


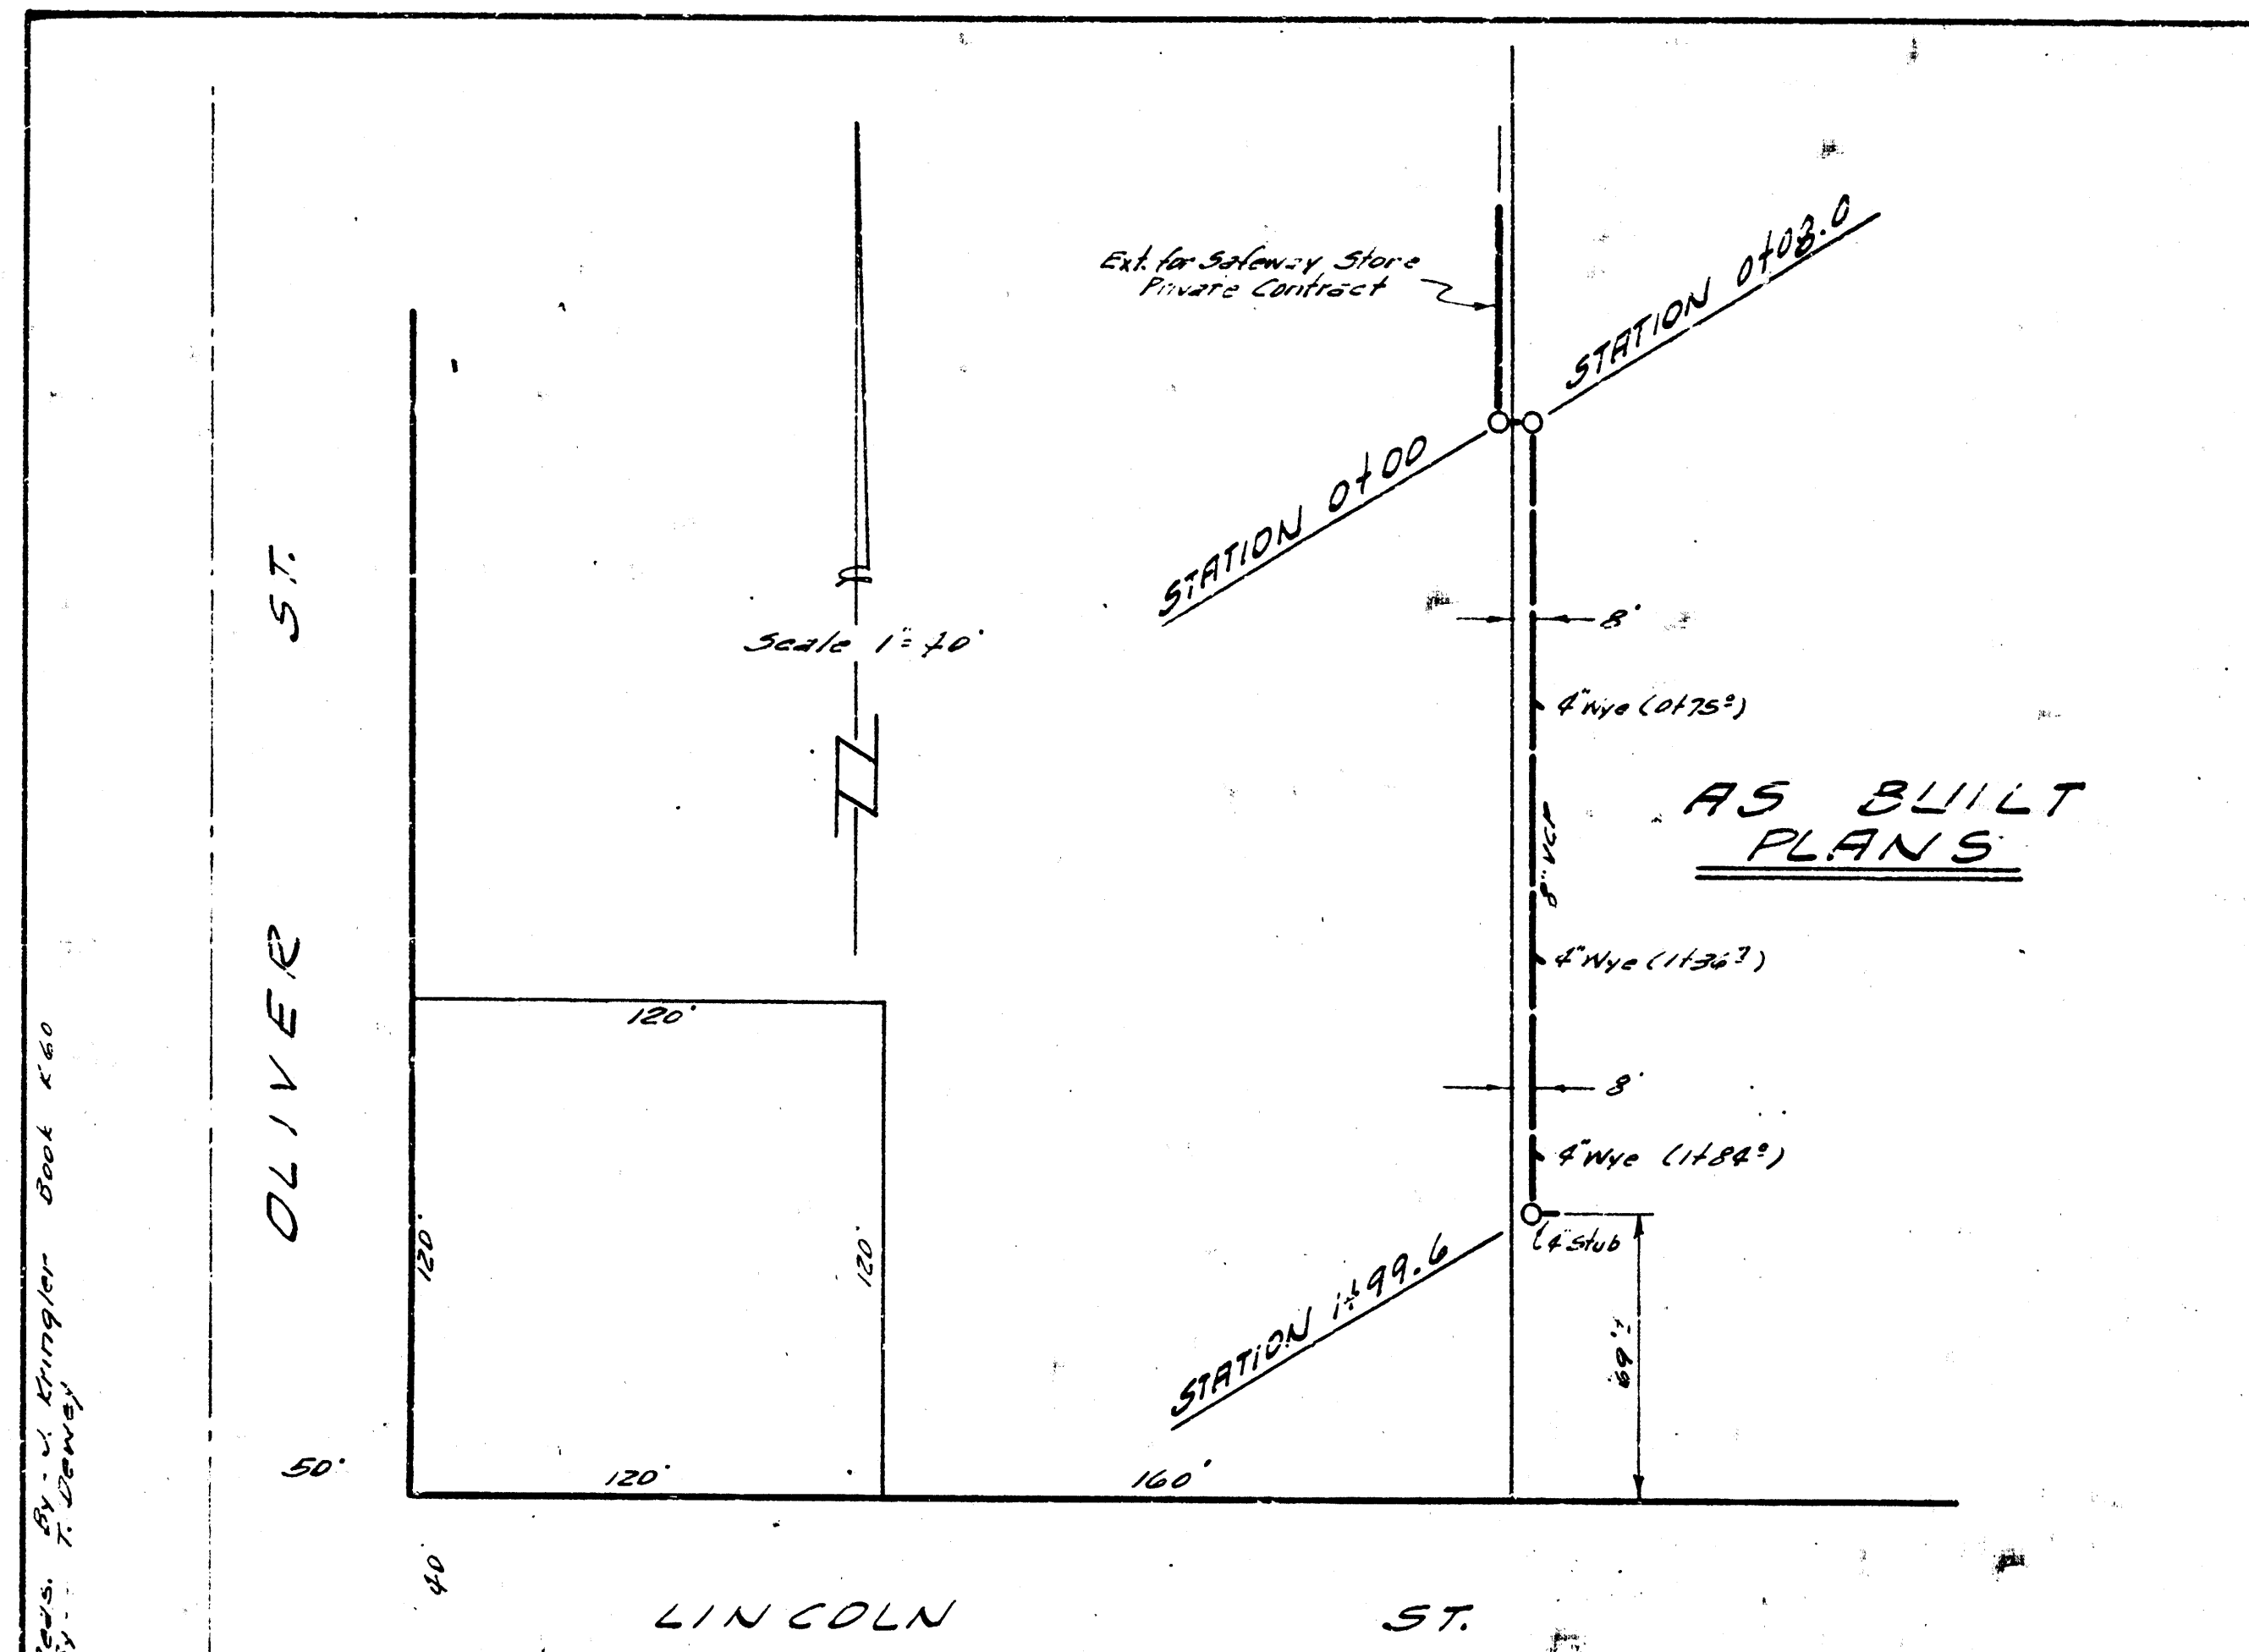


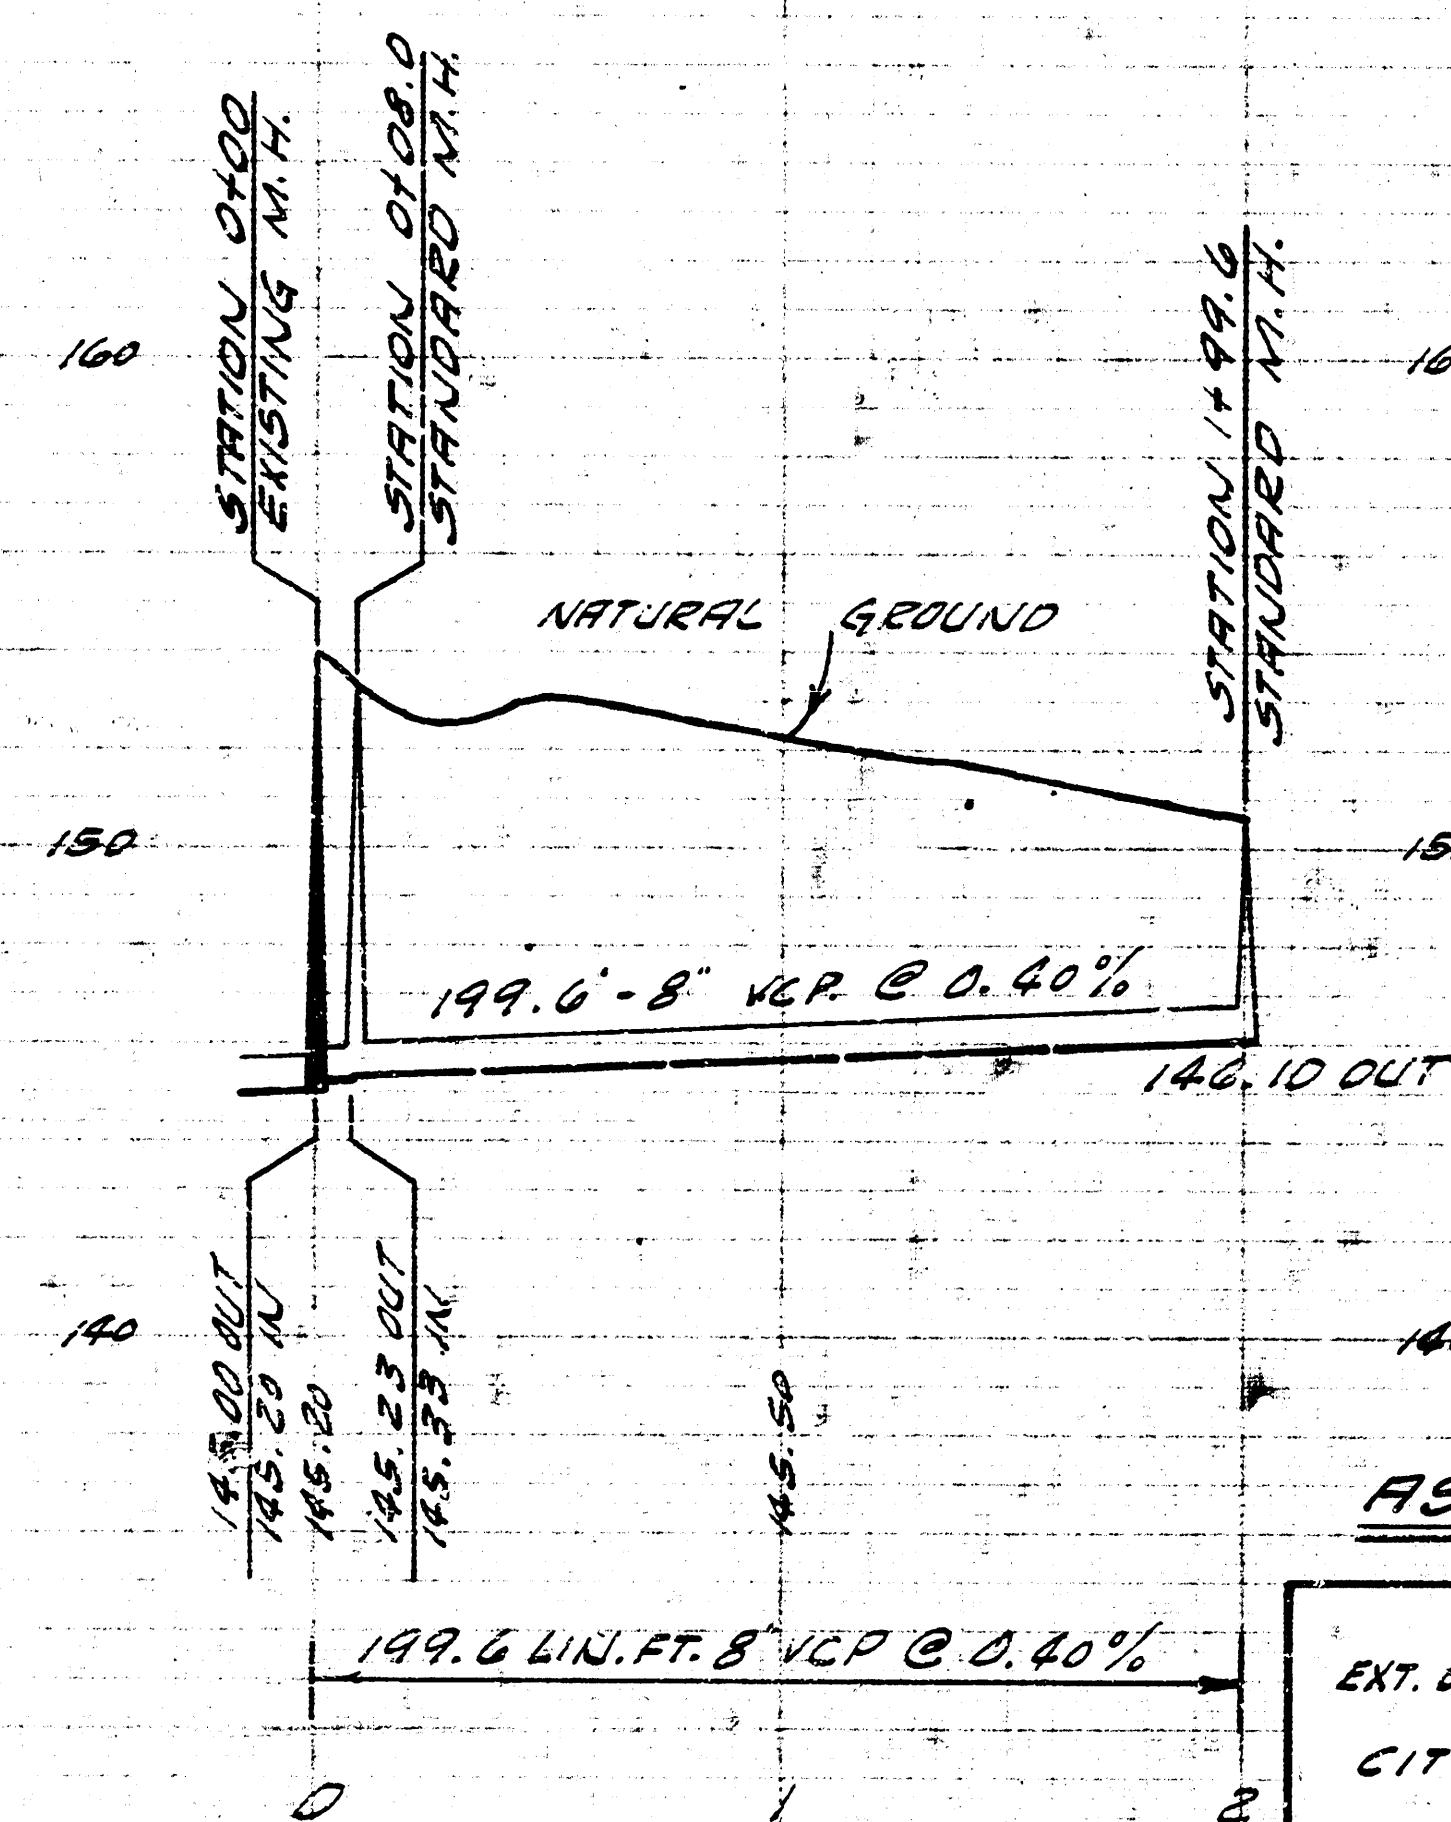

PLAN SCALE 1" = 40'
 PROFILE SCALE 1" = 40' HOR, 1" = 4' VERT.

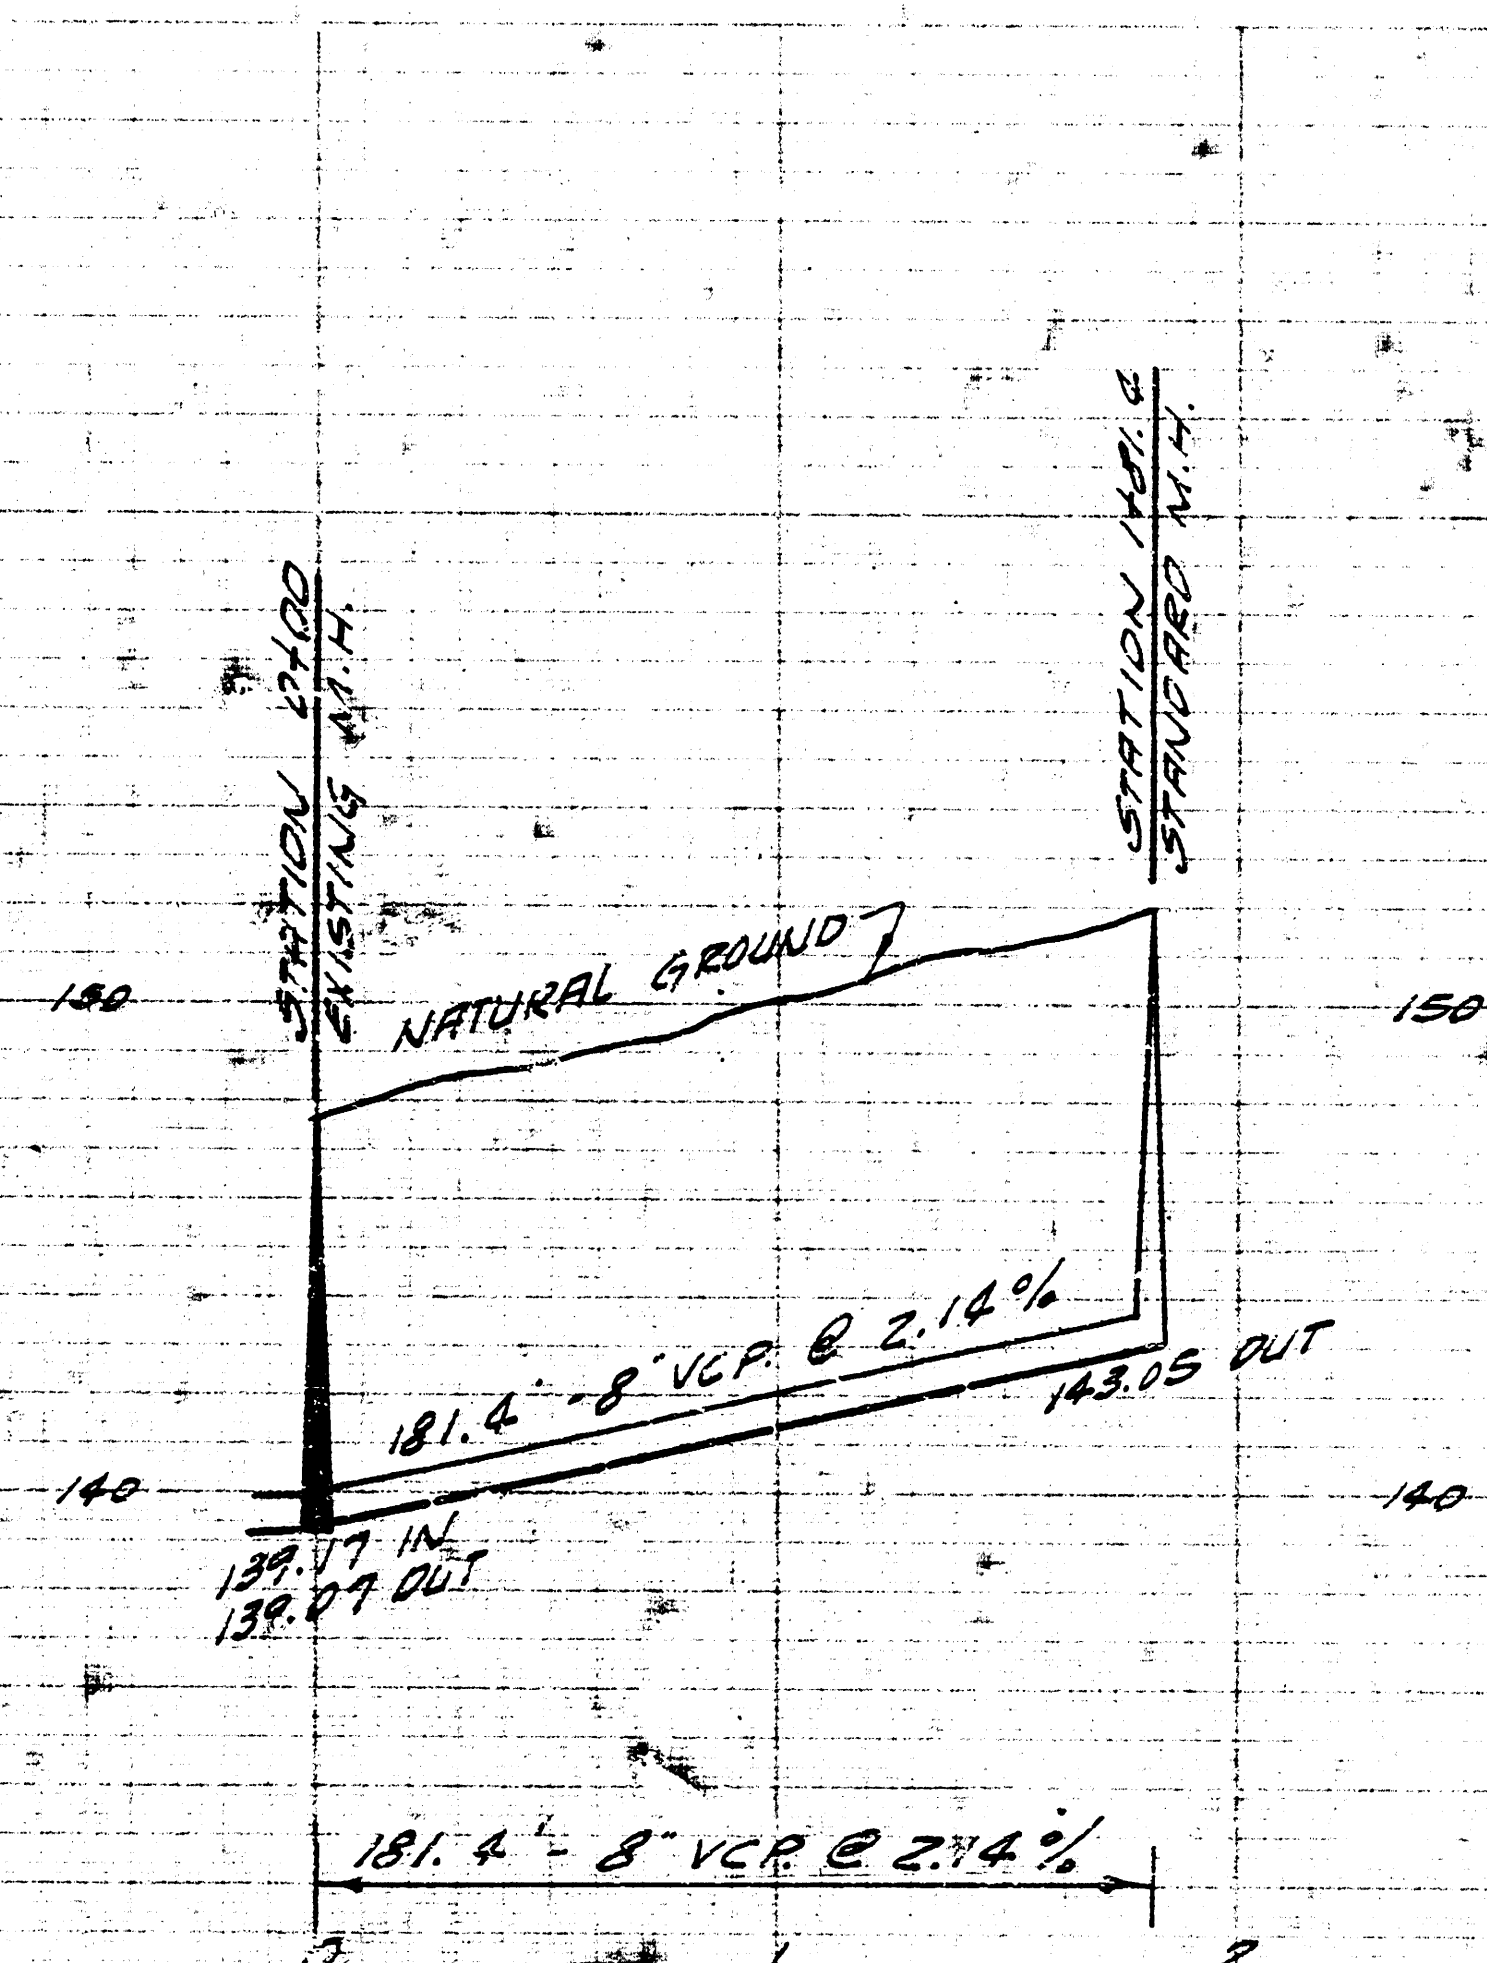

EXT. OF LAT. 33 DCS SS 12
 CITY OF WICHITA, KANSAS
 B.E. SMITH CITY ENGINEER
 PRIVATE JOB. OCT. 1960

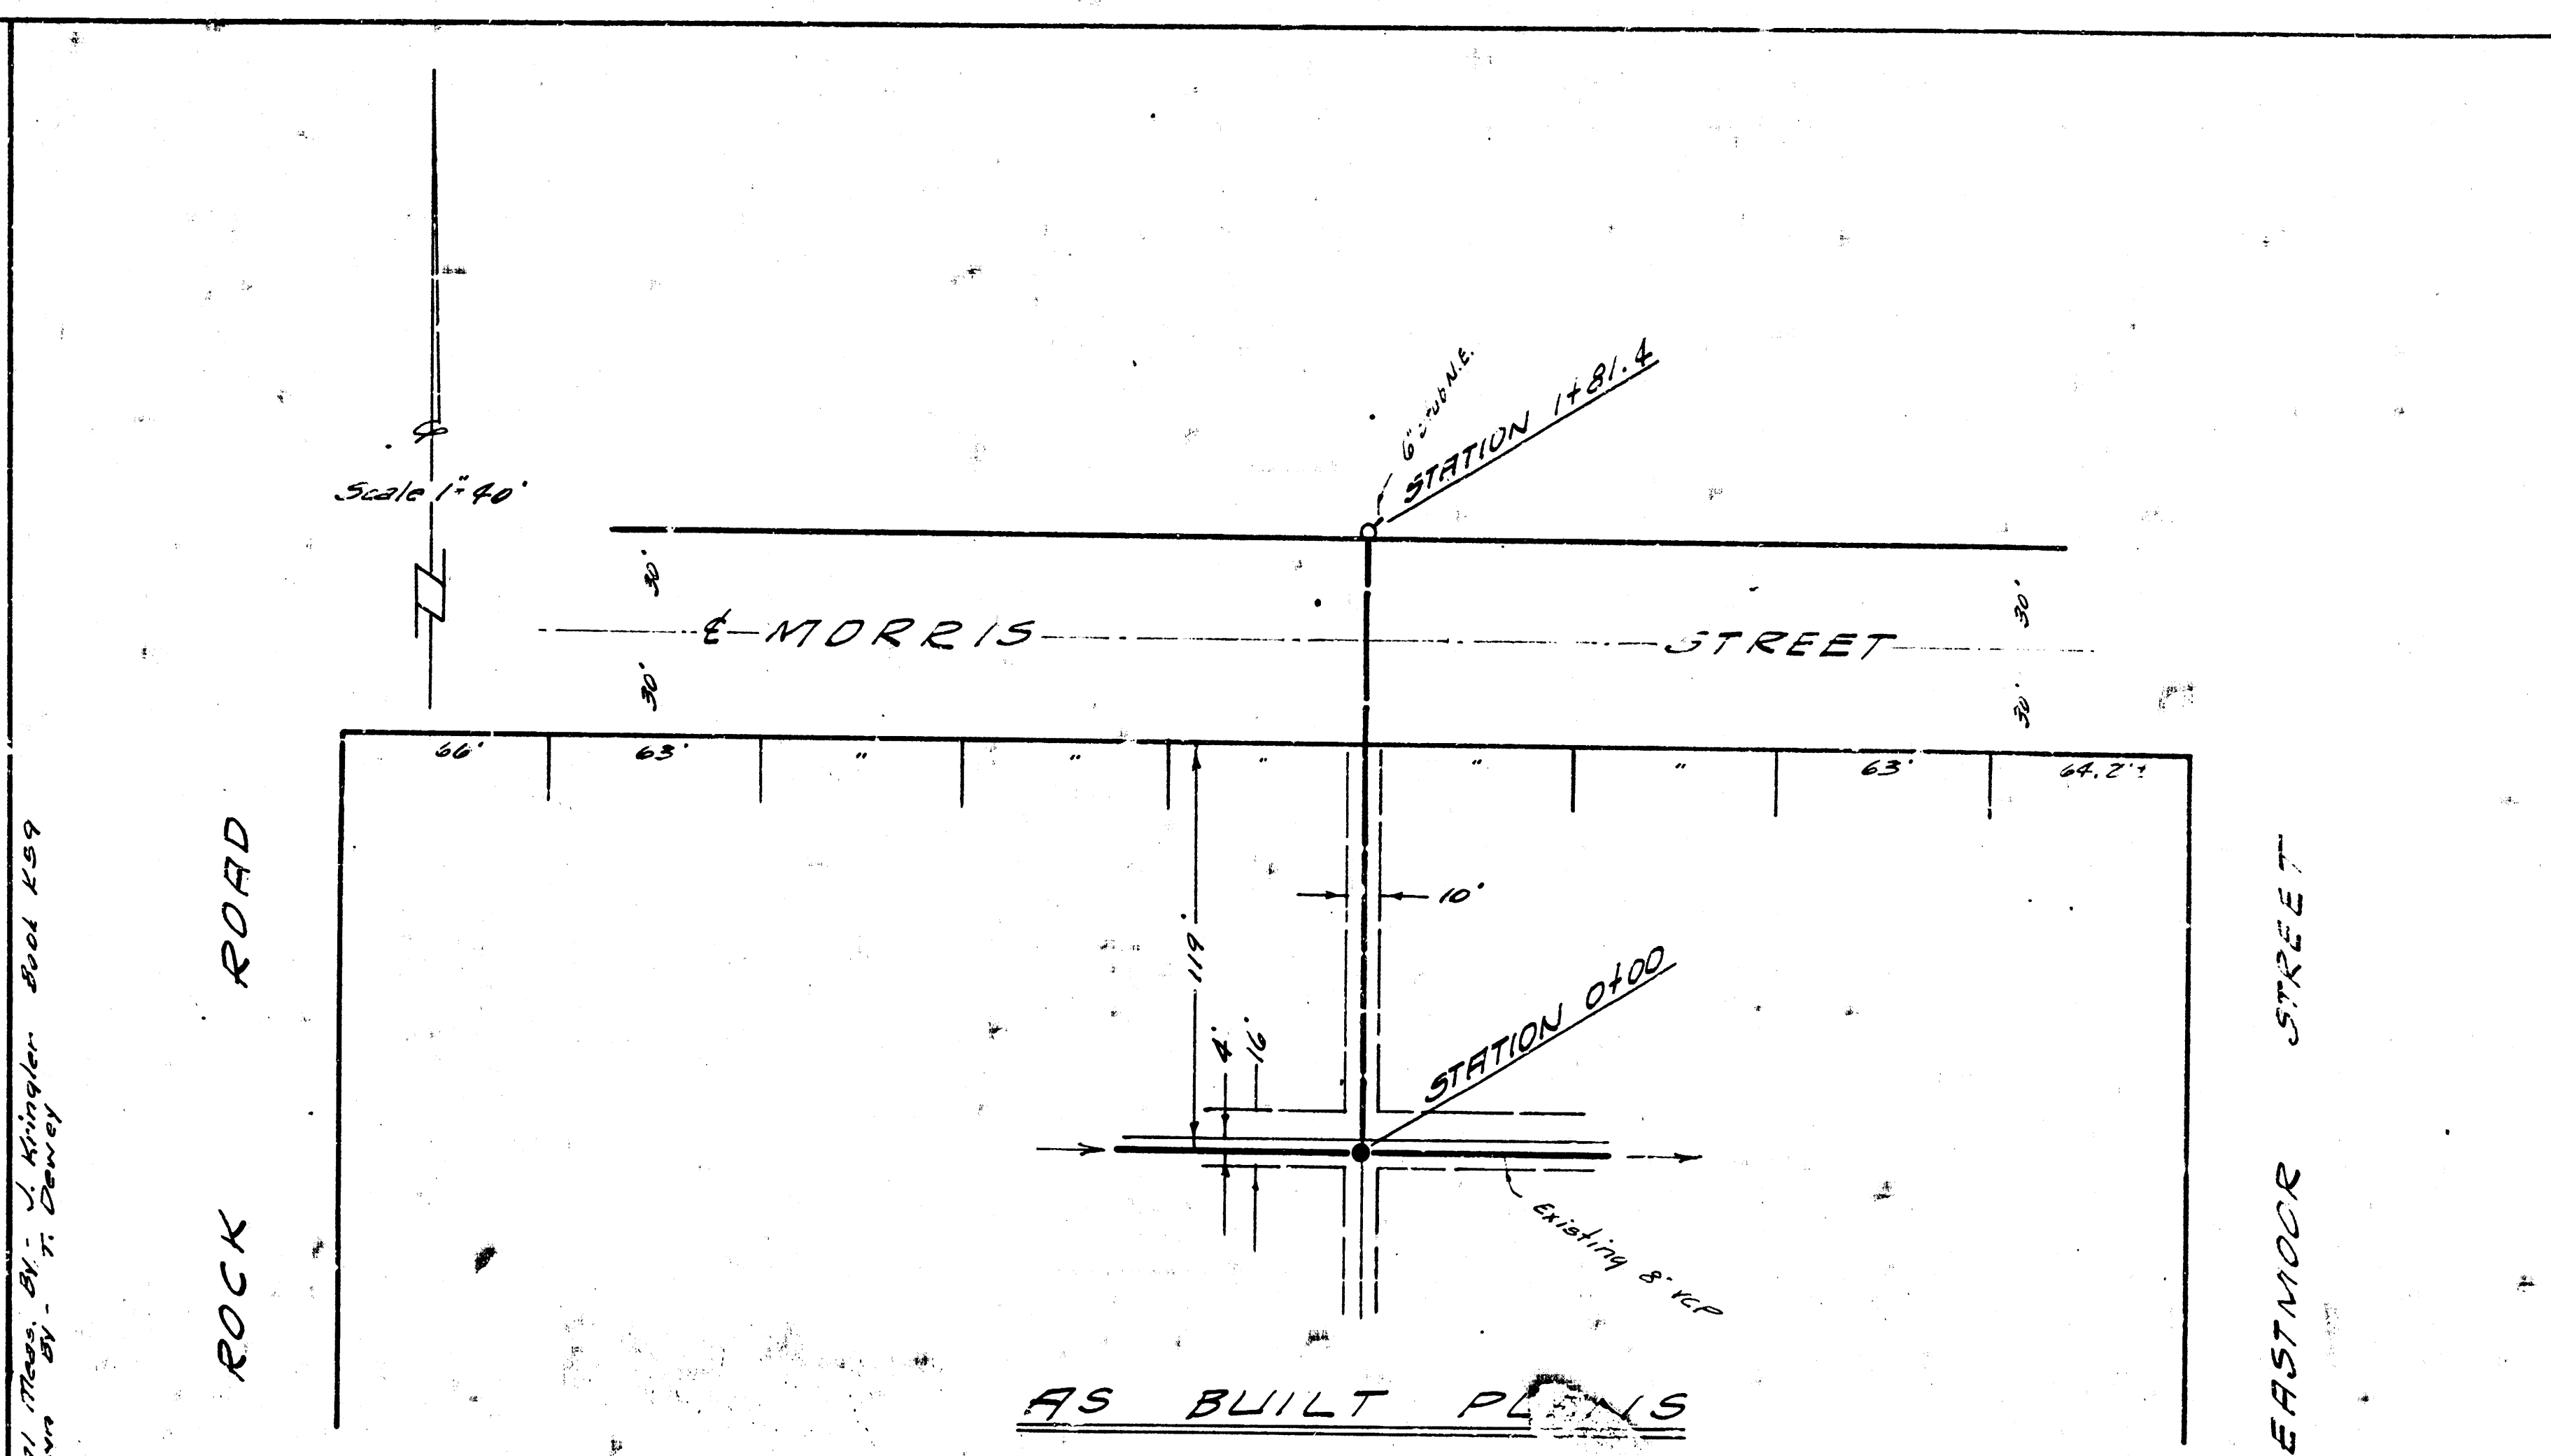

EXT. OF LATERAL 23 WIS
 CITY OF WICHITA, KANSAS
 B.E. SMITH CITY ENGINEER
 PRIVATE JOB. OCT. 1960