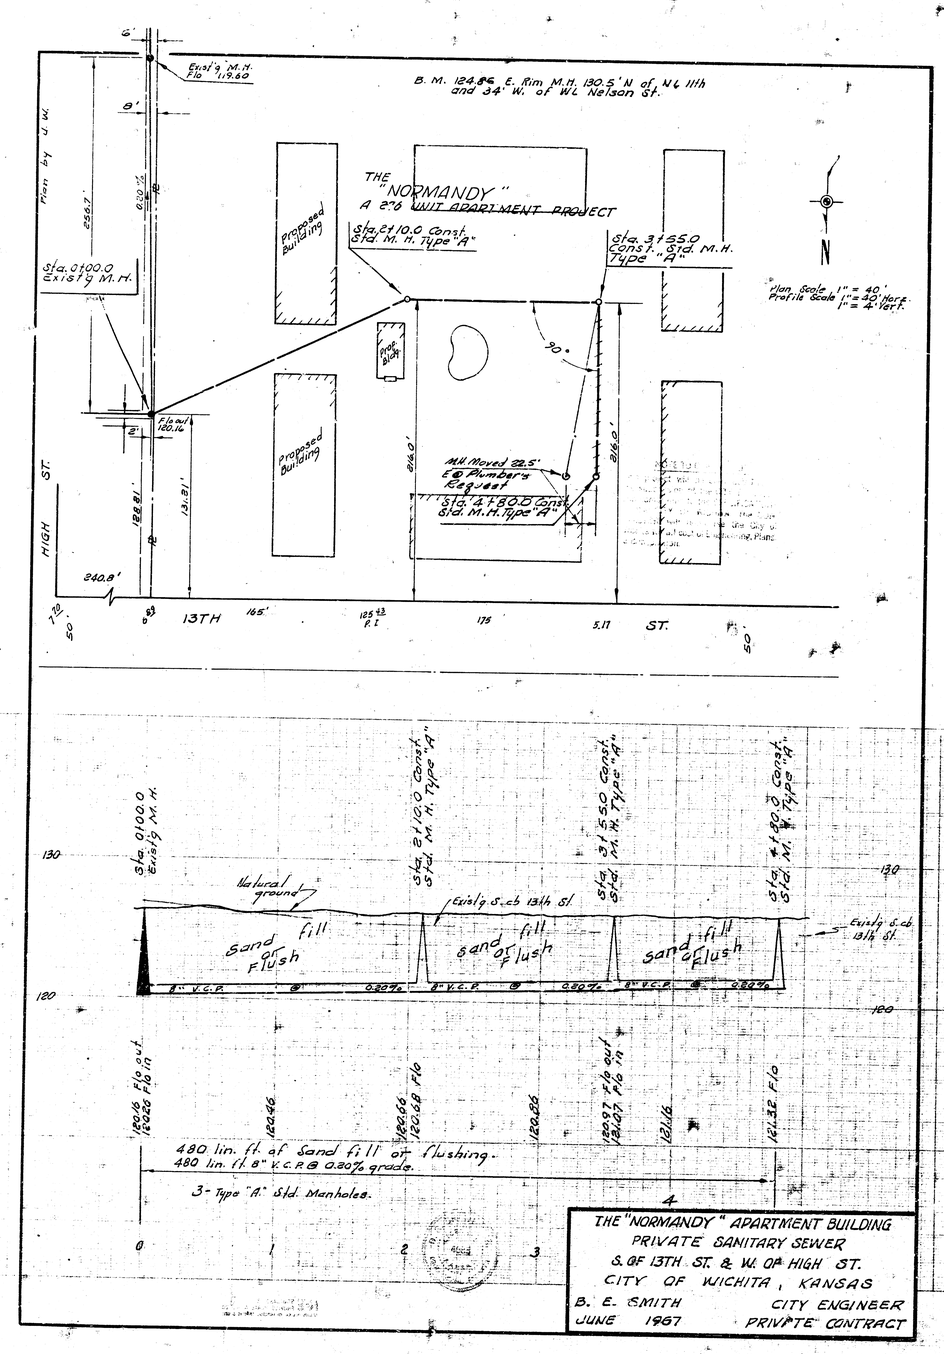

THE "NORMANDY" APARTMENT BUILDING
PRIVATE SANITARY SEWER
S. OF 13TH ST. & W. OF HIGH ST.
CITY OF WICHITA, KANSAS
B. E. SMITH CITY ENGINEER
JUNE 1967 PRIVATE CONTRACT

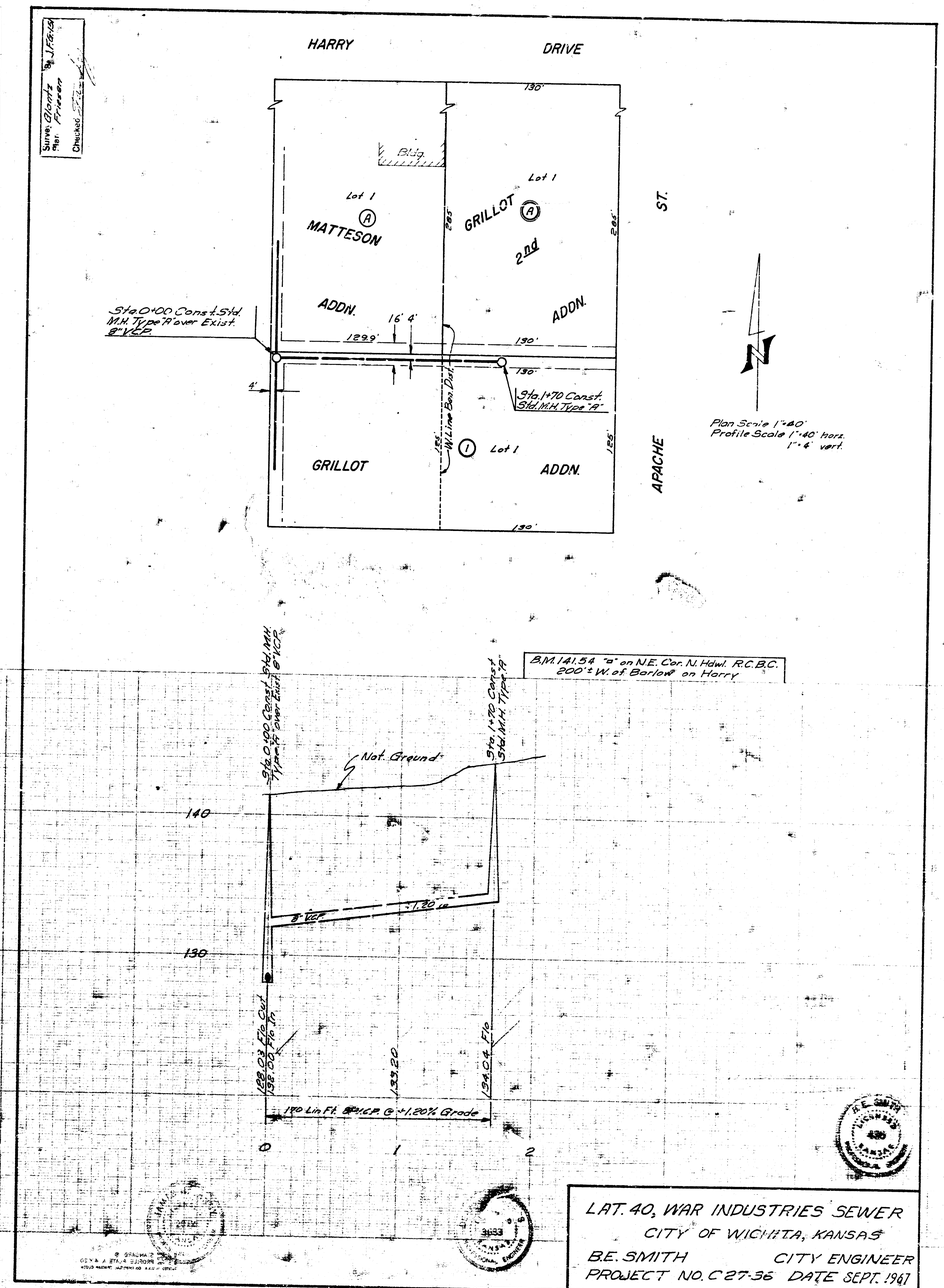

LAT. 40, WAR INDUSTRIES SEWER
CITY OF WICHITA, KANSAS
B.E. SMITH CITY ENGINEER
PROJECT NO. C 27-36 DATE SEPT. 1961

9 13 3 (2)