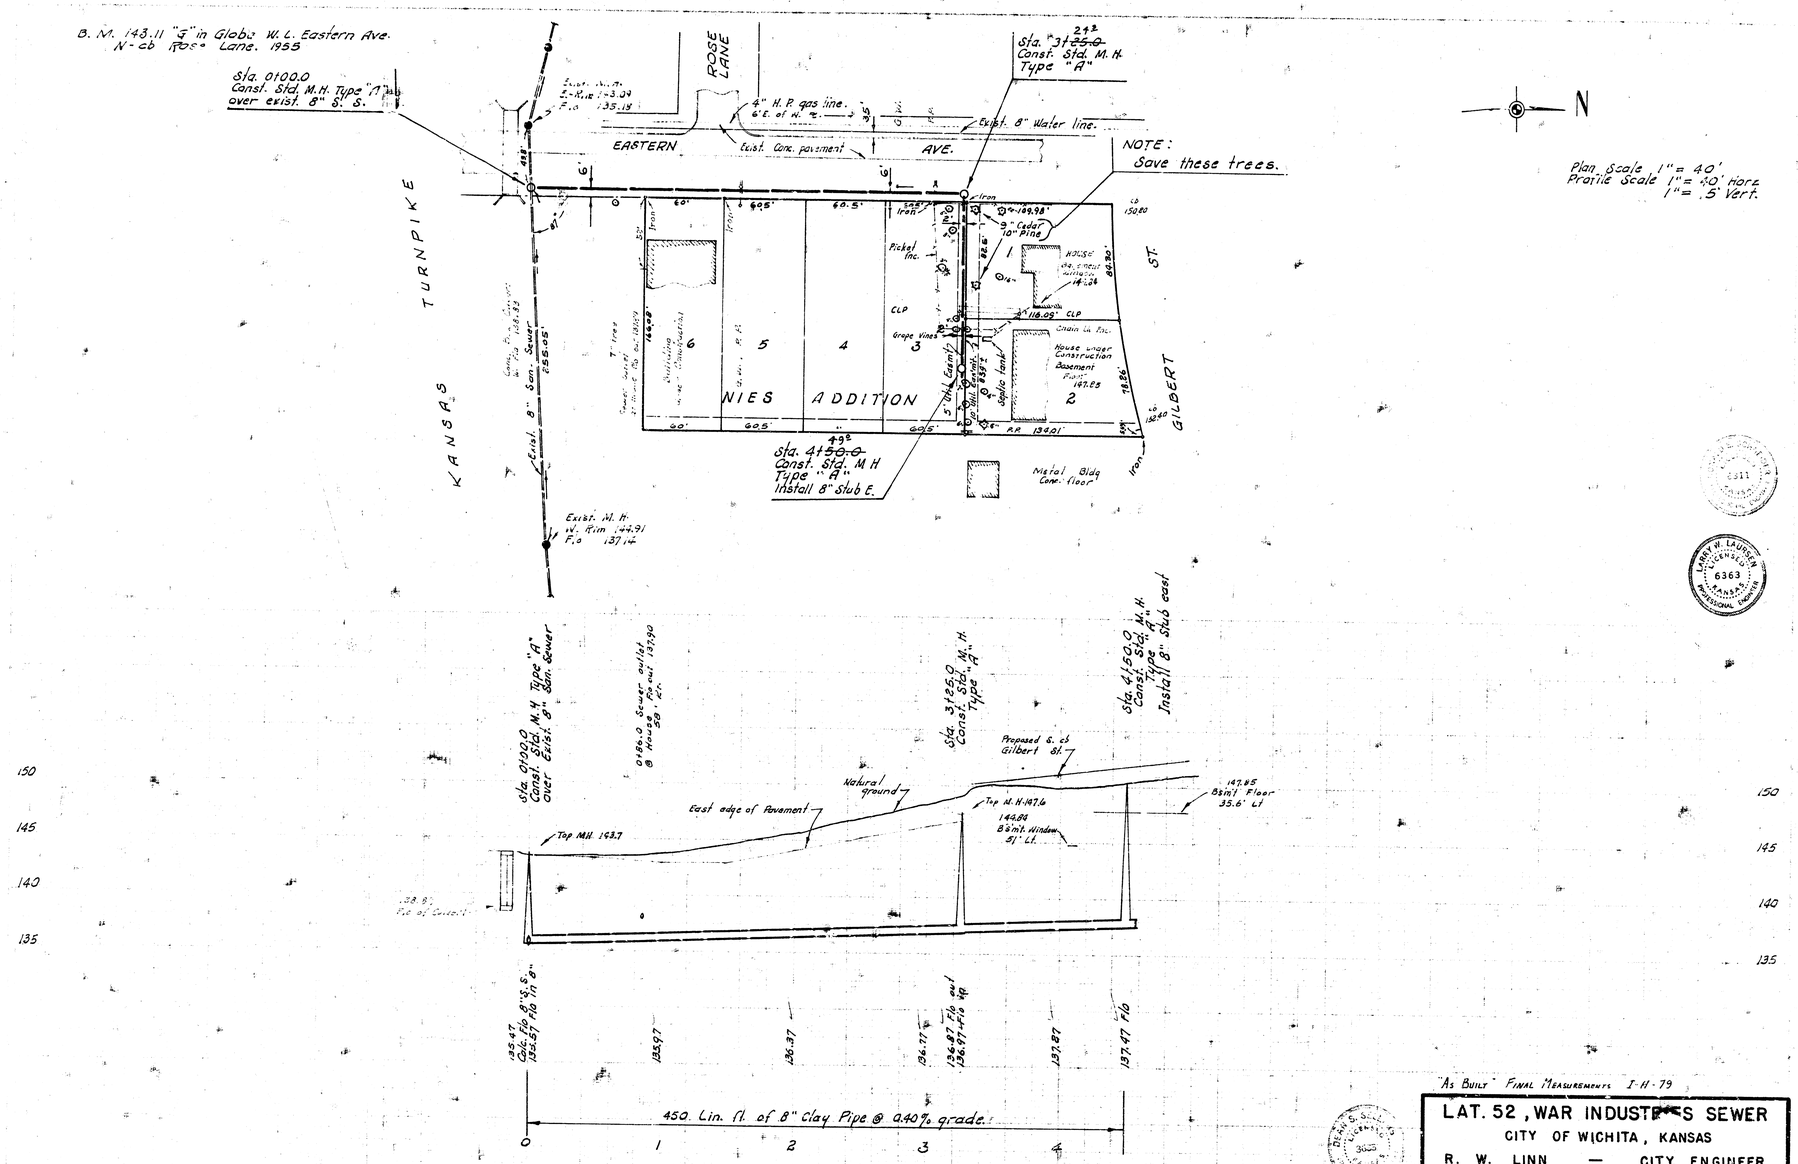

"As Built" Final Measurements 1-11-79

LAT. 52, WAR INDUSTRIES SEWER

CITY OF WICHITA, KANSAS

R. W. LINN — CITY ENGINEER

FEB. 1973 PROJECT NO. DBKL 5 7 2042