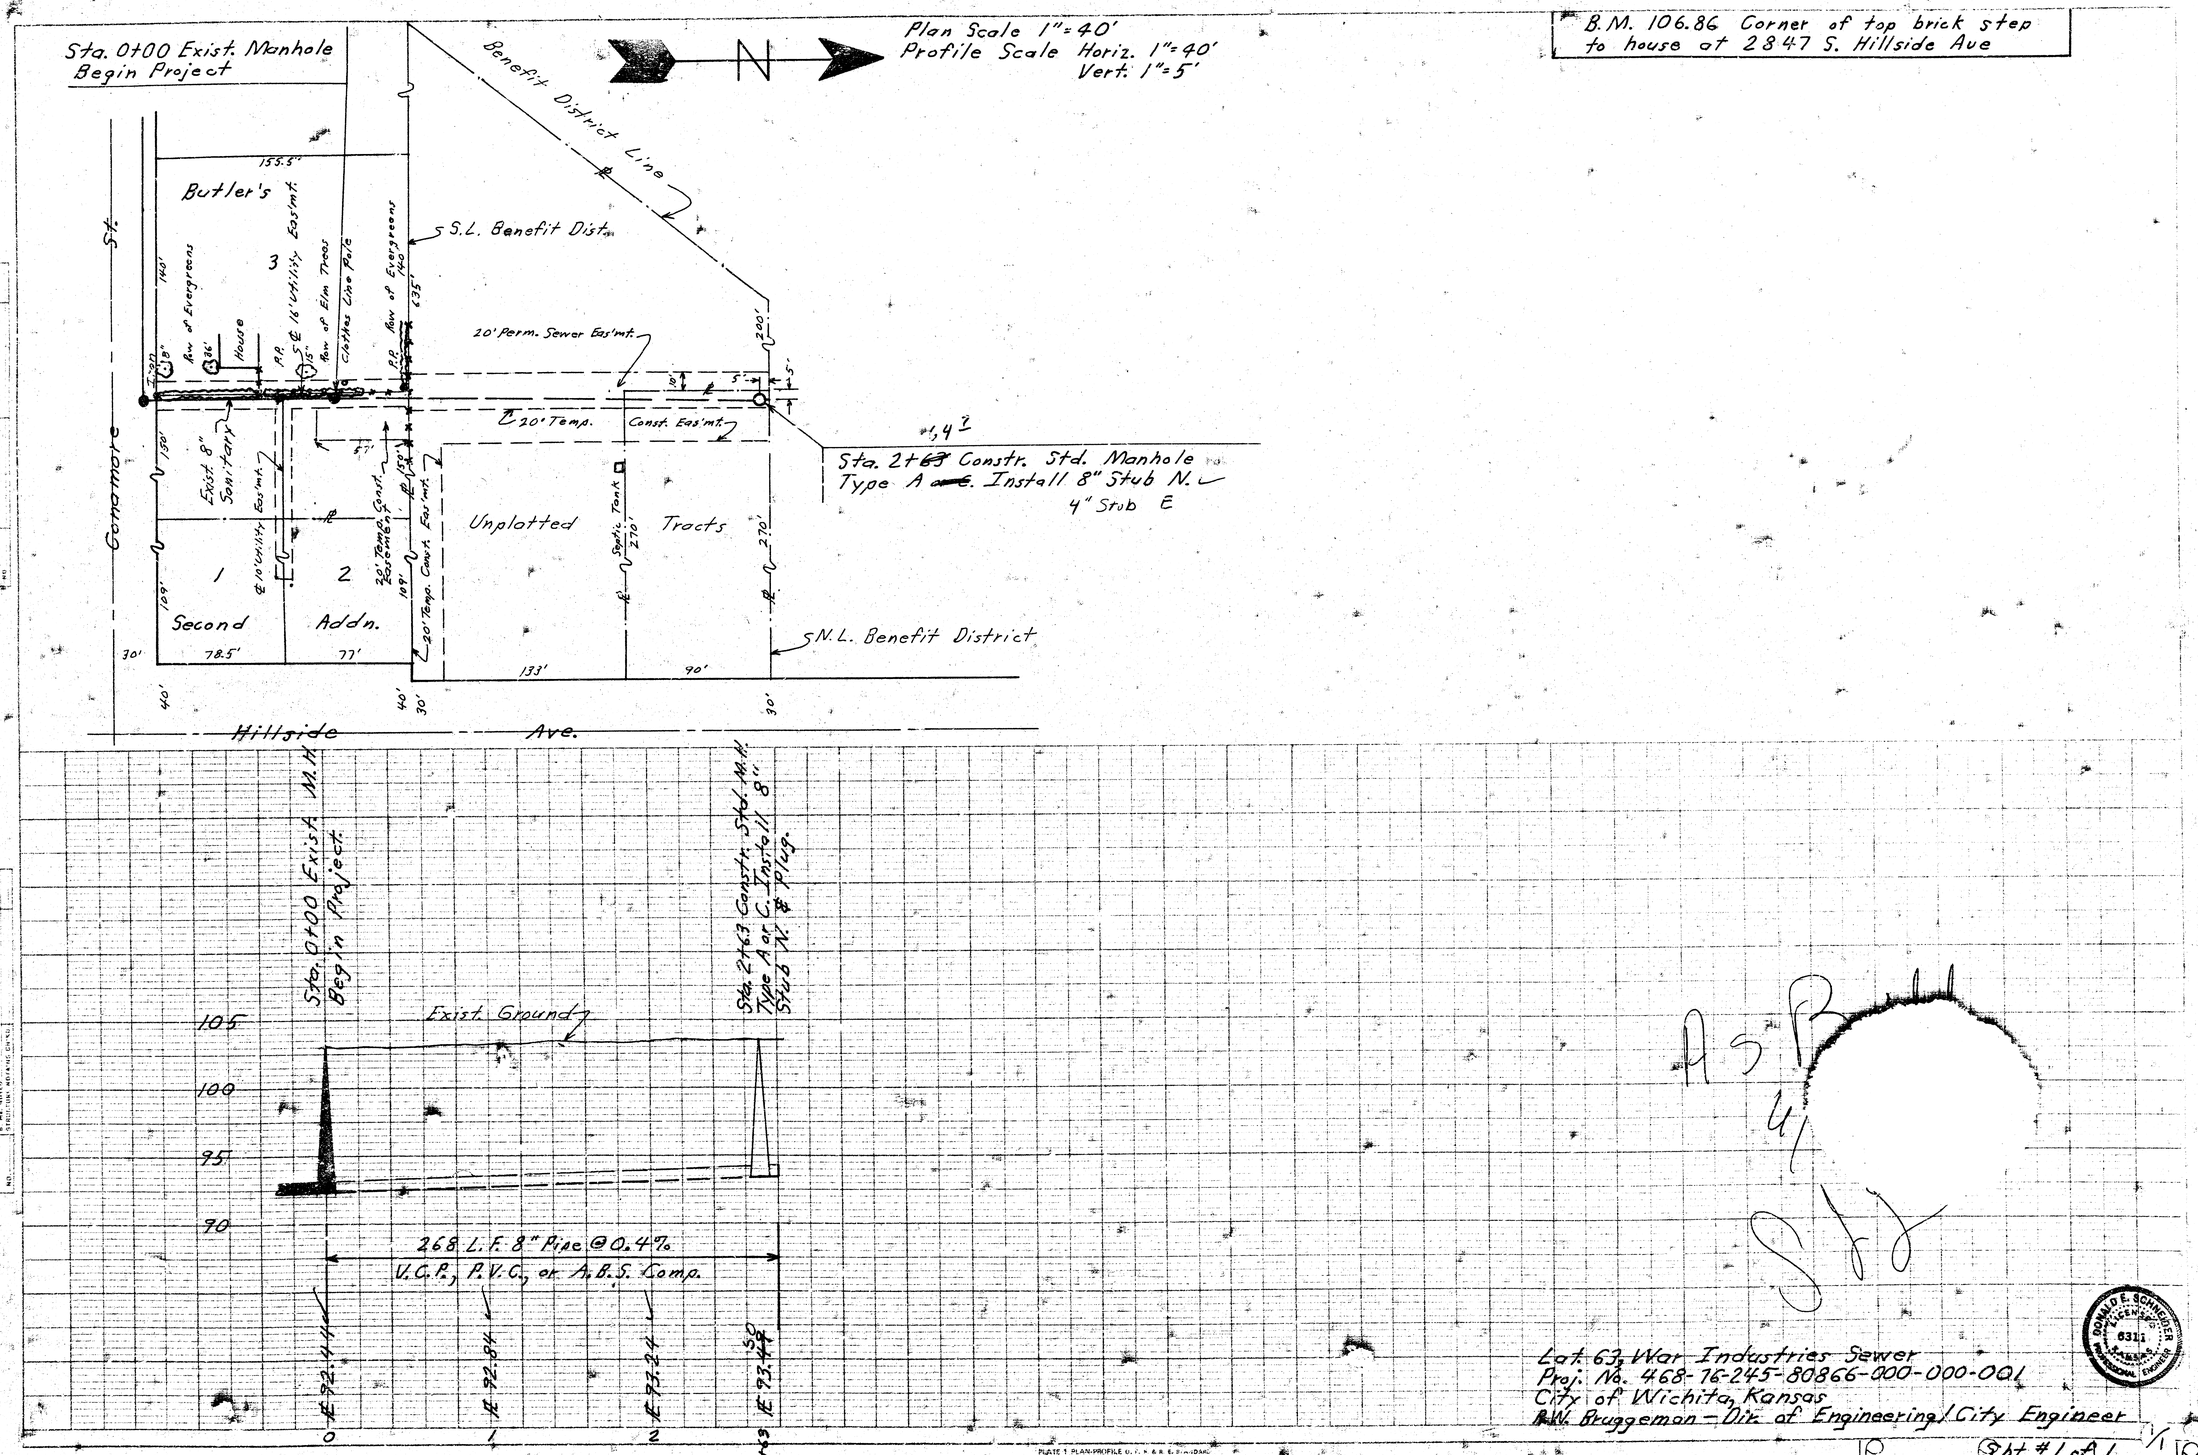


Lot 63, War Industries Sewer
Proj. No. 468-76-245-80866-000-000-001
City of Wichita, Kansas
R.W. Bruggeman — Dir. of Engineering/City Engineer

Sht. #1 of 1

PLATE 1 PLAN-PROFILE U.V. & B.S. STANDARD
100% RAG MOUNTAIN BOND WHITE AND PRINTED IN U.S.A.
EUGENE DIETZGEN CO.