

LATERAL 66 WAR INDUSTRIES SEWER SERVING HEDGECLIFF 2ND ADDITION

CITY OF WICHITA
PROJECT NO. 468-76-245-81056-000-000-001
DATE: JUNE 1981

GENERAL NOTES:

1. PRESERVATION OF PROPERTY IRONS. THE CONTRACTOR SHALL BE RESPONSIBLE FOR PRESERVING PROPERTY IRONS. THE CONTRACTOR SHALL BE REQUIRED TO RE-ESTABLISH ANY PROPERTY IRONS WHICH ARE DAMAGED OR DESTROYED BY HIS CONSTRUCTION OPERATIONS. SUCH IRONS SHALL BE RE-ESTABLISHED BY A LICENSED LAND SURVEYOR OR A LICENSED PROFESSIONAL ENGINEER IN ACCORDANCE WITH APPLICABLE STATE LAWS.

2. PRIOR TO BEGINNING CONSTRUCTION, THE CONTRACTOR SHALL VERIFY THE HORIZONTAL AND VERTICAL LOCATION OF THE EXISTING 8" SANITARY SEWER AT THE BEGINNING OF LINE NO. ONE. IF ANY DISCREPANCIES ARE FOUND REGARDING FIELD LOCATIONS AND PLAN LOCATIONS IN THIS AREA, THE CONTRACTOR SHALL CONTACT THE ENGINEER FOR THE NECESSARY FIELD ADJUSTMENT CALCULATIONS PRIOR TO PROCEEDING.

3. AT LEAST 48 HOURS PRIOR TO BEGINNING EXCAVATION (EXCLUDING WEEKENDS AND HOLIDAYS), THE CONTRACTOR SHALL CONTACT THE UTILITY LOCATION SERVICE - KAN-U-DIG-IT AT 316-267-2889 TO REQUEST THE FOLLOWING COMPANIES TO LOCATE ANY EXISTING LINES WITHIN THE PROJECT AREA: GAS SERVICE COMPANY, K.G. & E., SOUTHWESTERN BELL TELEPHONE CO., WICHITA WATER DEPT., AND THE CITIES SERVICE GAS COMPANY.

4. EXCESS EXCAVATED MATERIAL AND OTHER DEBRIS SHALL BE WASTED AS DIRECTED BY THE ENGINEER.



5. THE CONTRACTOR SHALL REMOVE TREES AS DIRECTED BY THE ENGINEER TO ALLOW FOR THE CONSTRUCTION OF THE SANITARY SEWER LINES. TREE REMOVAL IS TO BE CONSIDERED SUBSIDIARY TO ITEMS BID AND IS NOT AN ADDITIONAL PAY ITEM.

NOTE: RISER PIPE SHALL BE INSTALLED TO SERVE INDIVIDUAL LOTS OR TRACTS IN CONJUNCTION WITH NEW SANITARY SEWER CONSTRUCTION, UNLESS OTHERWISE ORDERED BY THE ENGINEER. BECAUSE OF GROUND WATER, UNSTABLE SOIL OR UNUSUALLY DEEP CONSTRUCTION, RISER LOCATIONS SHALL BE AS APPROVED BY THE PROPERTY OWNER WITH THE CONCURRENCE OF THE ENGINEER. INSTALLATION OF RISERS ON SEWERS BECAUSE OF UNUSUAL DEPTH WILL BE REQUIRED WHEN THE SEWER IS DEEPER THAN TWELVE FEET (12'). THE CONTRACTOR WILL BE REQUIRED TO FILE WRITTEN DOCUMENTATION WITH THE ENGINEER IN A FORM APPROVED BY THE ENGINEER INDICATING THE LOCATIONS WHERE RISERS ARE TO BE INSTALLED AS REQUESTED BY THE PROPERTY OWNER OR HIS AUTHORIZED REPRESENTATIVE. RISER PIPE CONSTRUCTION SHALL CONFORM TO THE REQUIREMENTS AS SHOWN ON THE STANDARD RISER DETAIL SHEET.

BENCH MARKS


1. CITY BRASS CAP 53' S. AND 47' W. OF THE CENTERLINE OF PAWNEE & WEBB ROAD. ELEV. 205.678
2. RAILROAD SPIKE IN POWER POLE 150' W. AND 25' N. OF THE CENTERLINE CYPRESS & PAWNEE. ELEV. 194.04

ELEVATIONS ARE CITY OF WICHITA DATUM


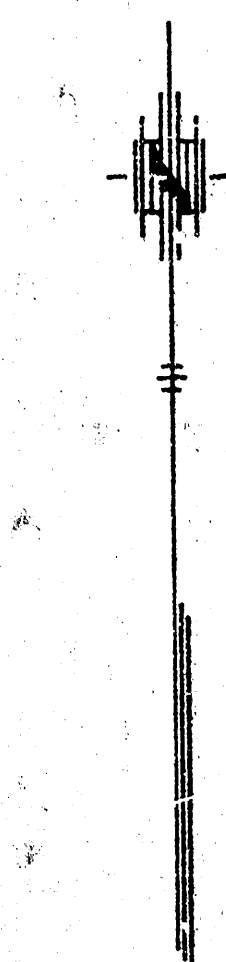
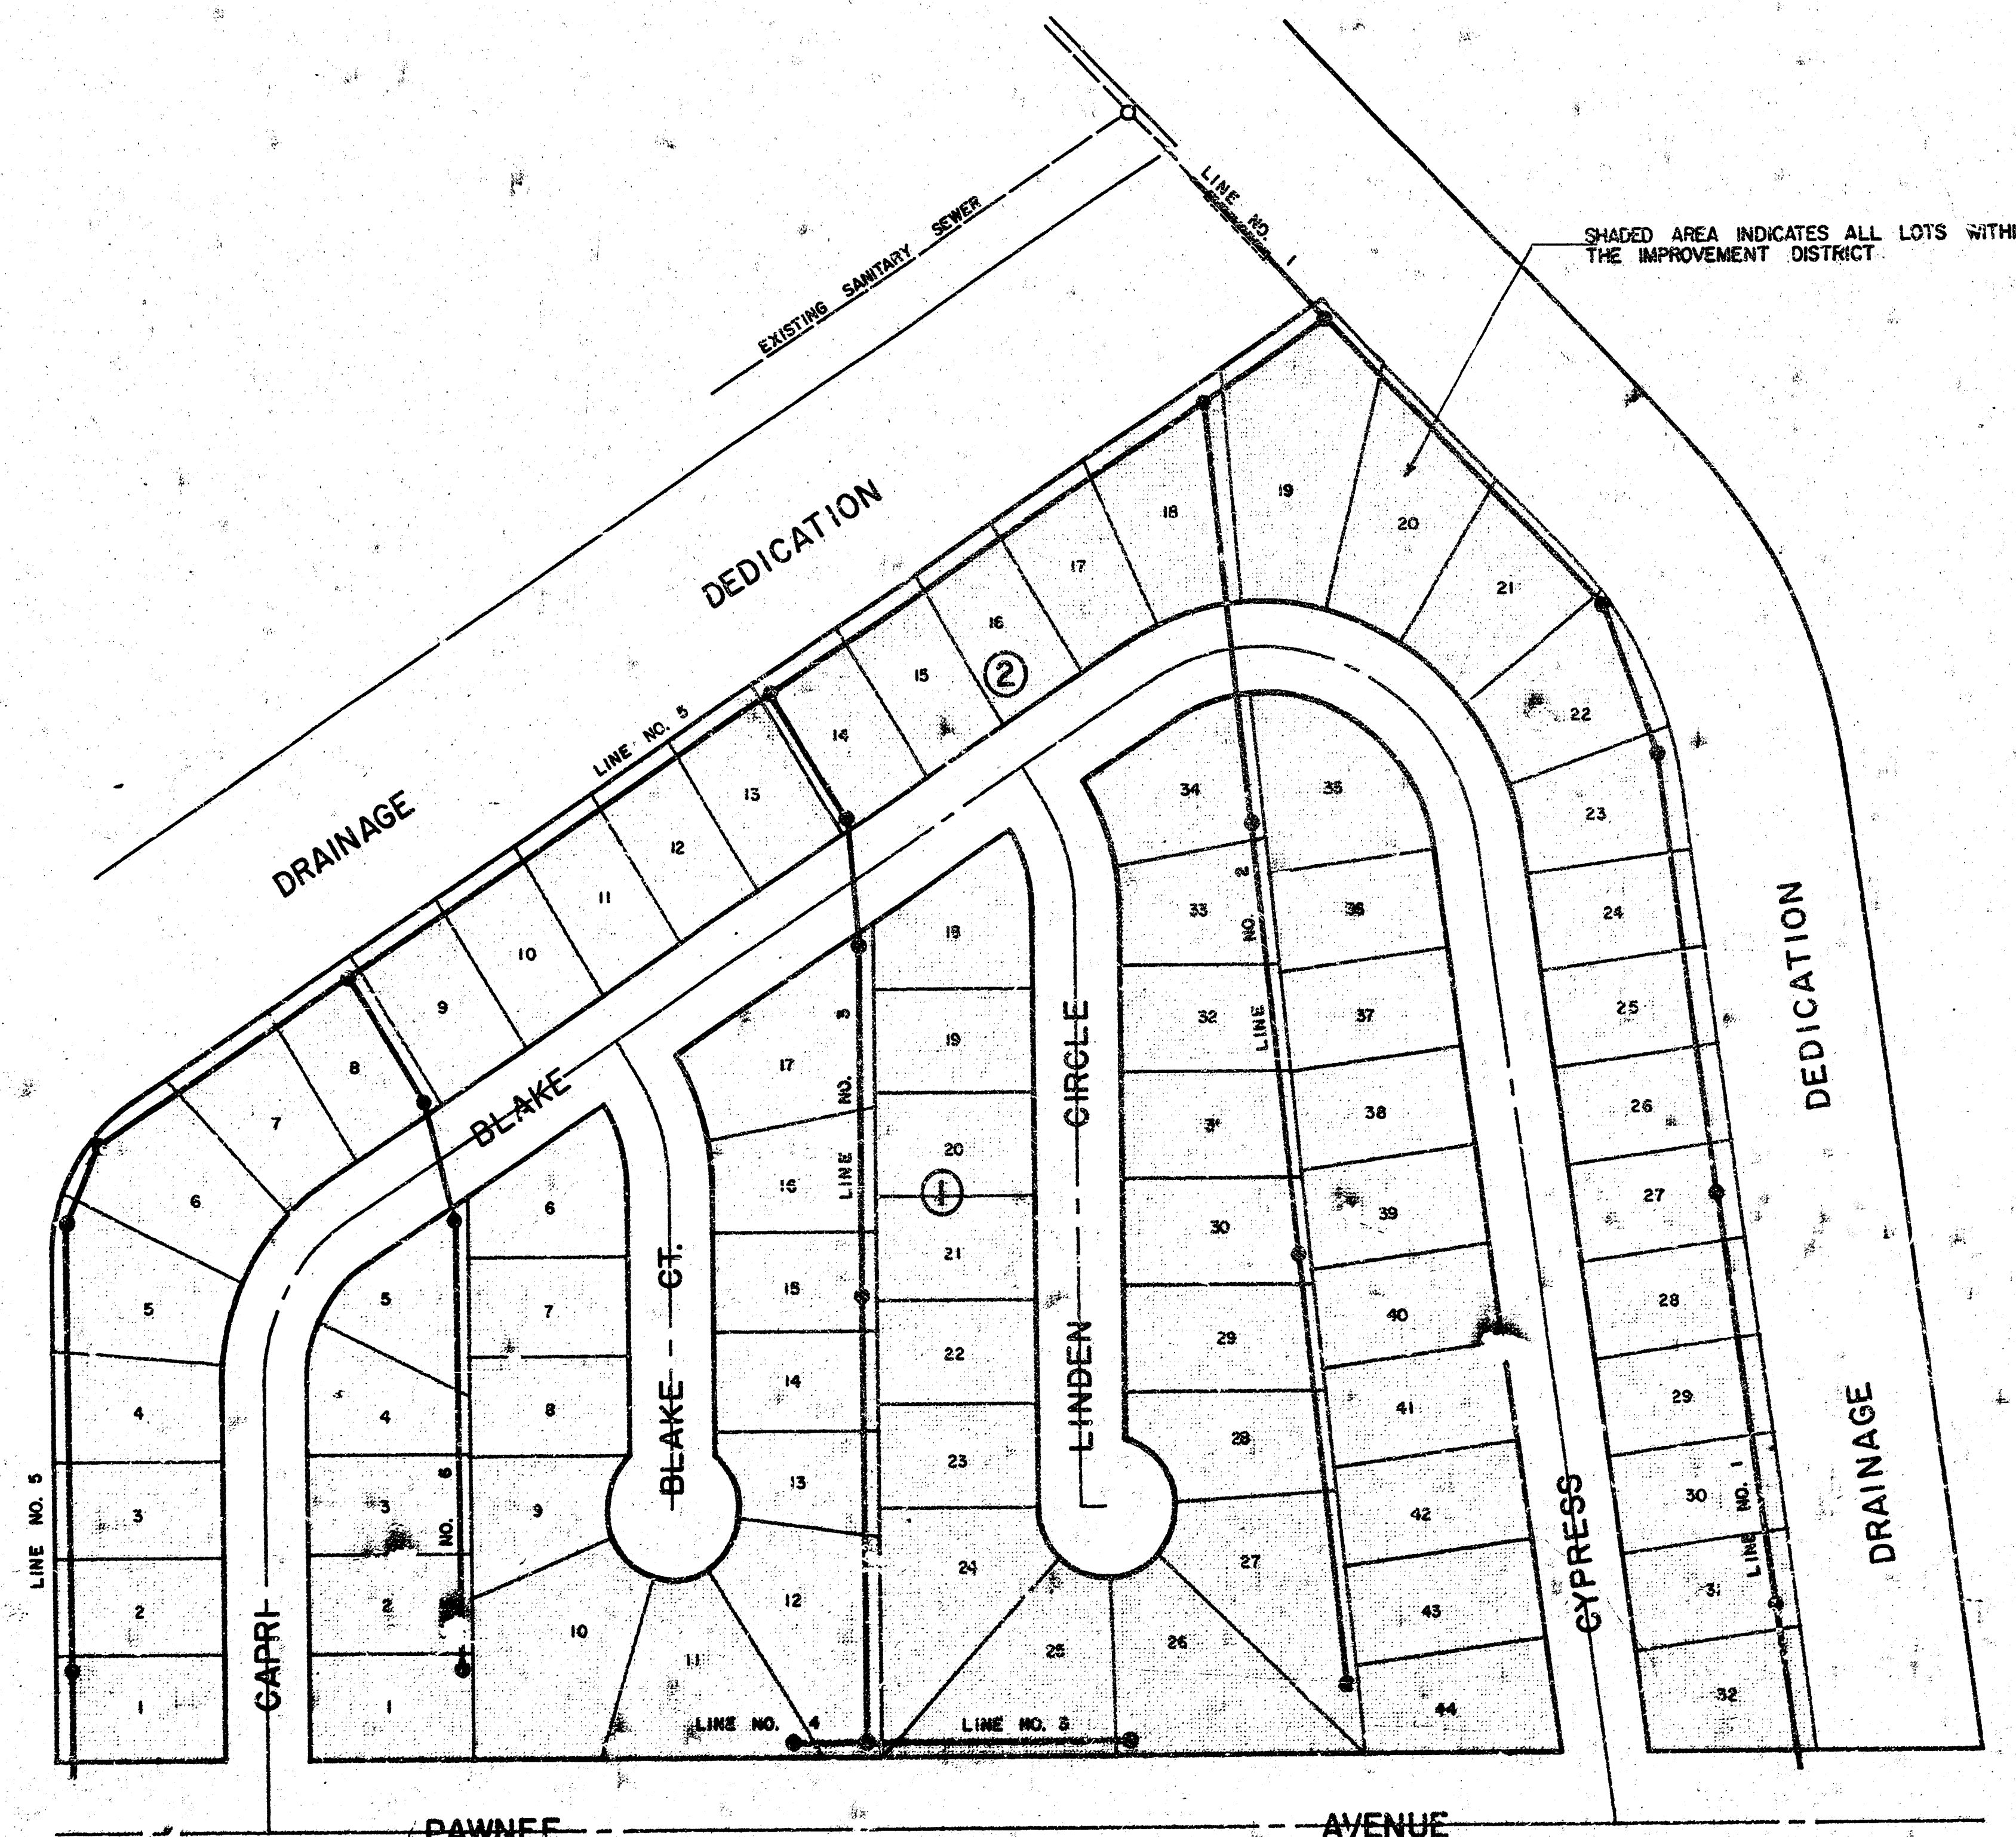


INDEX TO SHEETS

TITLE	SHEET NO. 1
LINE NO. 1	SHEET NO. 2
LINE NO. 2	SHEET NO. 3
LINE NO. 3 & 4	SHEET NO. 4
LINE NO. 5	SHEET NO. 5
LINE NO. 5 & 6	SHEET NO. 6

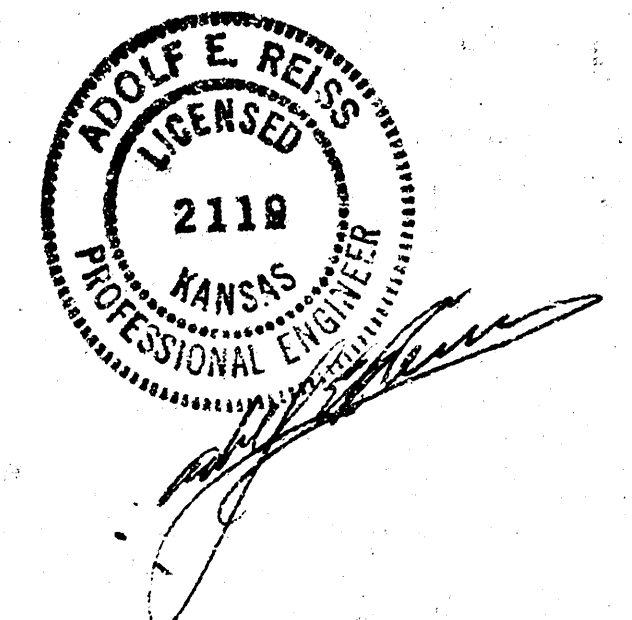

LINE NO. 2 HEDGECLIFF 2ND ADDN.		SCALE AS NOTED DATE 6-24-81 SHEET 3 OF 6	REISS & COODNER ENGINEERS 2100 WEST 21 ST STREET WICHITA, KANSAS 67203 (913) 832-0223
CITY OF WICHITA - LATERAL 66 - WAR INDUSTRIES SEWER PROJECT NO. 465 76 245 5056 000 000 001		REV'D 9-8-81	

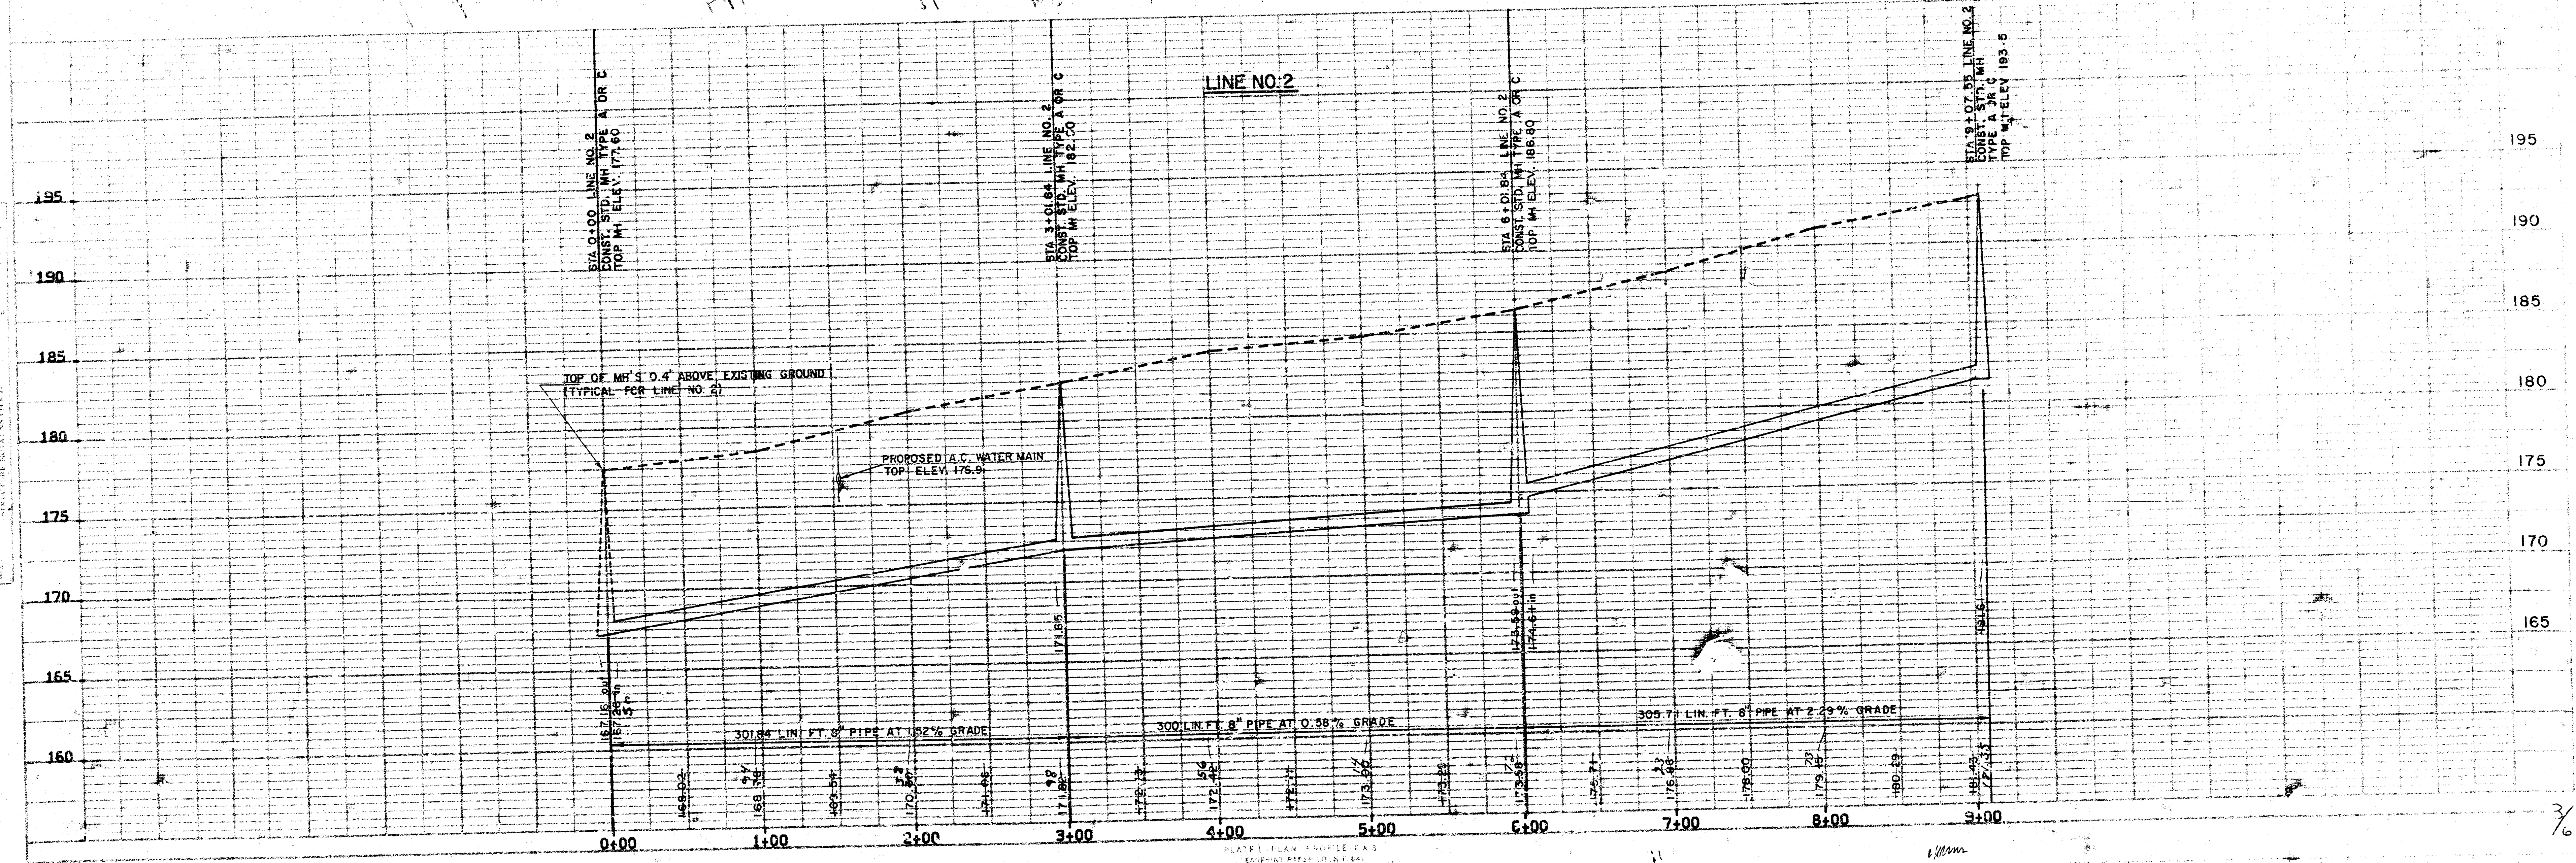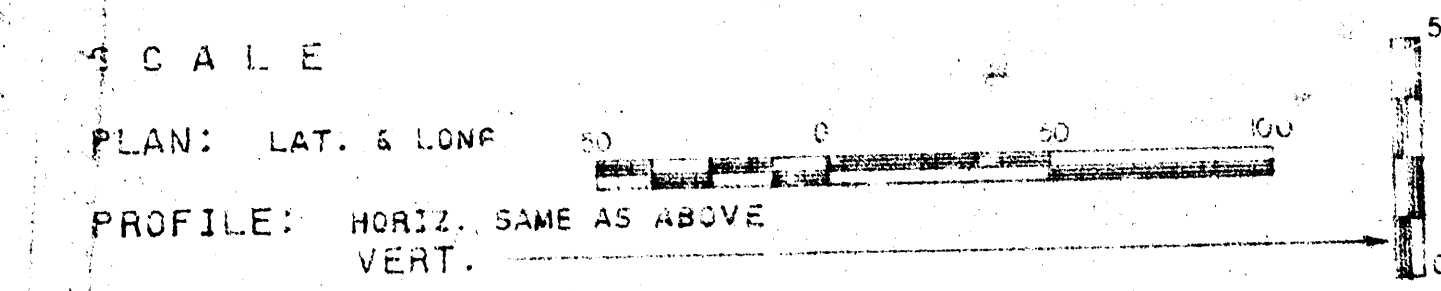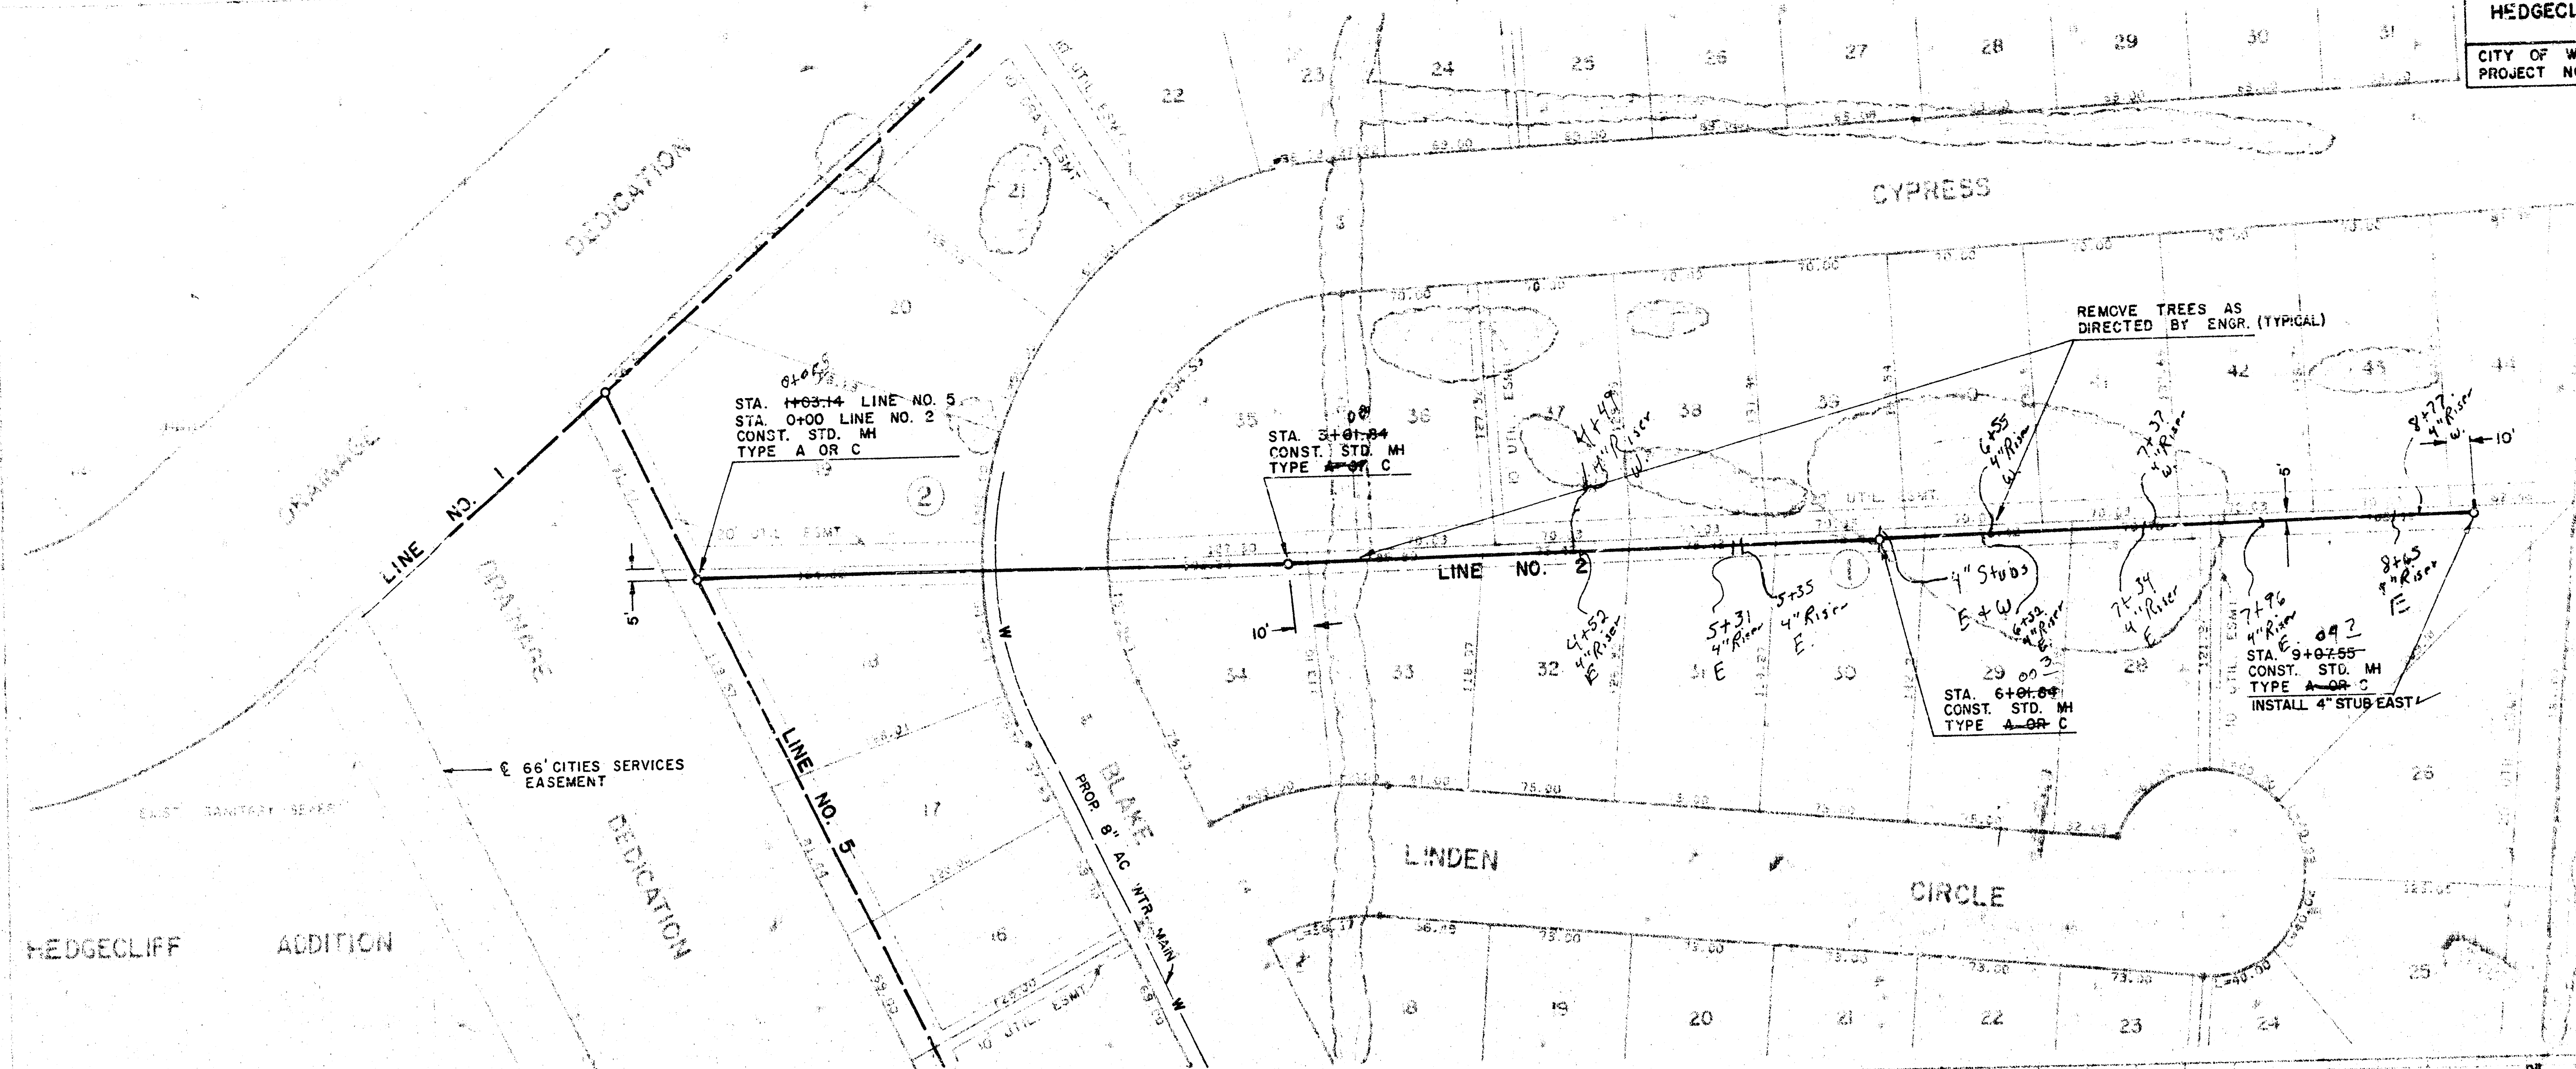




LINE NO. 3 AND 4 HEDGECLIFF 2ND ADDN.		SCALES NOTED DATE 6-24-81 SHEET 3 OF 6	REISS & GOODNESS ENGINEERS 2100 WEST 21 ST STREET WICHITA, KANSAS 67204 (316) 632-0231
CITY OF WICHITA - LATERAL 66 - WAR INDUSTRIES SEWER PROJECT NO. 468 76 245 B056 000 000 001		REV'D 9-8-81	

* THE TOP OF MANHOLE ELEVATIONS ARE 0.4' ABOVE THE PROPOSED PROPERTY LINE ELEVATIONS AS ESTABLISHED BY THE ENGINEERING DEPARTMENT CITY OF WICHITA



* STA. 7+43.85 LINE NO. 3
 STA. 0+00 LINE NO. 4
 CONST. STD. MH
 TYPE A-OR C

* STA. 0+56.64
 CONST. STD. MH
 TYPE A-OR C
 INSTALL 4" STUB N.W.

As Bui
 1.1.2
 7-82

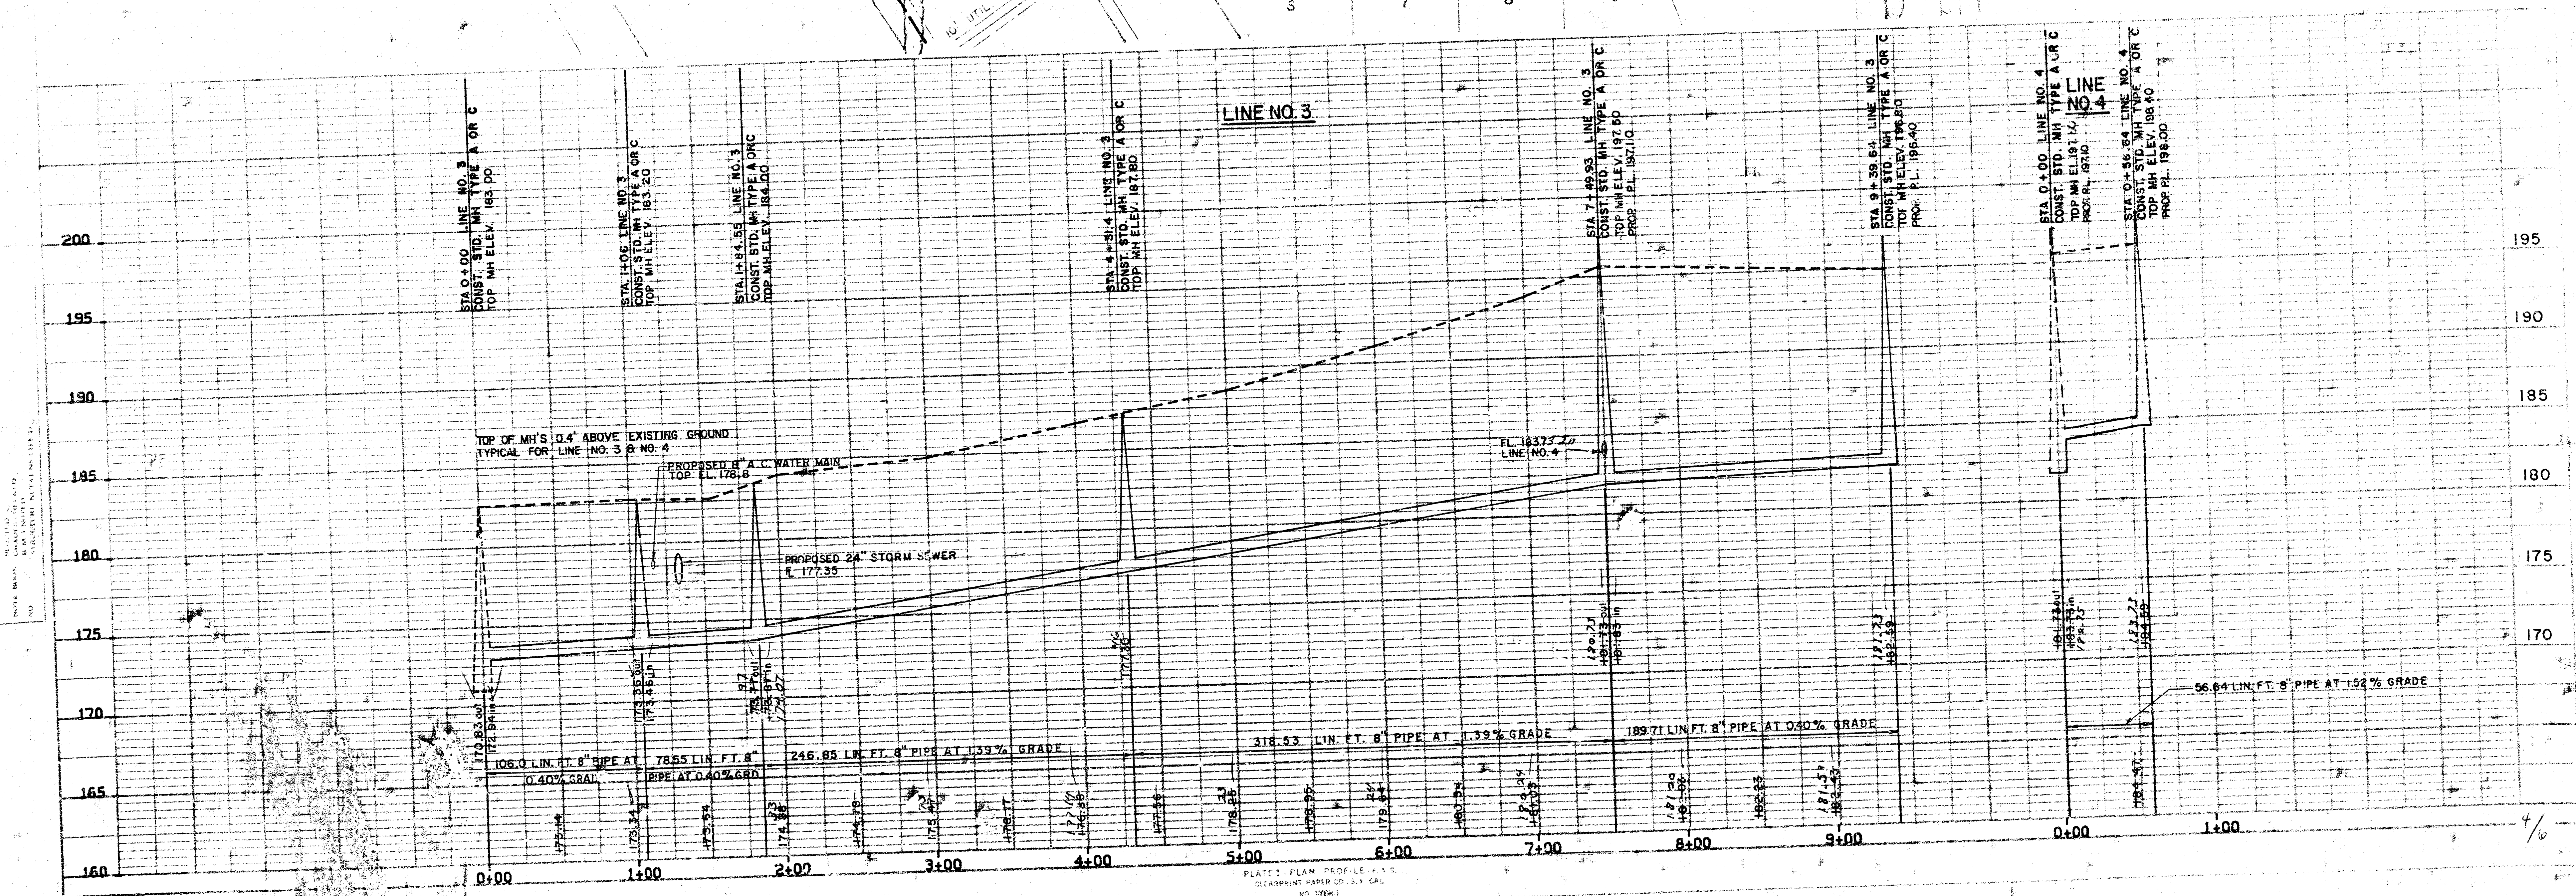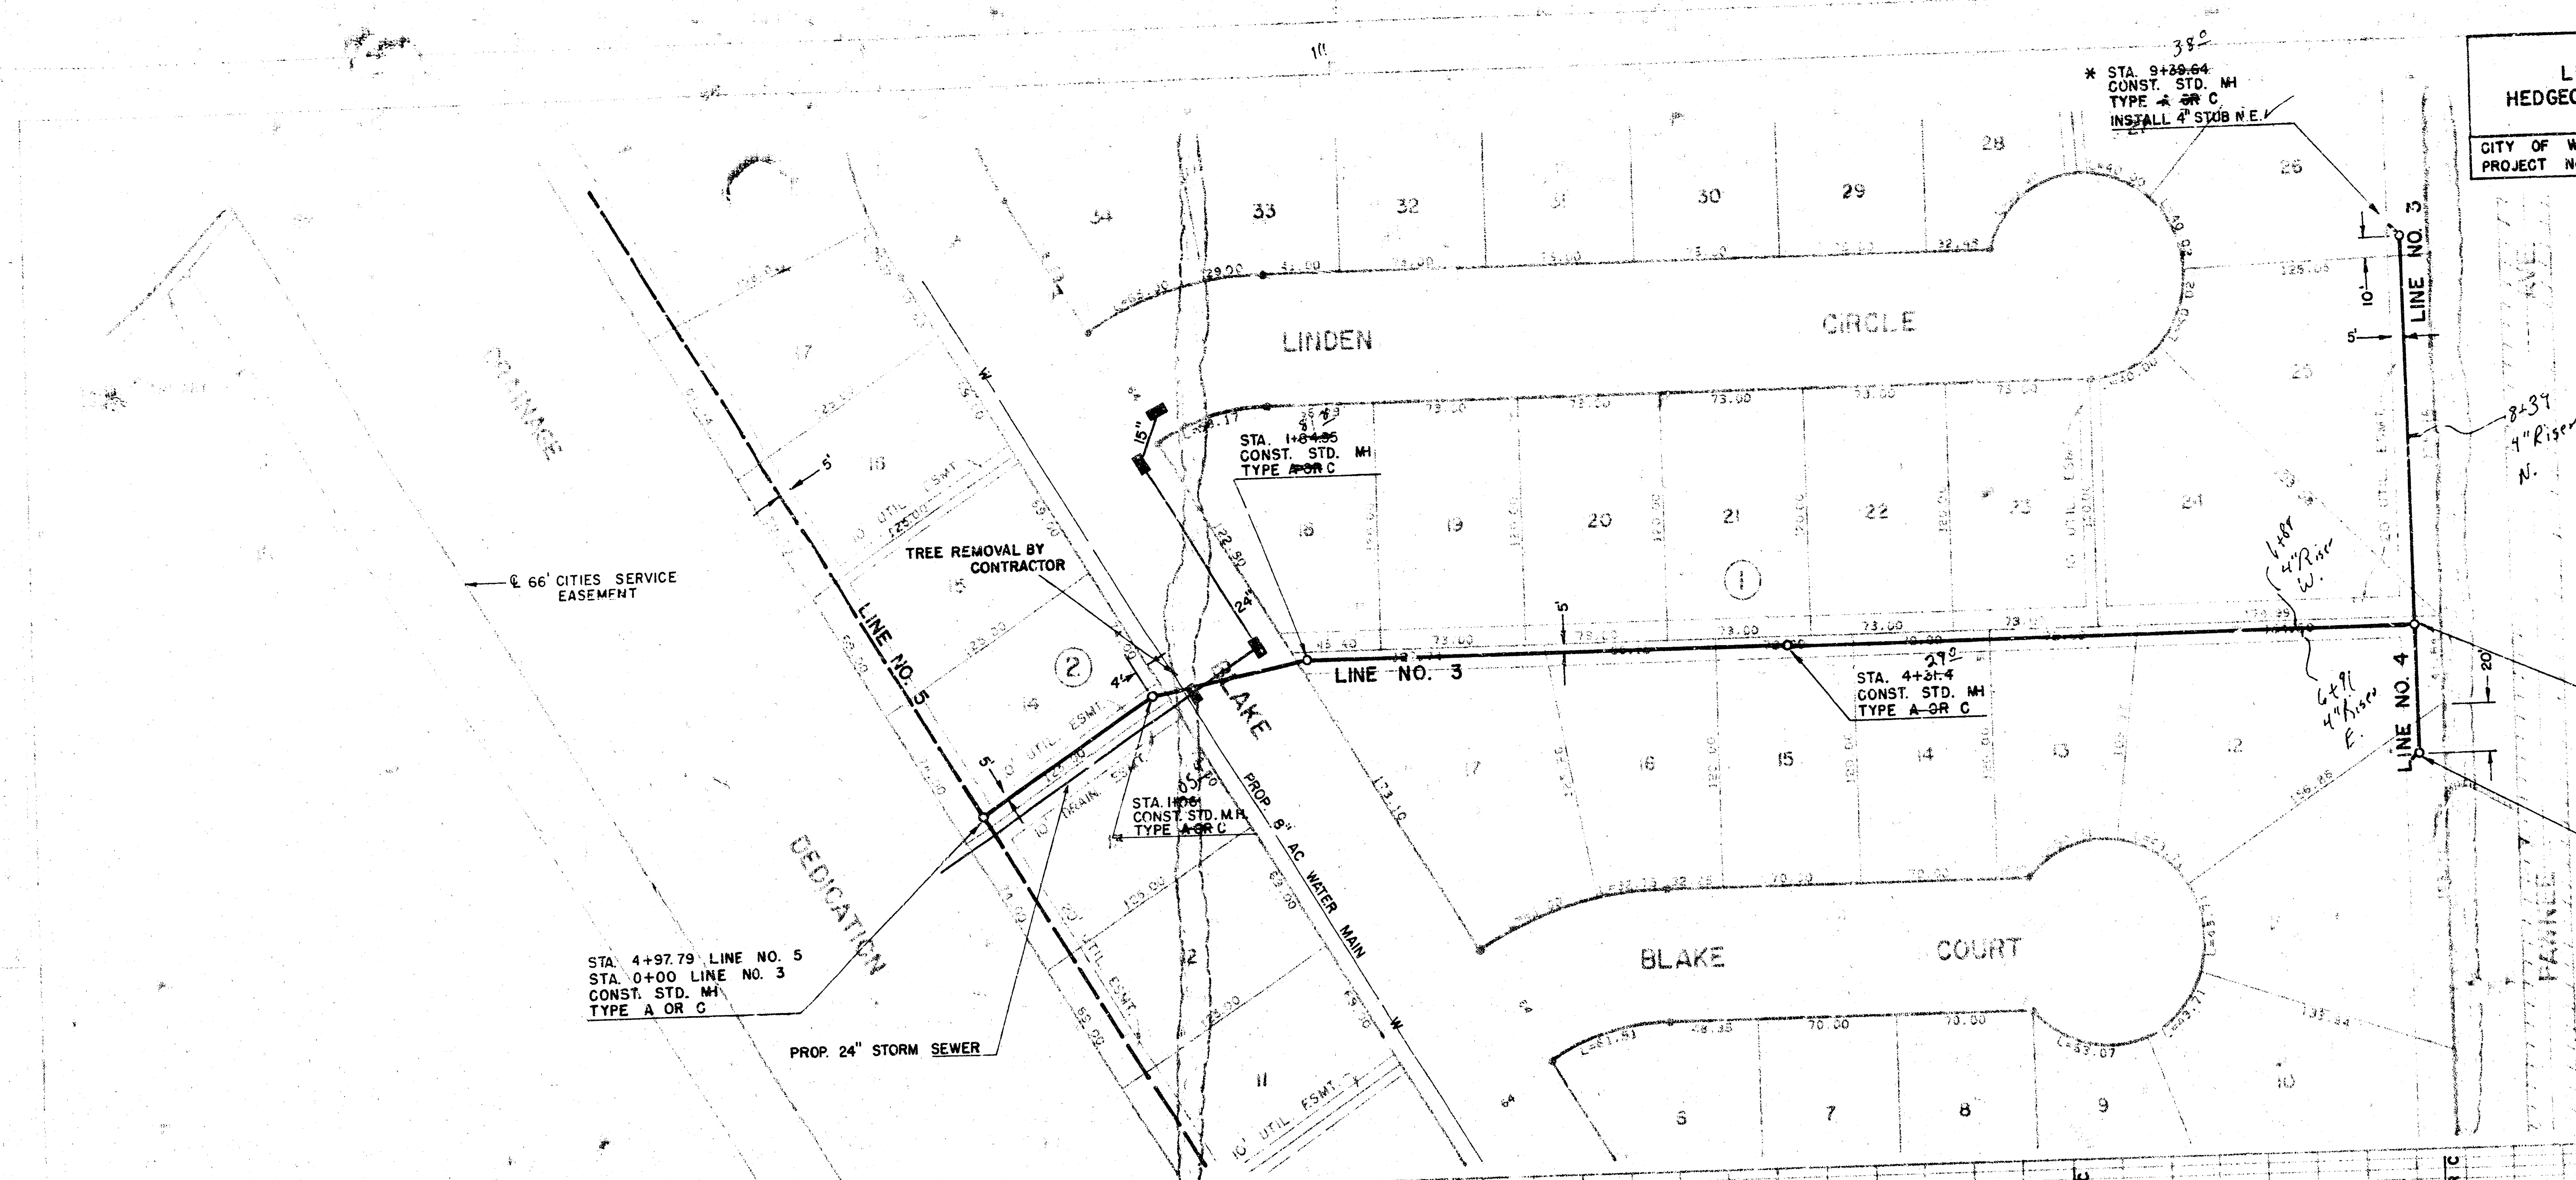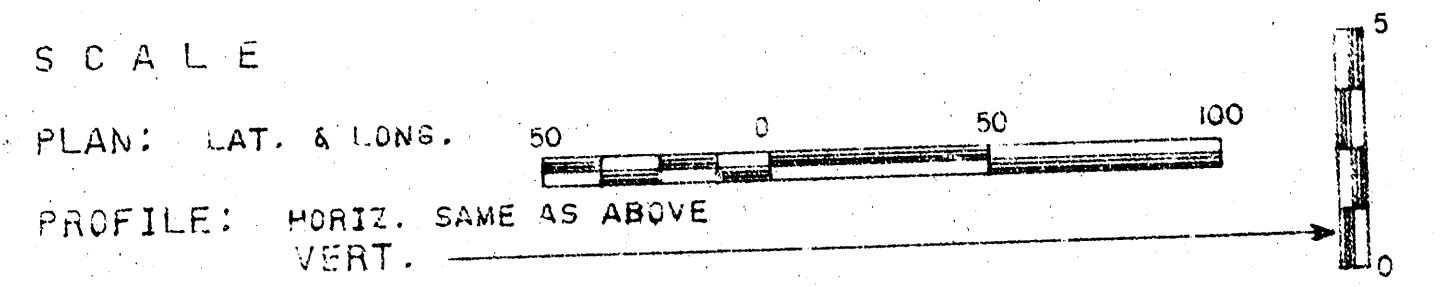

LINE NO. 5 HEDGECLIFF 2ND ADDN.		SCALE AS NOTED DATE 6-24-81 SHEET 5 OF 6	DEISS & GOODNESS ENGINEERS 2160 WEST 31 ST STREET WICHITA, KANSAS 67203 (316) 832-0213
CITY OF WICHITA - LATERAL 66 - WAR INDUSTRIES SEWER PROJECT NO. 468 76 245 81056 000.000.001		REV'D 9-8-81	

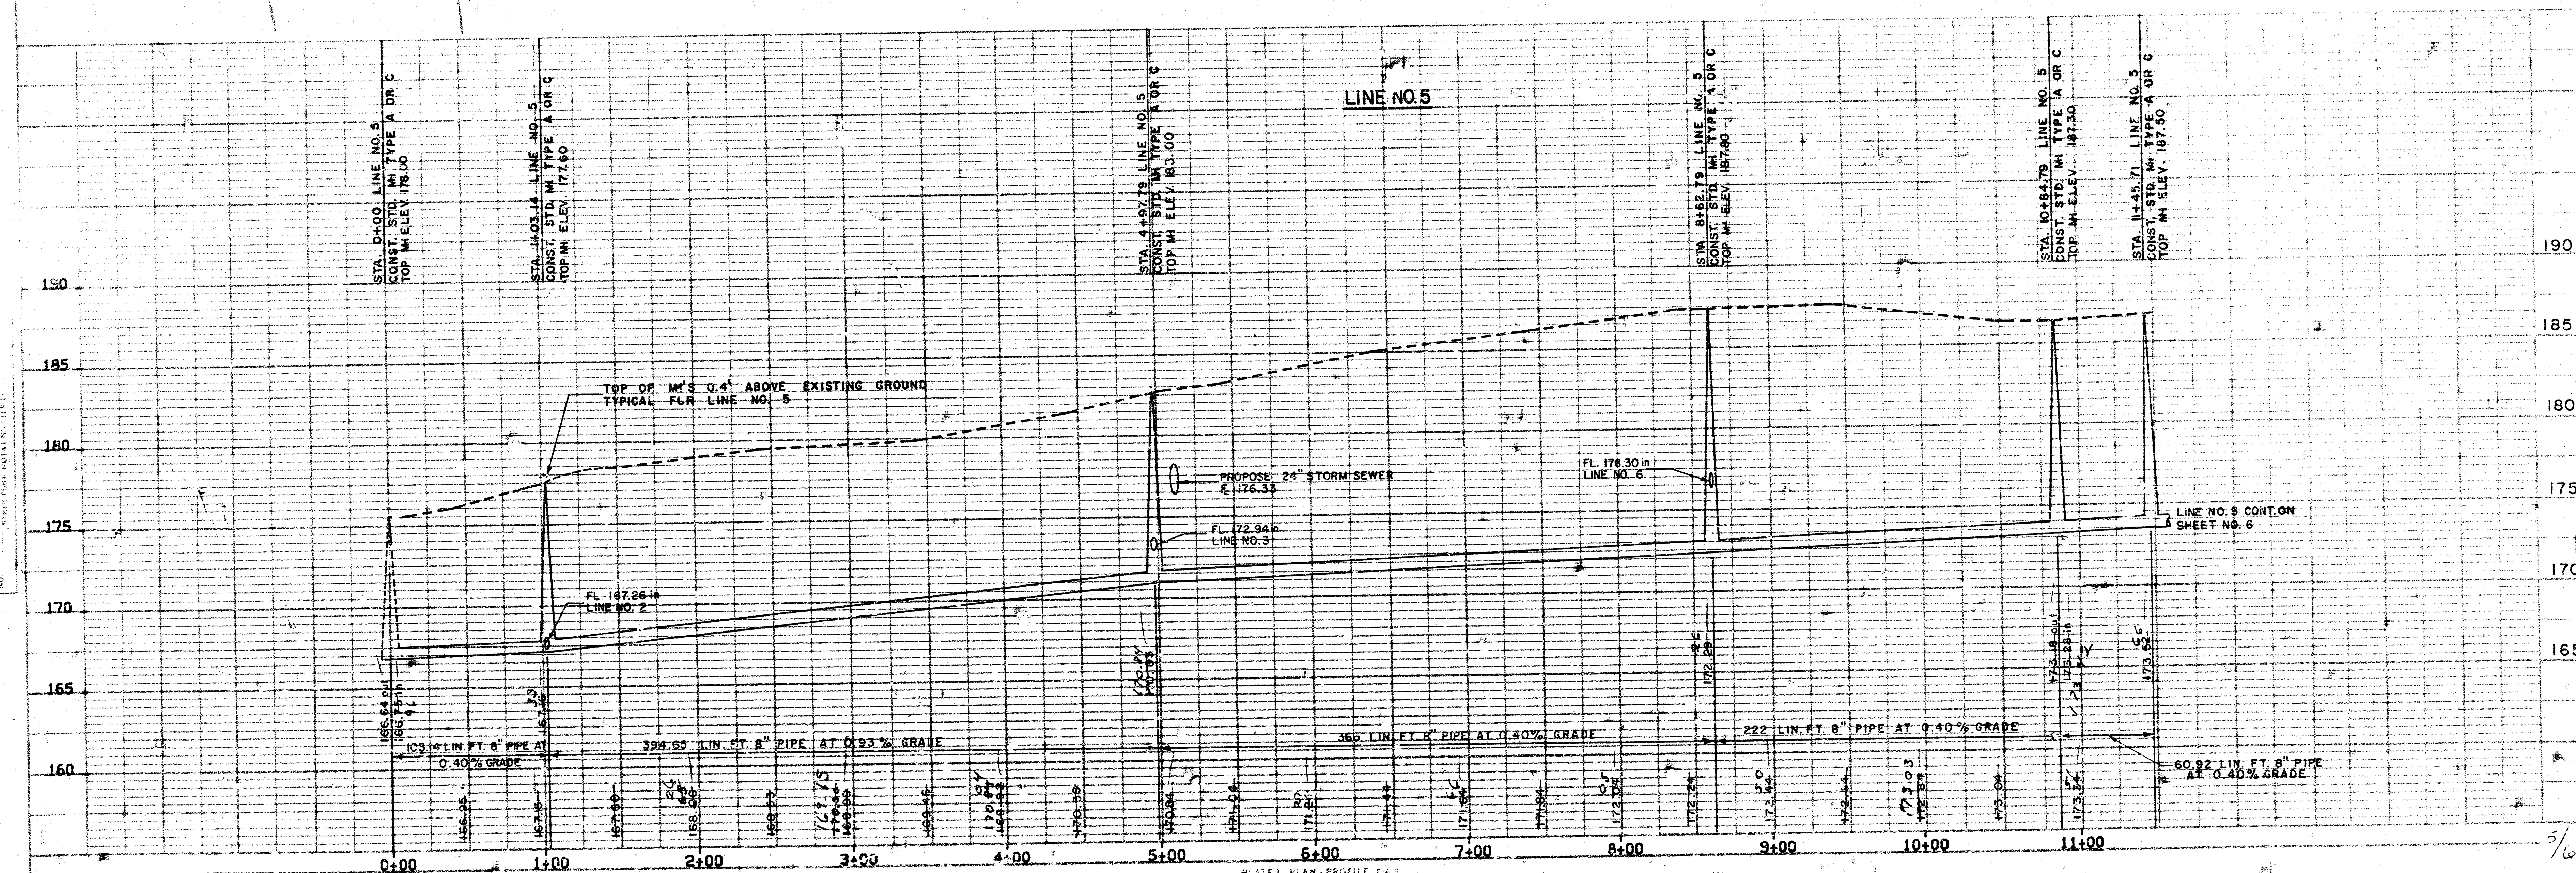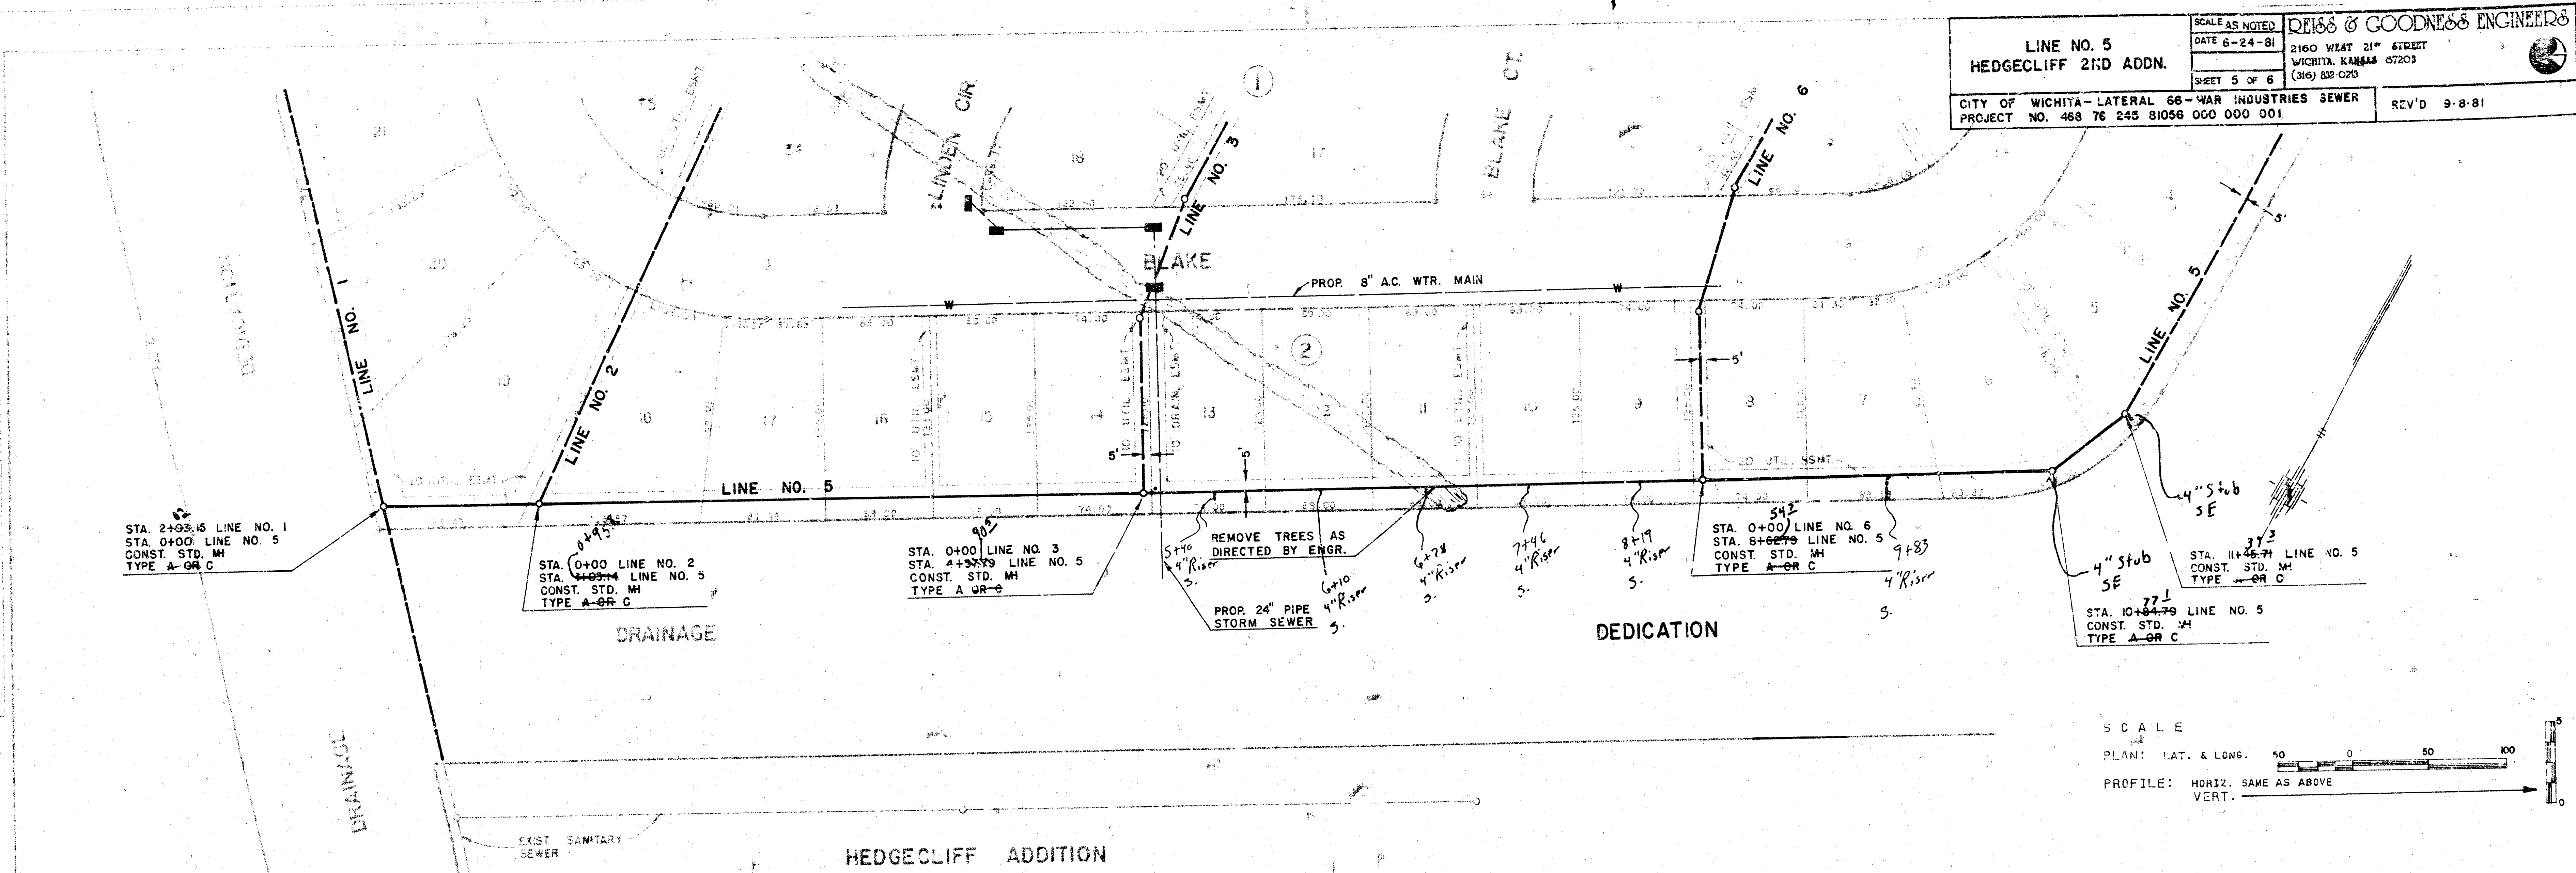

PLAN

PROFILES

PLAN
 DATE: 5-24-81
 BY: J.L.L.
 CHECKED: J.L.L.
 NO. 1

PROFILE
 DATE: 5-24-81
 BY: J.L.L.
 CHECKED: J.L.L.
 NO. 1

LINE NO. 5 AND 6 HEDGECLIFF 2ND ADDN.		80% AS NOTED DATE 5-24-81 SHEET 6 OF 6	DEISS & GOODNESS ENGINEERS 2100 WEST 21 ST STREET WICHITA, KANSAS 67203 (316) 832-0285
CITY OF WICHITA - LATERAL 66 - WAR INDUSTRIES SEWER PROJECT NO. 483 76 245 81056 000 000 001		RCV'D 9-3-81	

