


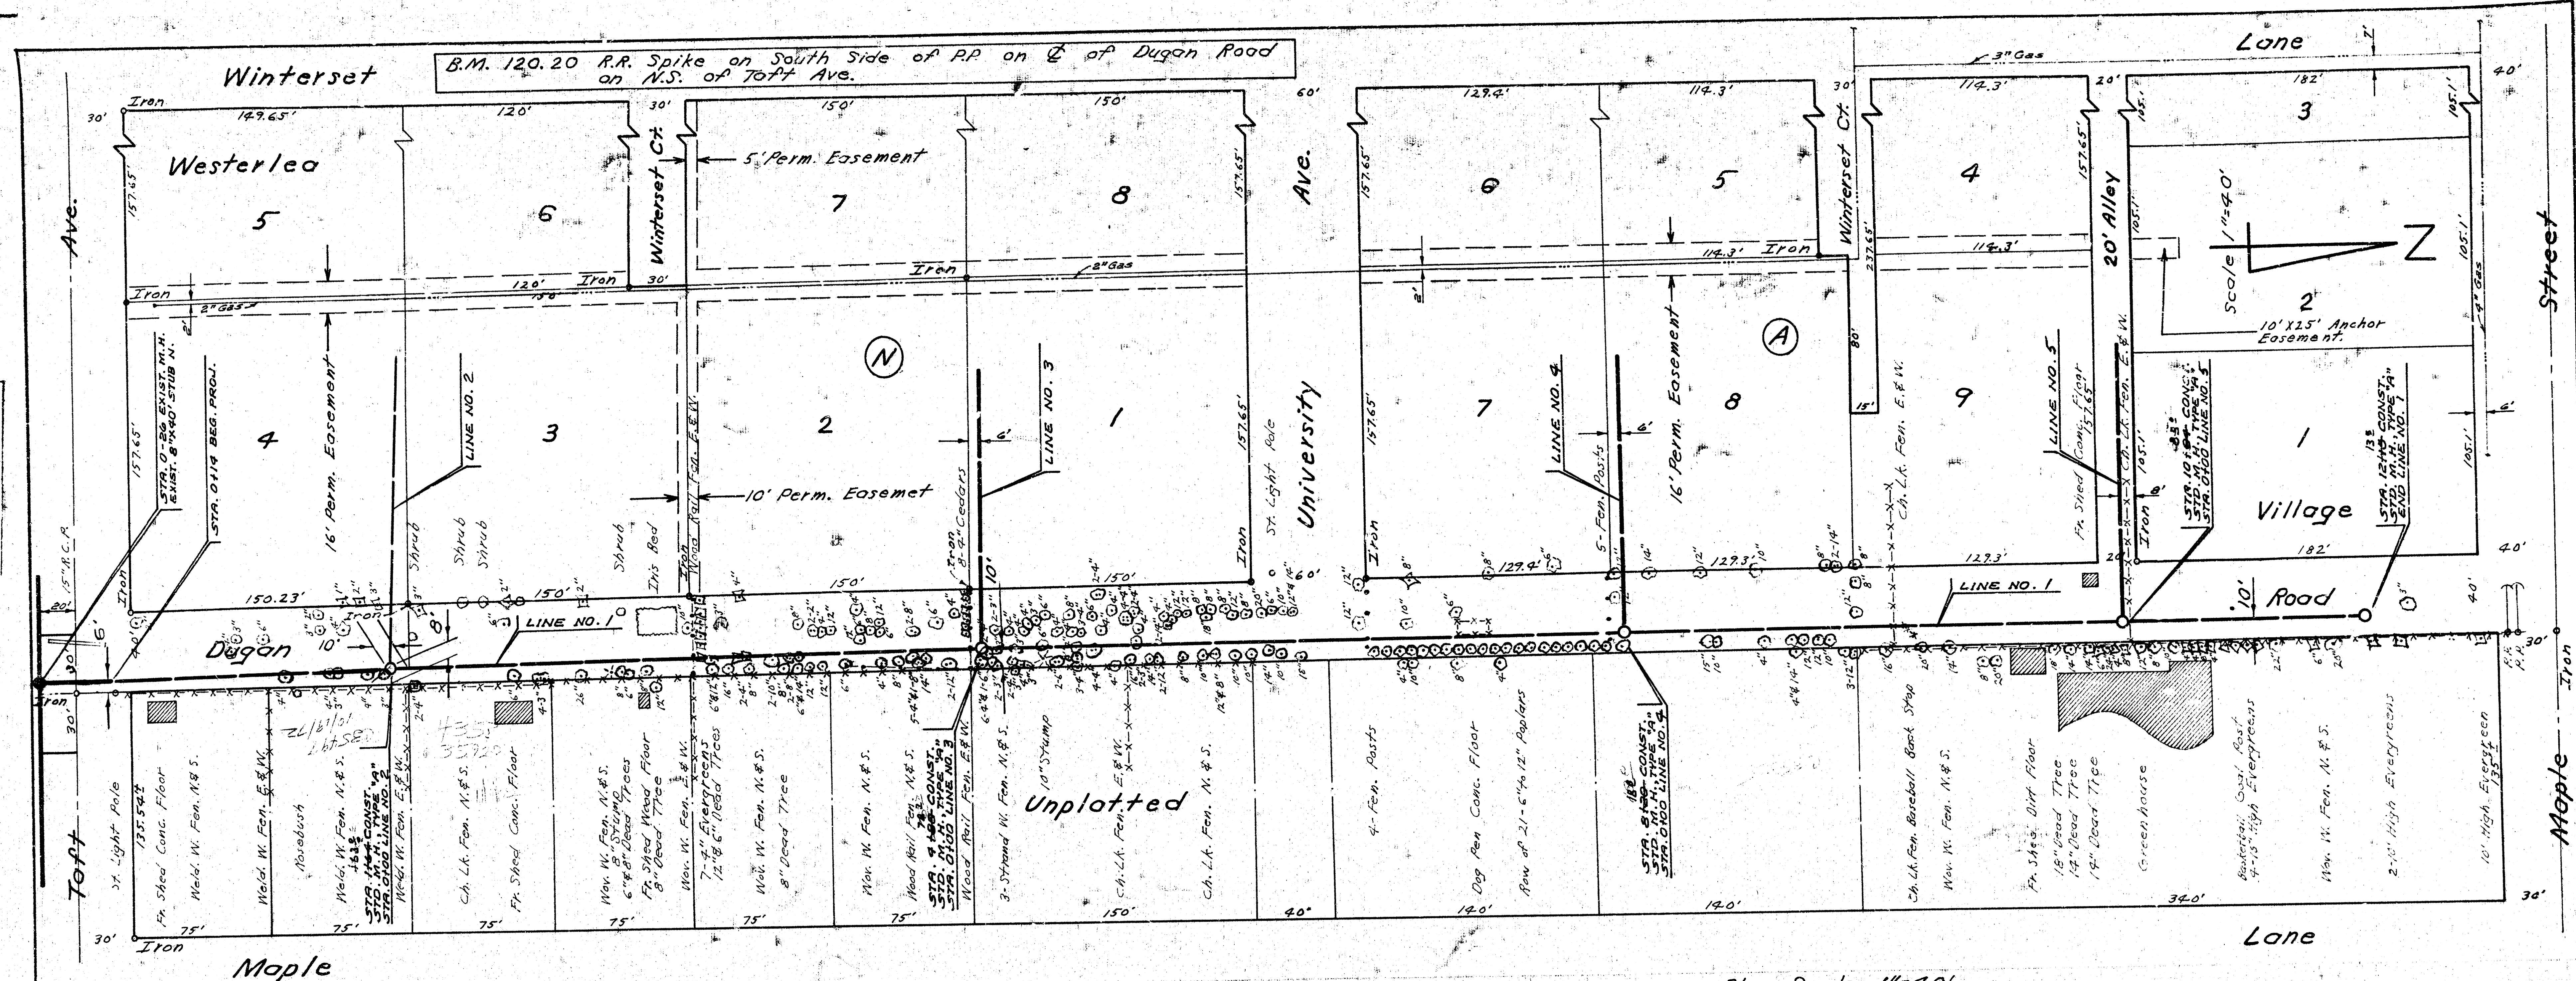


Survey Figs 54, 55, 56, 57
Plan D 22
City Engineer
City of Wichita

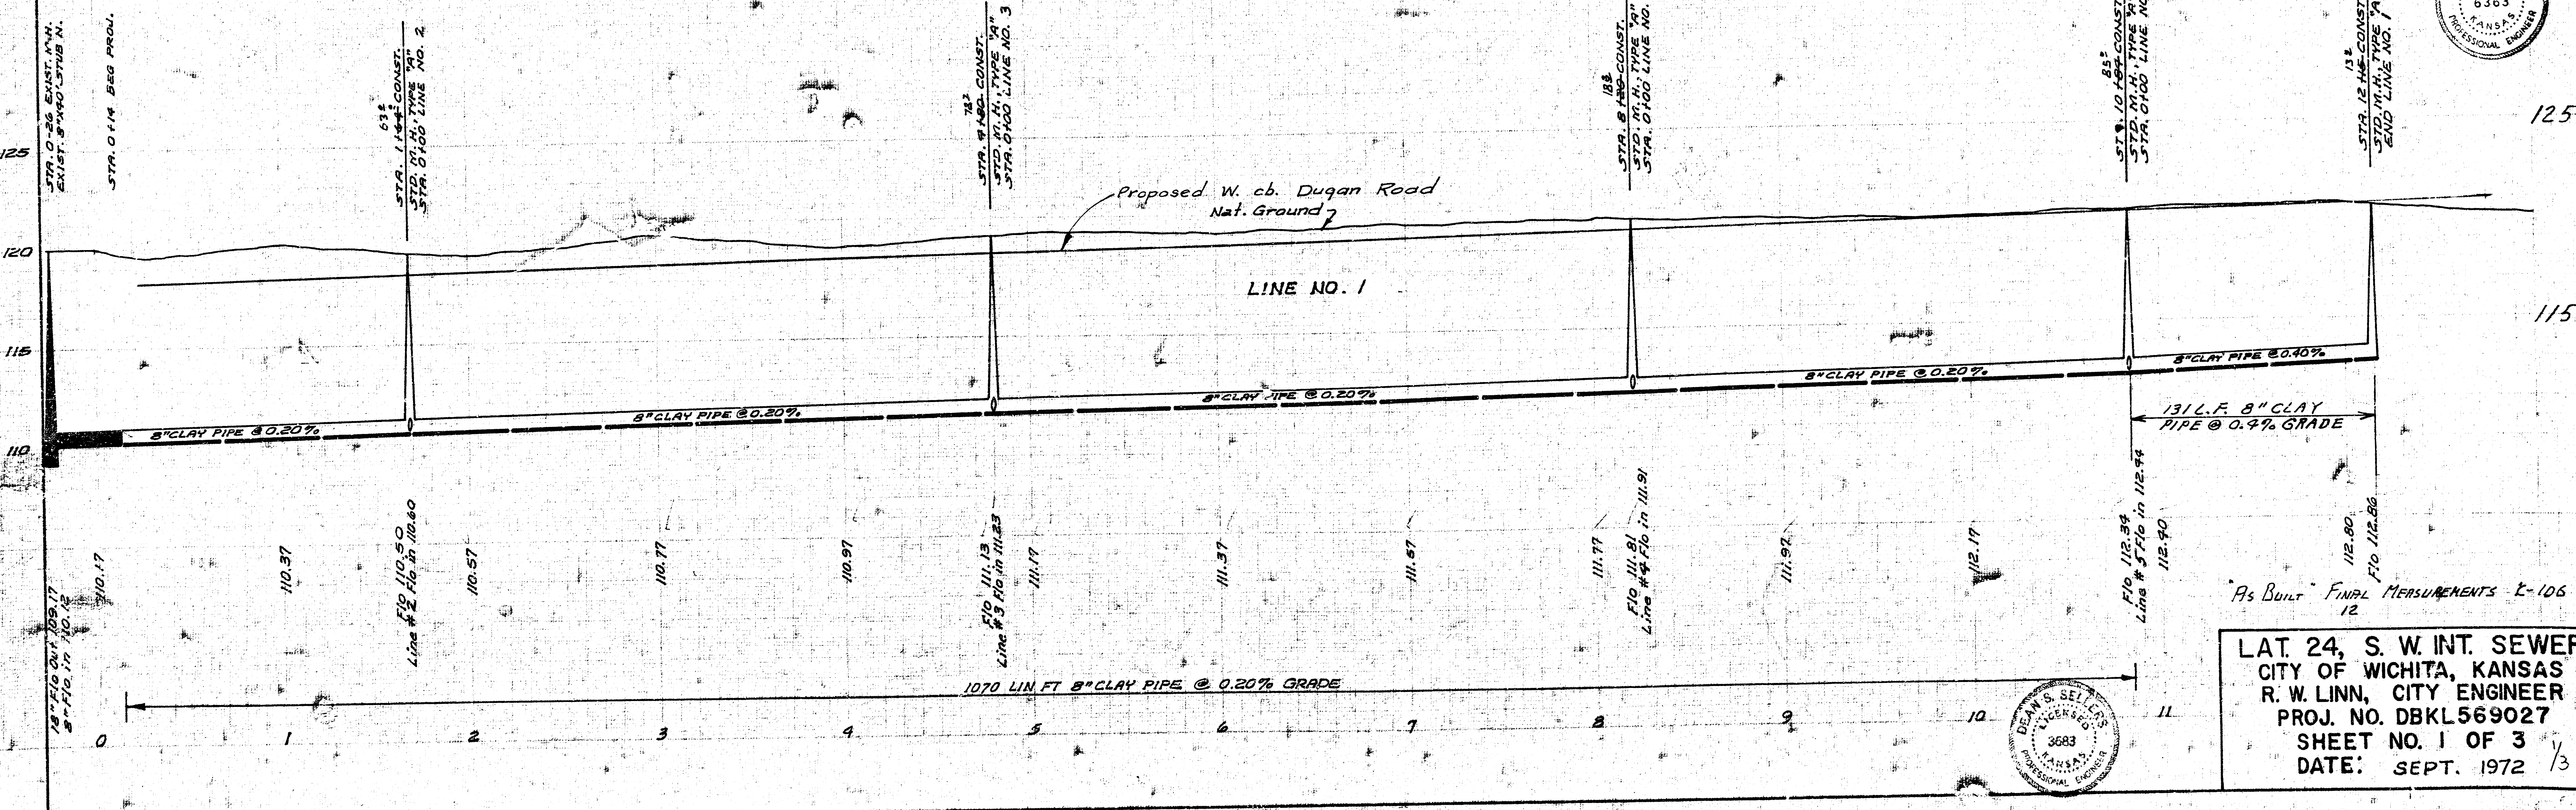

Plan Scale 1"=40'
Profile Scale Horiz. 1"=40'
Vert. 1"=4'

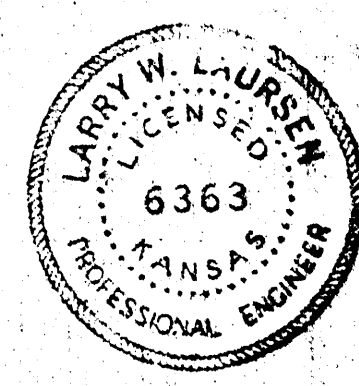


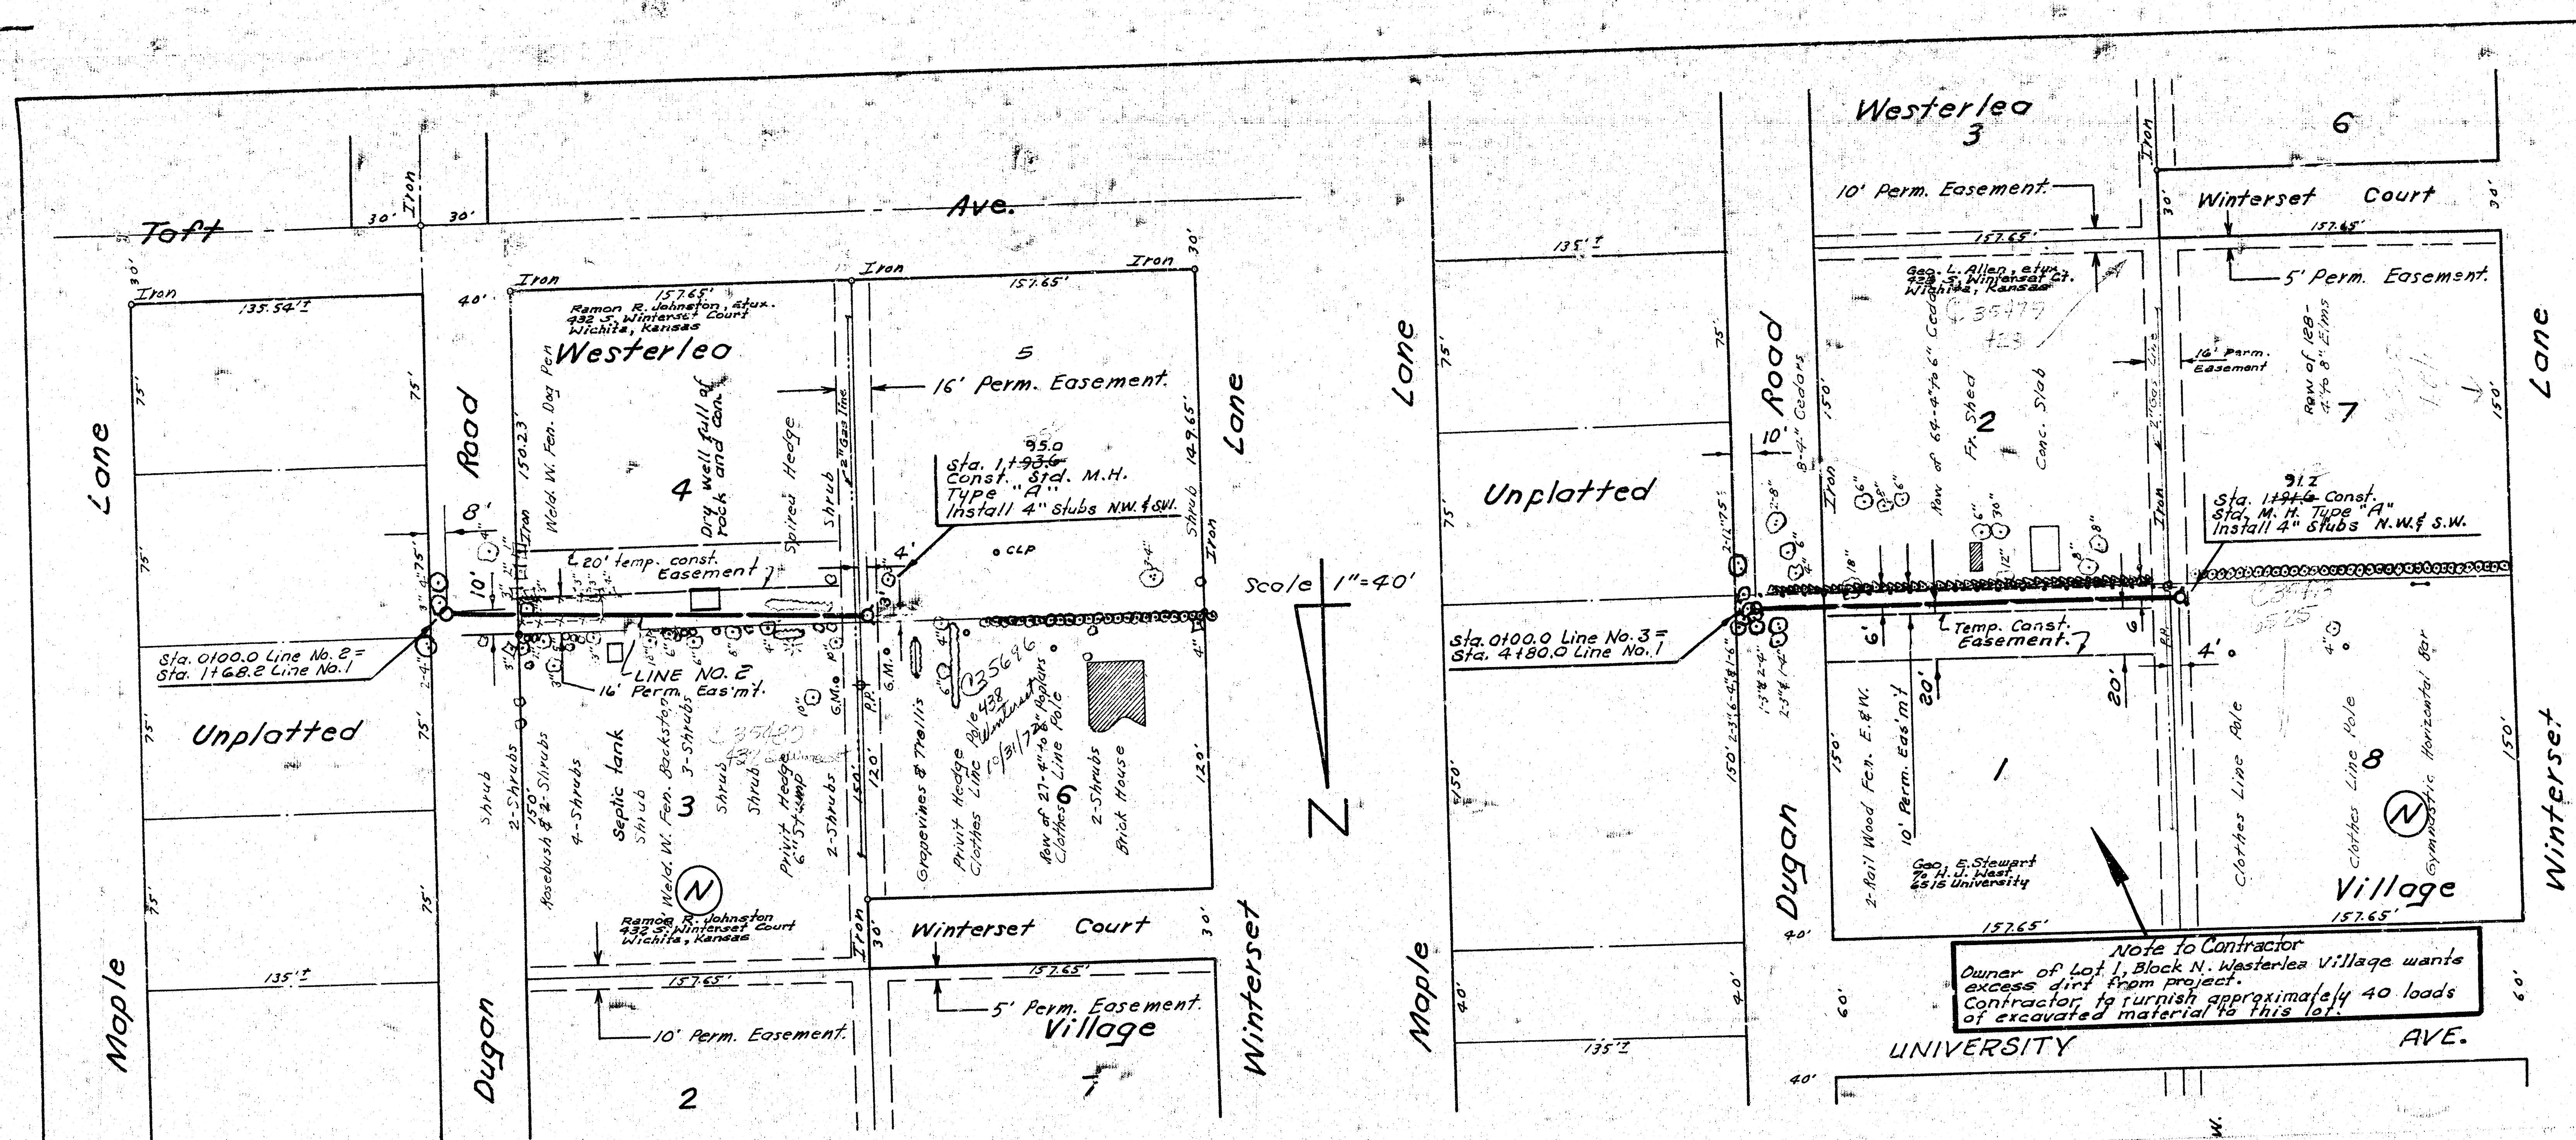


NOTE:
 The lump sum for clearing of R/W is to include the removing of hedge, trees and stumps.
 All lateral fields crossed with construction San-sewer shall be replaced thru sewer trench and shall be considered incidental to project.

Note to Contractor
 Owner of Lot 1, Block N, Westerlea Village wants excess dirt from project.
 Contractor to furnish approximately 40 loads of excavated material to this lot.

Plan Scale 1"=40'
 Profile Scale Hor. 1"=40'
 Vert. 1"=4'

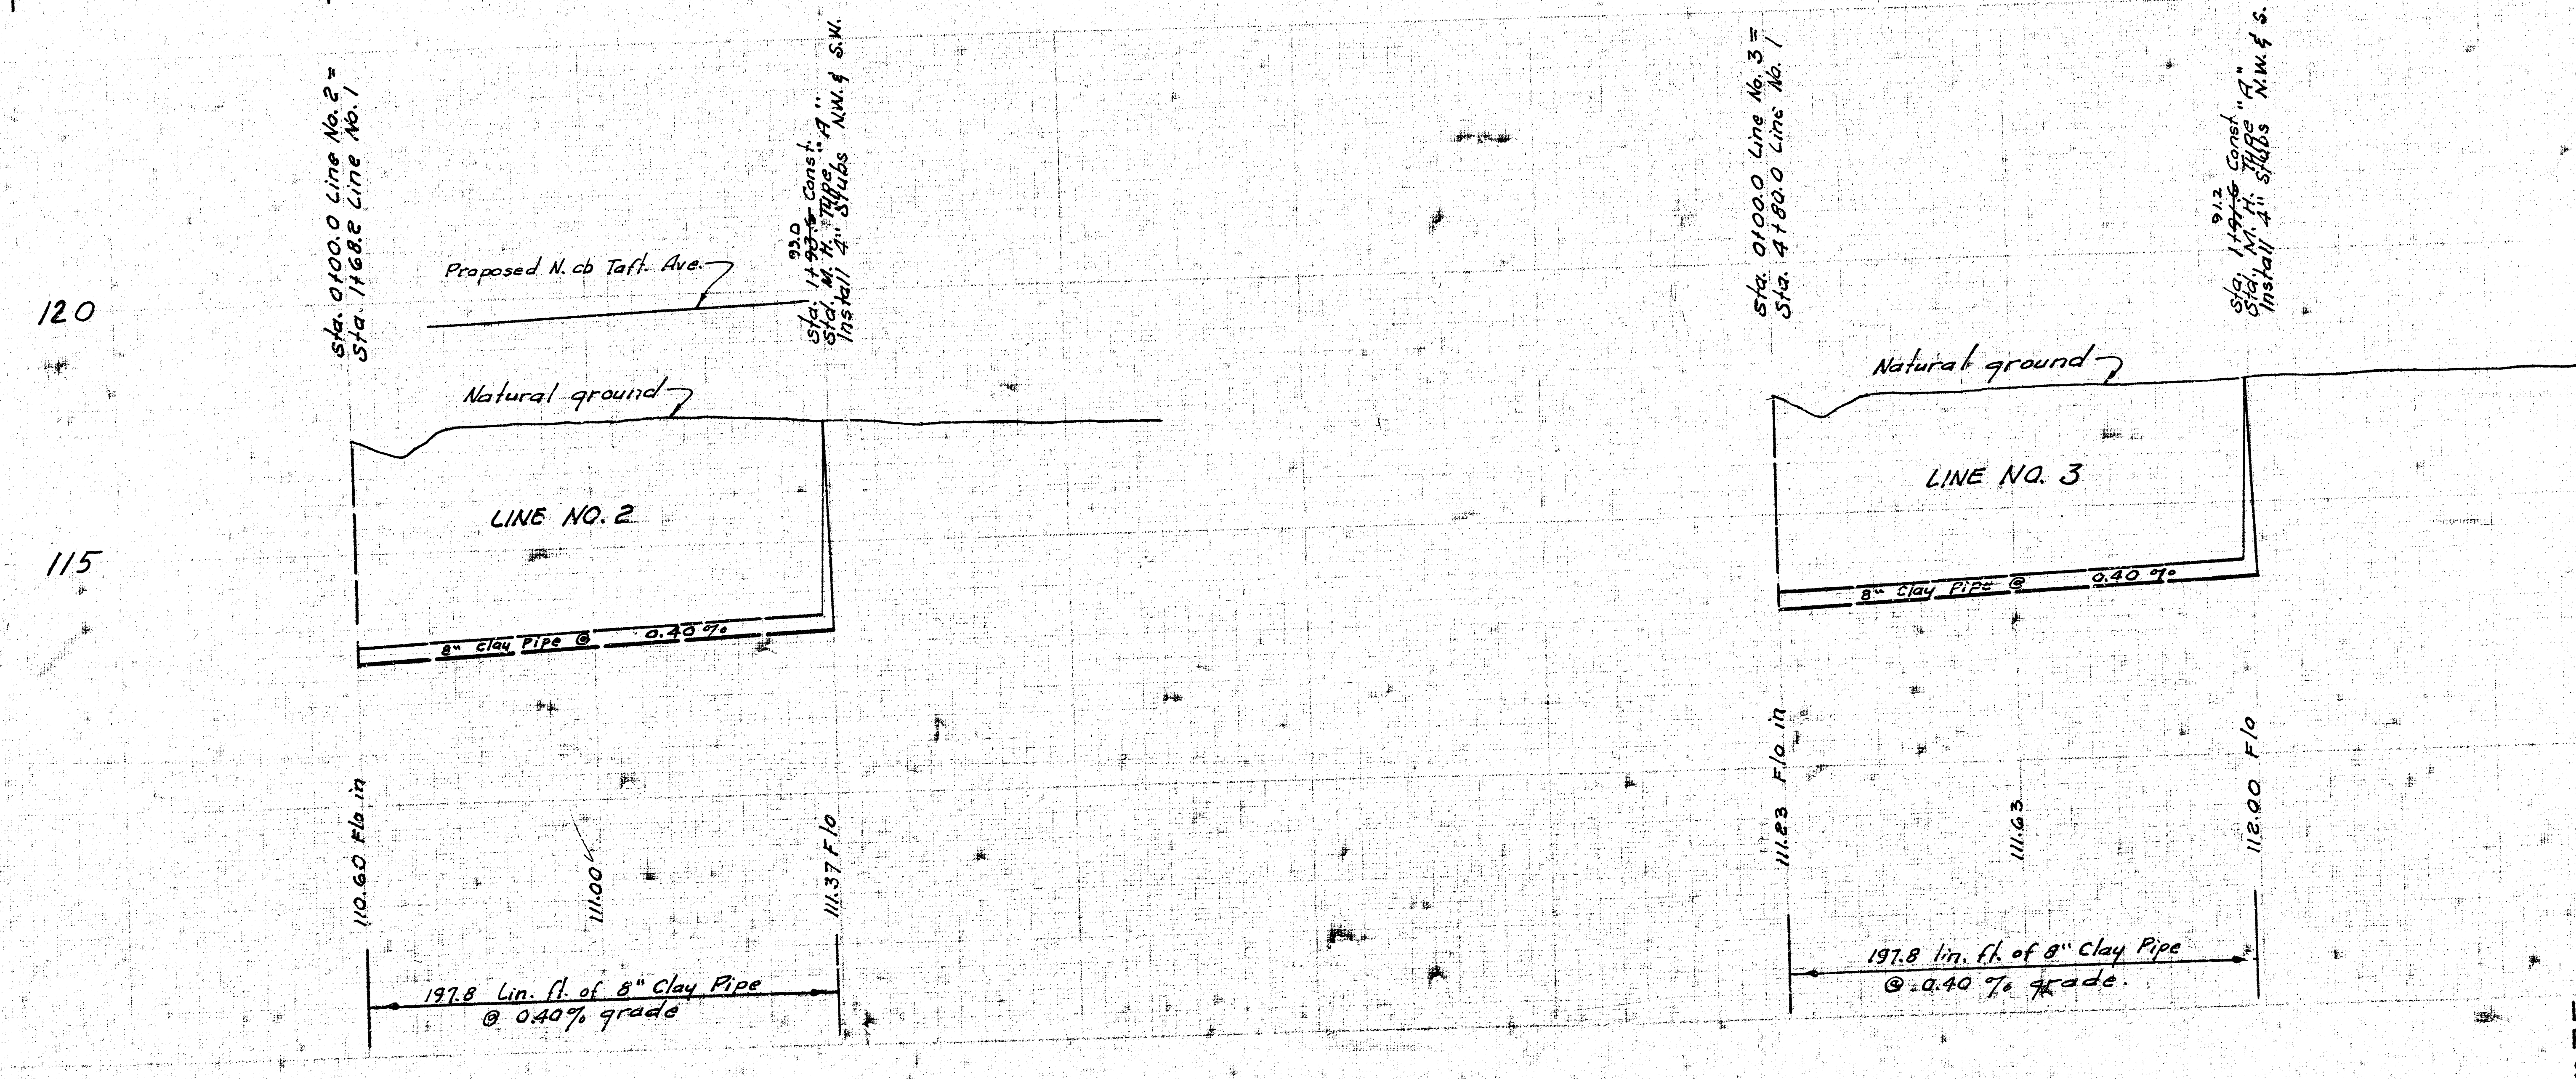

LAT. 24, S. W. INT. SEWER
 PROJ. NO. DBKL569027
 SHEET NO. 2 OF 3

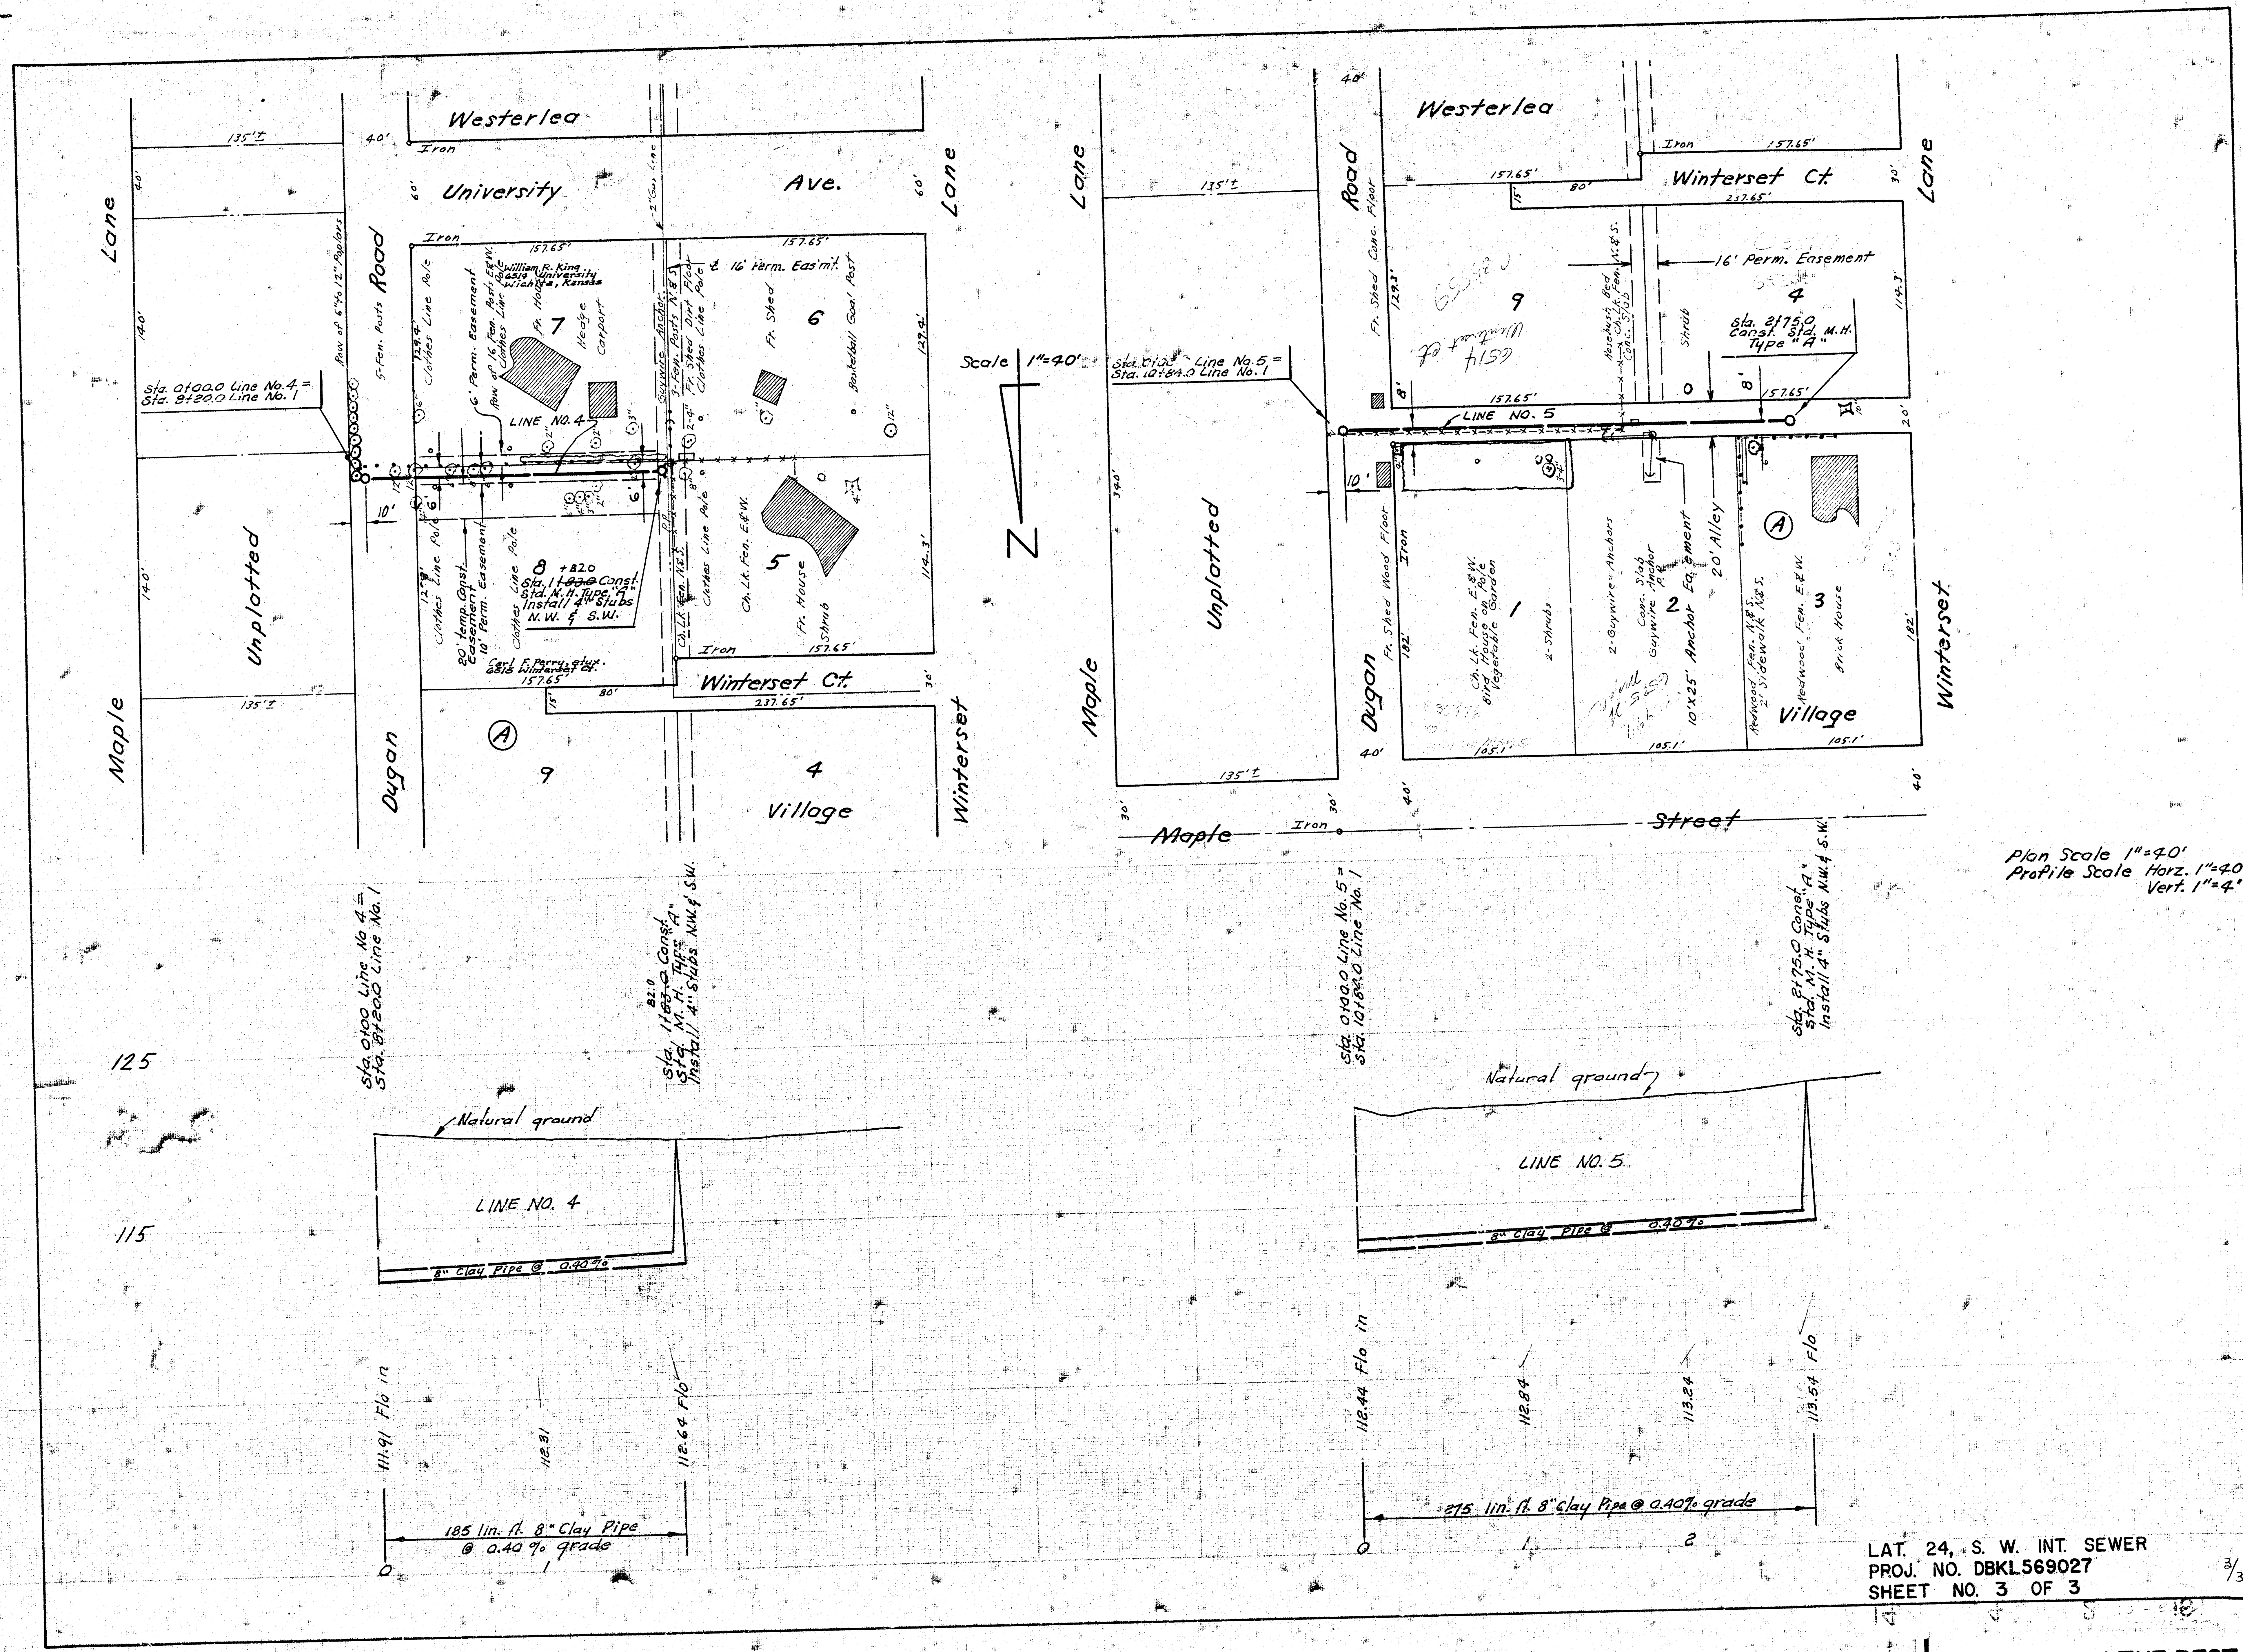

Scale 1"=40'

Plan Scale 1"=40'
Profile Scale Horiz. 1"=40'
Vert. 1"=4'

