



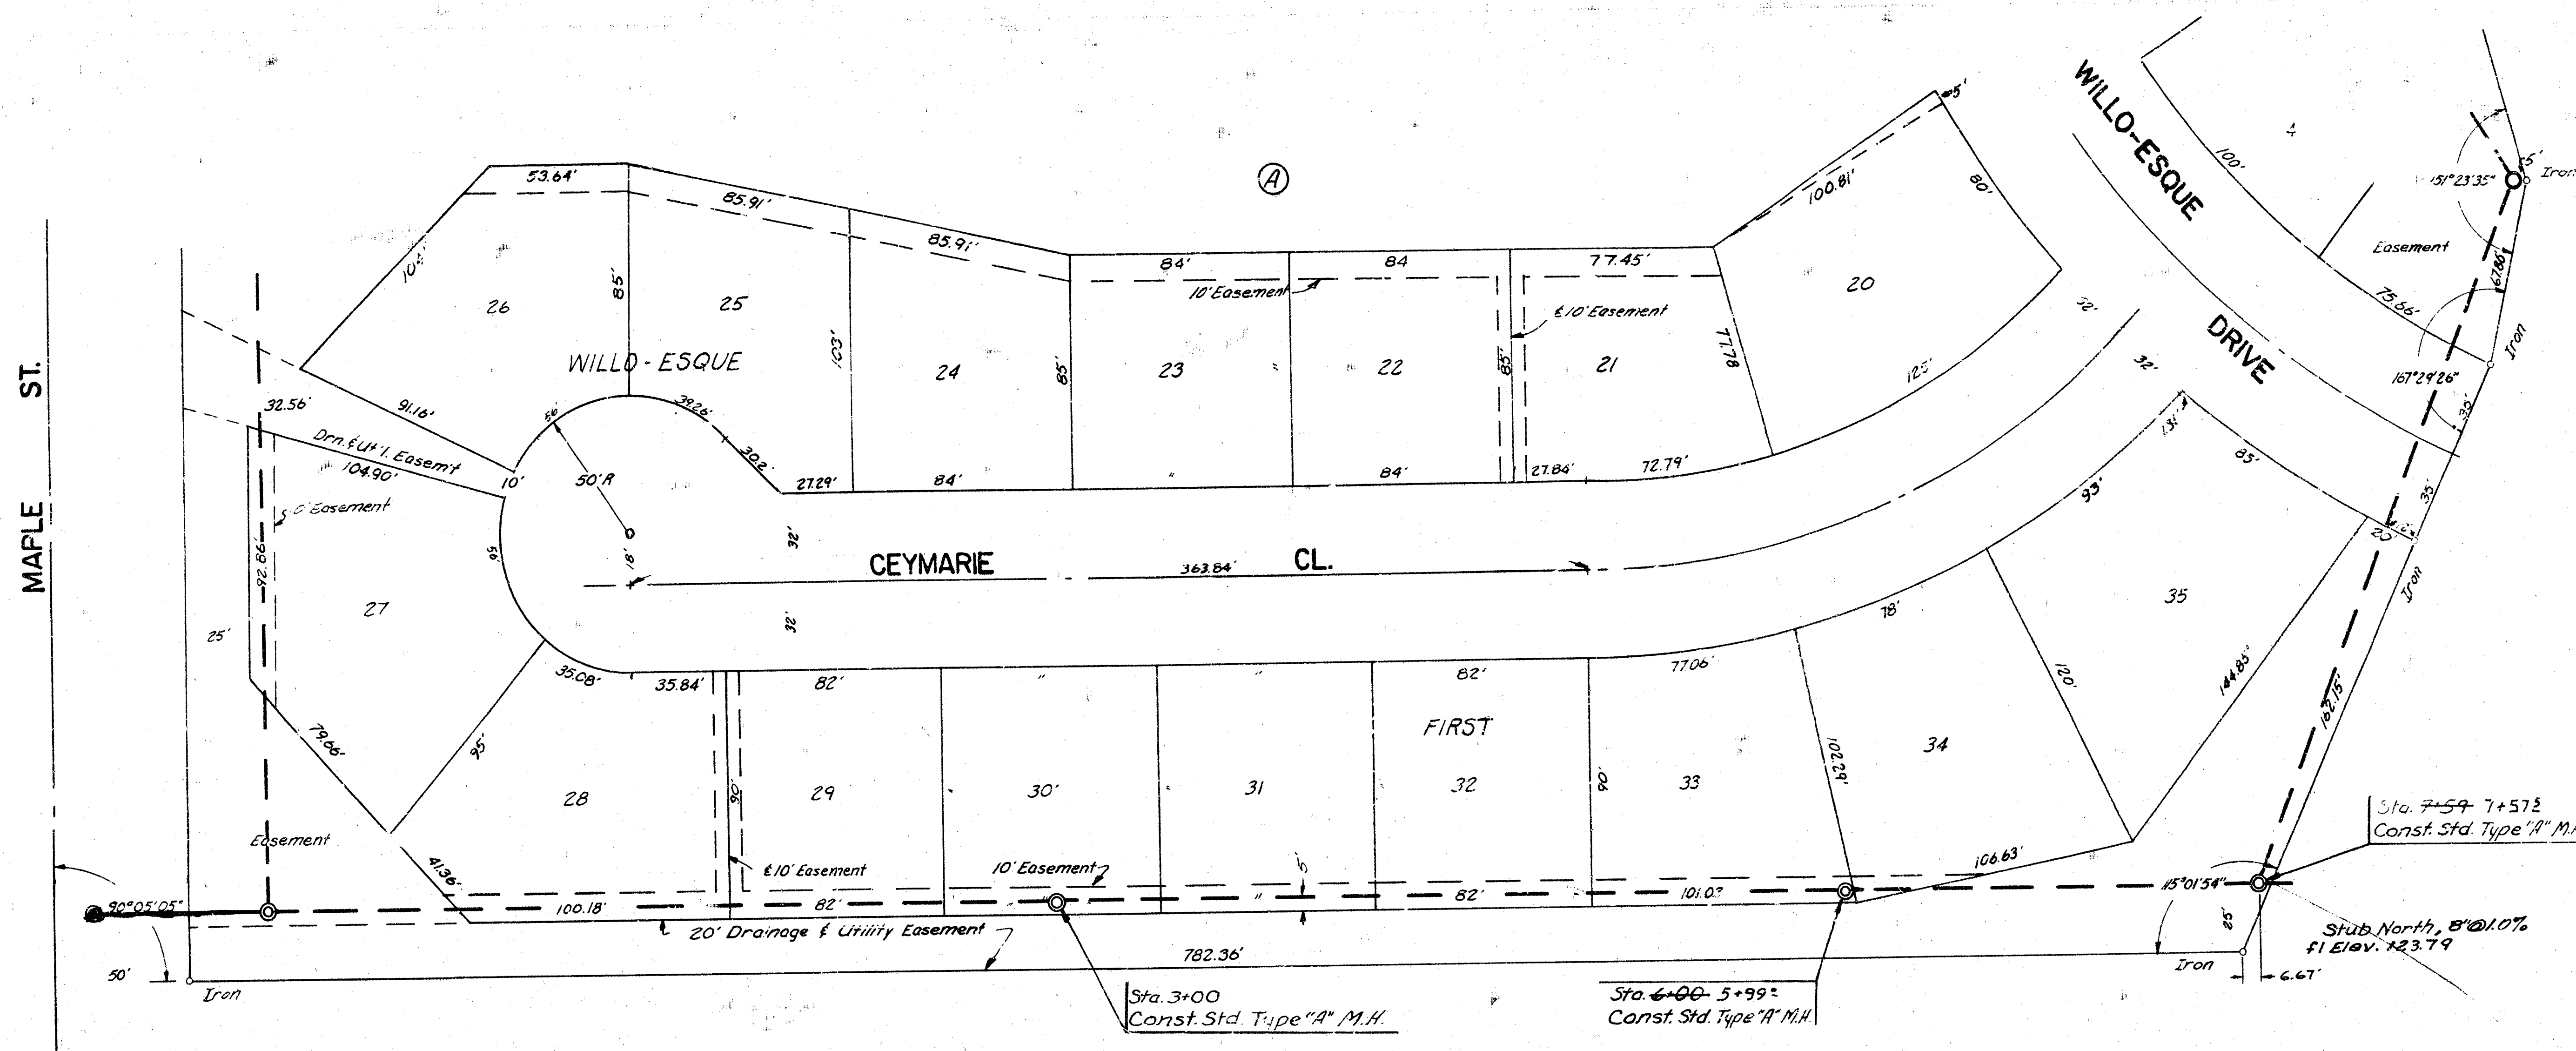


Plan Scale: 1" = 40'
 Profile Scale: 1" = 40'
 " 1" = 5'

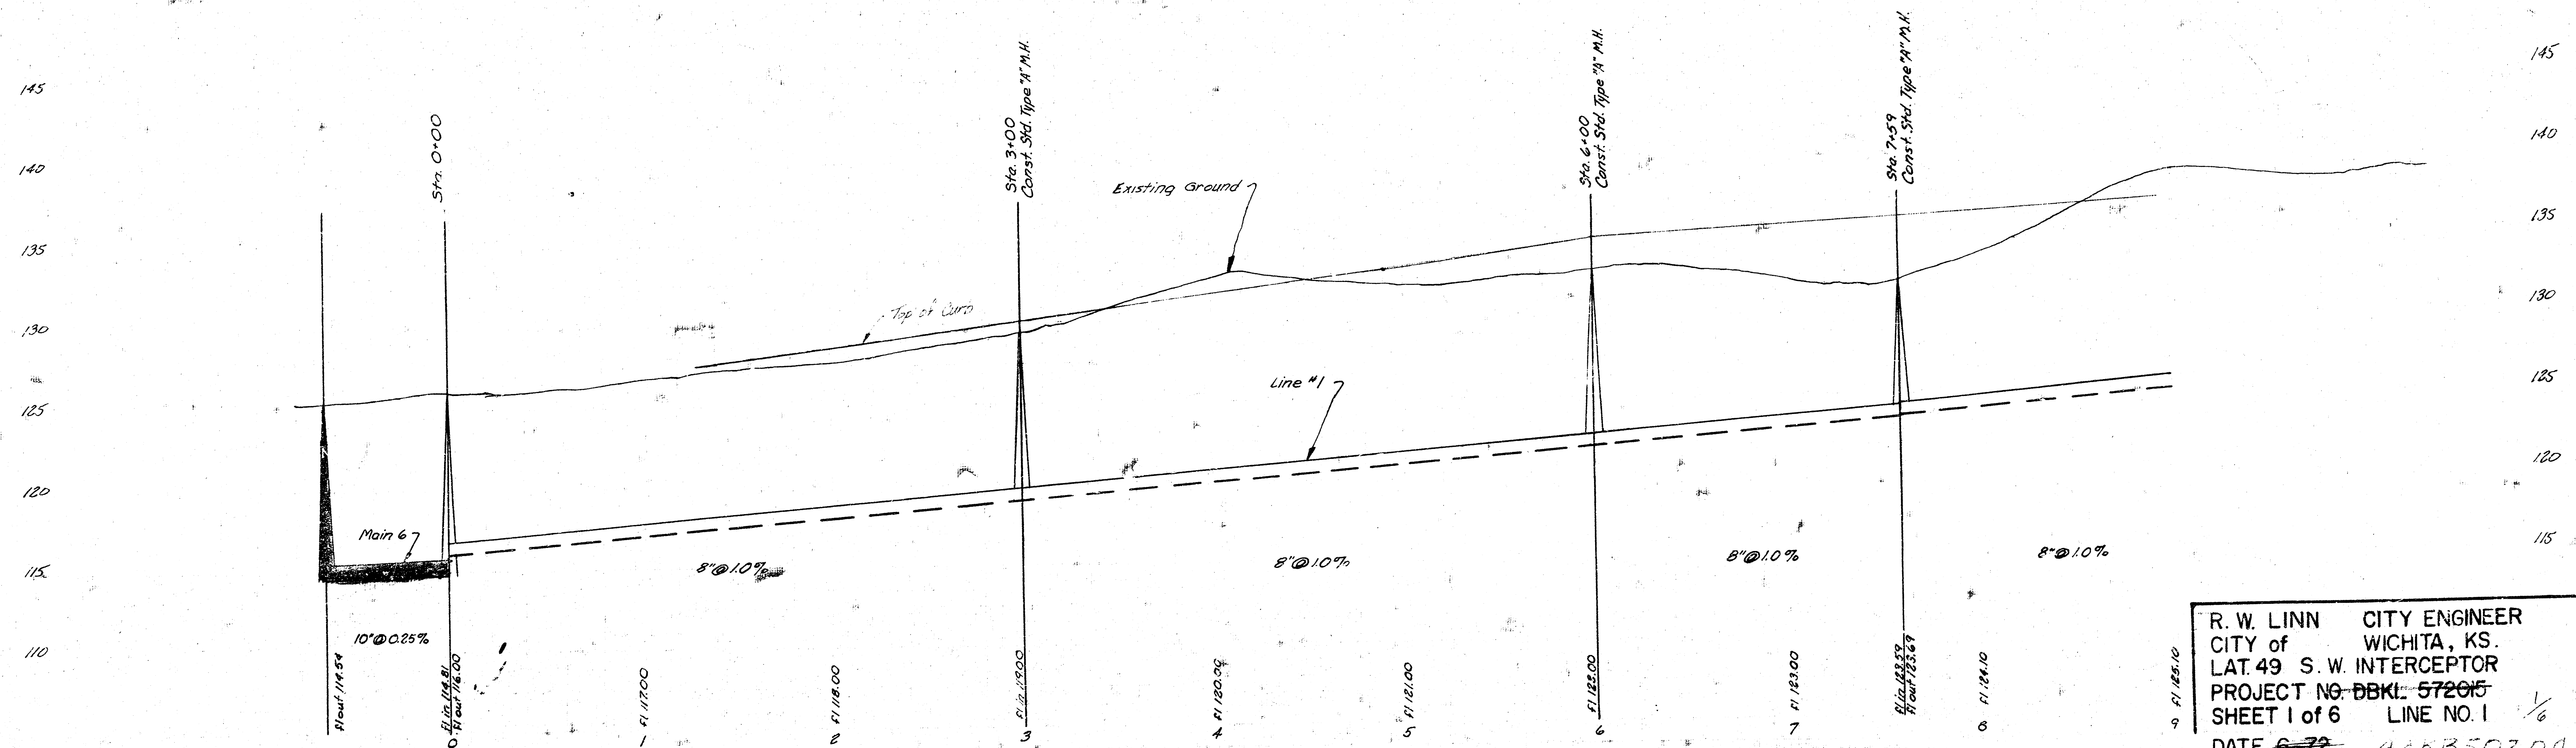


R. W. LINN CITY ENGINEER
 CITY of WICHITA, KS.
 LAT. 49 S. W. INTERCEPTOR
 PROJECT NO. DBKL 57205
 SHEET 1 of 6 LINE NO. 1
 DATE 9-72 AAKB502048
 9-72



FILMED FROM THE BEST

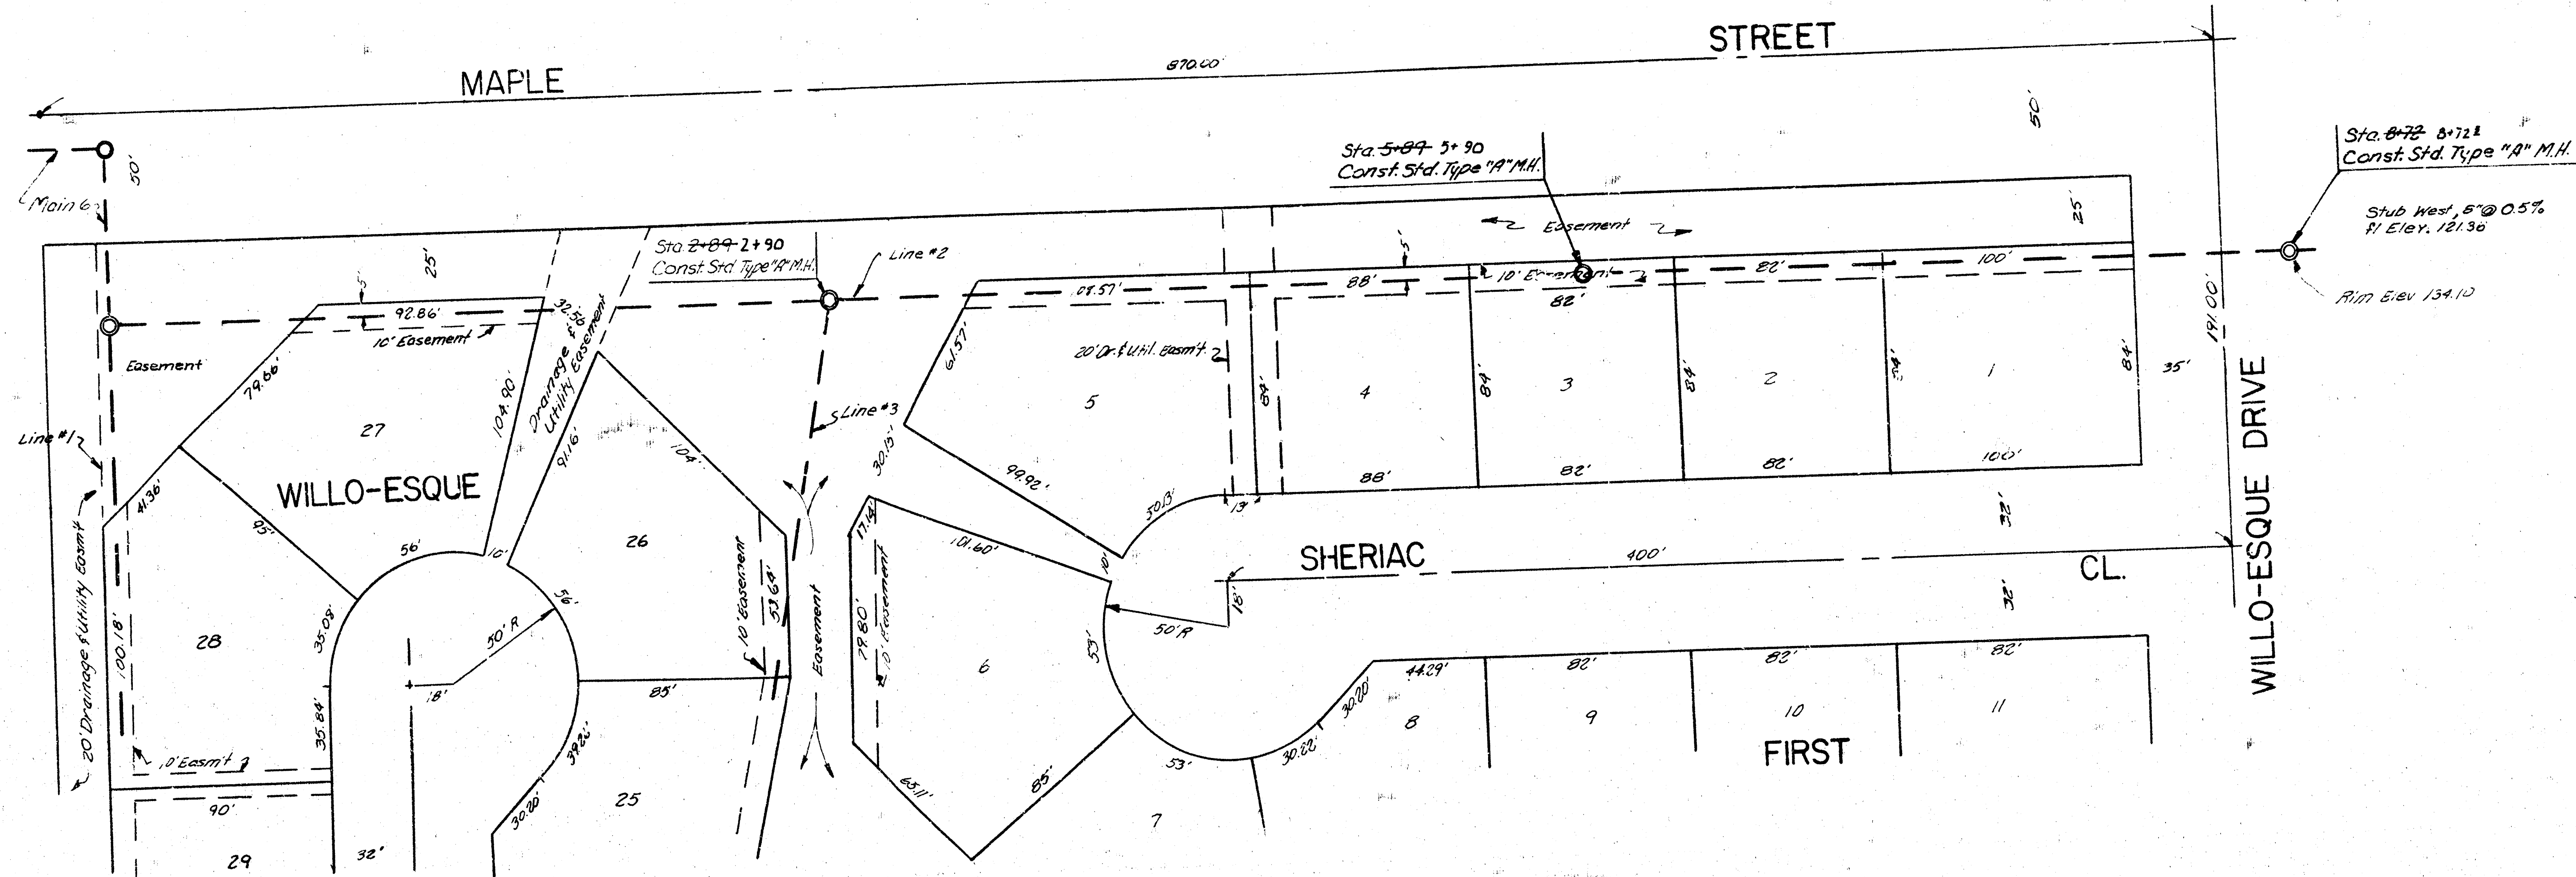


Plan Scale 1" = 40'
 Profile Scale Hor 1" = 40'
 Ver 1" = 5'

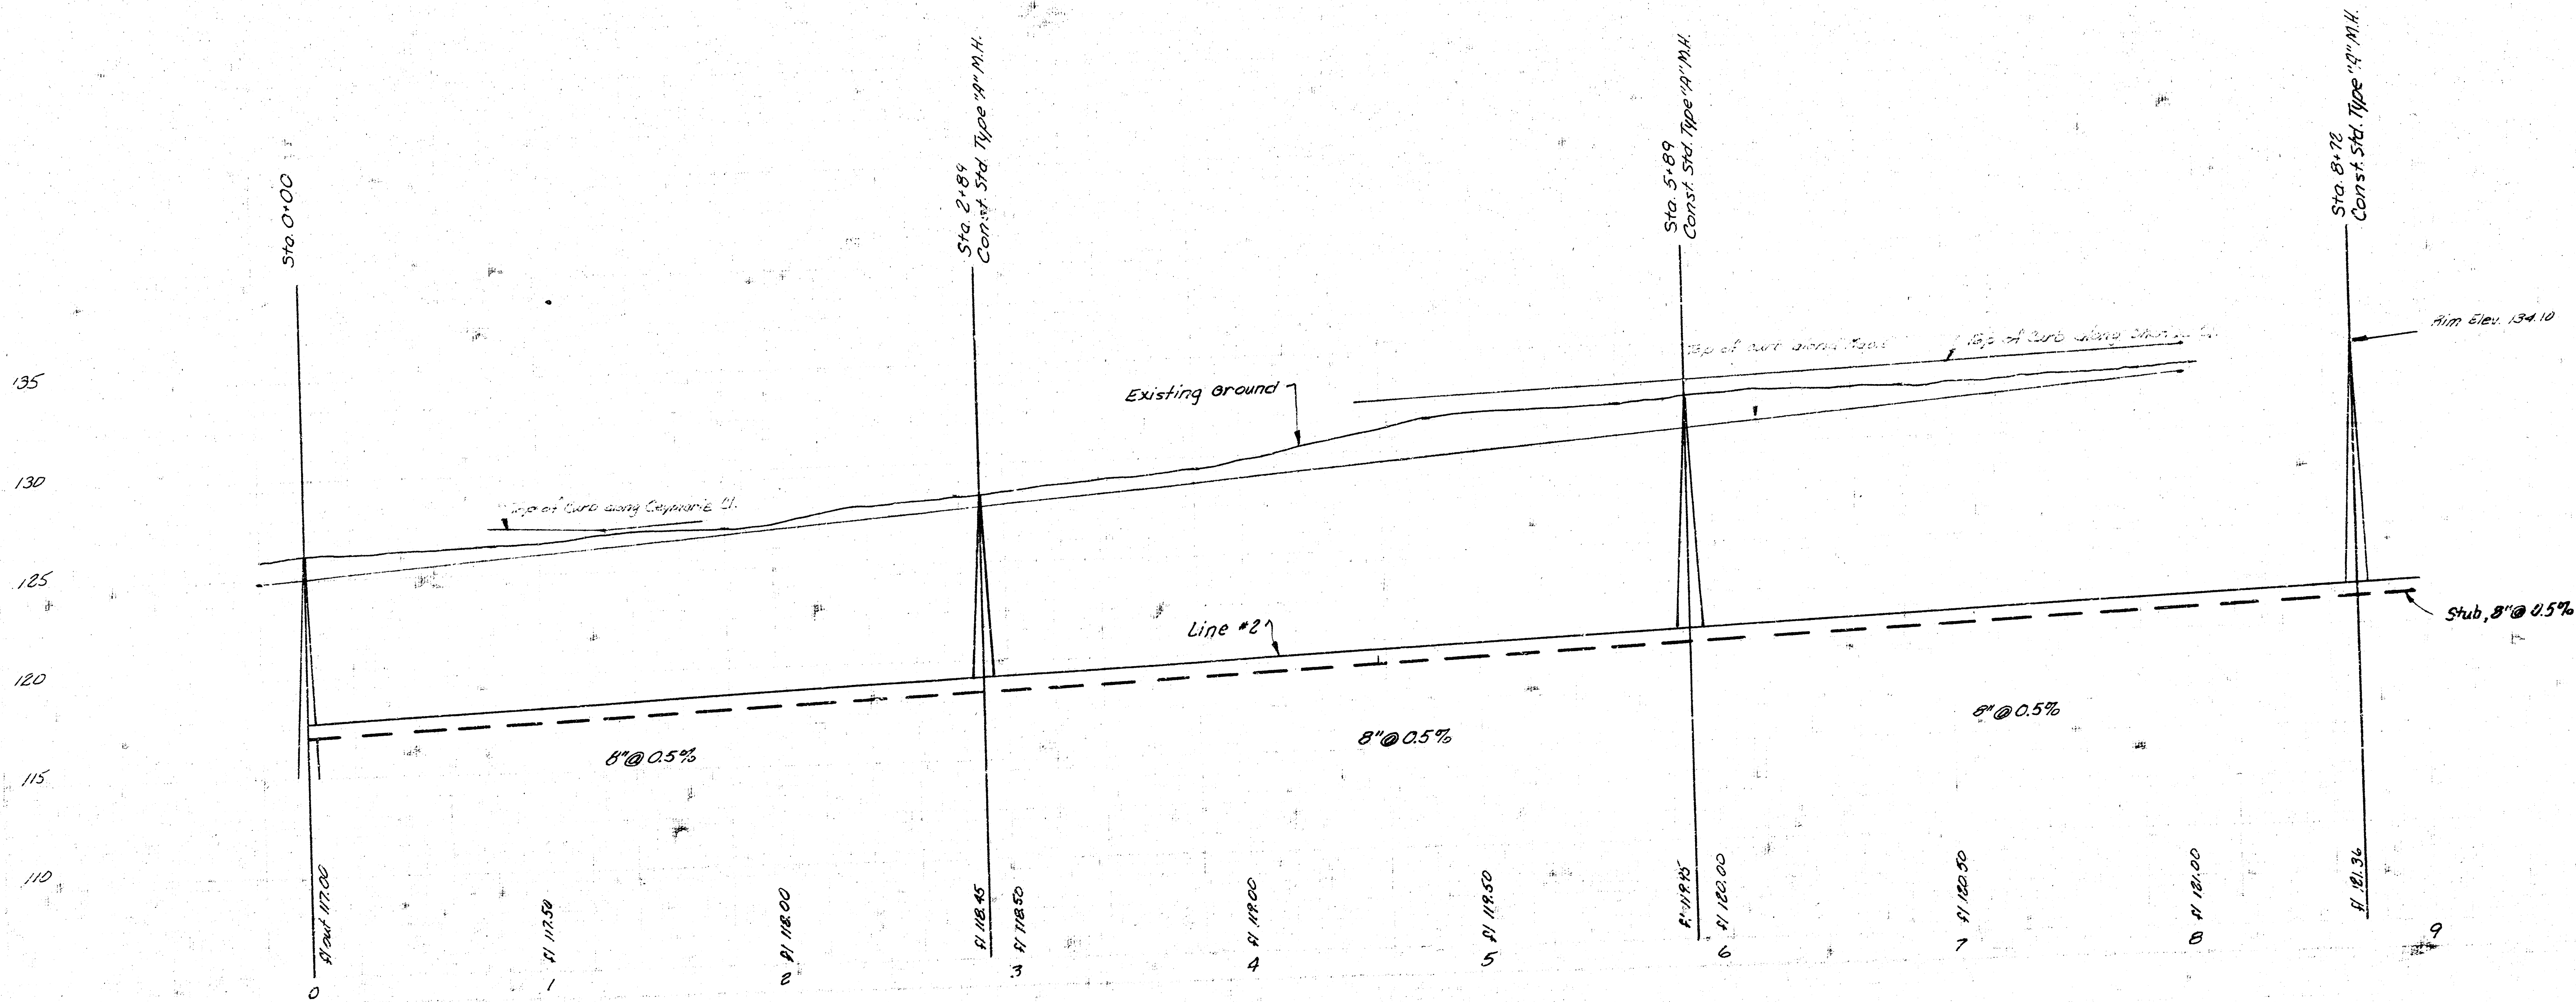

LAT. 49 S.W. INTERCEPTOR
 PROJ. NO. DKL 57205
 SHEET 3 of 6 LINE NO. 2

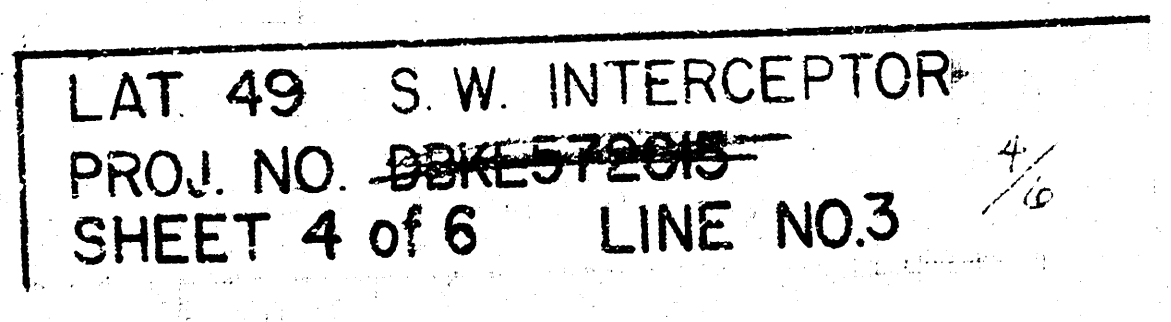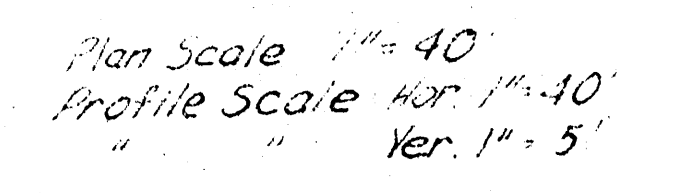

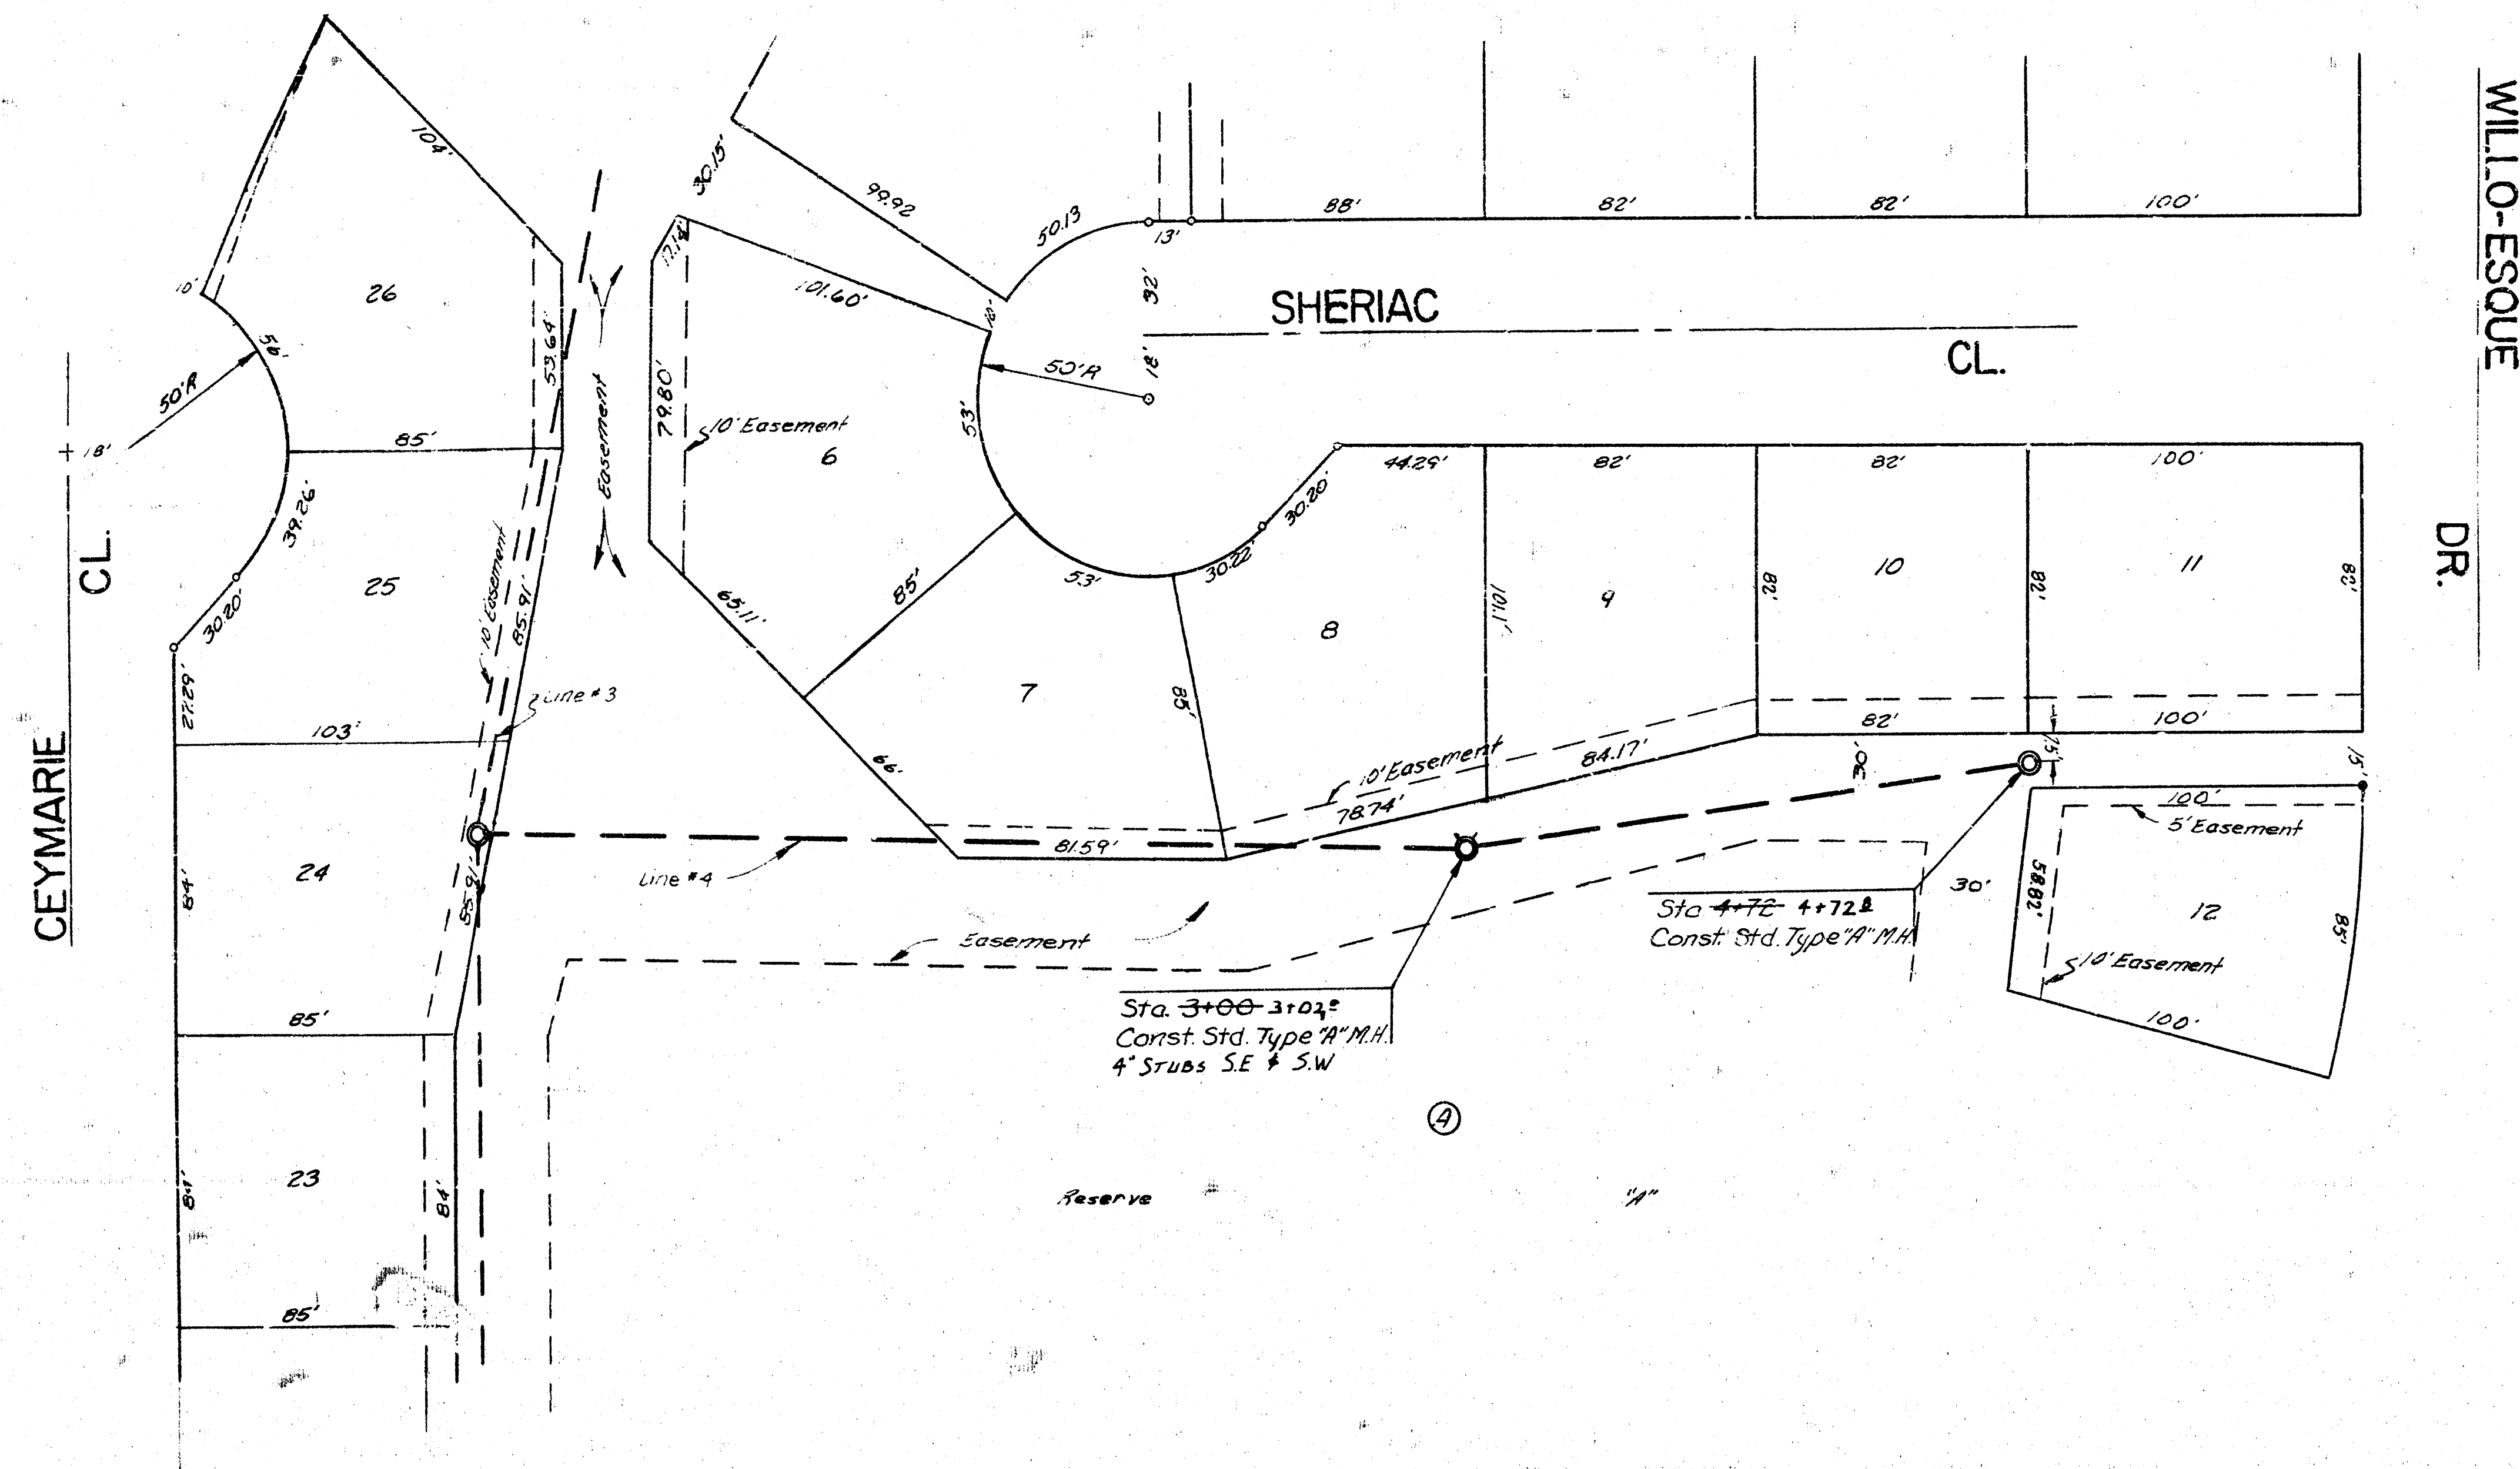

Plan Scale 1" = 40'
 Profile Scale Hor. 1" = 40'
 Profile Scale Ver. 1" = 5'

