



B. M. 109.35 R. R. Spk. 10, N. S.
P. R. N. W. cor. Hoover & 31st
St. So.

FINAL CONSTRUCTION TO BE MADE AS SHOWN ON THIS PLAN.
IN CASE A CHANGE IS MADE AT ANY TIME, THE
OWNER SHALL BE RESPONSIBLE FOR A CORRECTED SET.

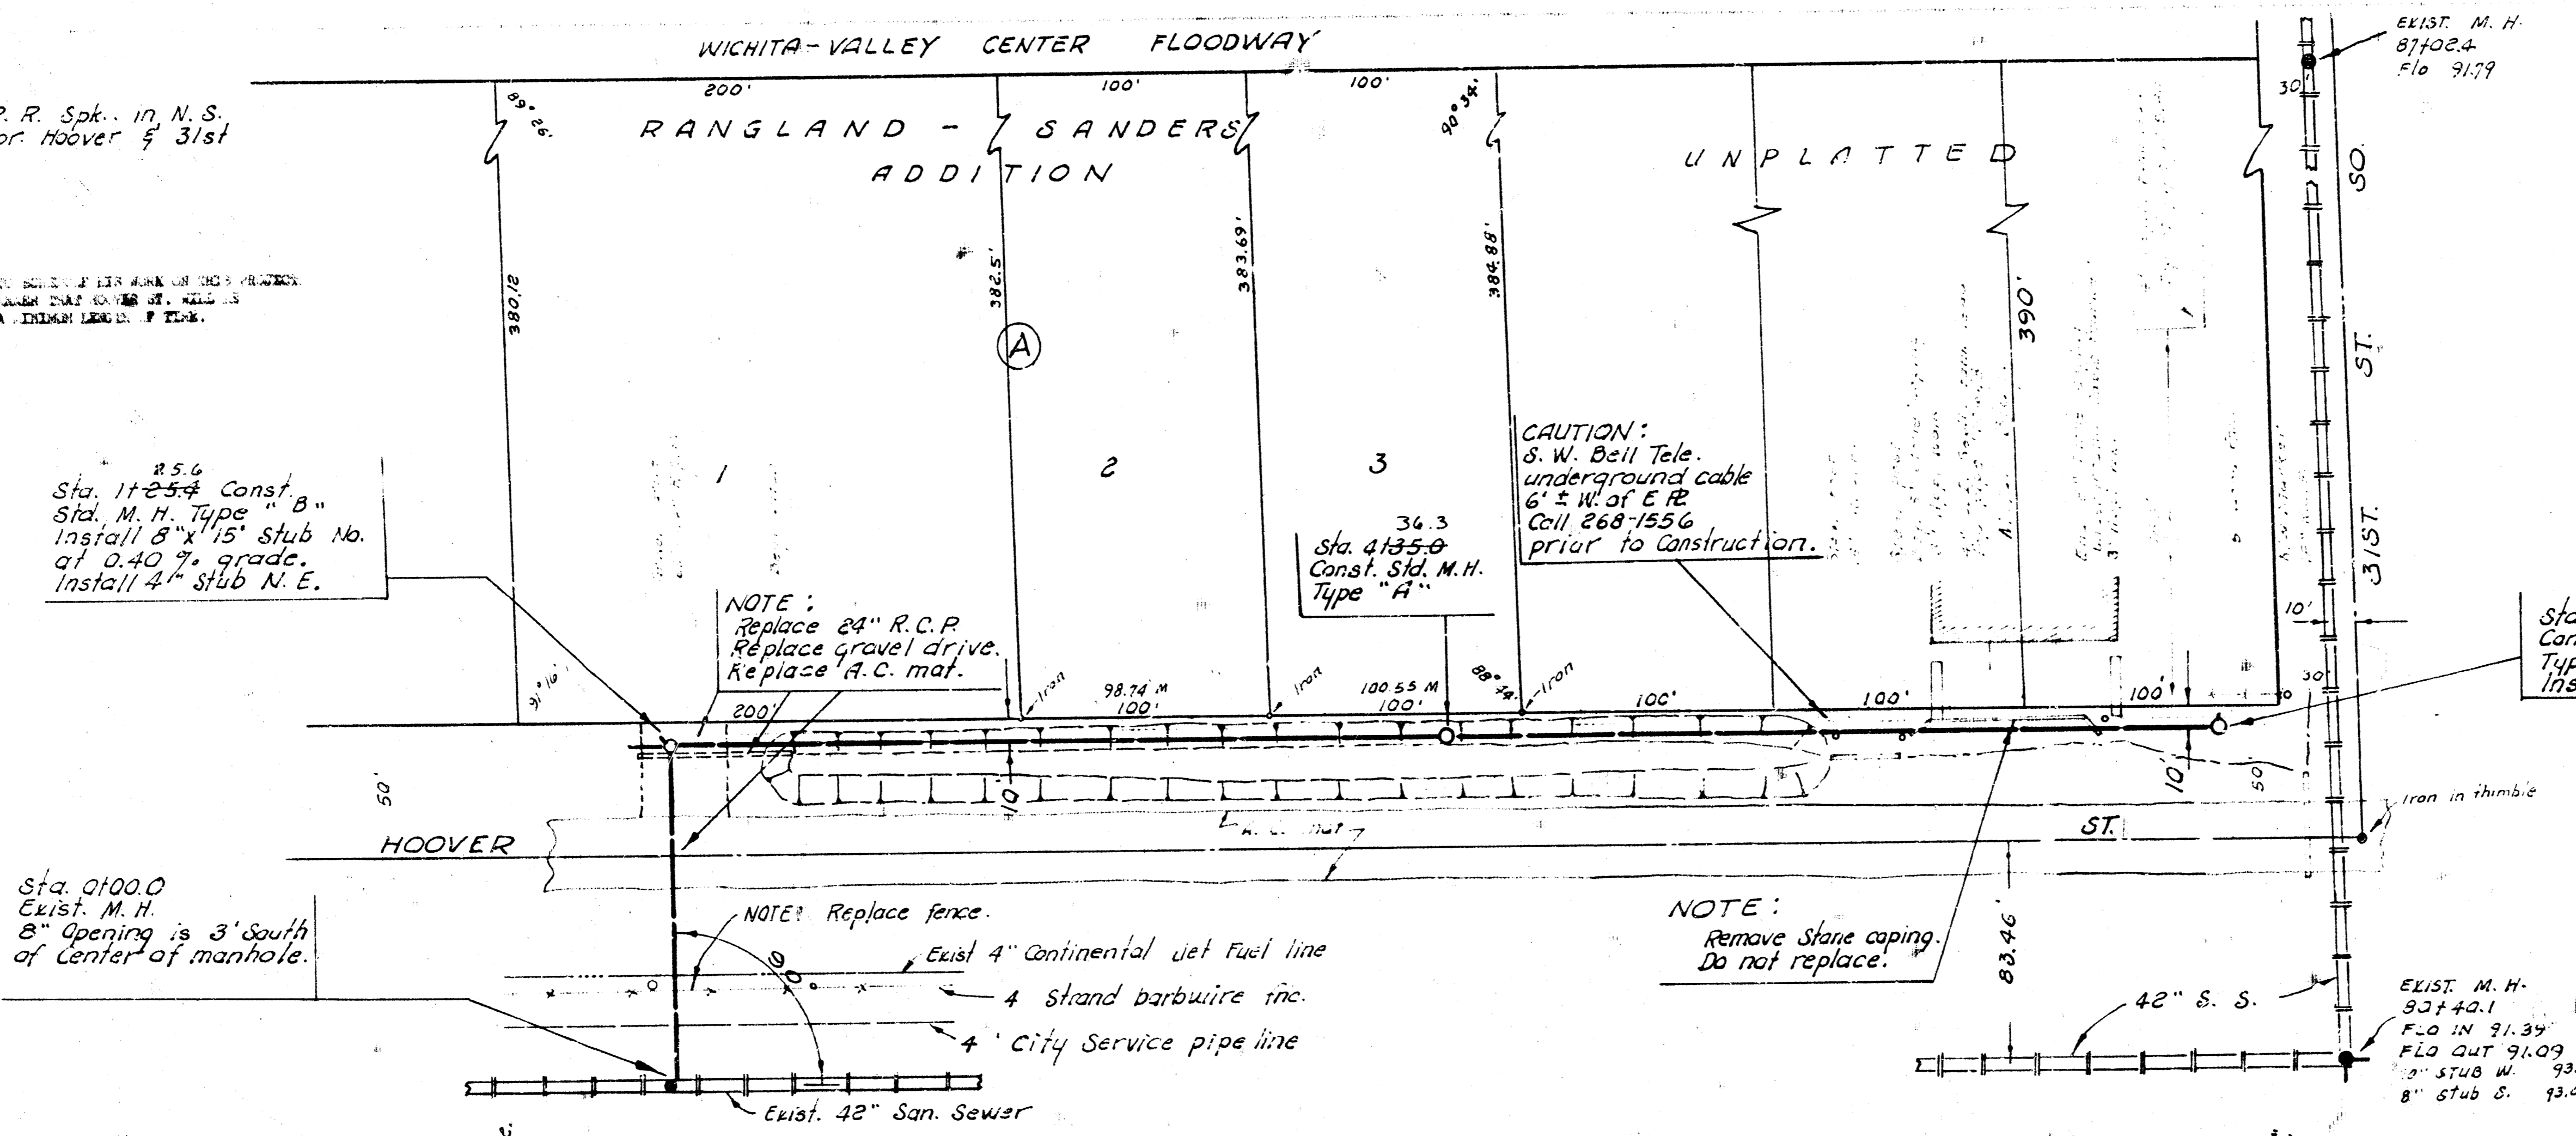

Plan Scale 1" = 40'
Profile Scale 1" = 5' Vert.

CAUTION
UNDERGROUND UTILITIES

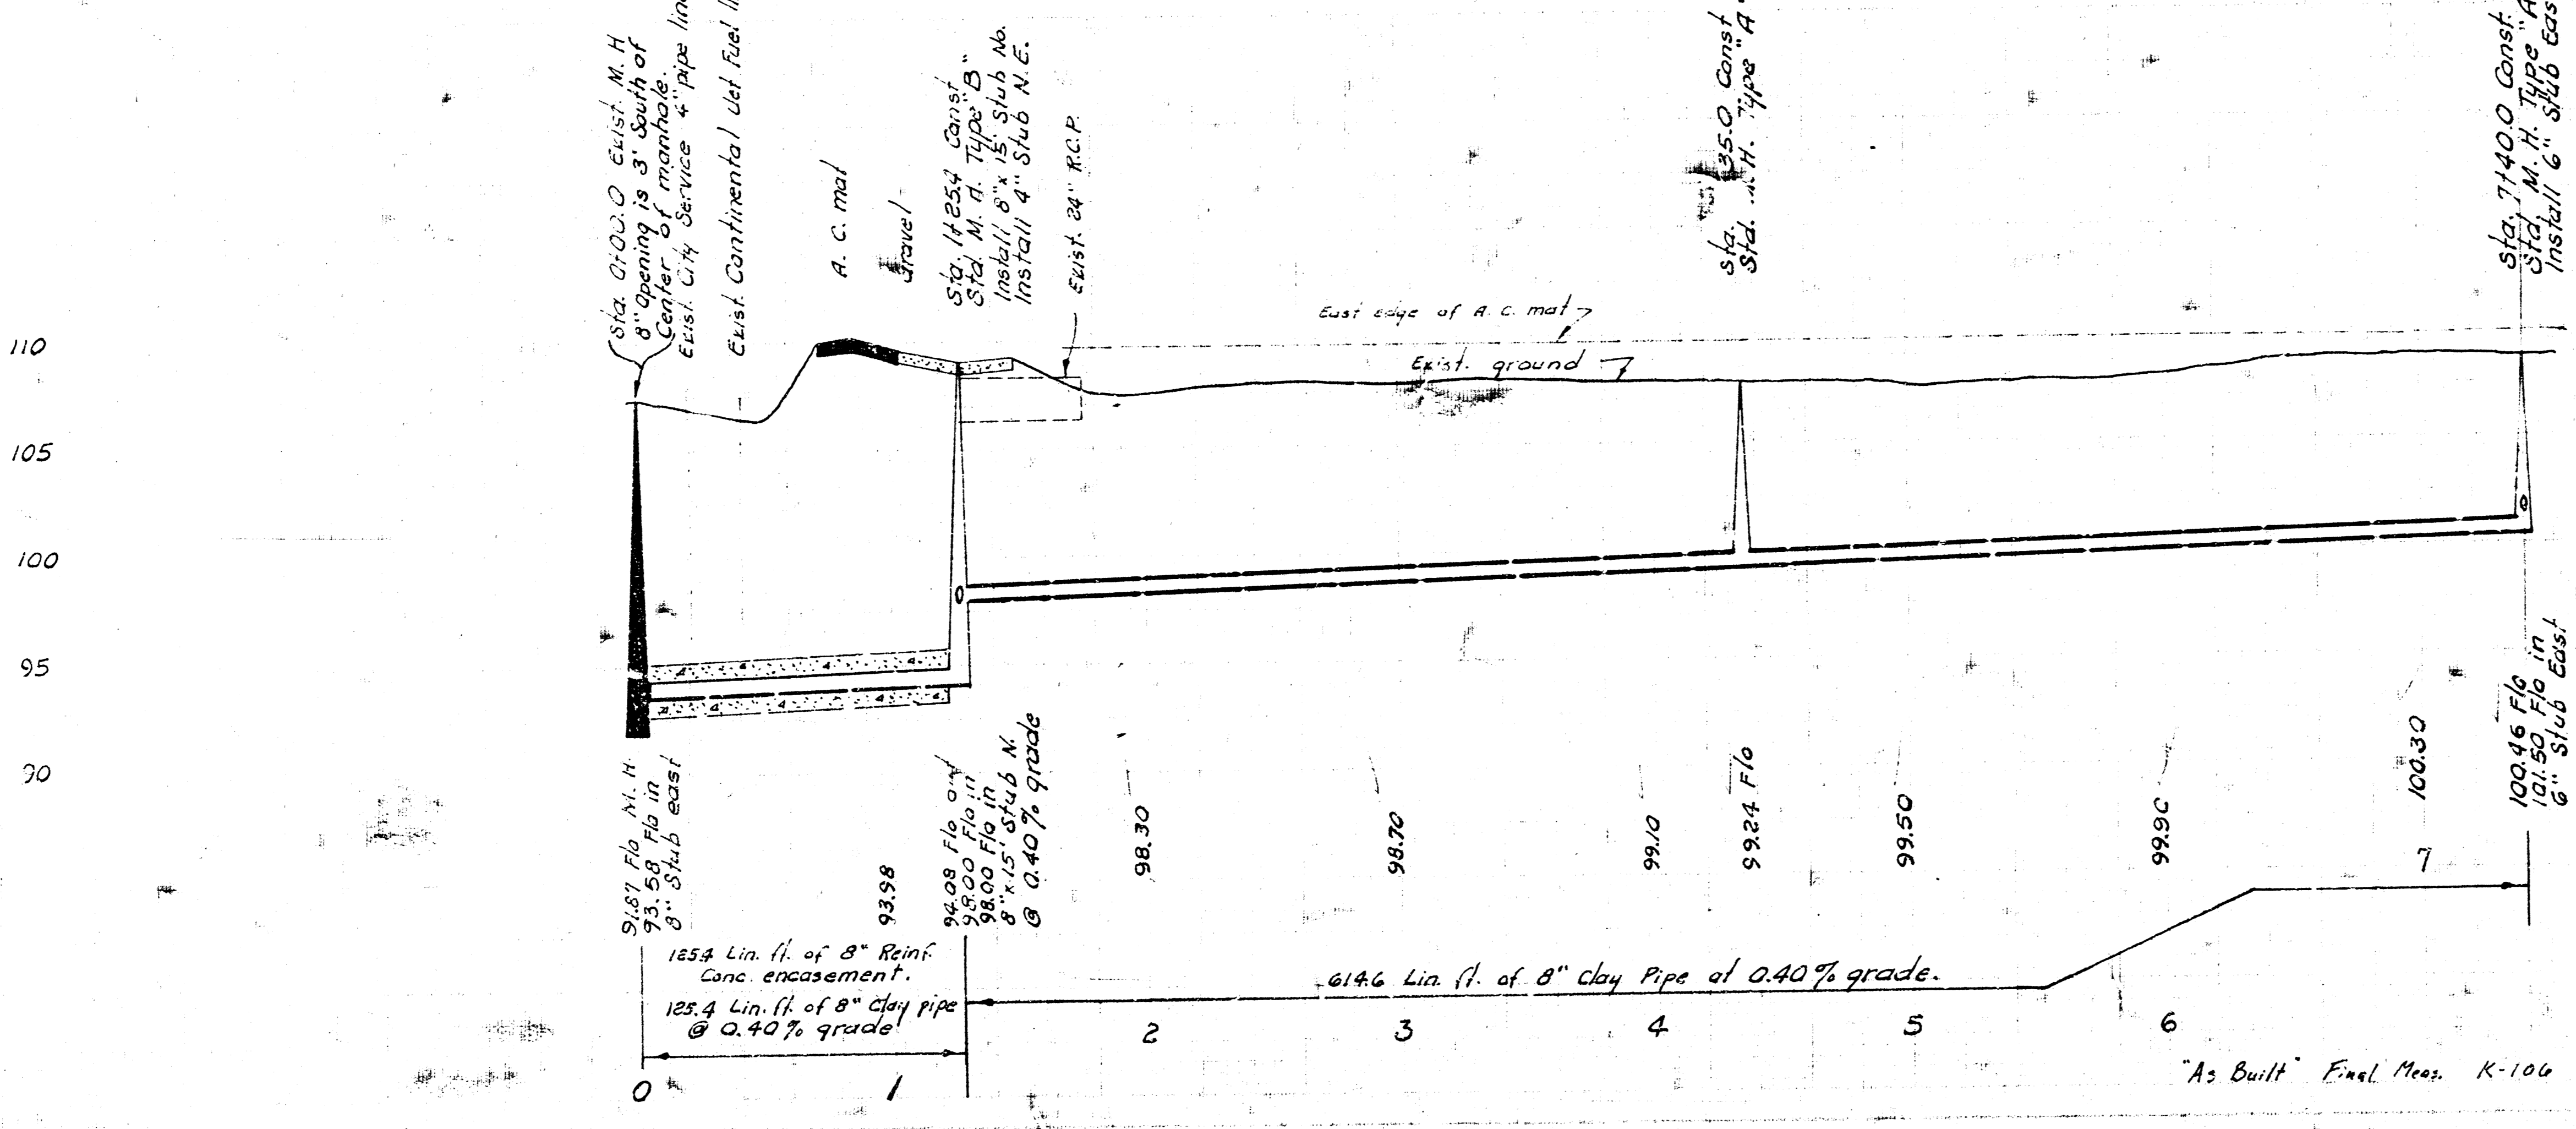

LAT. 51, S. W. INTERCEPTOR SEWER
CITY OF WICHITA, KANSAS
R. W. LINN - CITY ENGINEER
JAN. 1973 PROJECT NO. DBKL572045

