


B. M. 148.10 City Std. @ Ridge Rd. & 13th St.
 B. M. 159.71 N.E. cor. conc. porch No. # 1525 N. Holland.

217
 218
 219


NOTE:

Clearing of Right-of-Way shall include removal of all trees, fence, hedge and etc. within the easement. All equipment, labor and tools necessary to complete the items shall be included in price bid of "Lump Sum Clear R/W."

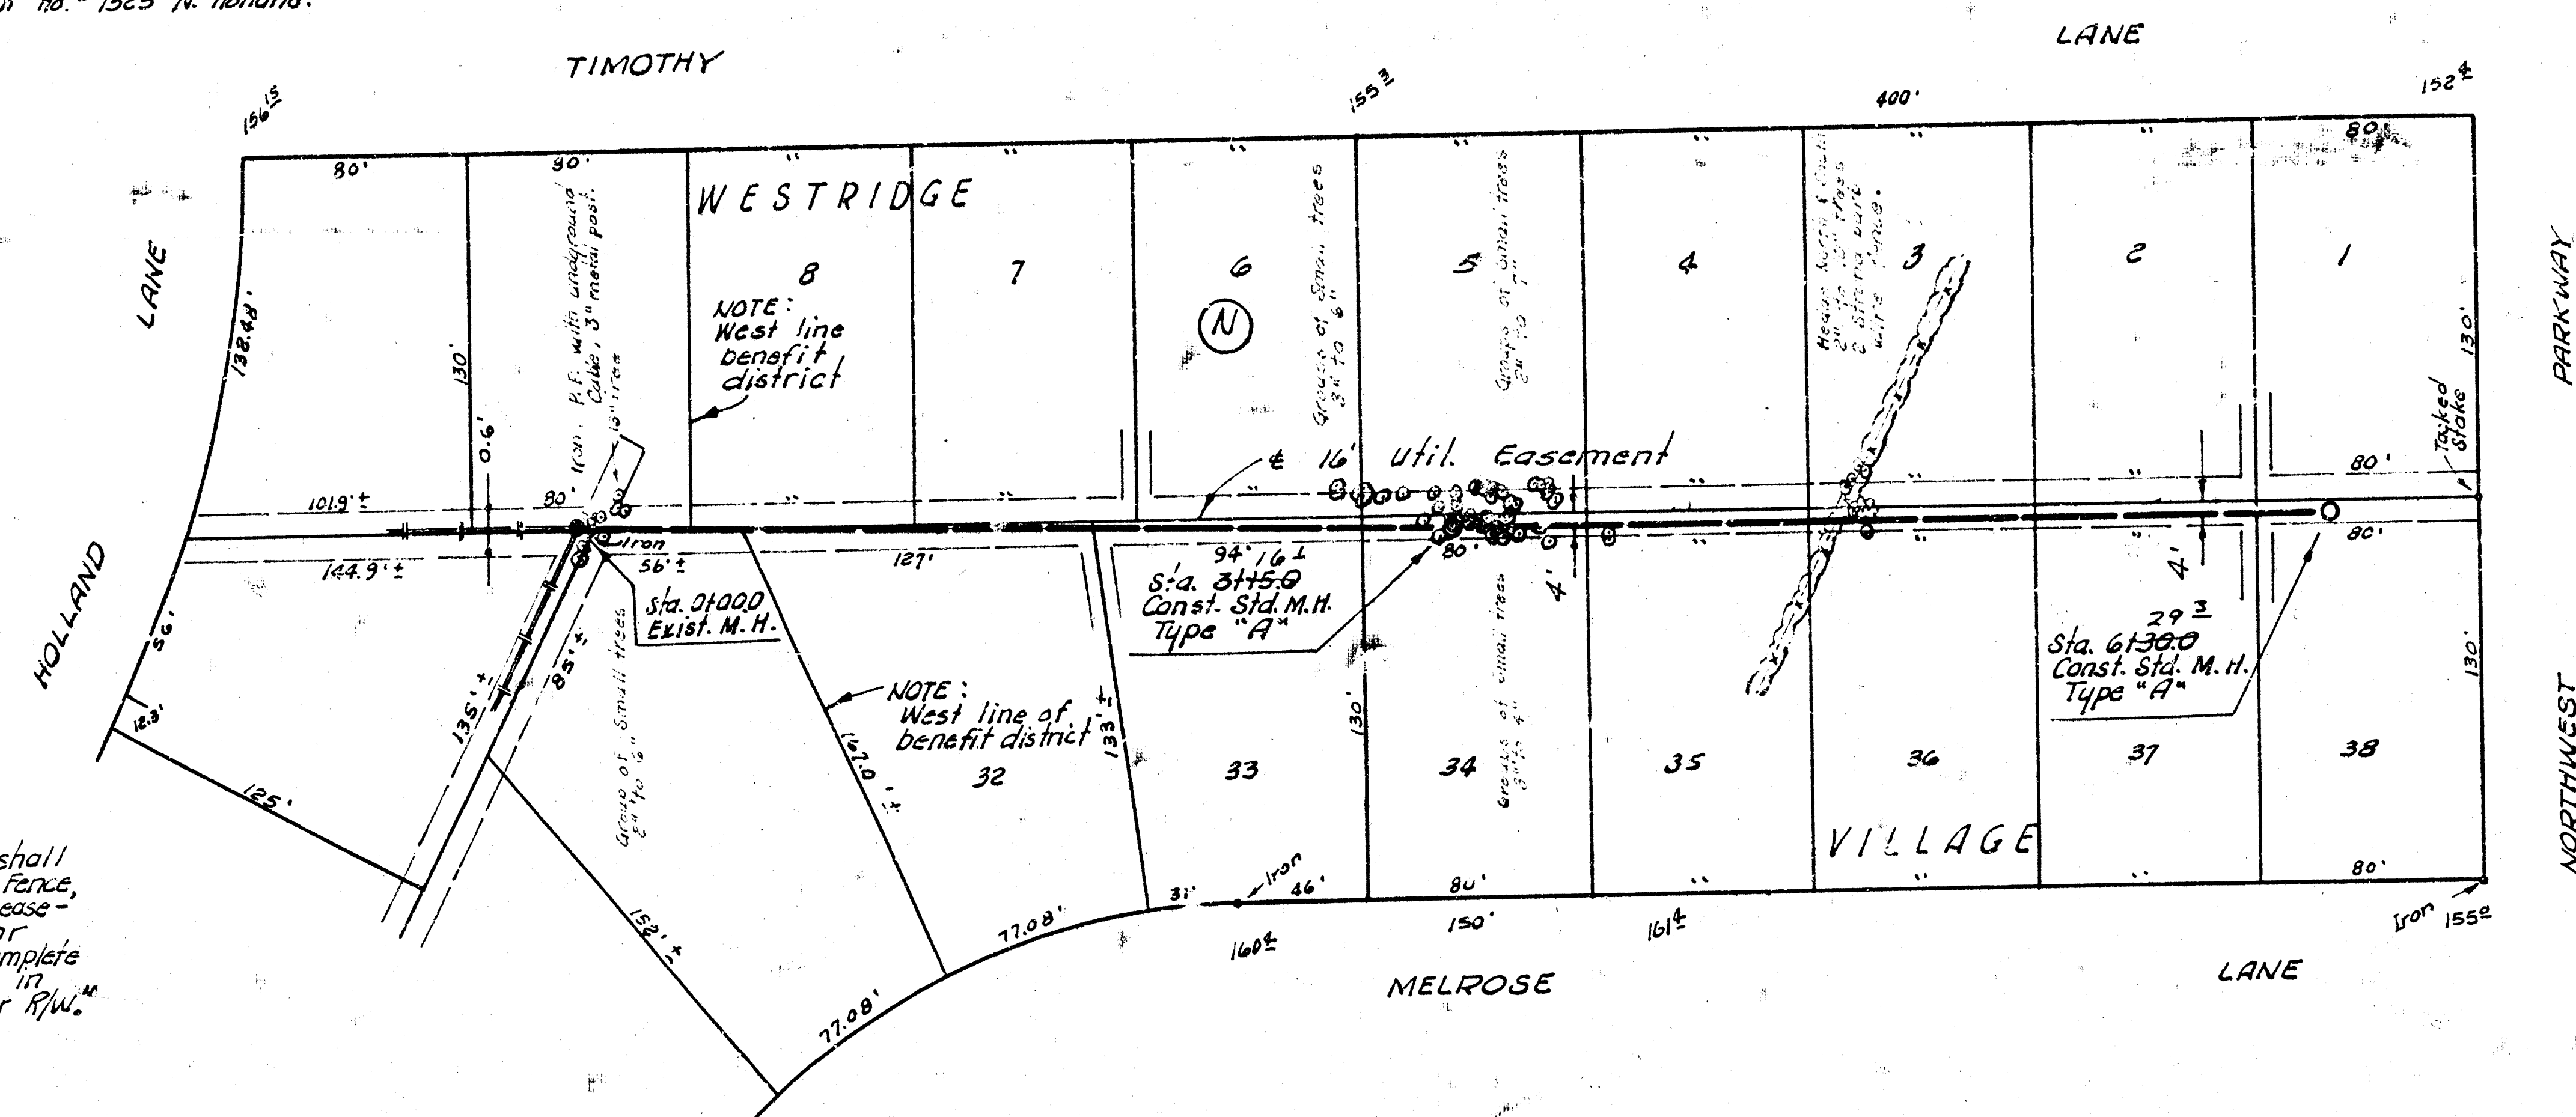

Plan Scale 1" = 40'
 Profile Scale 1" = 40' Horiz.
 1" = 5' Vert.

160
 155
 150
 145

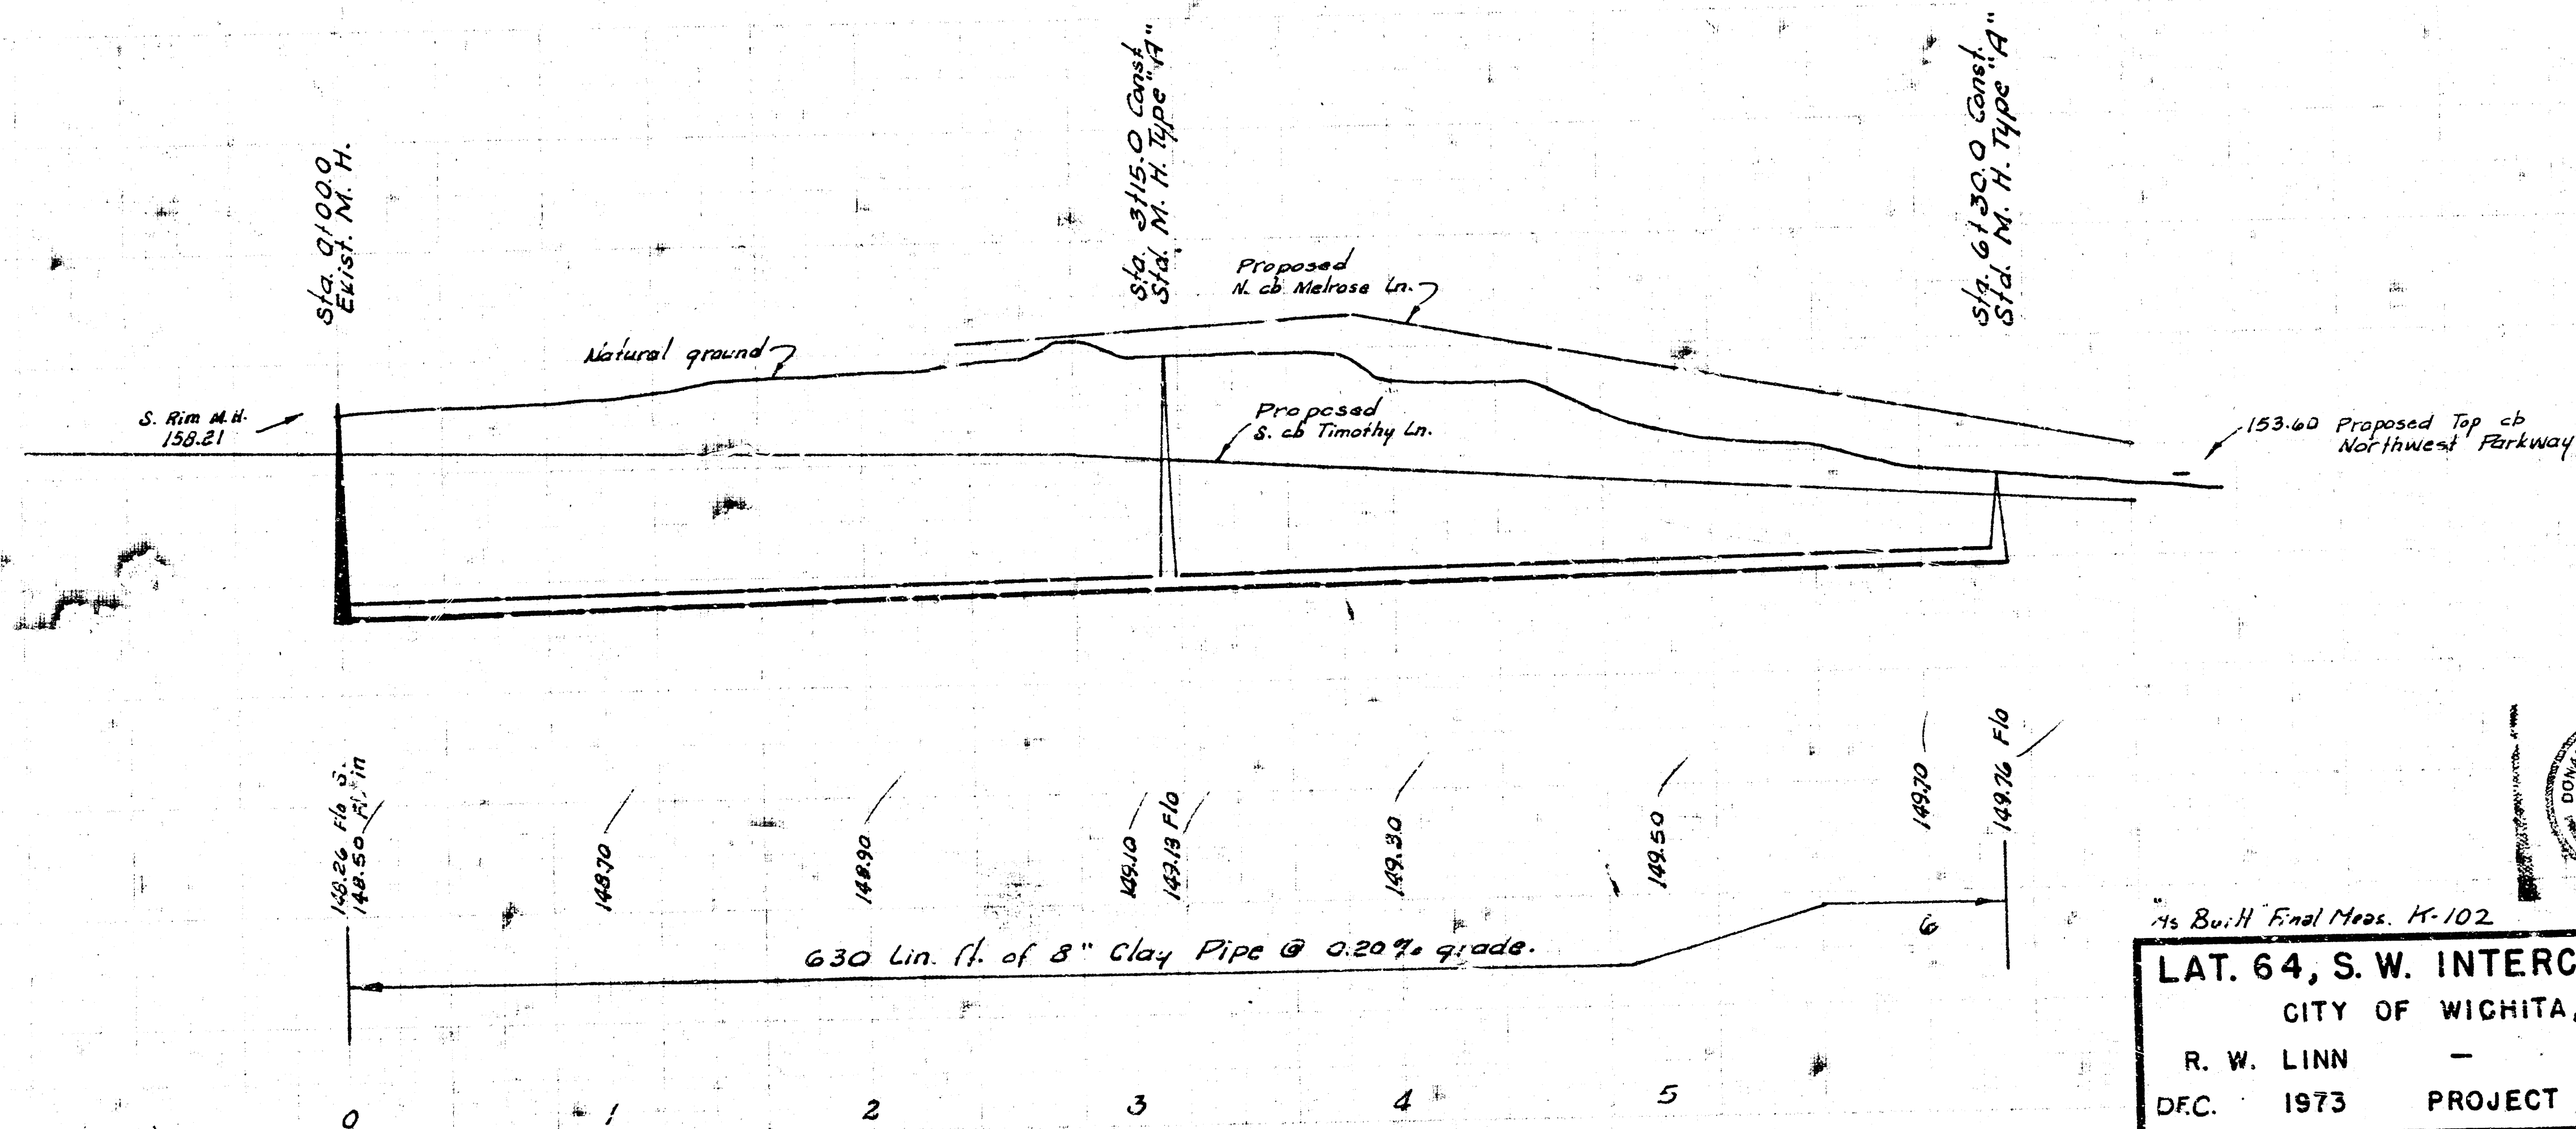

As Bui. H. Final Meas. H-102.
LAT. 64, S. W. INTERCEPTOR SEWER
 CITY OF WICHITA, KANSAS
 R. W. LINN — CITY ENGINEER
 DEC. 1973 PROJECT NO. DBKL 573075