


B. M. 148.102 City Std. on S.W. cor. Ridge Rd. & 13th St.
 B. M. 149.837 1/2" Bolt N. Side R. Pole on S.W. cor. Dunsworth & 13th St.
 B. M. 159.71 NE. cor. conc. porch No. #1525 N. Holland.

NOTE:
 Clearing of Right-of-Way shall include removal of all trees, fence, hedge and etc. within the easement. All equipment, labor and tools necessary to complete the items shall be included in price bid of "Lump Sum Clearing".

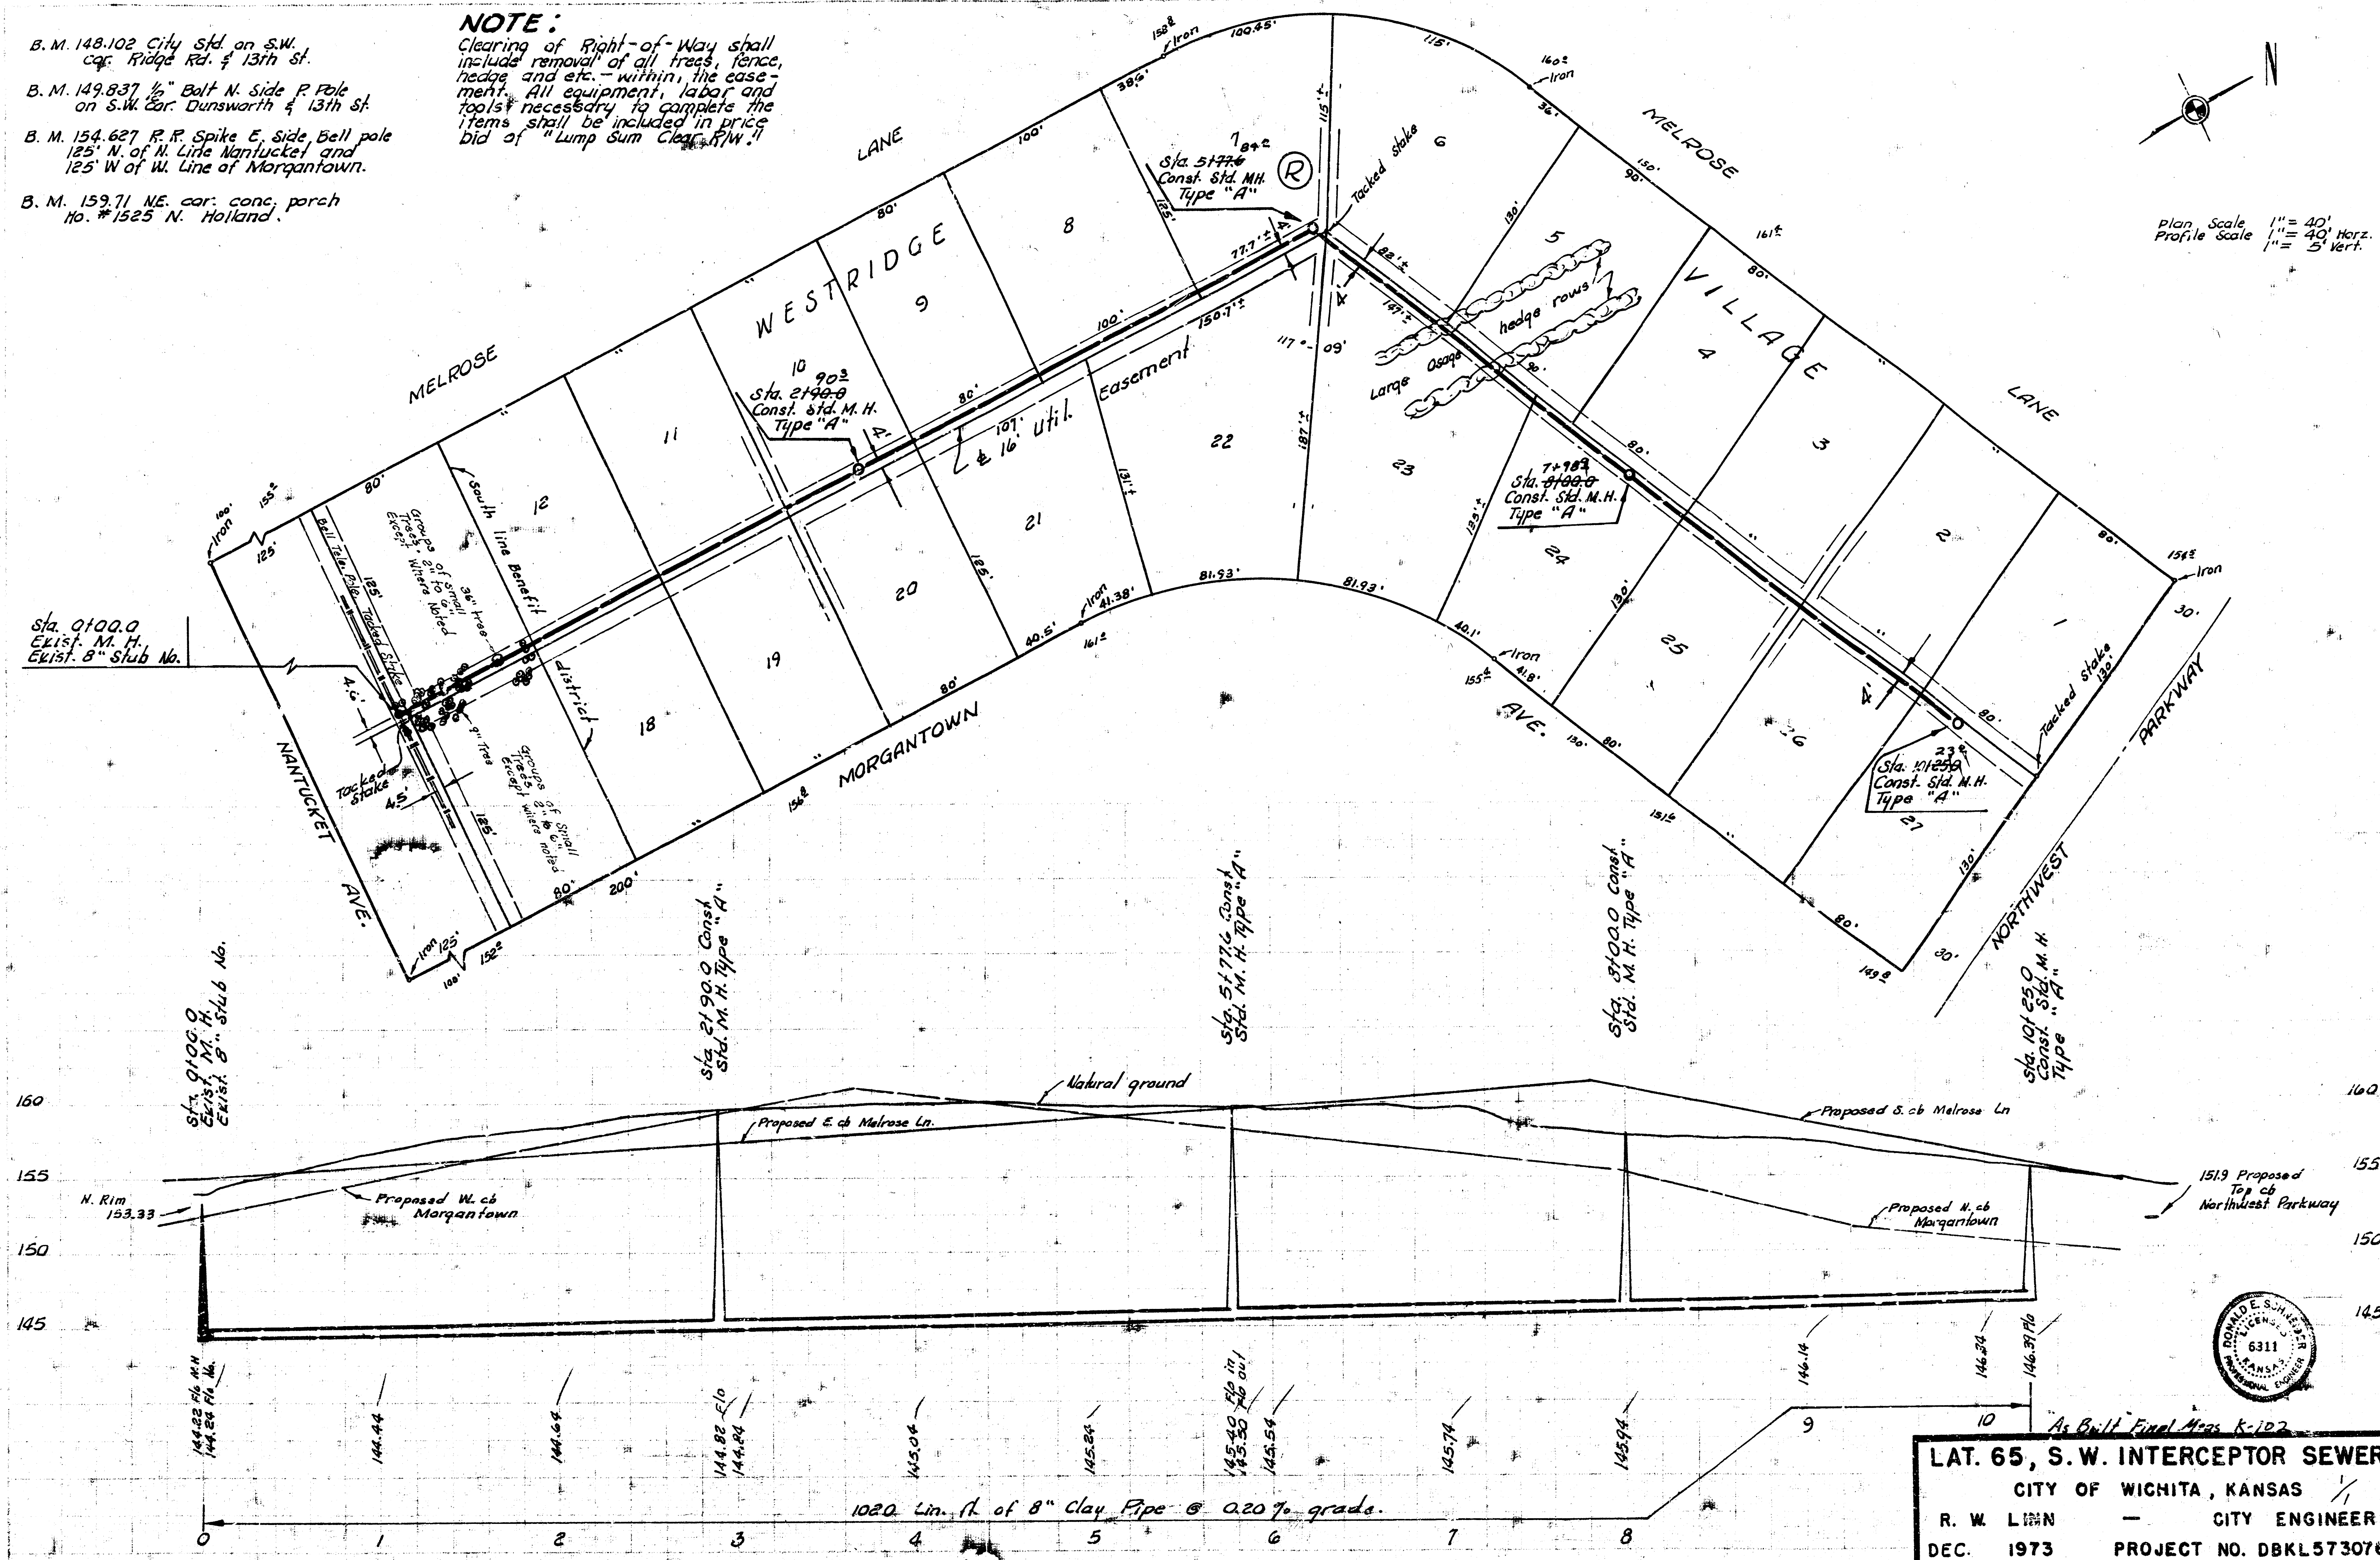

FILMED FROM THE BEST