


14-3-1-10
 10 M. H. 111
 1-10-74
 P. R. W.
 69


B. M. 108.43 City Std. Hoover & 31st. St. So.
 44' E. & 32' N. & both.
 B. M. 113.83 "P" cut SE. cor. conc. flyme N. Side
 31st. Sta. 13150 by Cassia Water tower.

Plan Scale 1" = 40'
 Profile Scale 1" = 40' Horz.
 1" = 5' Vert.

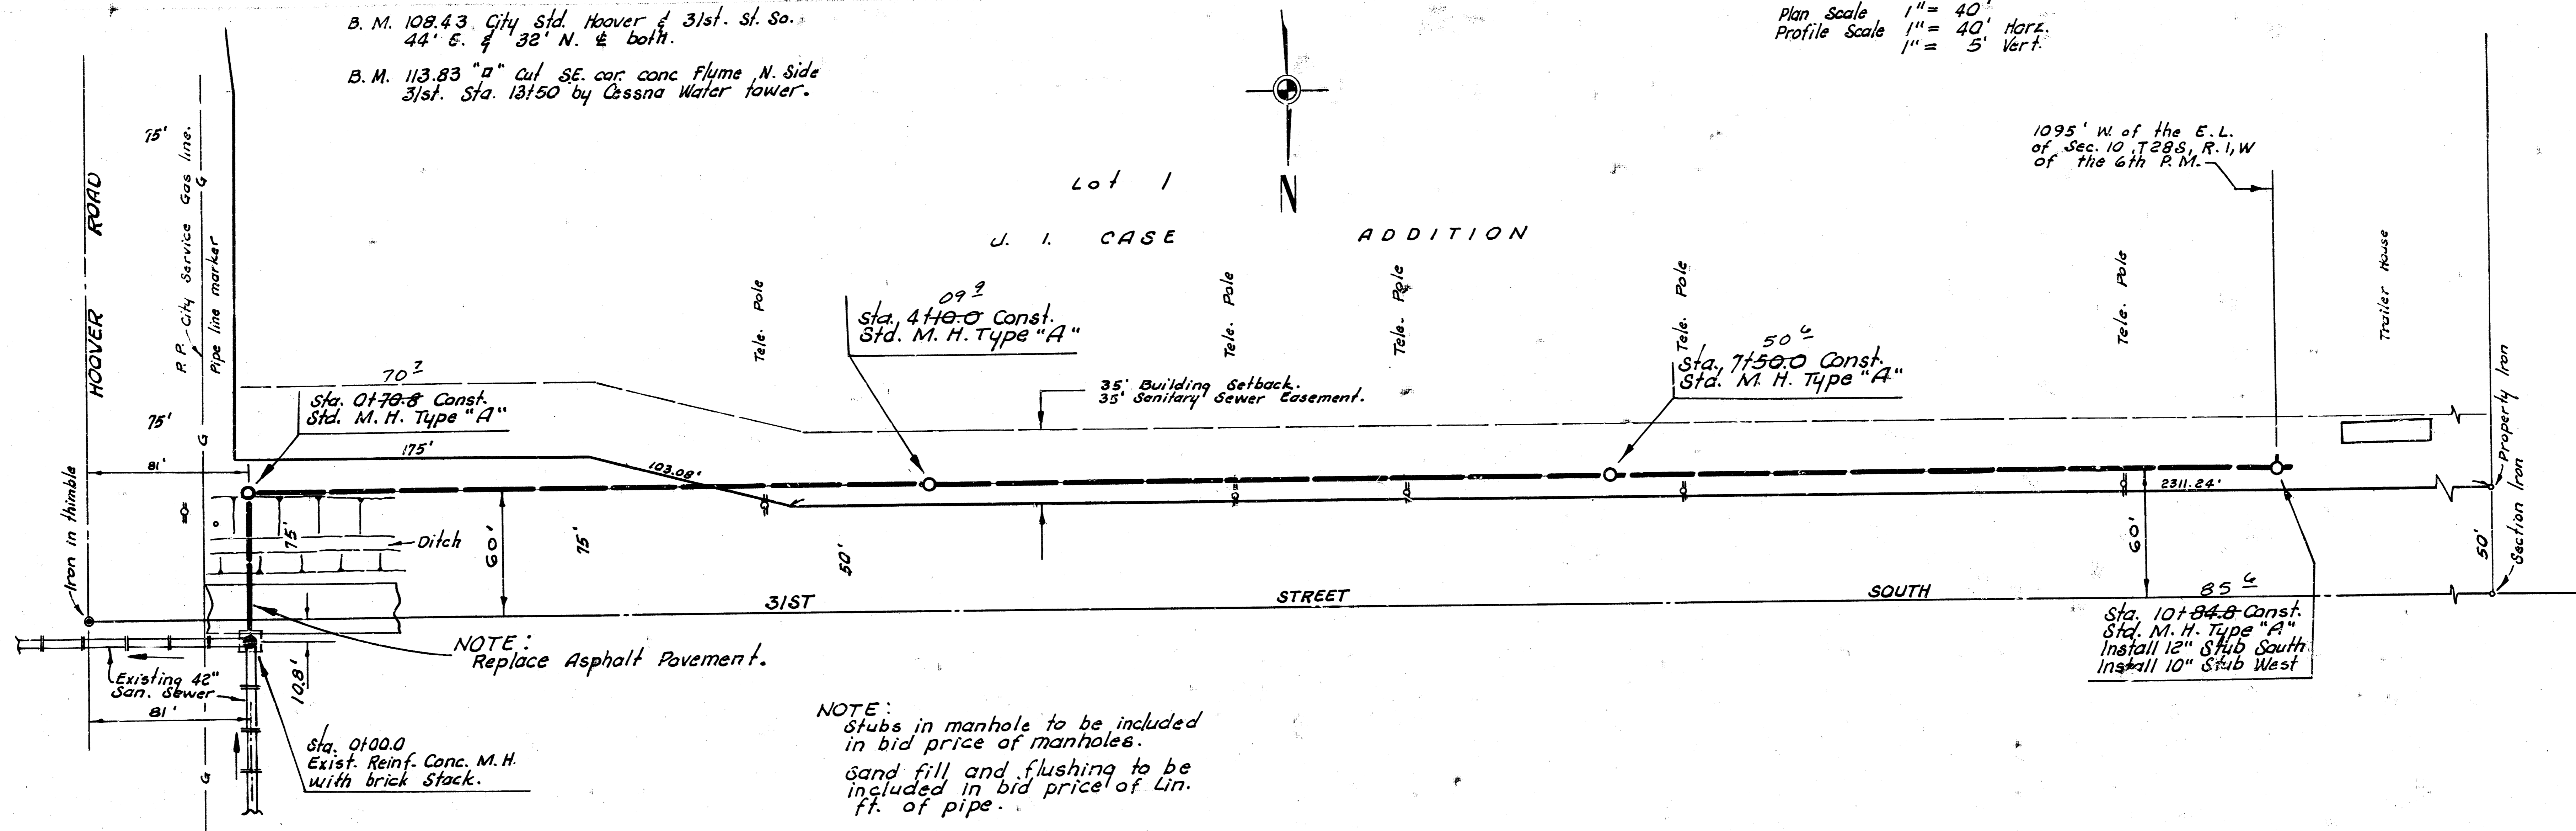

NOTE: Replace Asphalt Pavement.

NOTE: Stubs in manhole to be included in bid price of manholes.
 sand fill and flushing to be included in bid price of Lin. ft. of pipe.

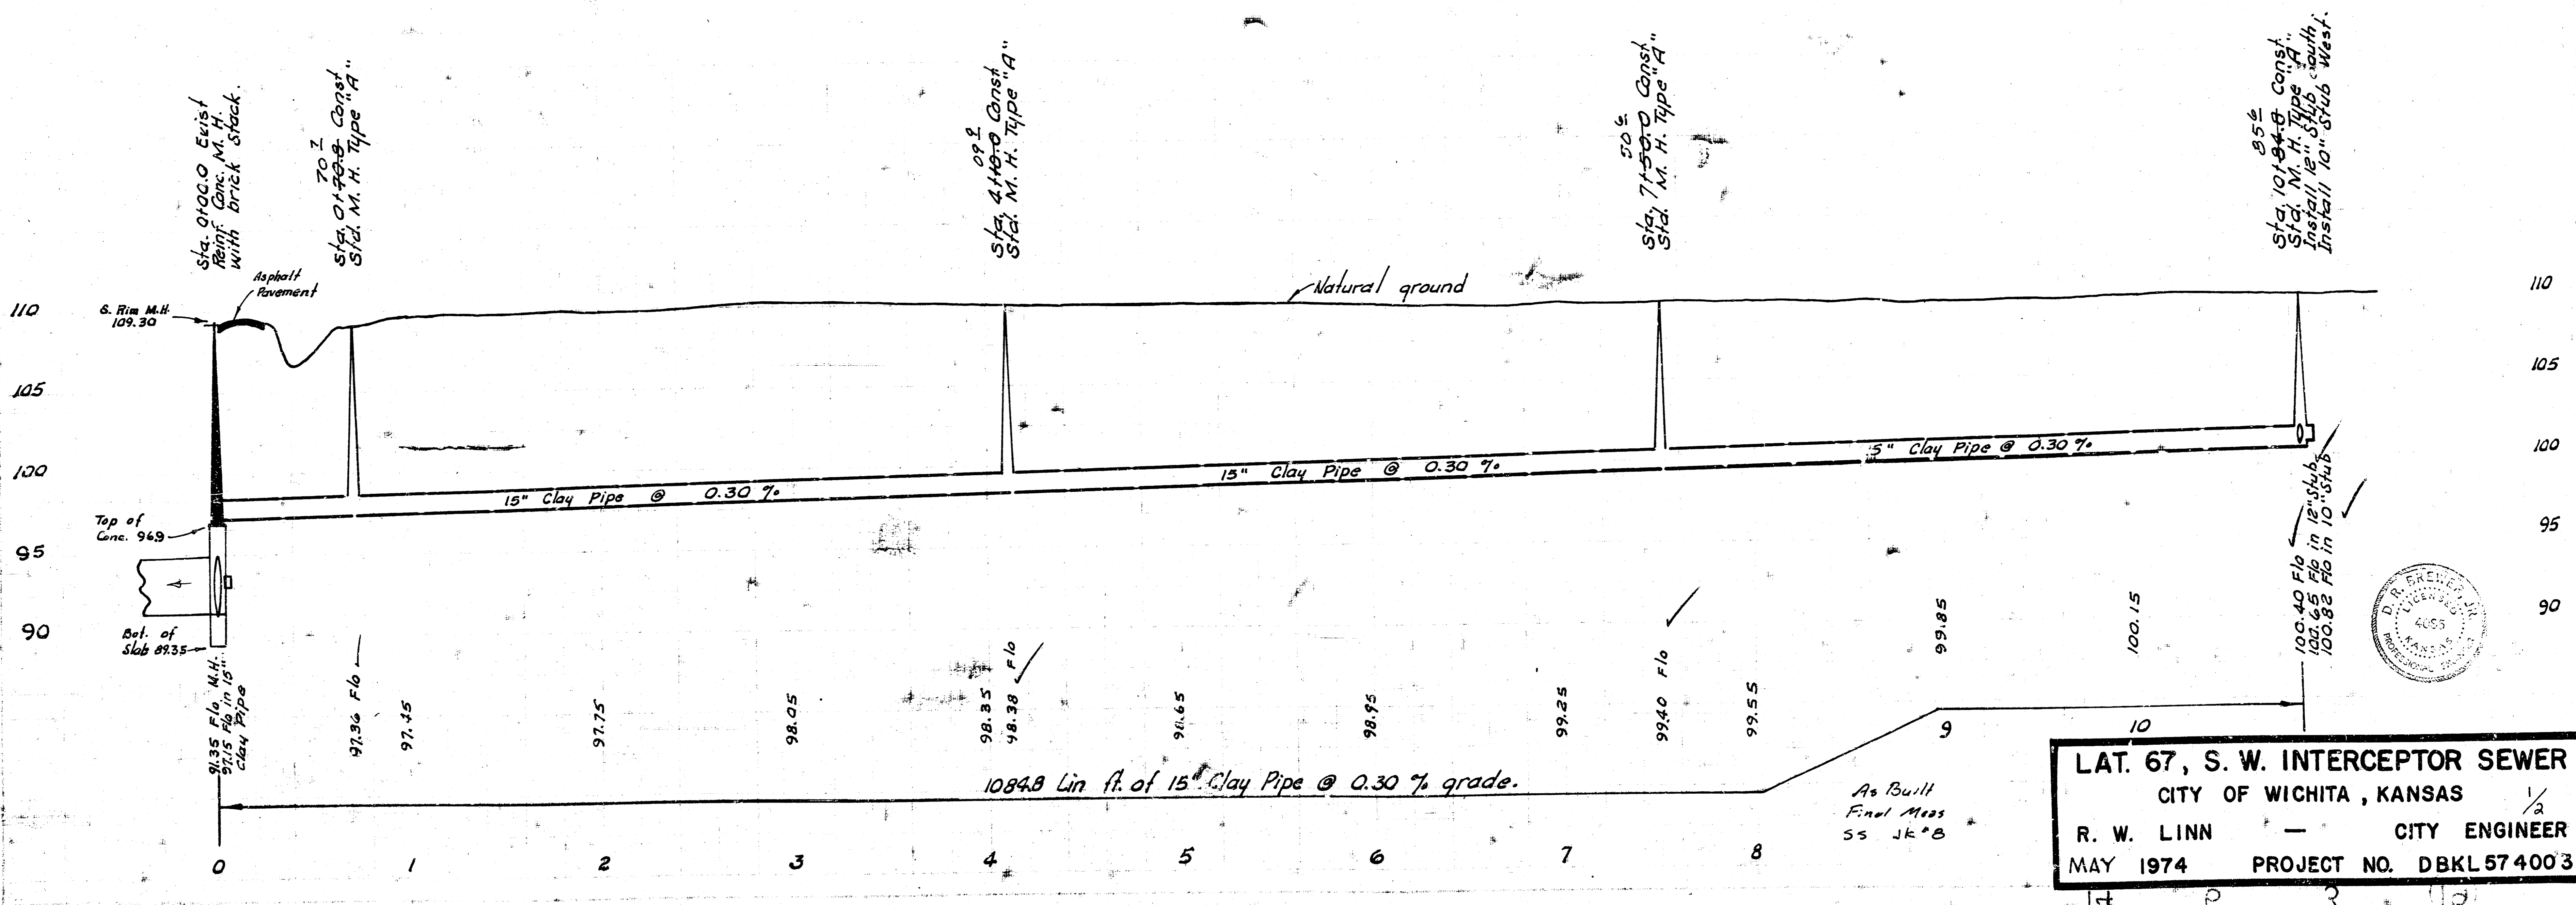

LAT. 67, S. W. INTERCEPTOR SEWER
 CITY OF WICHITA, KANSAS
 R. W. LINN — CITY ENGINEER
 MAY 1974 PROJECT NO. DBKL 574003



