


B.M. - 144.96 - City Std. NW Corner. Ridge Rd. & 2nd St.
 39.5' N. & 48.0' W. of E. Ridge Rd. & 2nd St.
 B.M. - 122.92 - #60 Nail in W. Face of H.L.P.E. of
 Wayside & Winterset.

Scale: Plan 1"=40'
 Profile 1"=10'
 Horiz. 1"=40'
 Vert. 1"=5'

FARMINGTON SQUARE ADD'X

Trees to be Removed.
 Except: That any tree marked for
 removal which in the opinion of the
 Field Engineer can be saved, SHALL
 be Saved.

NOTE: FLOW ELEVATION OF ALL 8" STUBS OUT OF
 MANHOLES SHALL BE SET 0.1' ABOVE THE
 FLOW ELEVATION OF THE MANHOLE.

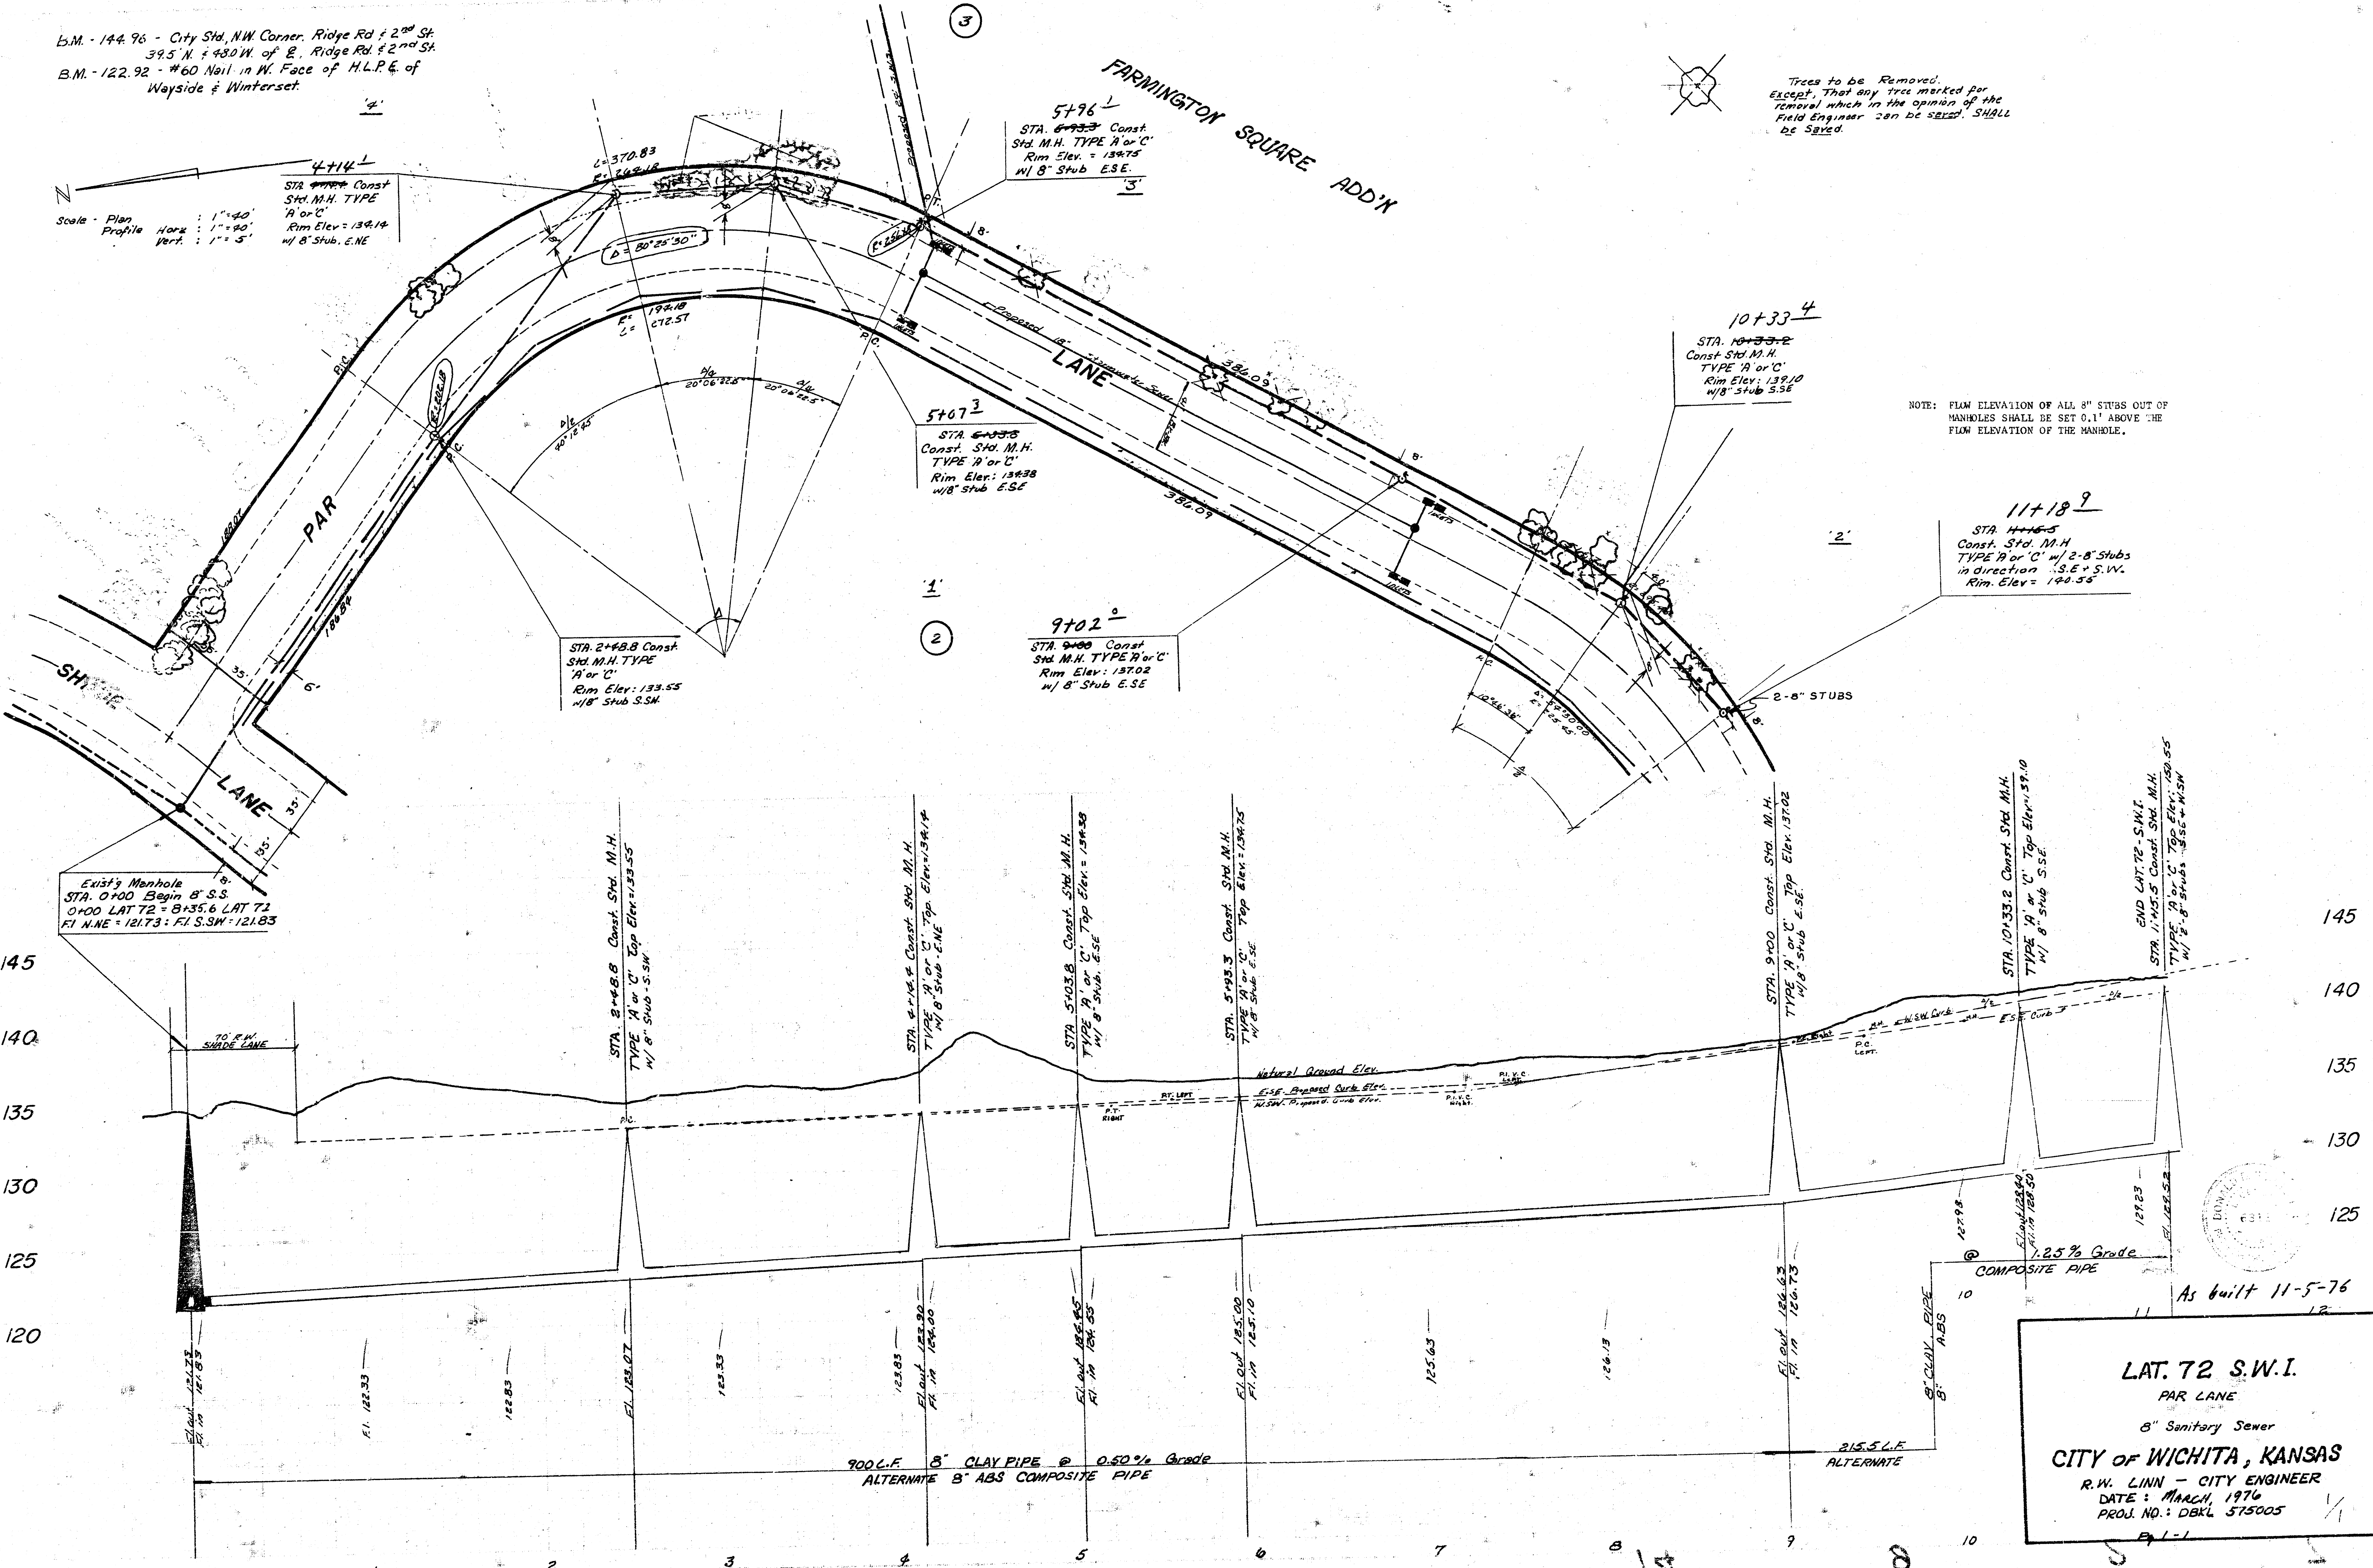

LAT. 72 S.W.1.
 PAR LANE
 8" Sanitary Sewer
CITY OF WICHITA, KANSAS
 R.W. LINN - CITY ENGINEER
 DATE: MARCH, 1976
 PROJ. NO.: DBKL 575005