



BM 157.04 R.R. Spike N. to RR approx. 200' S. & 100' W. of N.W. cor. Nantucket & Lark
(4th RR W. Mulize Rd on 13th)

Plan Scale 1" = 40'
Profile Scale 1" = 40'
1" = 5'

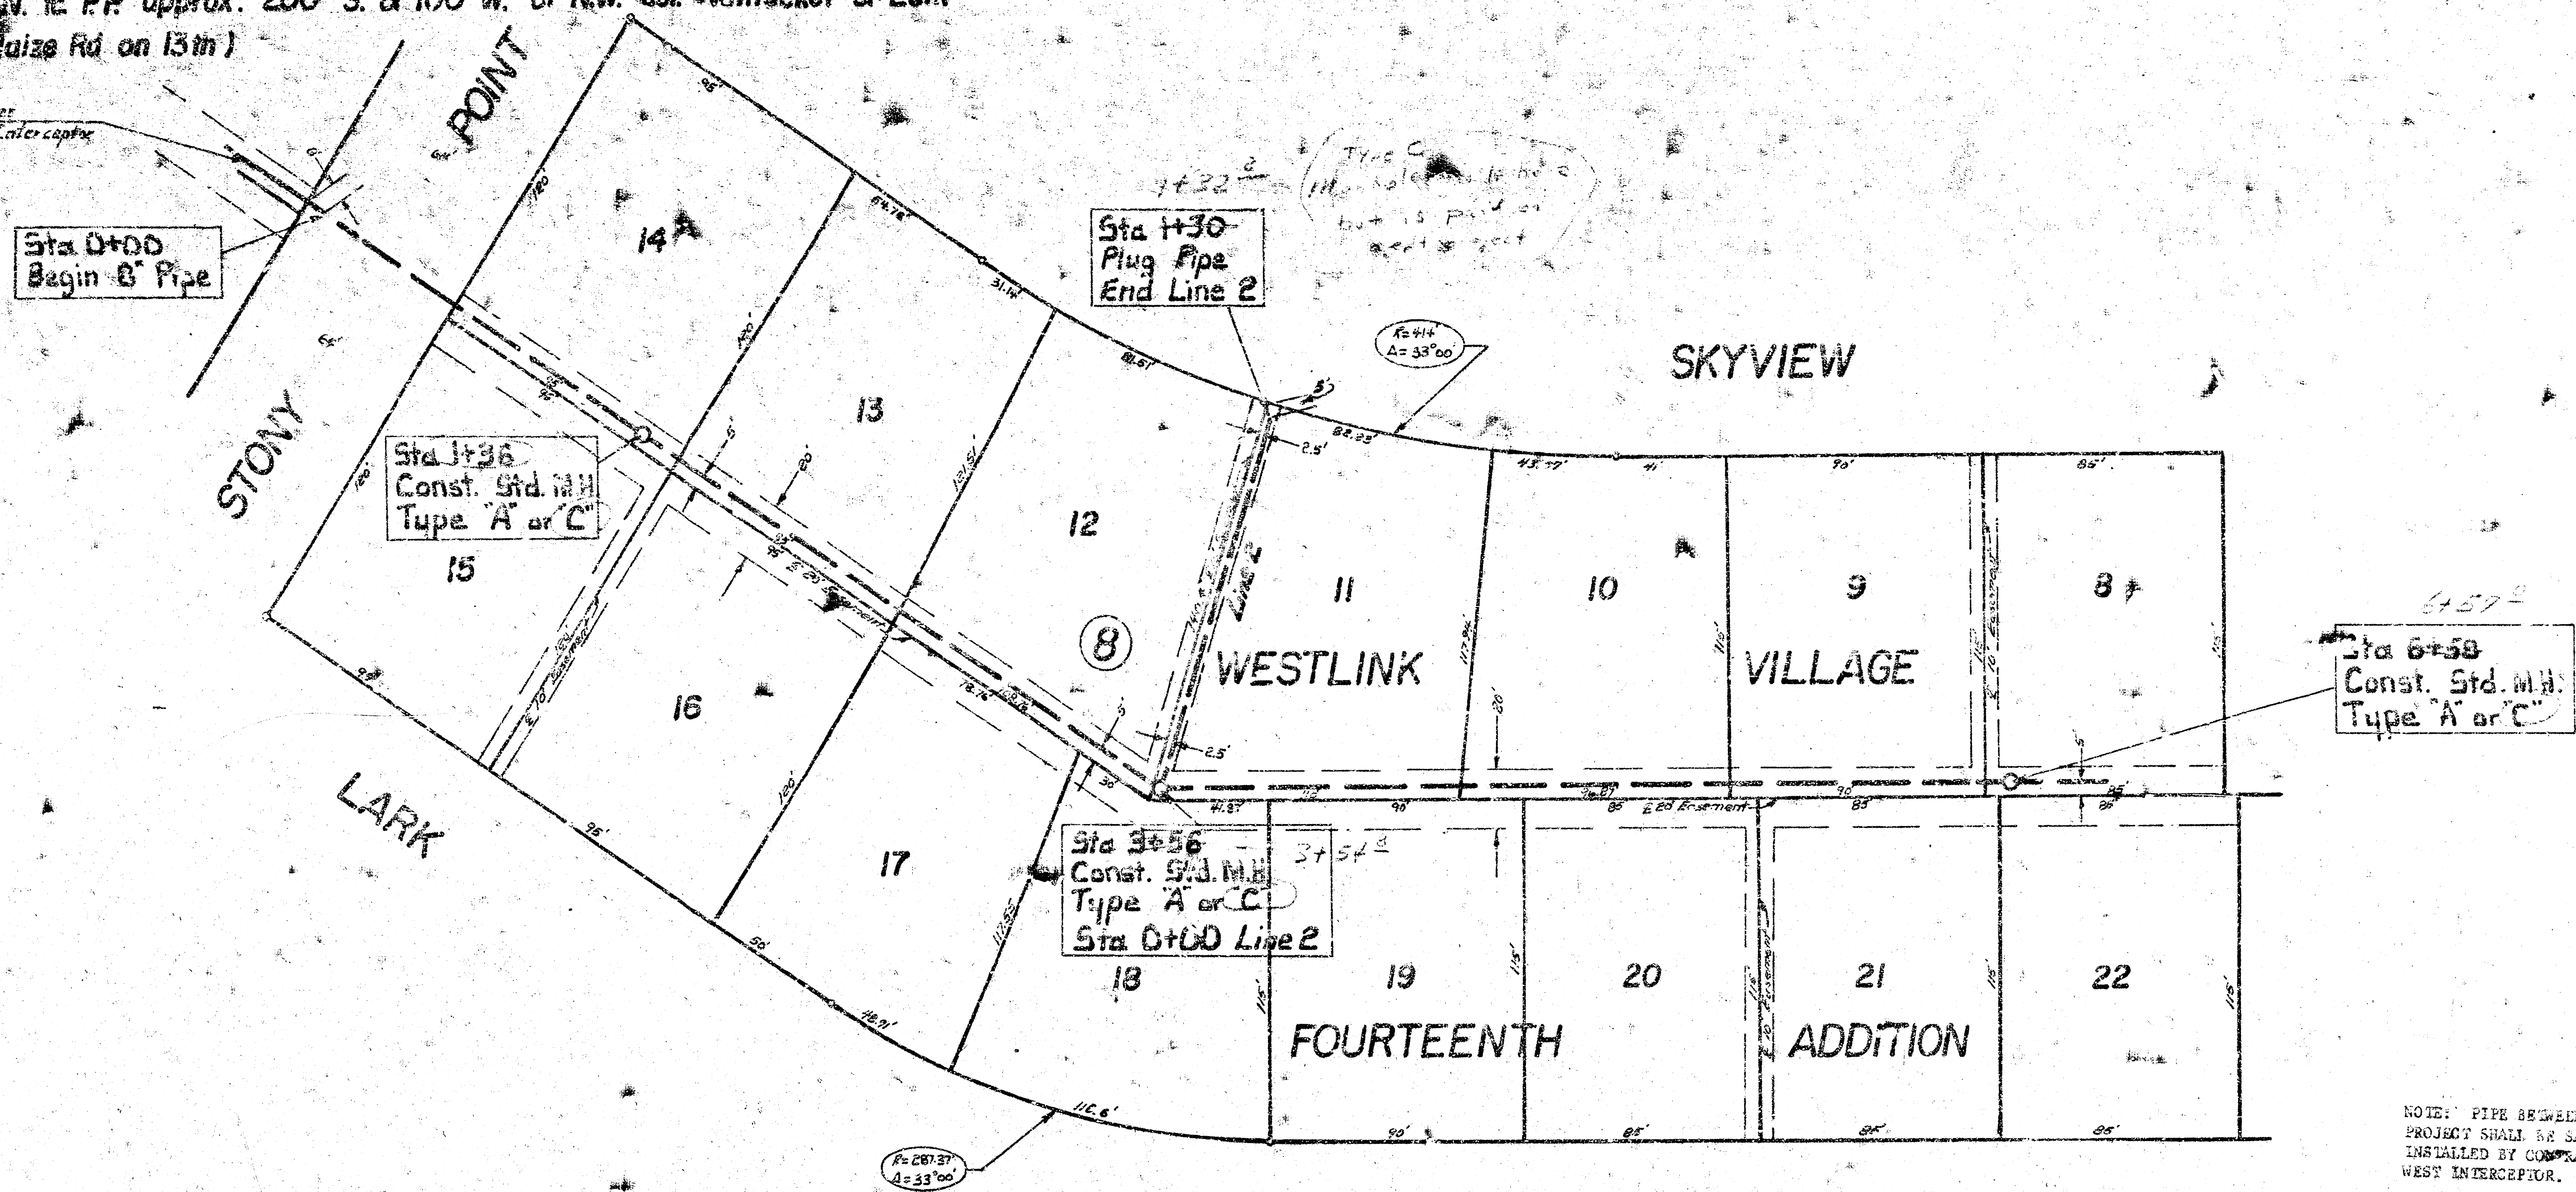


NOTE: PIPE BETWEEN STATION 0+00 AND STATION 1+36 ON THIS PROJECT SHALL BE SAME TYPE OF PIPE AS THAT WHICH IS TO BE INSTALLED BY CONTRACTOR FOR CONSTRUCTING LATERAL 105, SOUTH-WEST INTERCEPTOR.

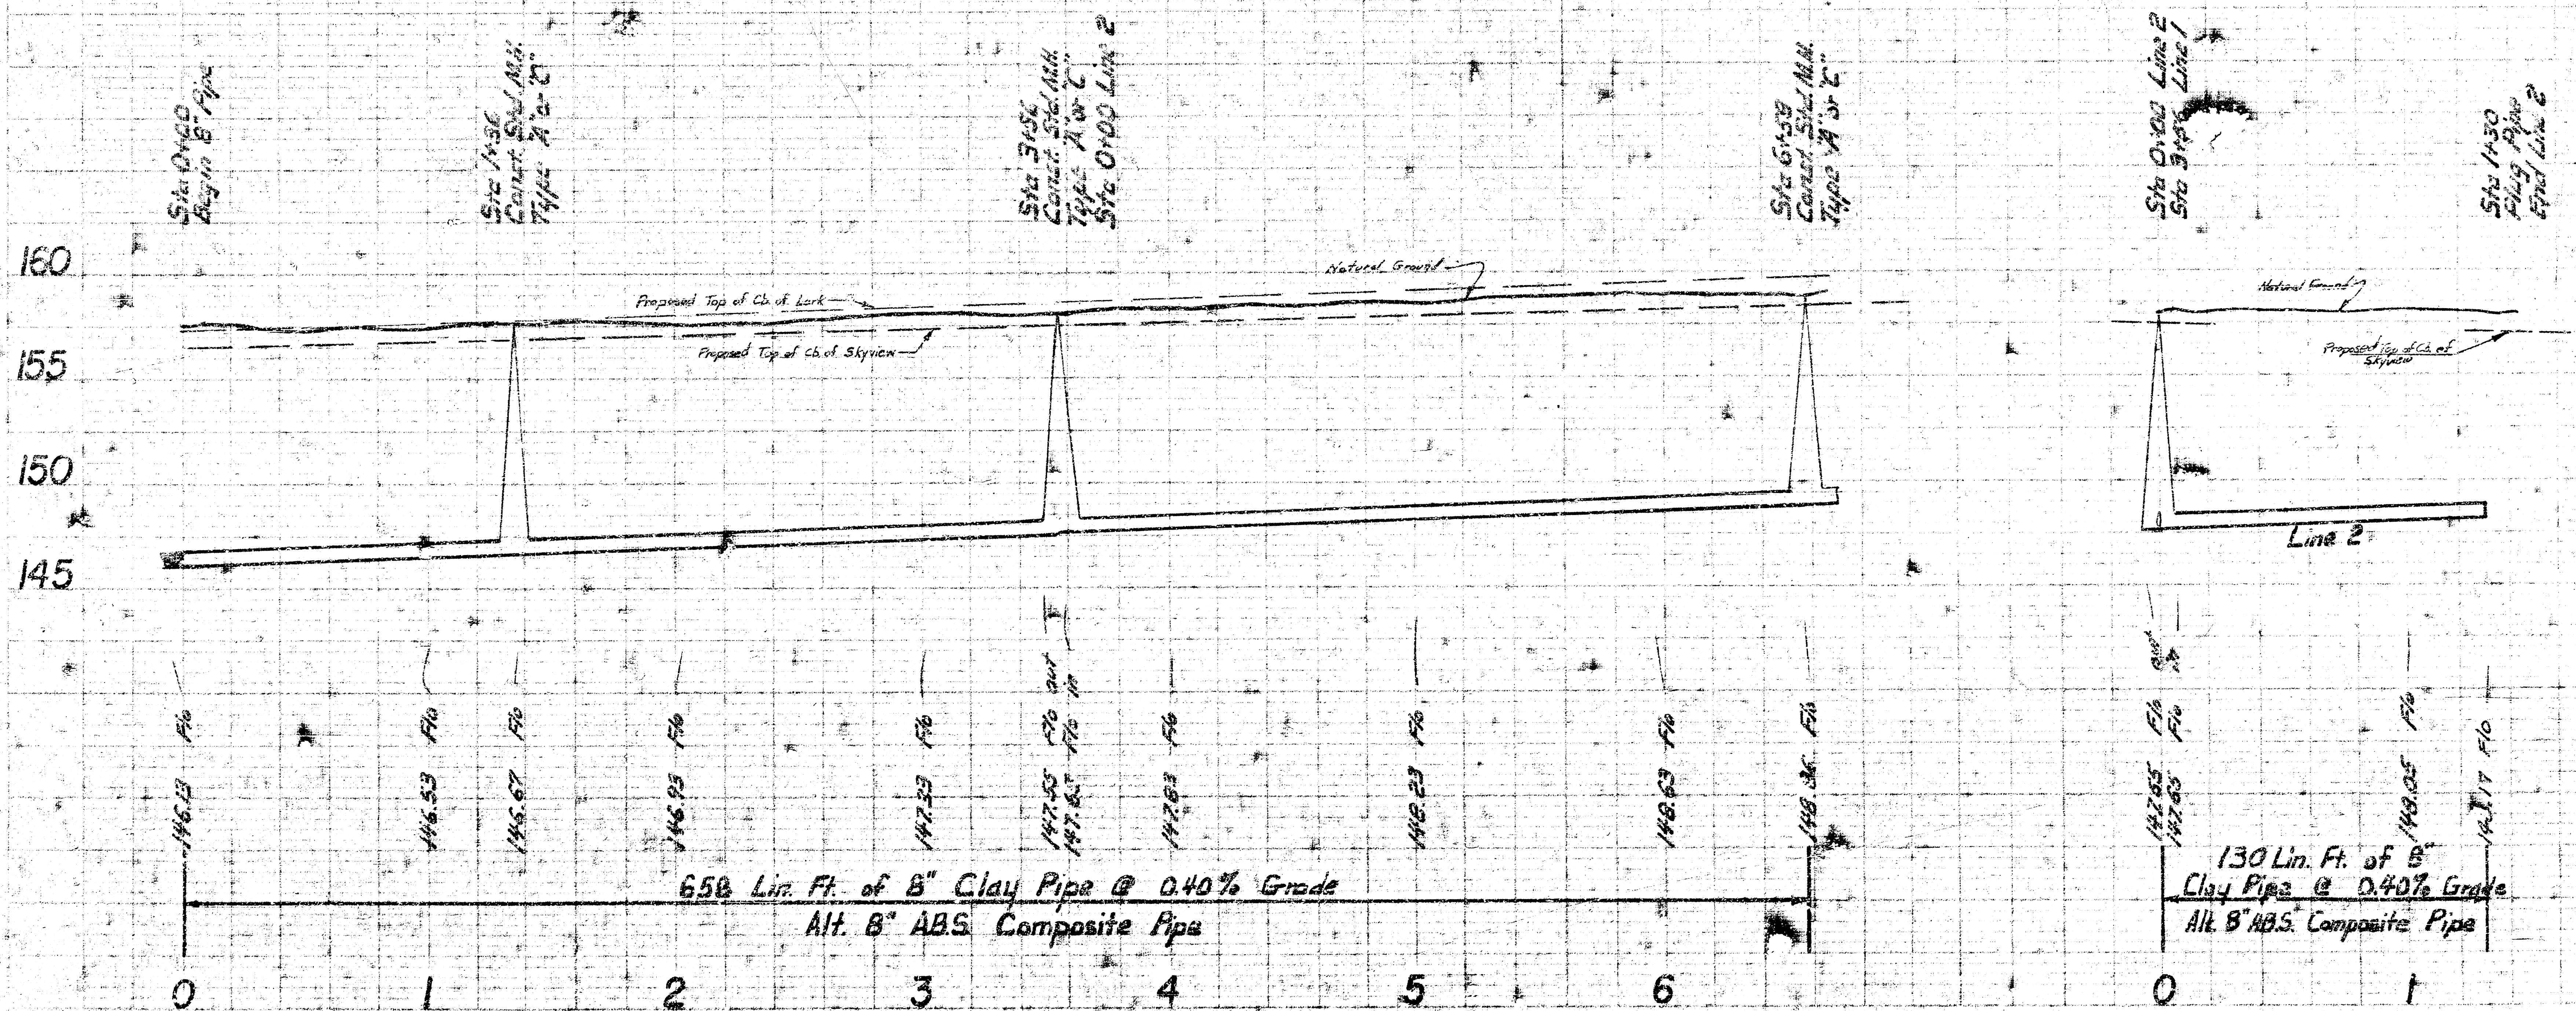


15-11-12/11/15
LAT 106 SOUTHWEST INTERCEPTOR
CITY OF WICHITA, KANSAS
R.W. LINN CITY ENGINEER
PROJ. NO. 468-76-245-80375-000-00
DATE

Don L. Sprague
Steve Palmer
April 77

21A420

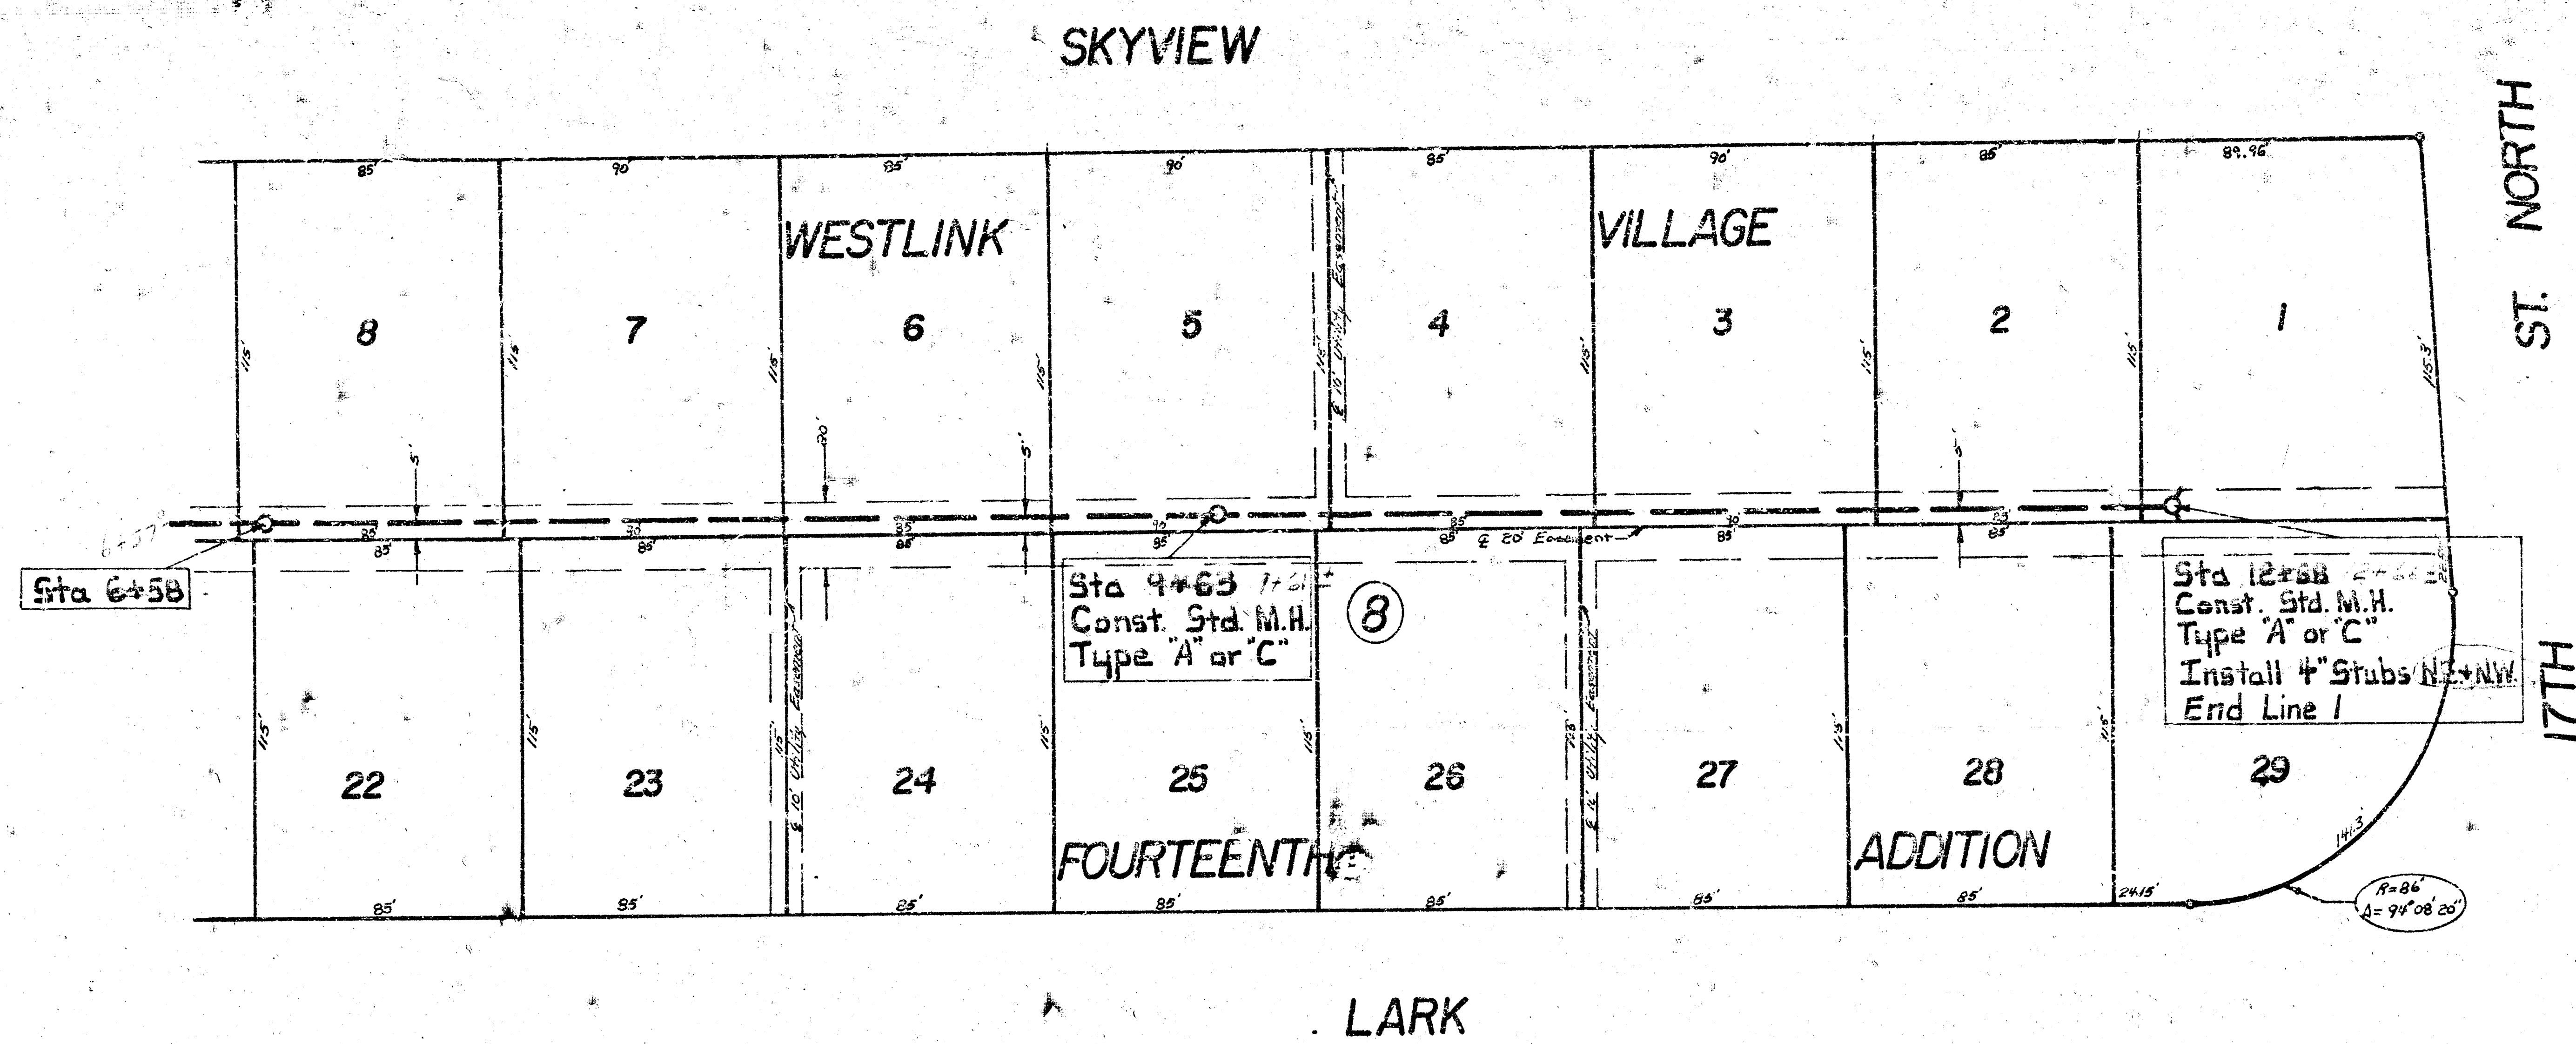

Plan Scale 1"=40'
Profile Scale 1"=40'
1"=5'

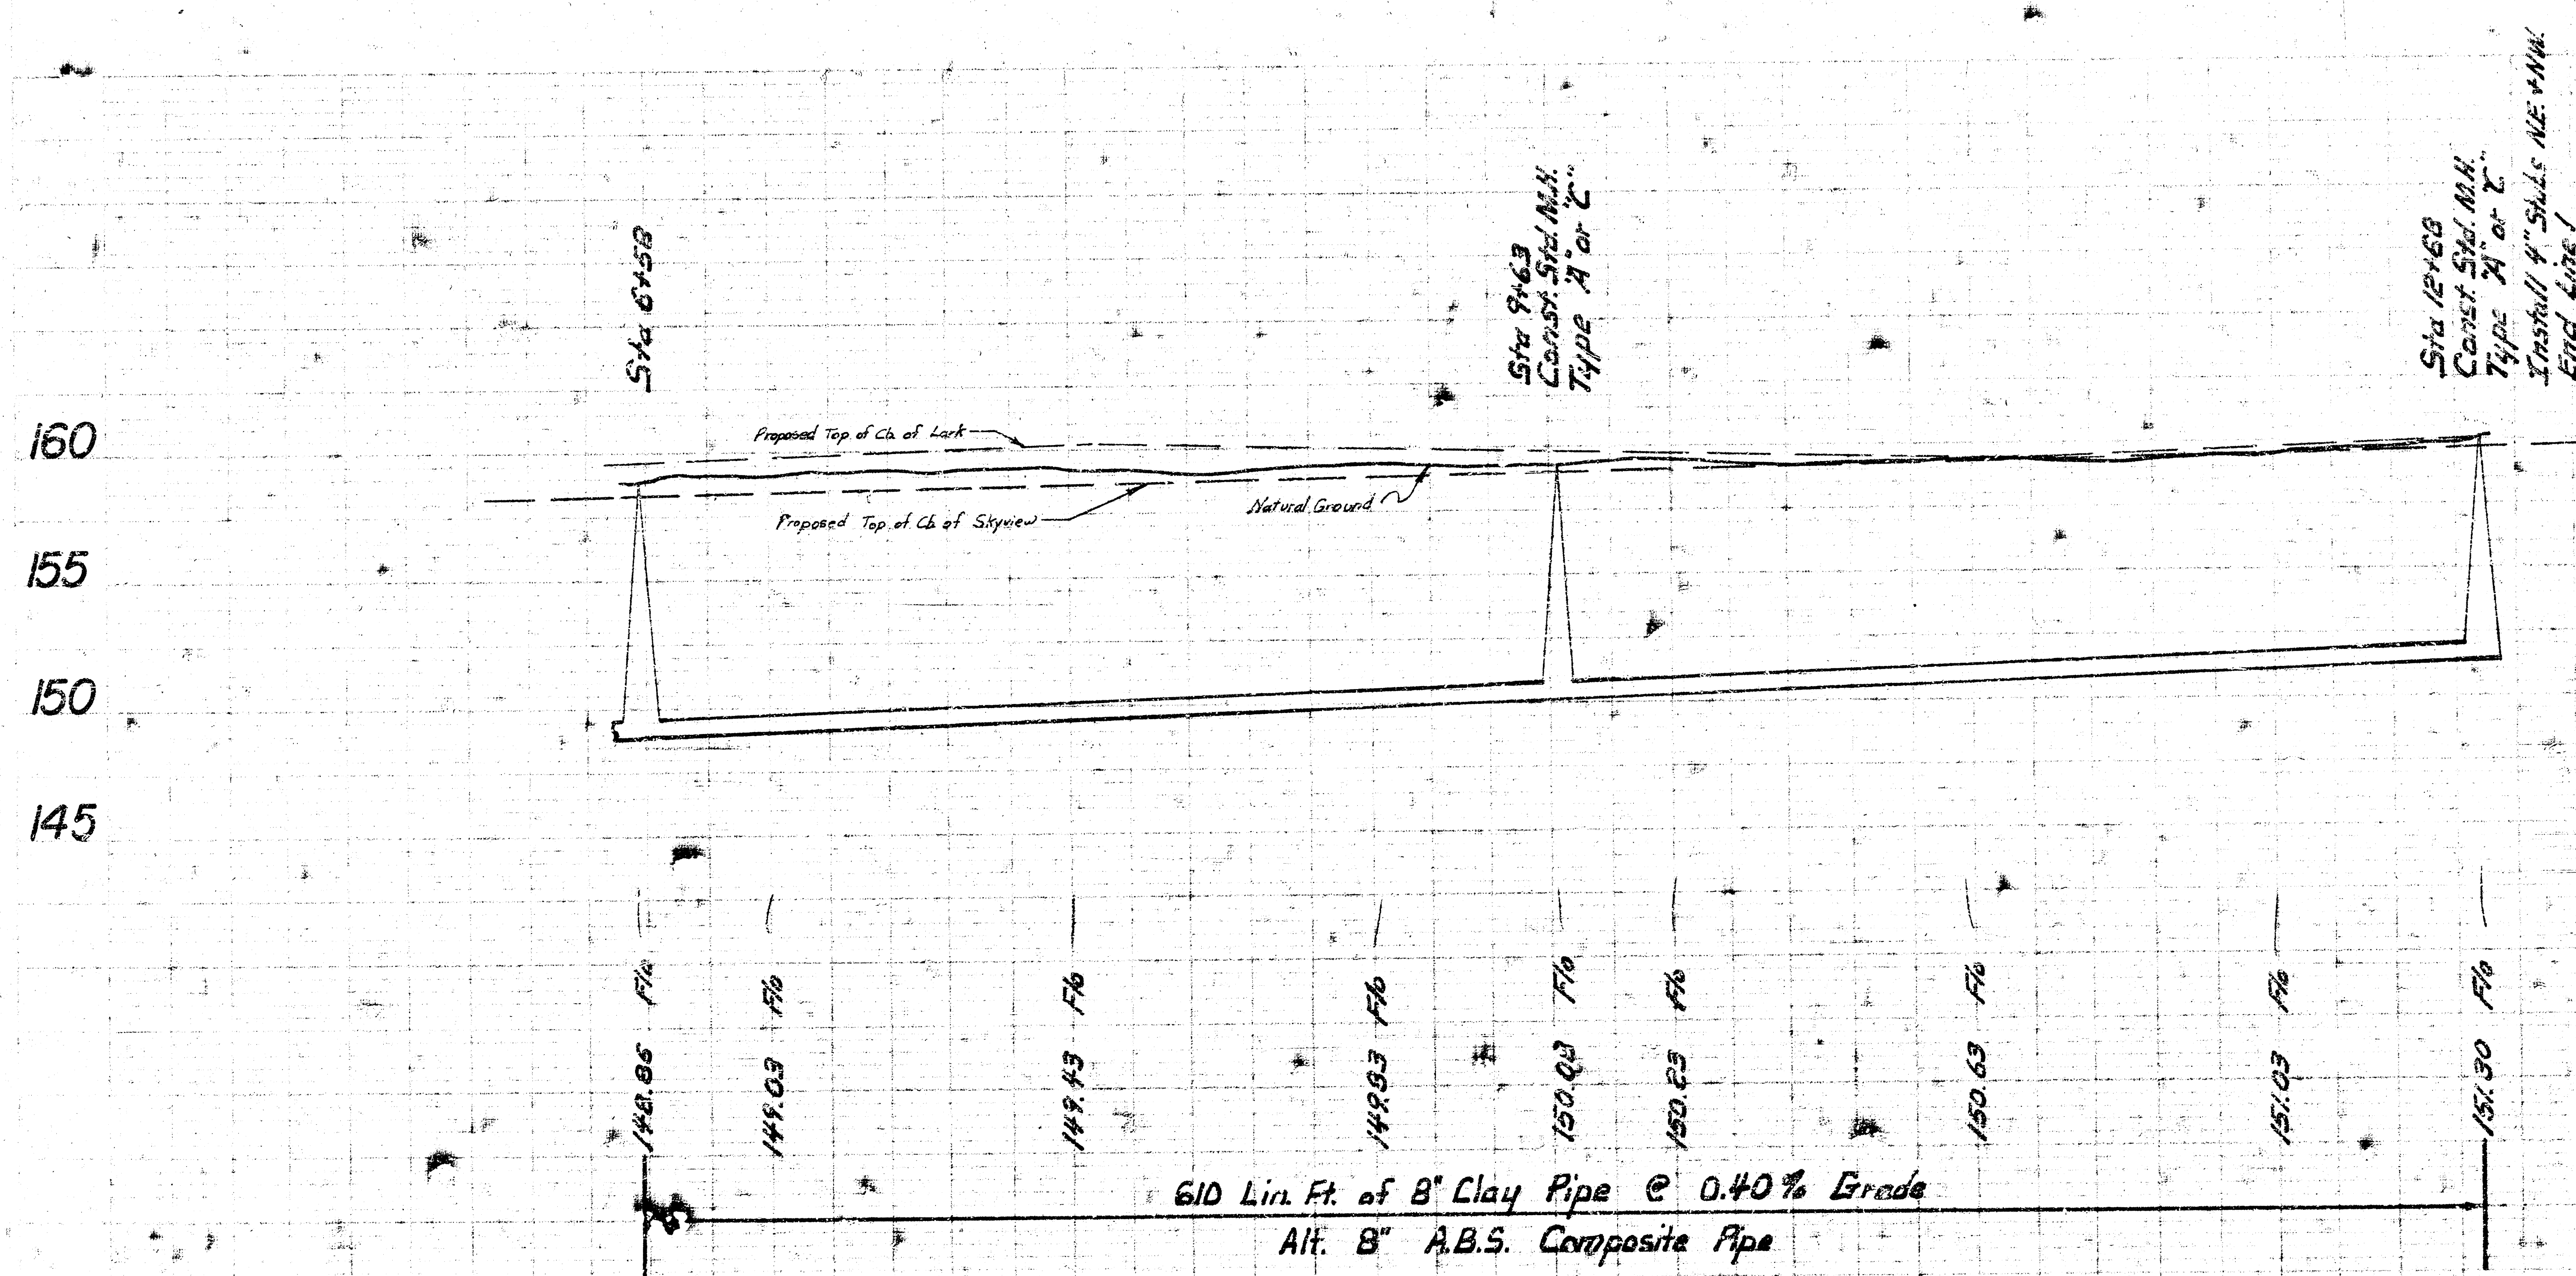

LAT 106 SOUTHWEST INTERCE
PROJ. NO. 468-76-245-80375-000-00