

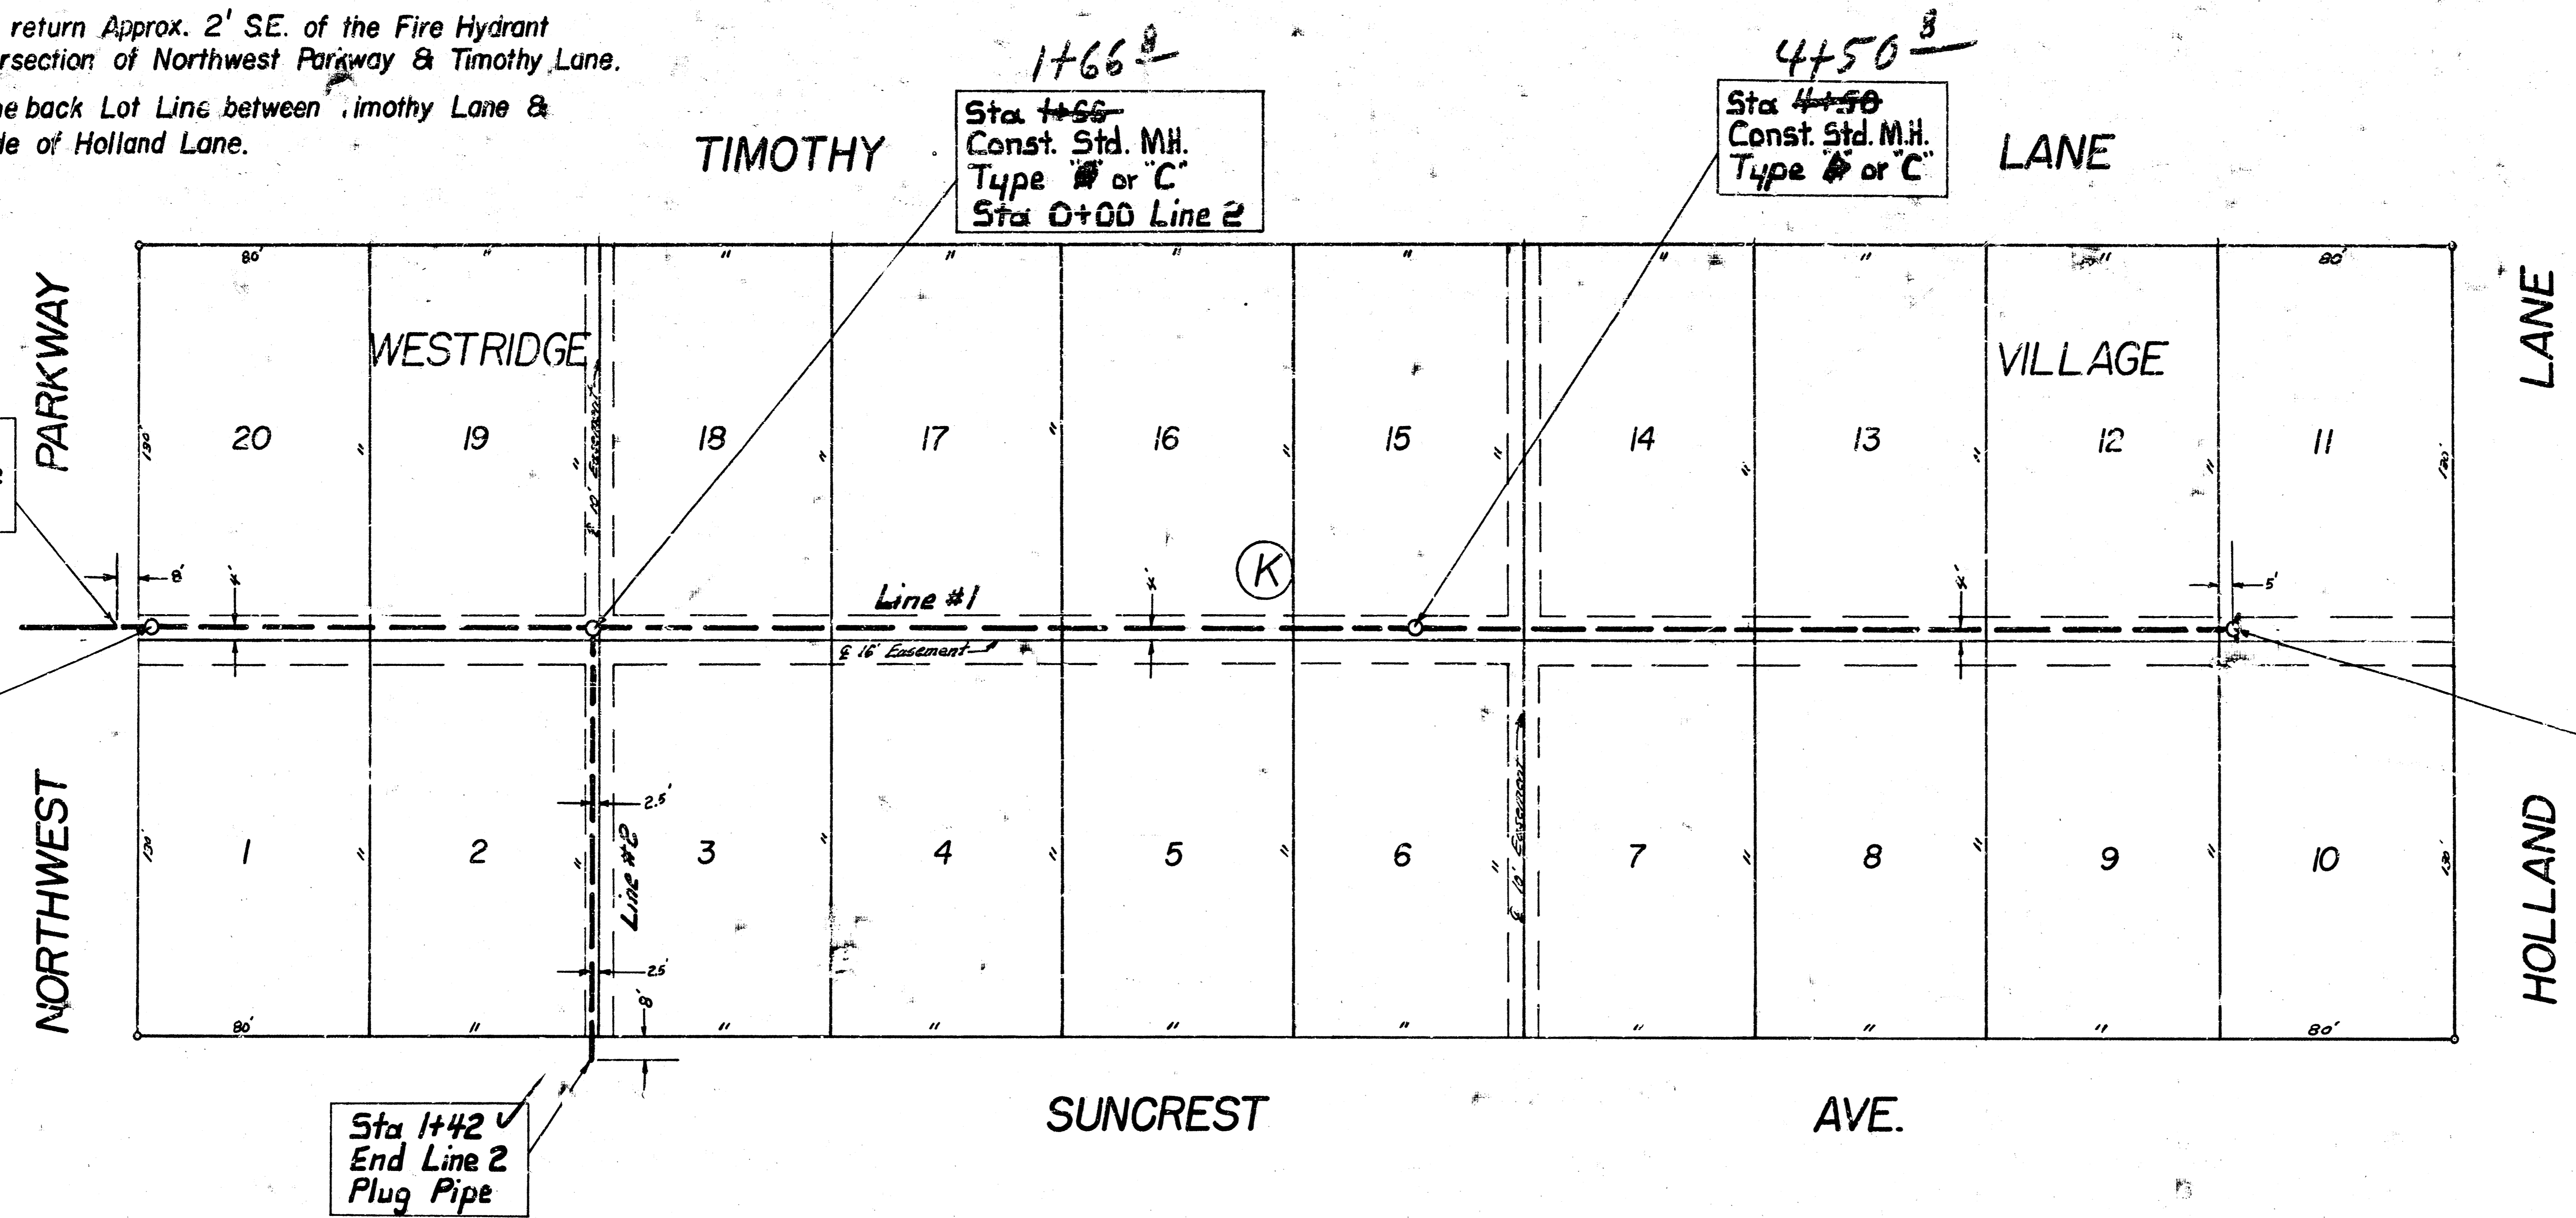


BM 152.45 "Chisel Mark in top of curb return Approx. 2' SE. of the Fire Hydrant on the NW. corner of the Intersection of Northwest Parkway & Timothy Lane.  
 BM 155.89 Top of Prop. Iron in conc. at the back Lot Line between Timothy Lane & Suncrest Ave. at the West side of Holland Lane.

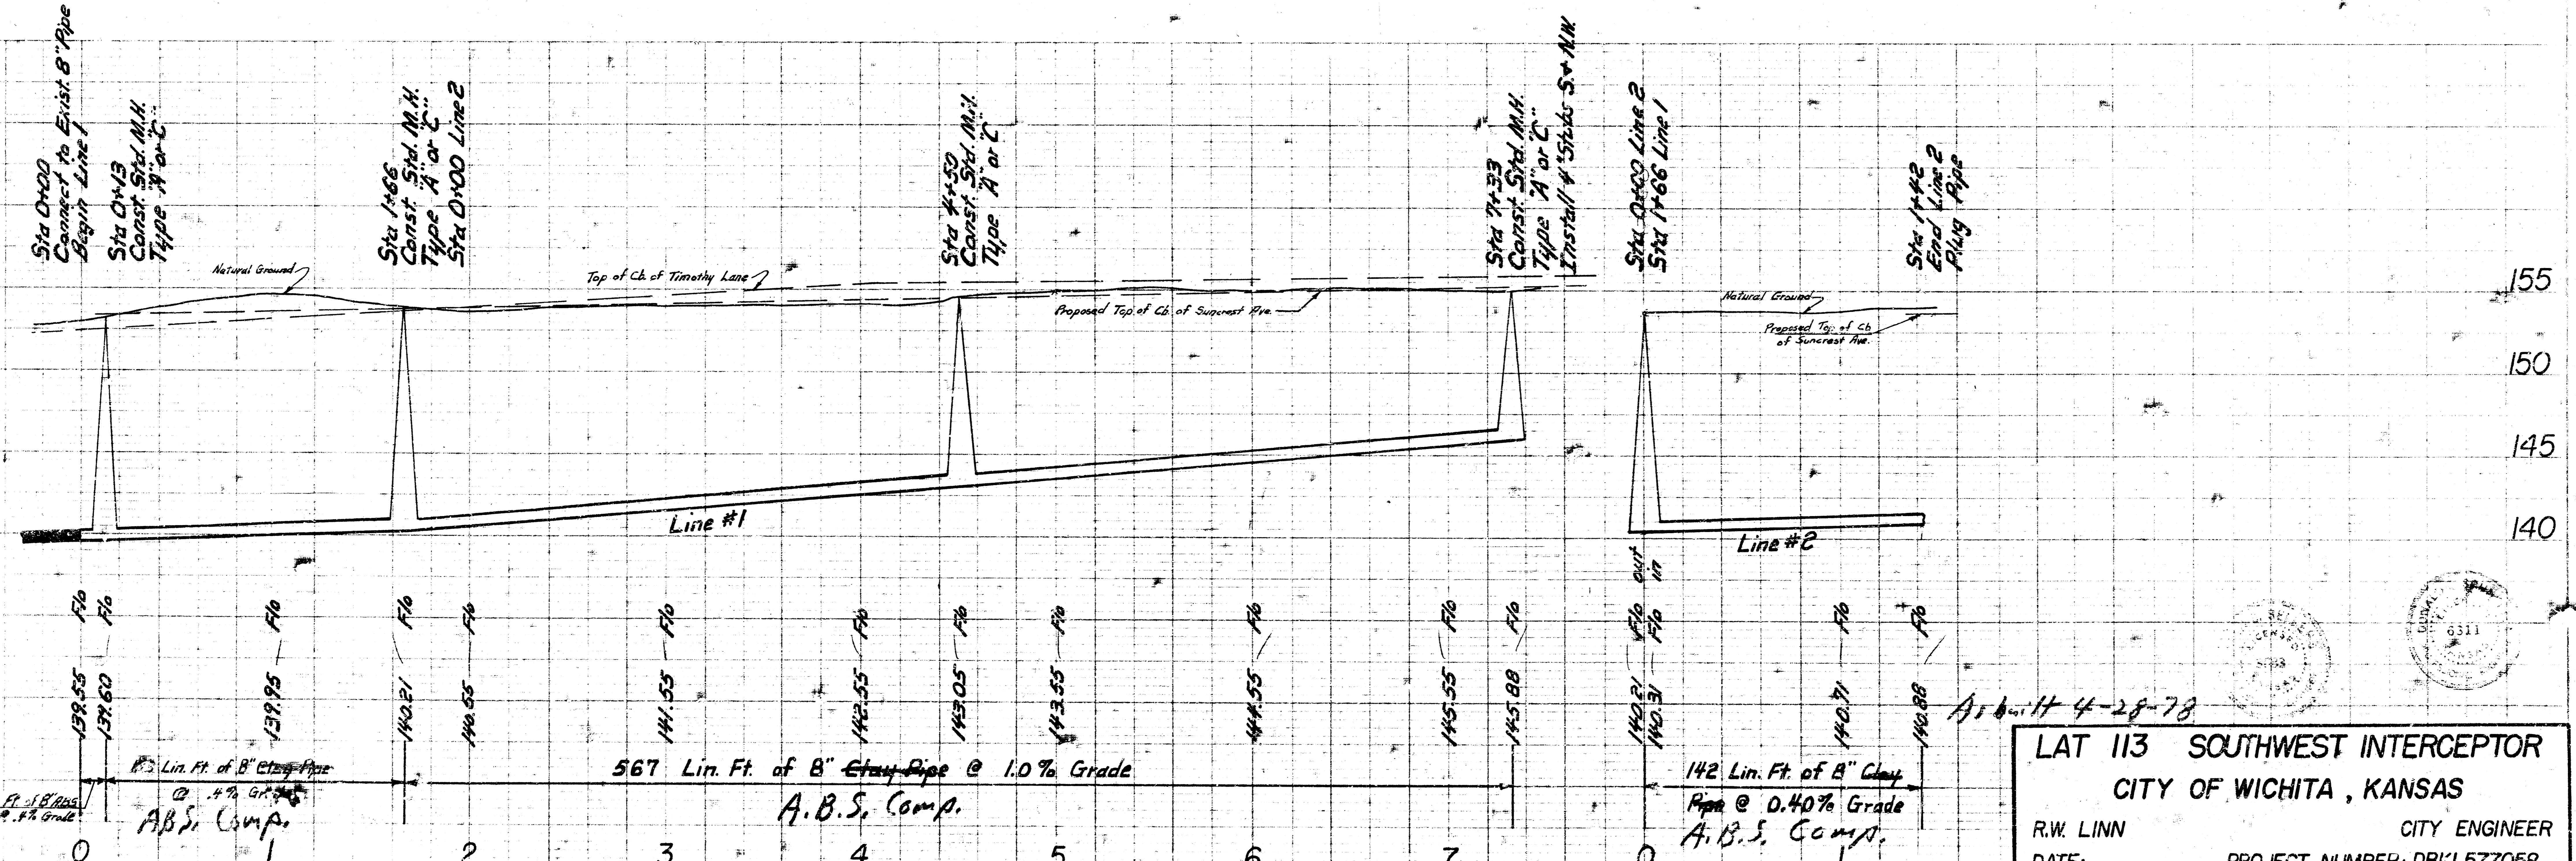

Plan Scale 1" = 40'  
 Profile Scale 1" = 40' Hor.  
 1" = 5' Vert.

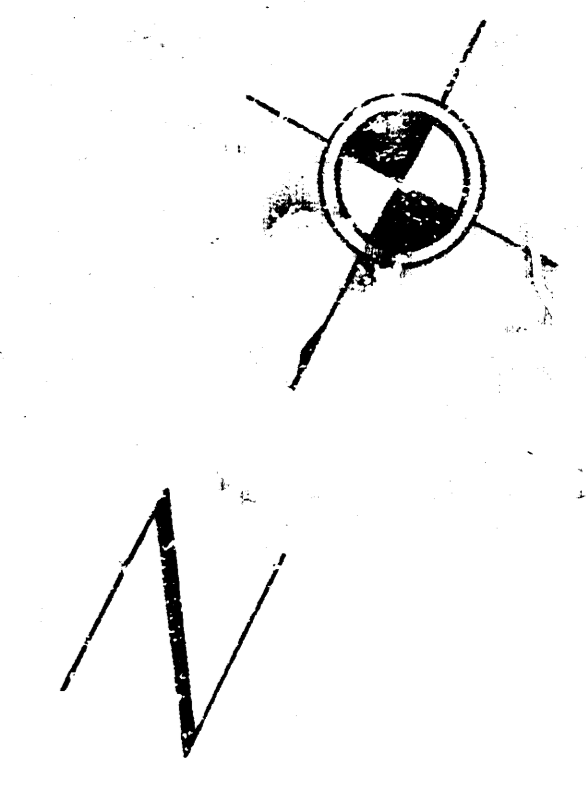

As of 4-28-78  
**LAT 113 SOUTHWEST INTERCEPTOR**  
**CITY OF WICHITA, KANSAS**  
 R.W. LINN CITY ENGINEER  
 DATE: \_\_\_\_\_ PROJECT NUMBER: DBKL577058