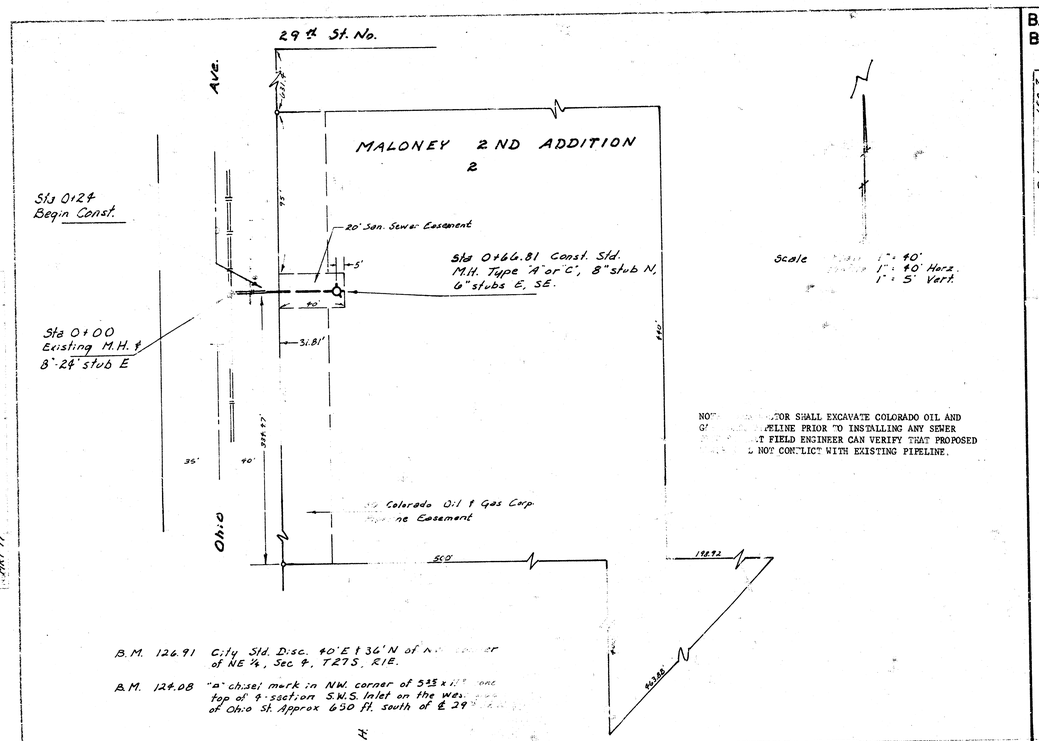


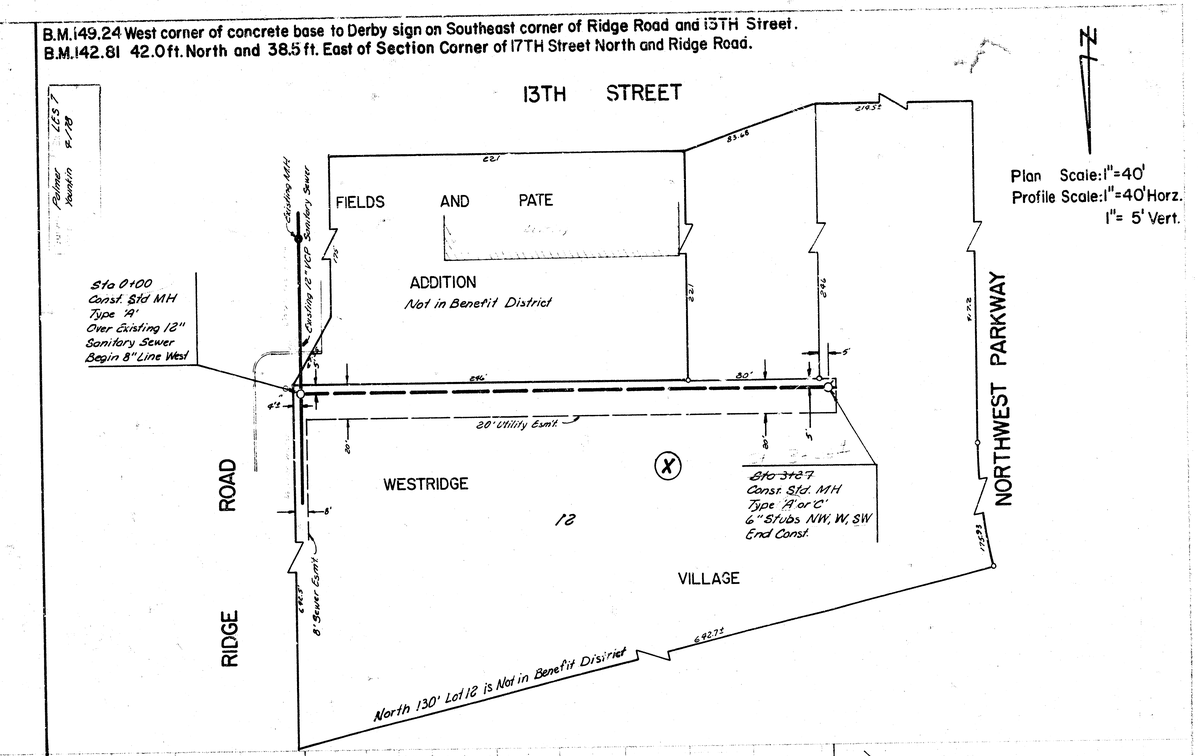


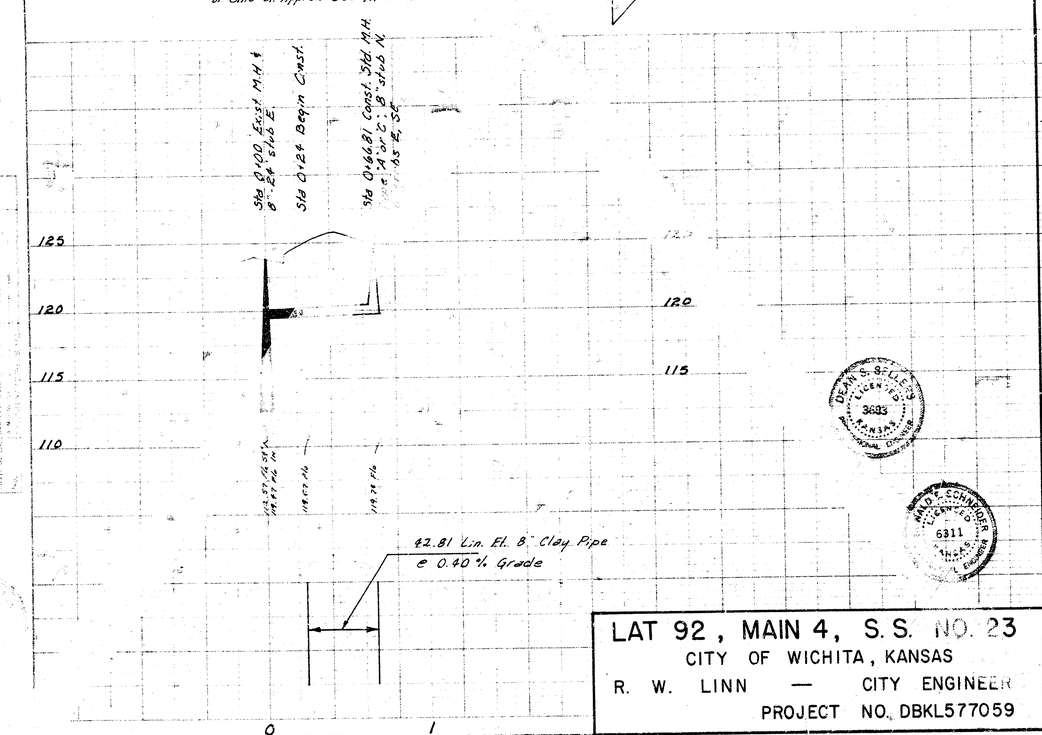


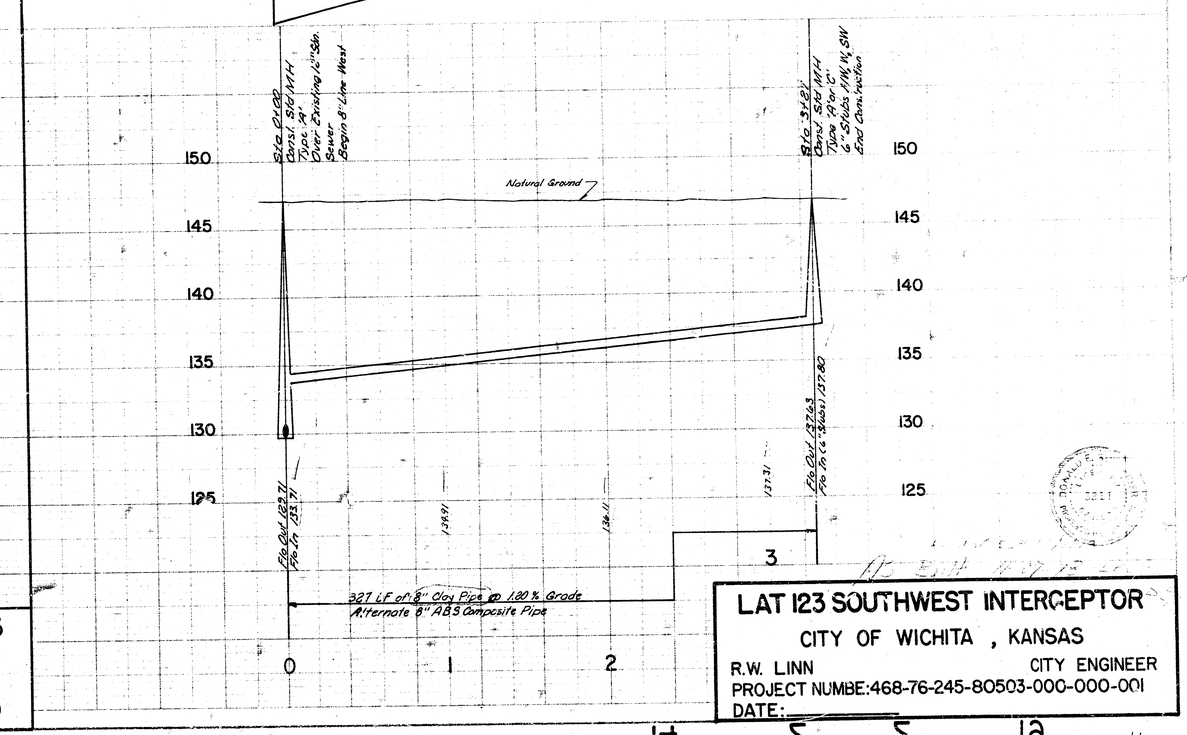


LAT 92, MAIN 4, S.S. NO. 23
CITY OF WICHITA, KANSAS
R. W. LINN — CITY ENGINEER
PROJECT NO. DBKL577059

LAT 123 SOUTHWEST INTERCEPTOR
CITY OF WICHITA, KANSAS
R.W. LINN CITY ENGINEER
PROJECT NUMBE: 468-76-245-80503-000-000-001
DATE:

PLAN
PROFILE