


PLAN
JPC:SZL

PROFILE

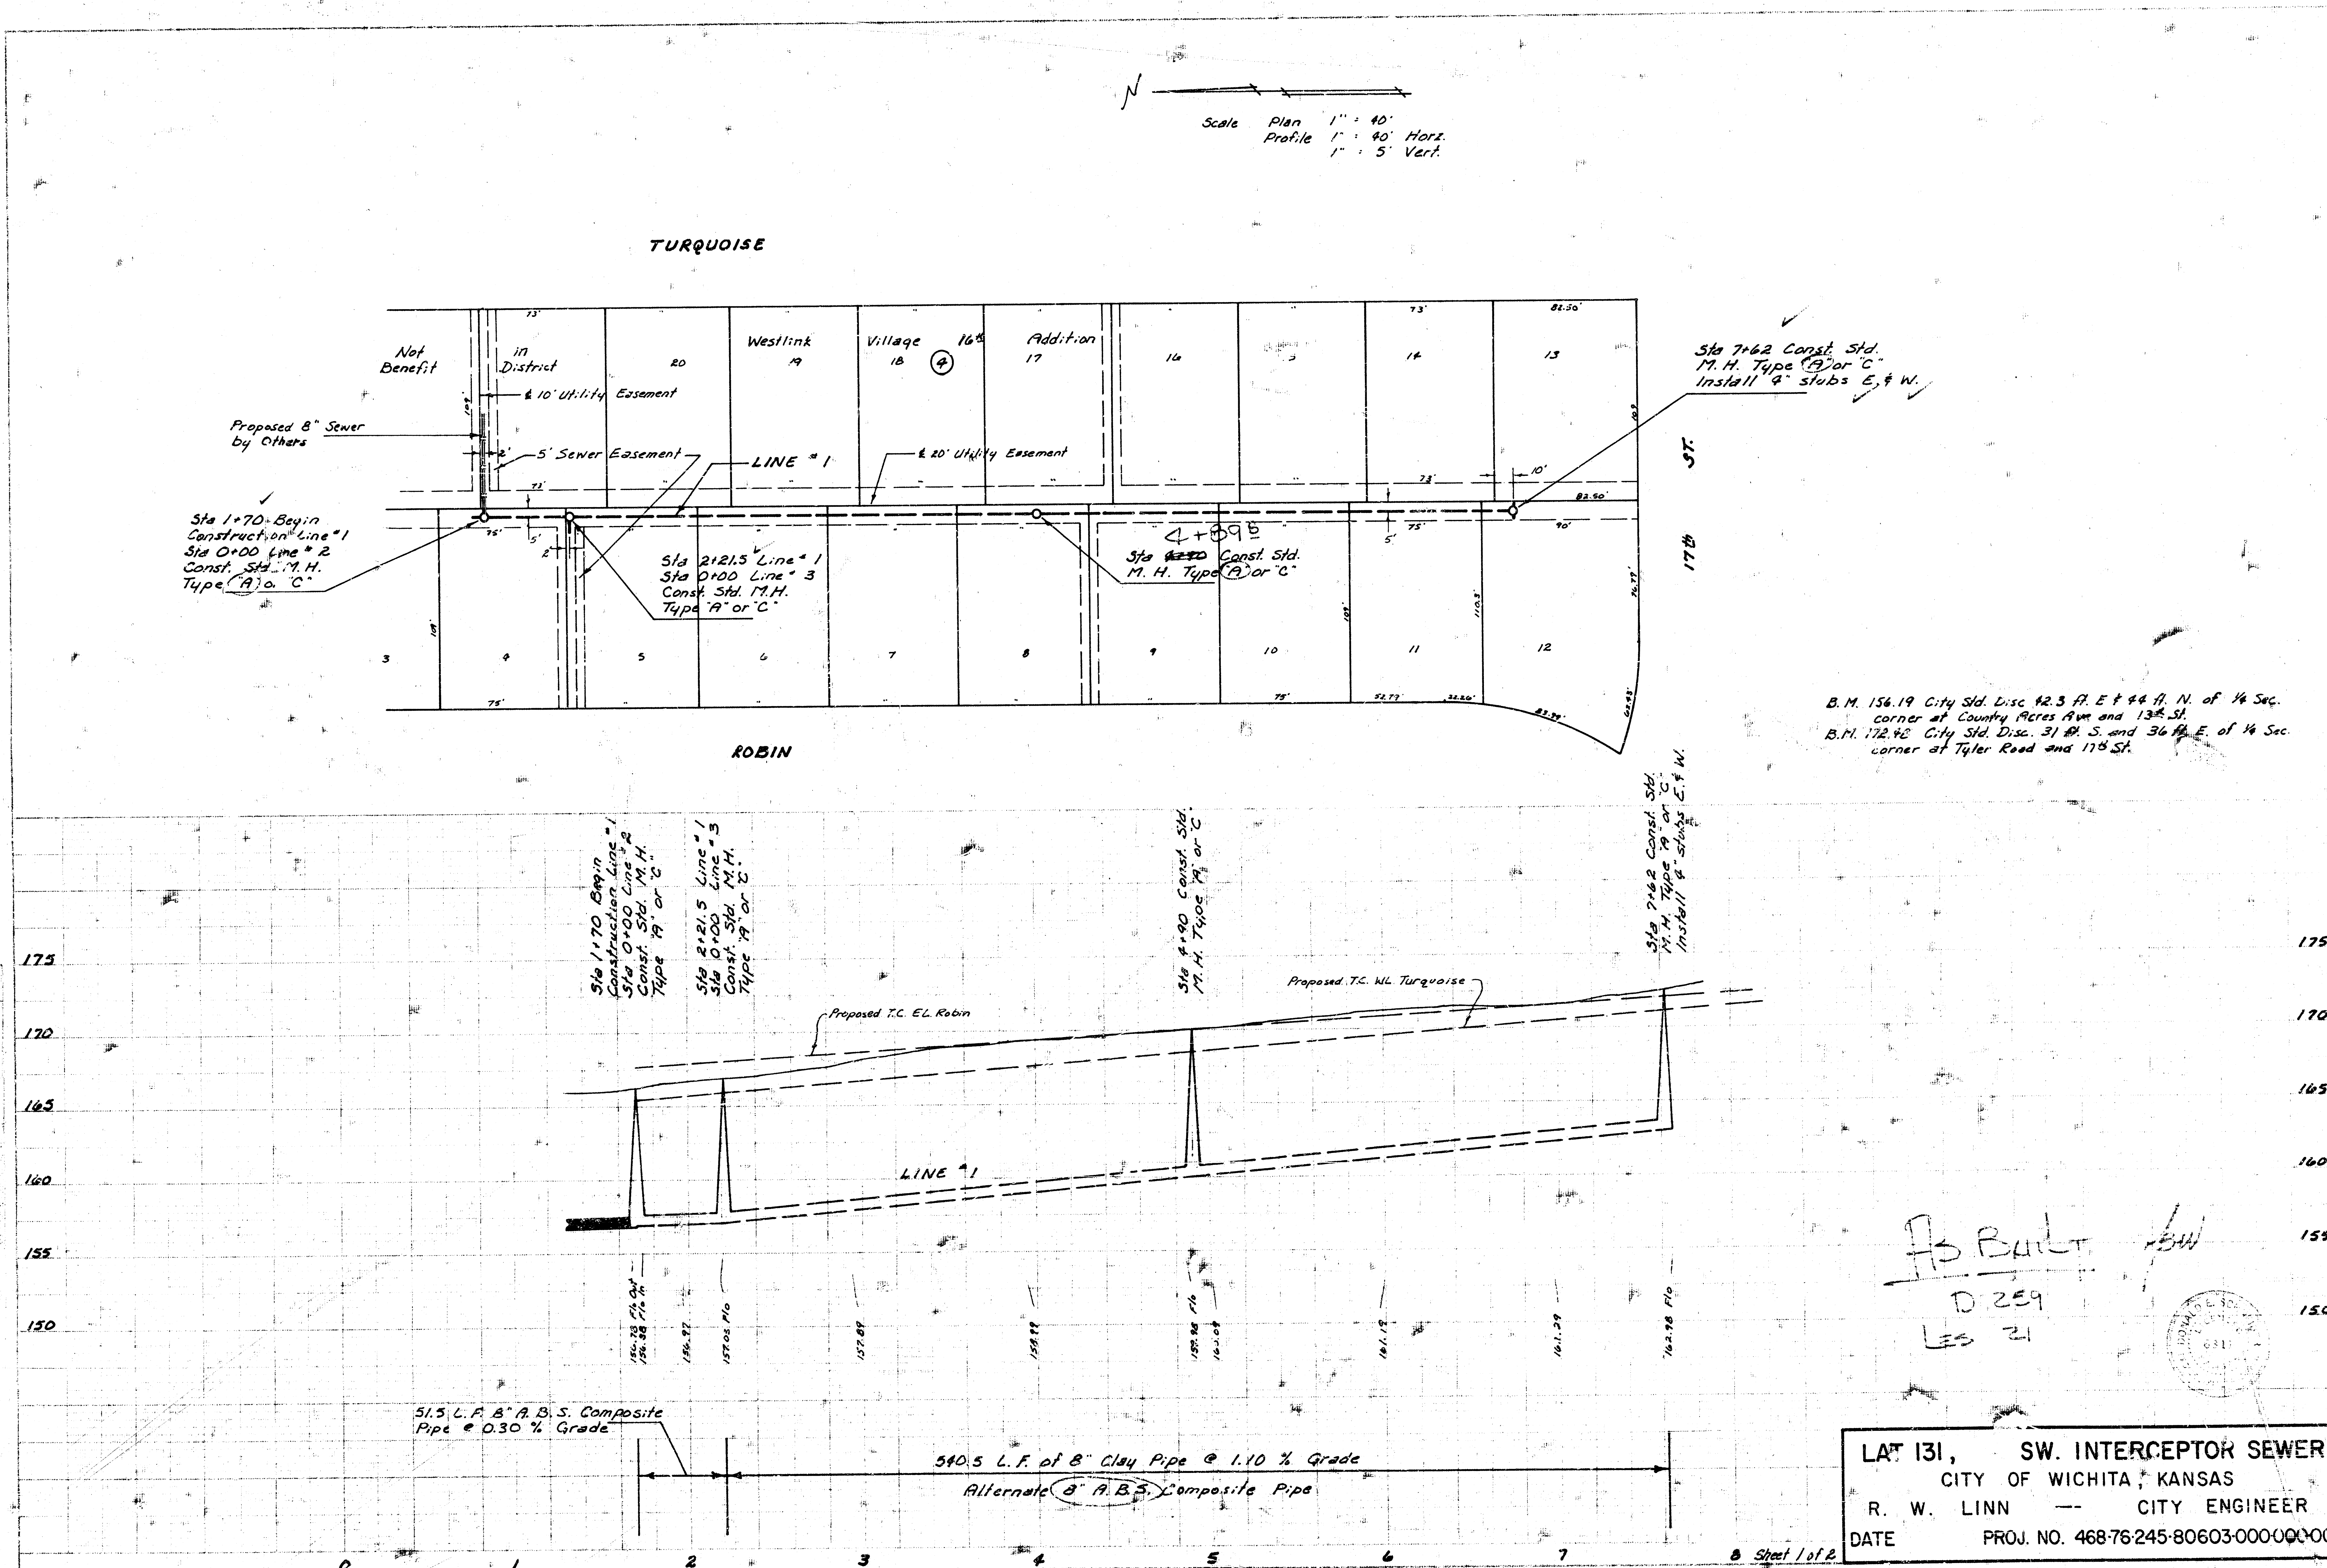

PLAN
NOTE: SEE SHEET 14-8-5-10

PROFILE
NOTE: SEE SHEET 14-8-5-10

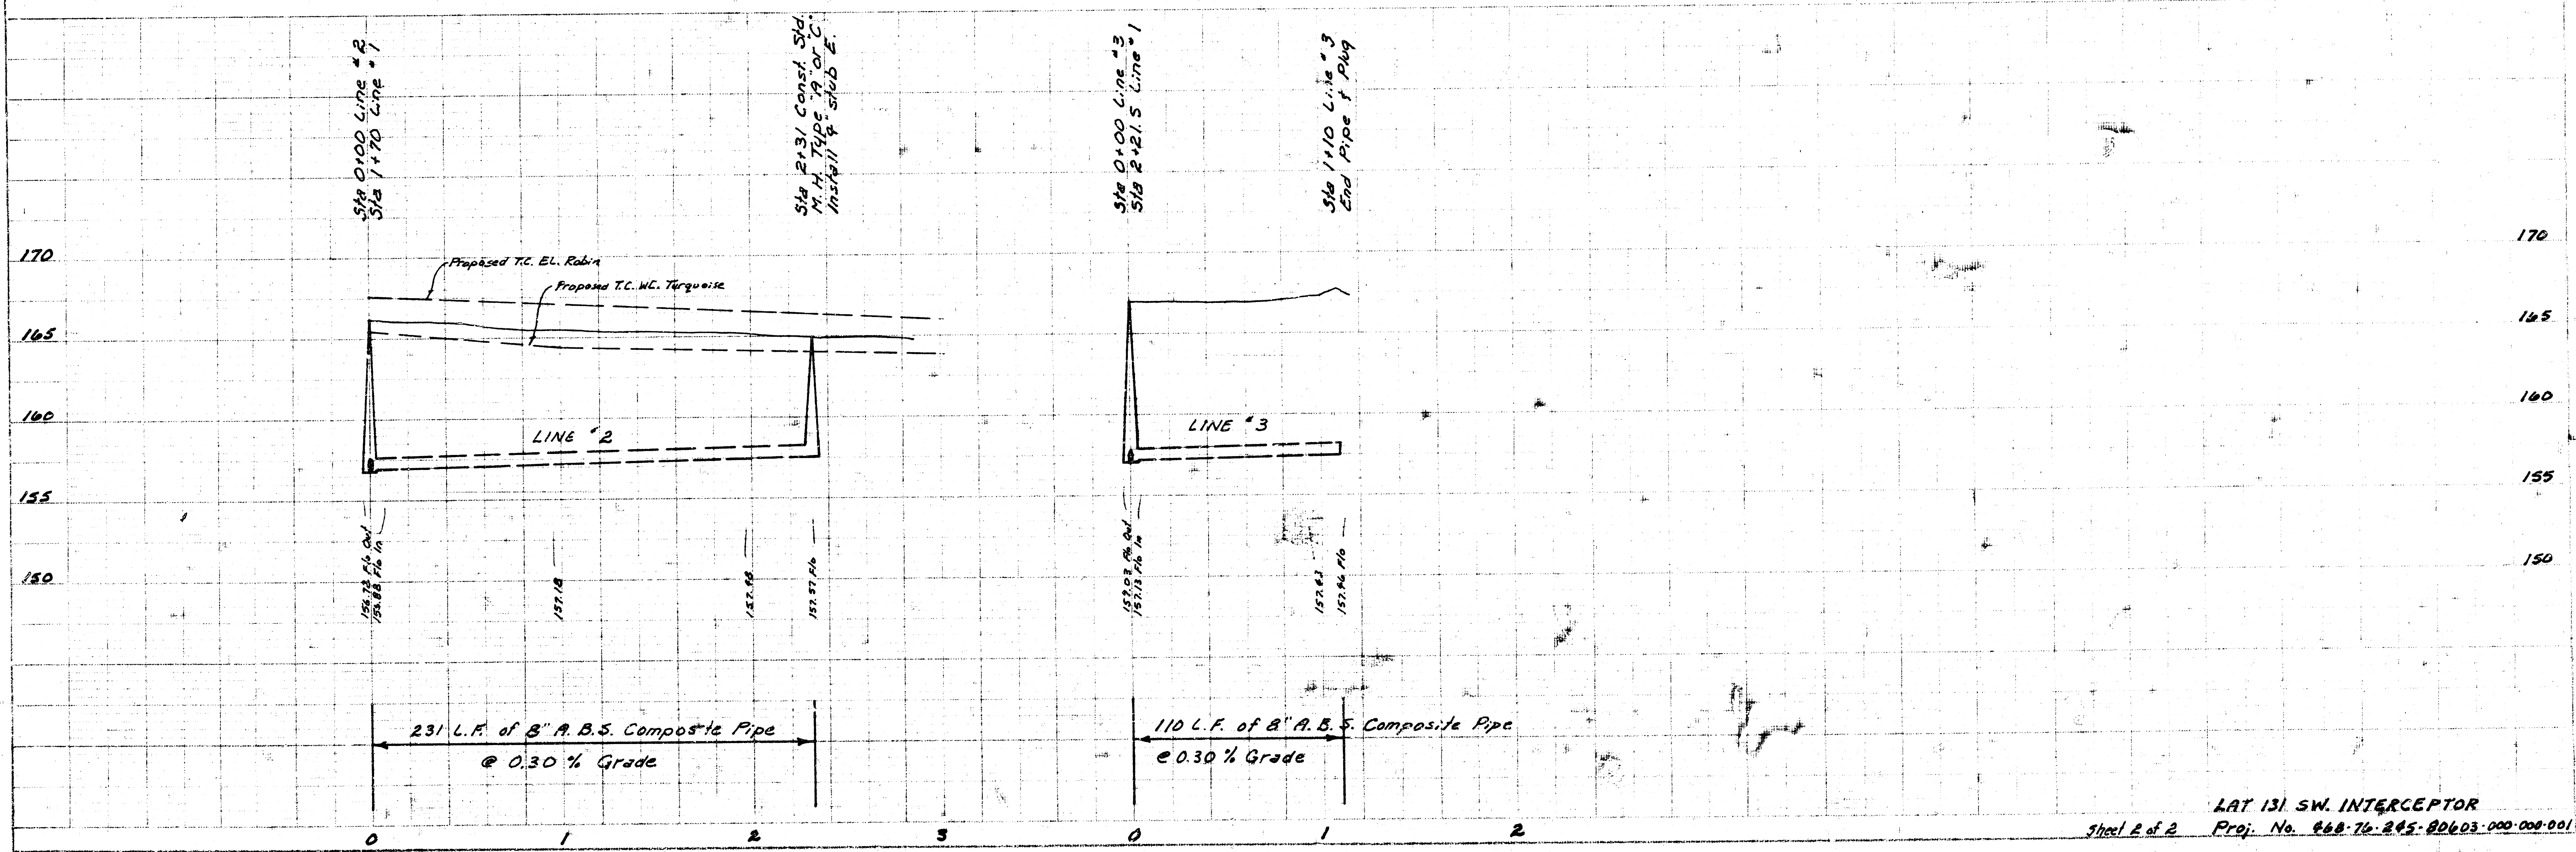
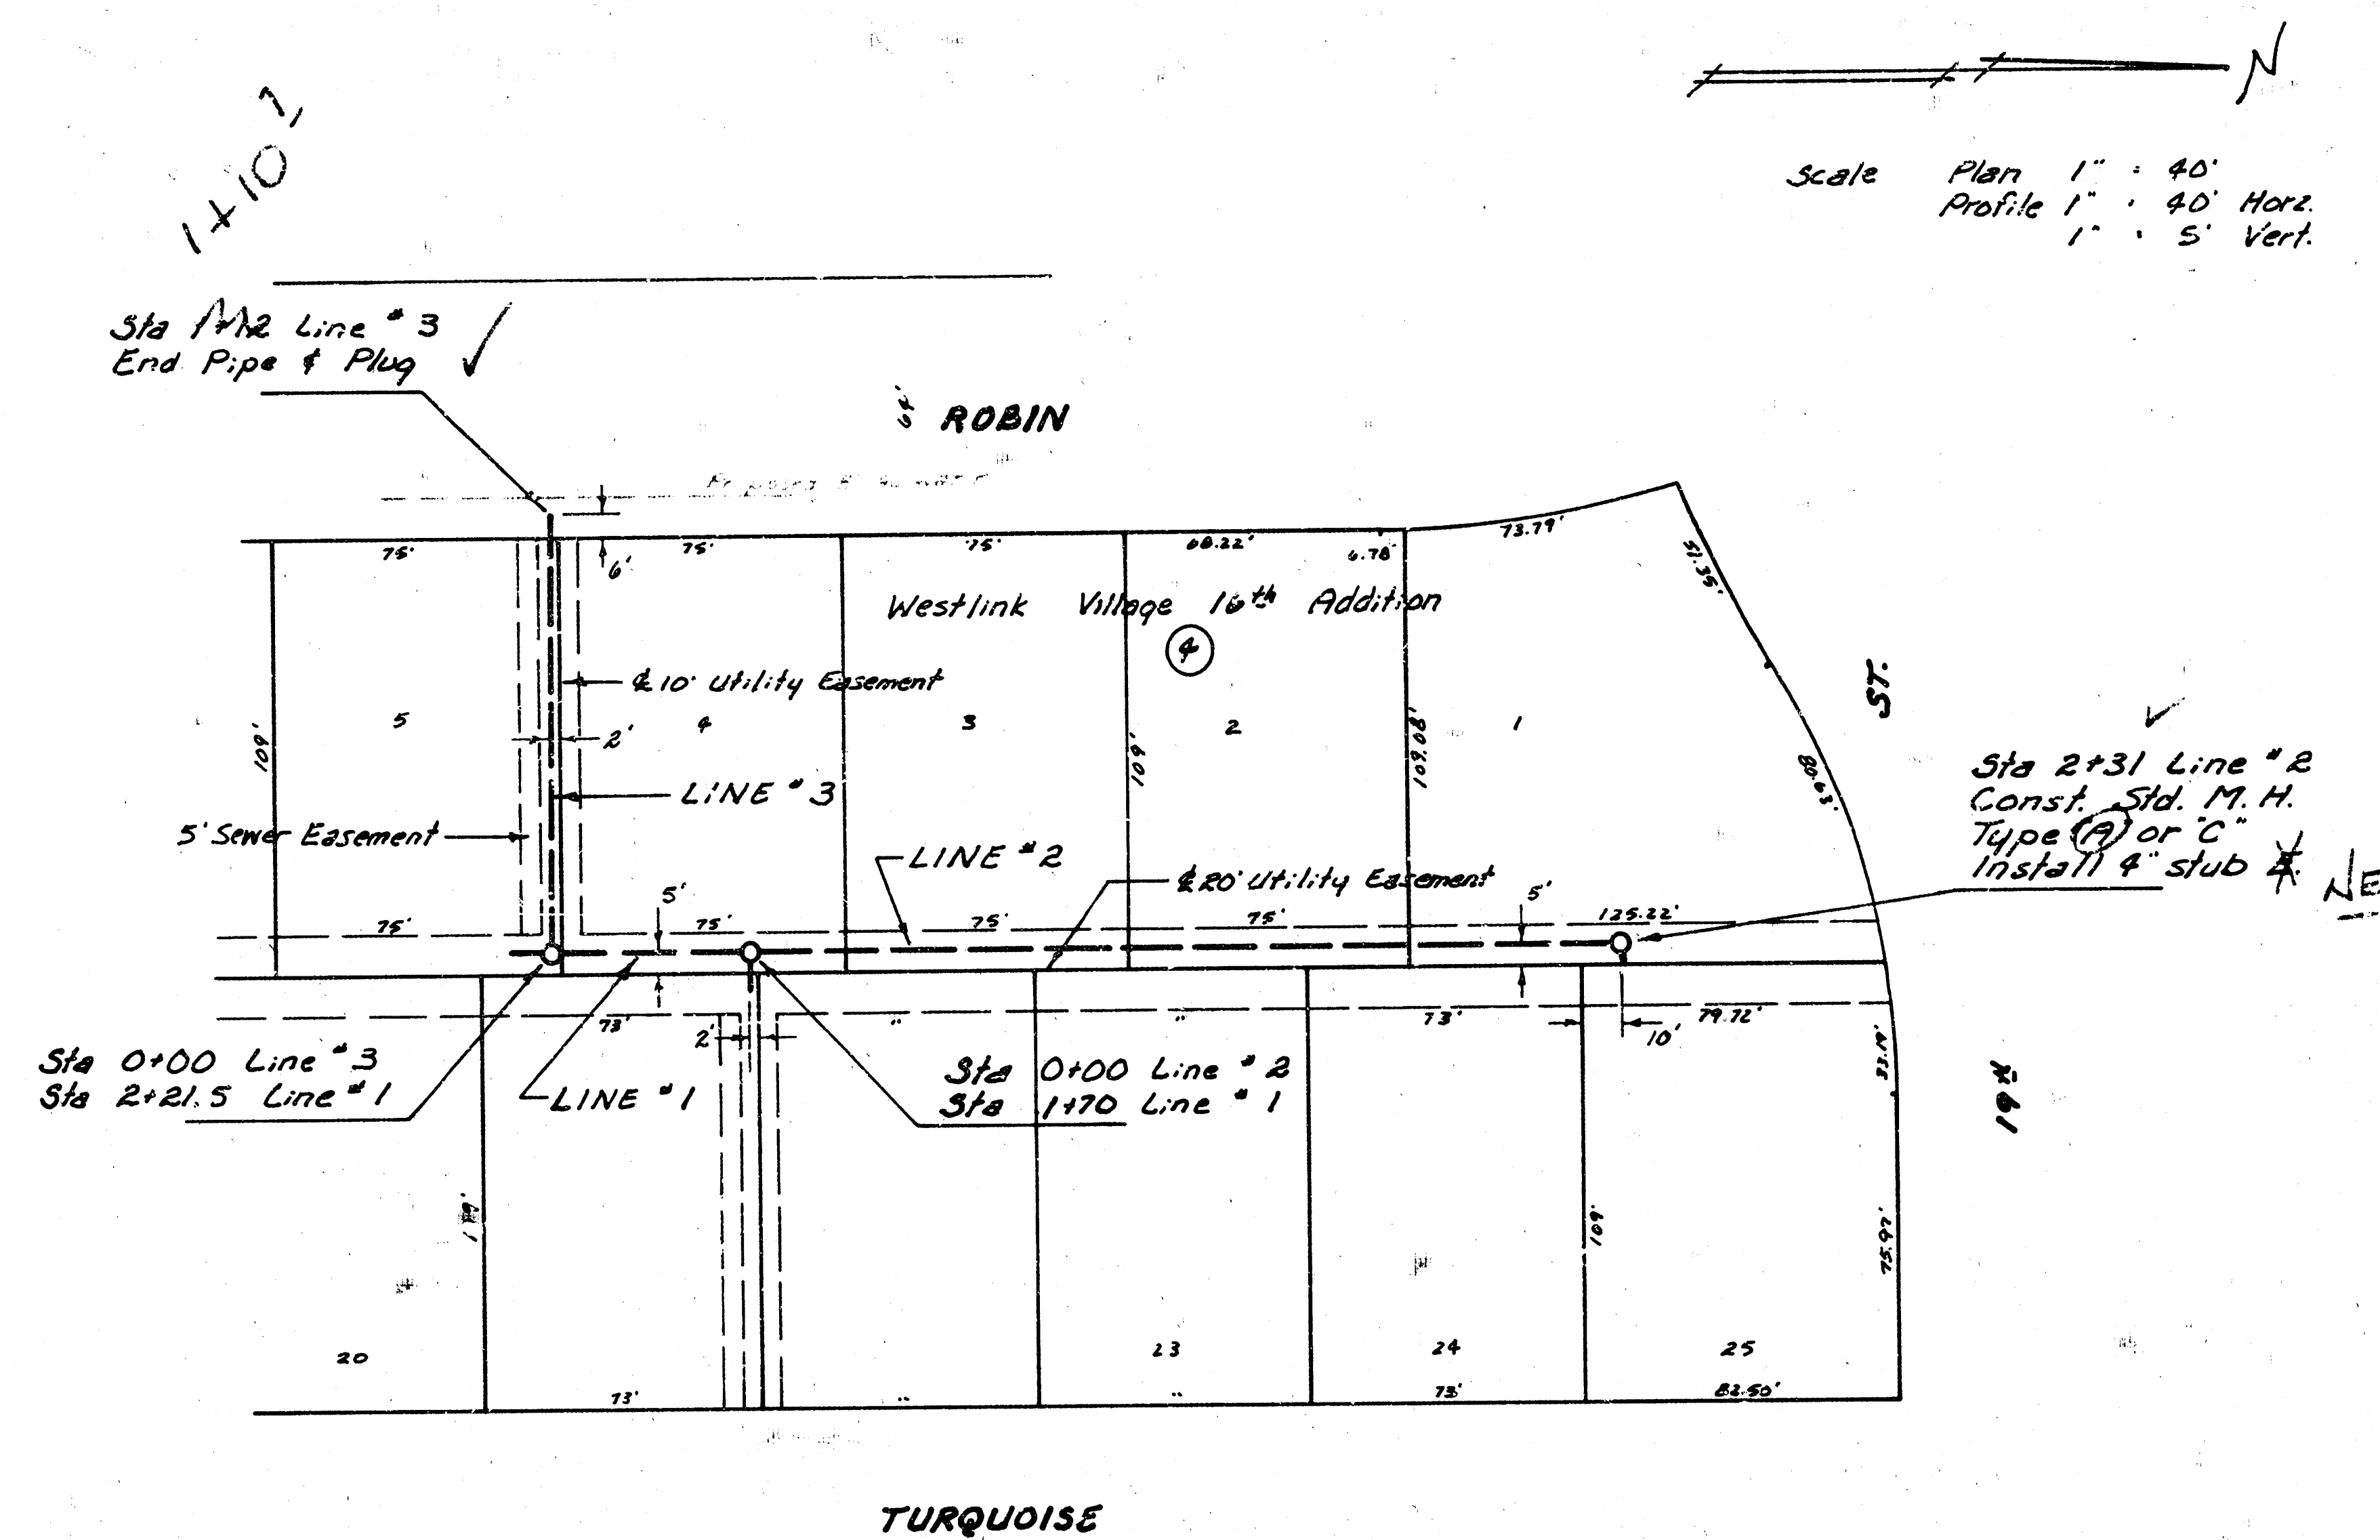


PLATE 1, PLAN & PROFILE
KOPPEL & SON CO.
45 1084 MADE IN U.S.A.

LAT 131 SW INTERCEPTOR
Sheet 2 of 2
Proj. No. 468-70-245-02603-000-001

14-8-5-10