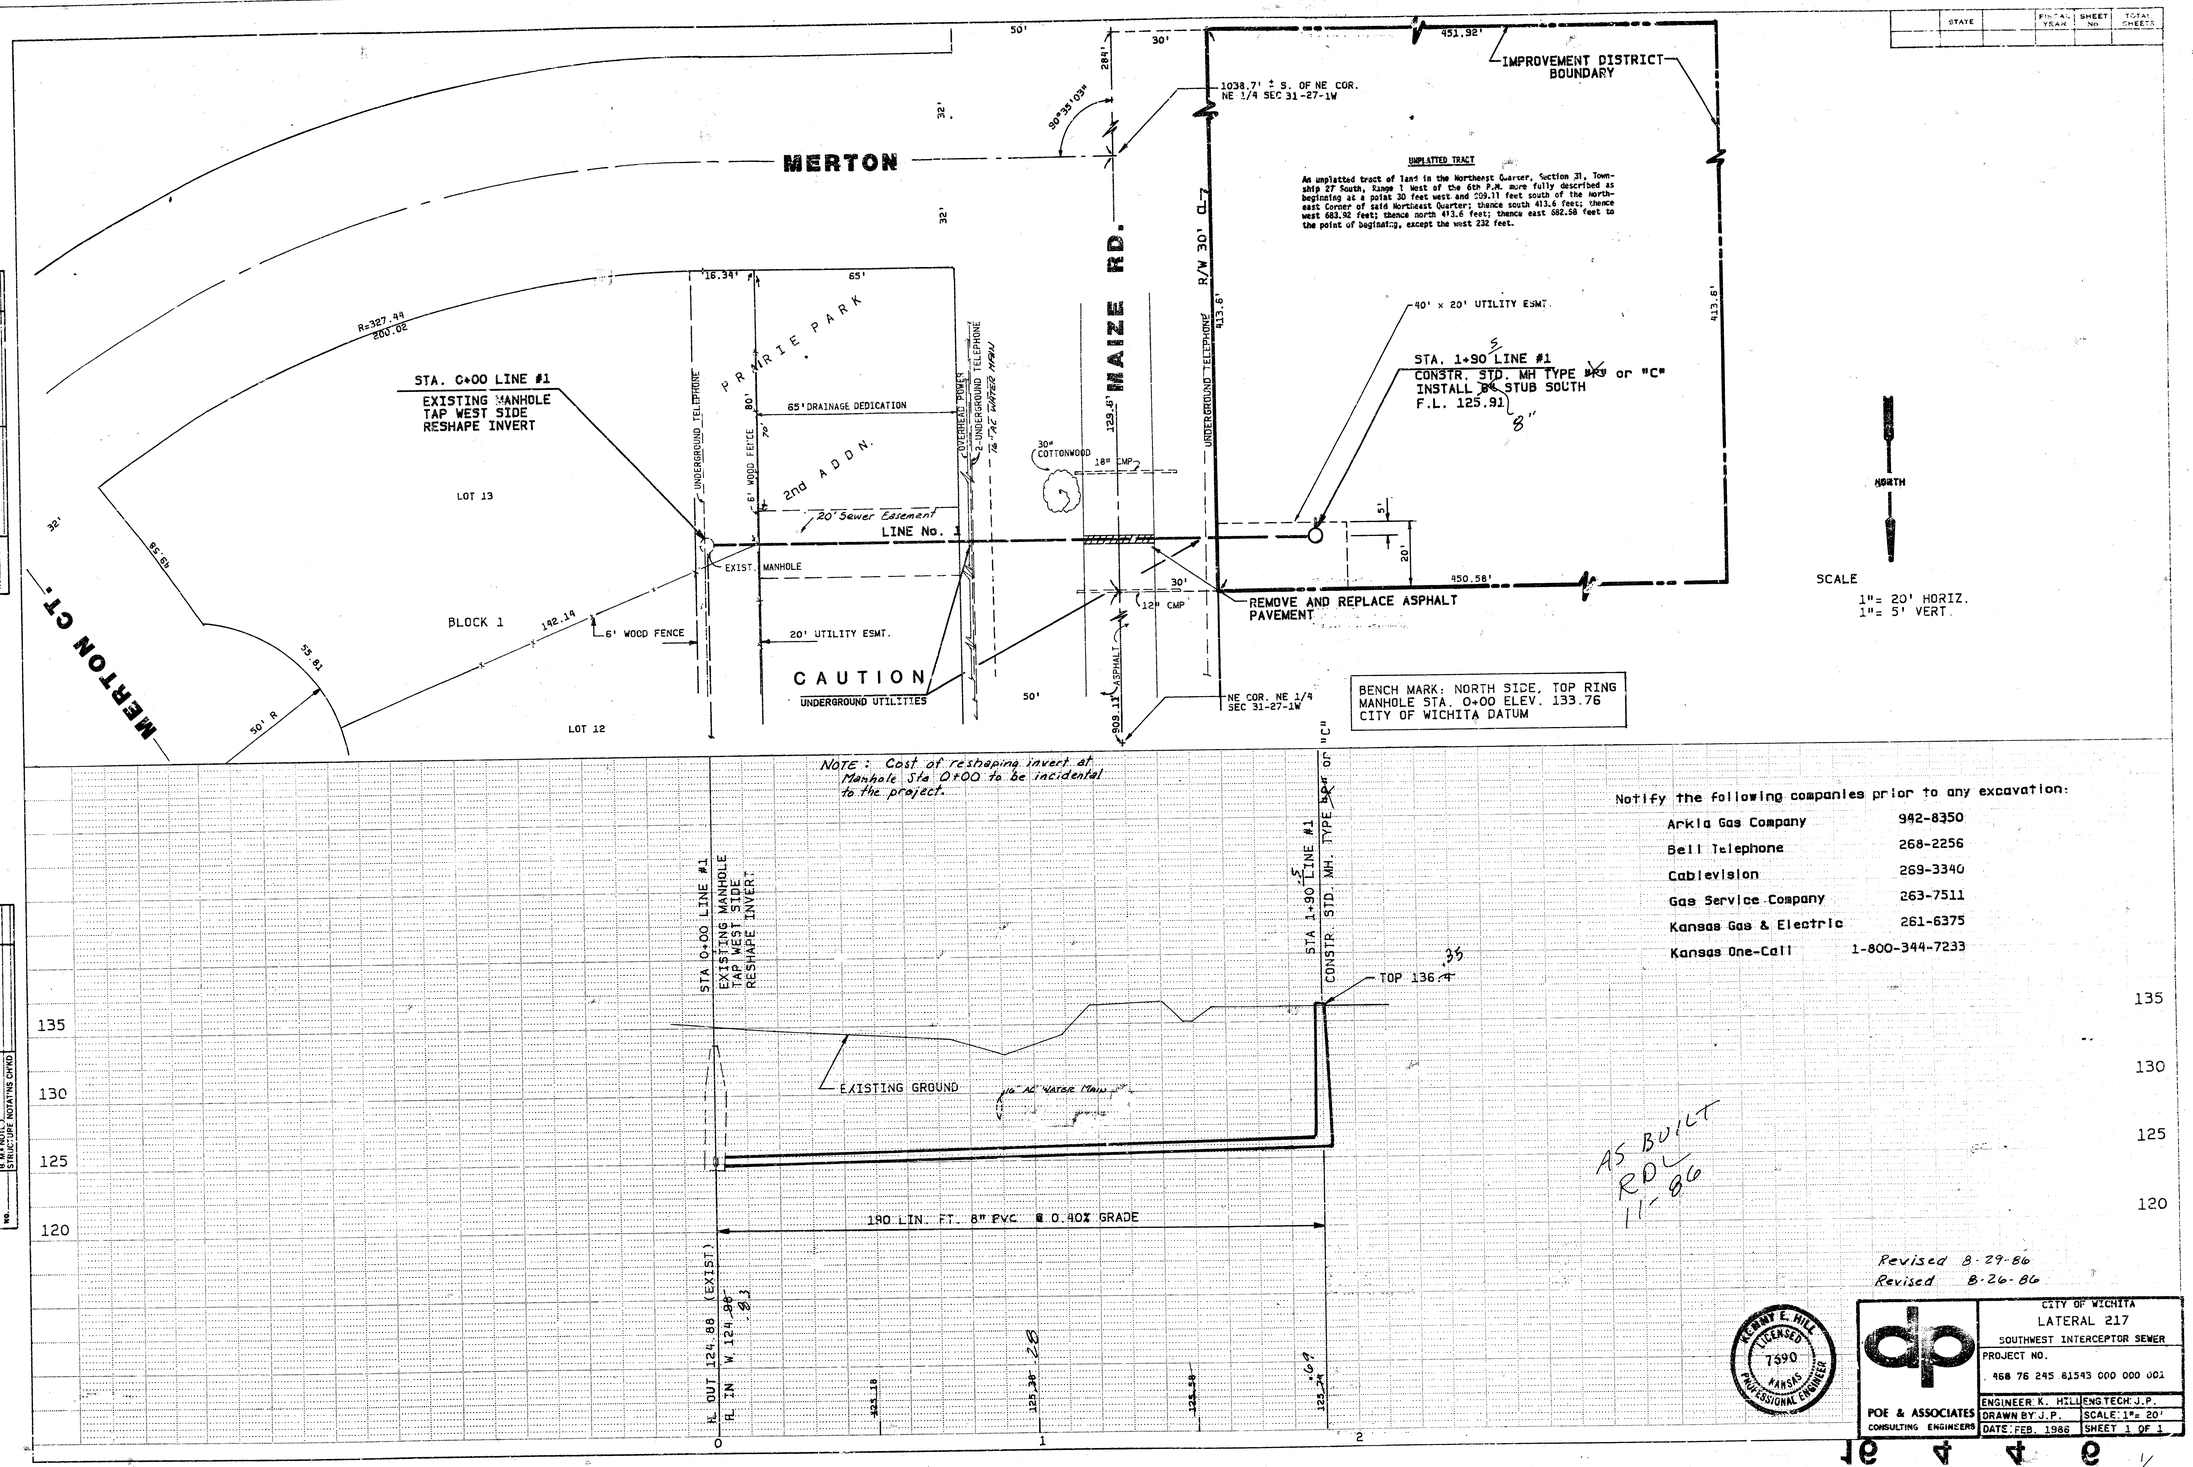

Notify the following companies prior to any excavation:

Arkla Gas Company	942-8350
Bell Telephone	268-2256
Cablevision	269-3340
Gas Service Company	263-7511
Kansas Gas & Electric	261-6375
Kansas One-Call	1-800-344-7233

AS BUILT
RDL
11-86

Revised 8-29-86
Revised 8-26-86

KENNY E. HILL
LICENSED
7590
KANSAS
PROFESSIONAL ENGINEER

POE & ASSOCIATES
CONSULTING ENGINEERS

CITY OF WICHITA
LATERAL 217
SOUTHWEST INTERCEPTOR SEWER
PROJECT NO.
468 76 245 81543 000 000 001

ENGINEER K. HILL	ENG TECH J.P.
DRAWN BY J.P.	SCALE 1"= 20'
DATE FEB. 1986	SHEET 1 OF 1

FILMED FROM THE BEST AVAILABLE COPY