
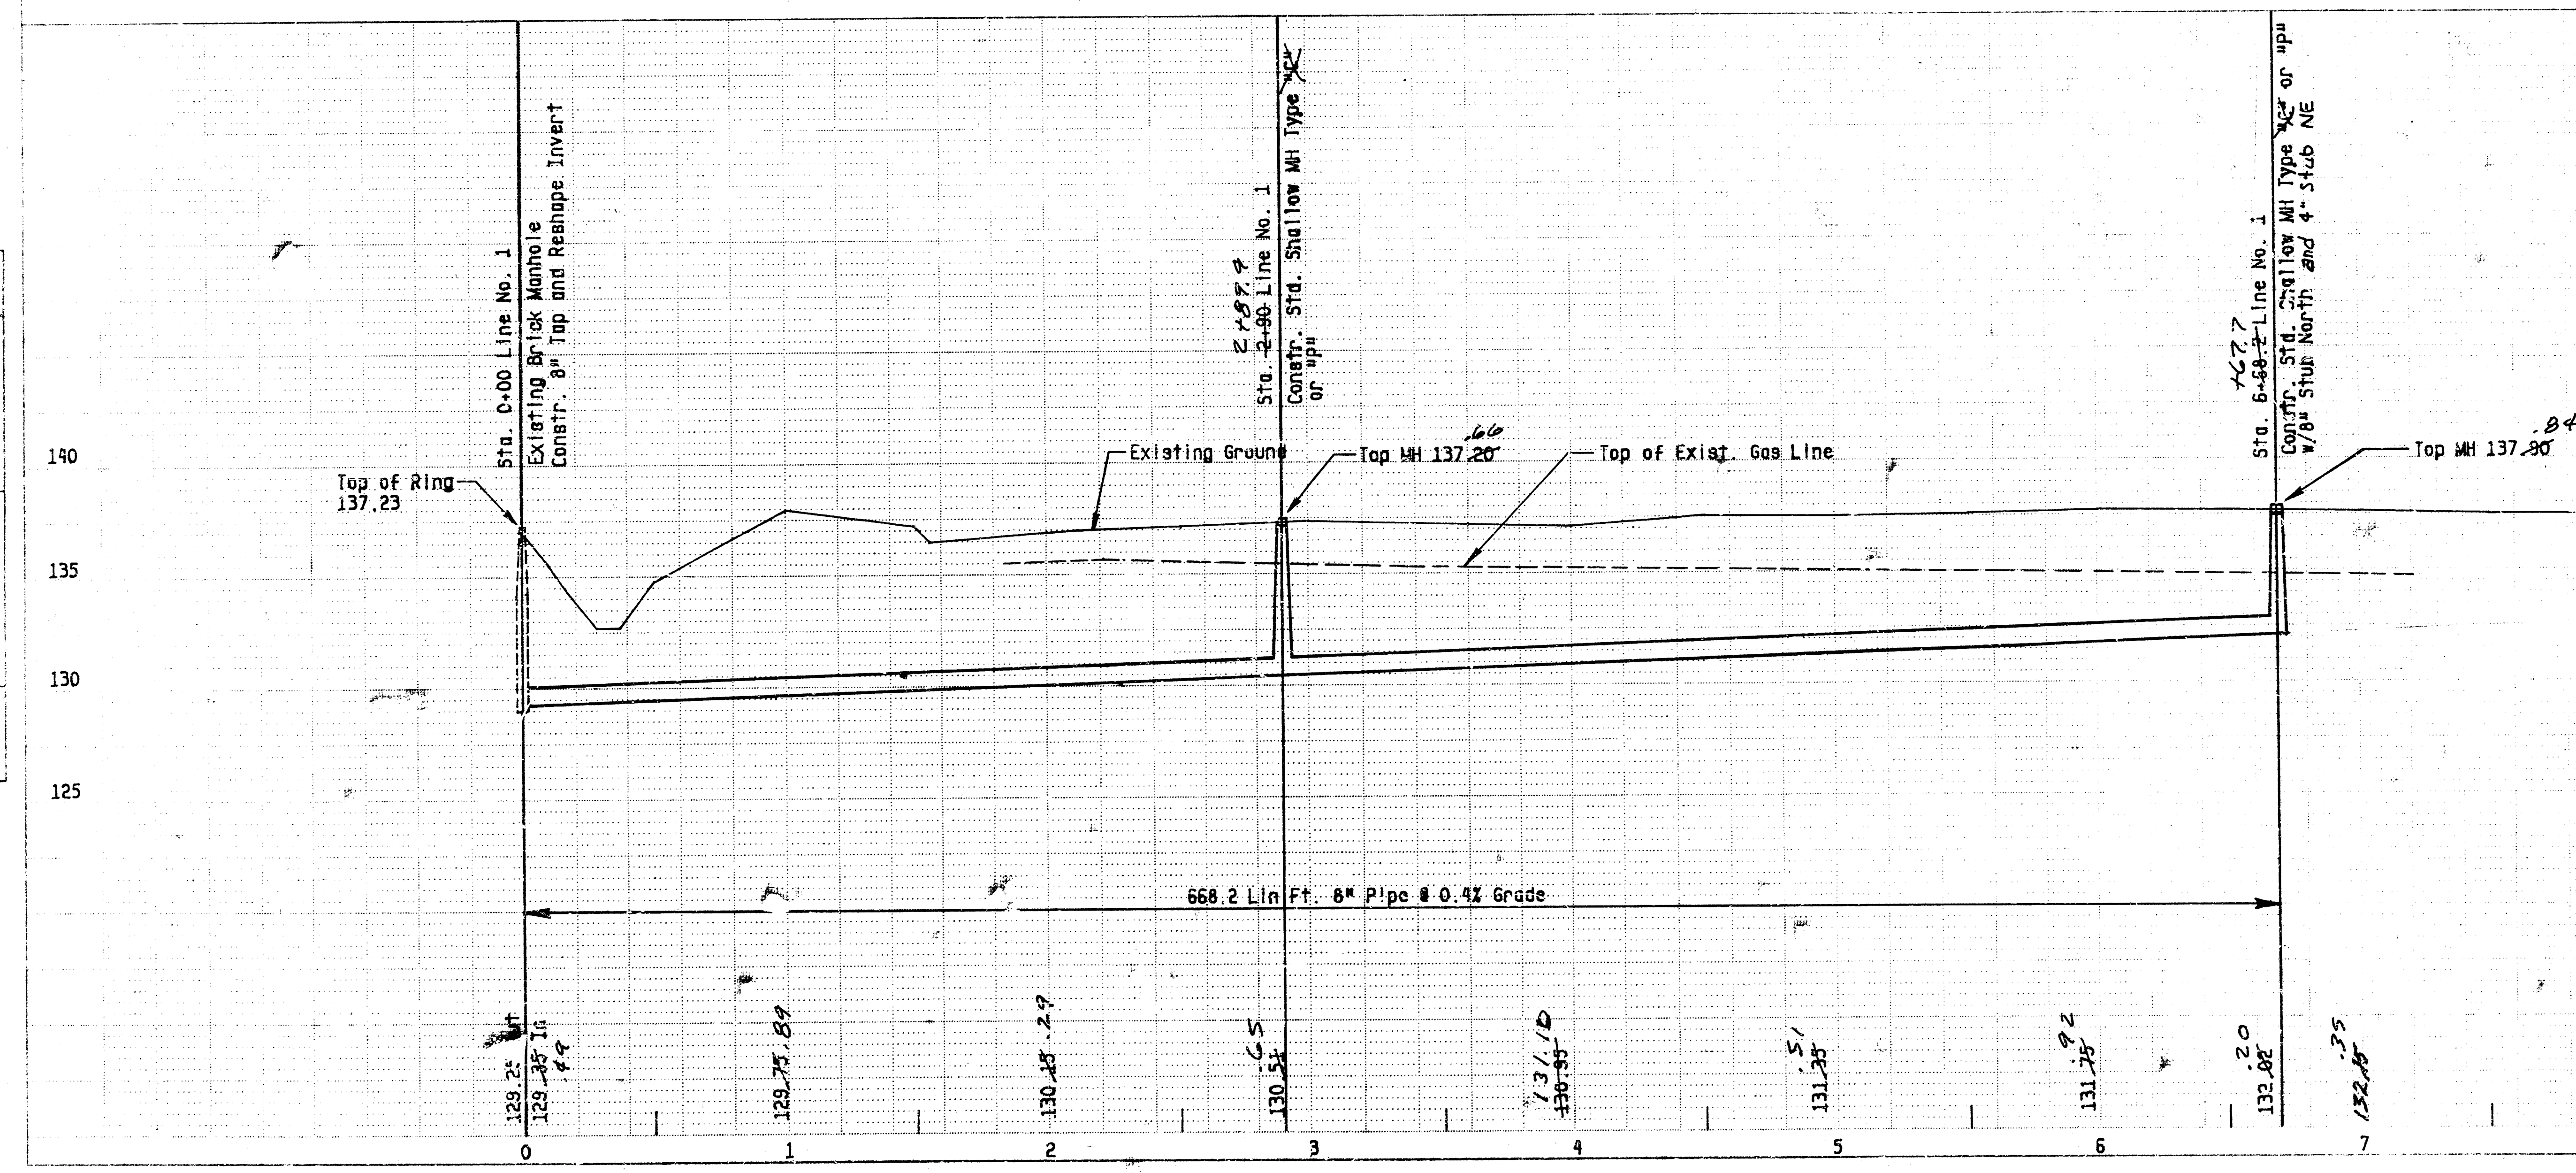


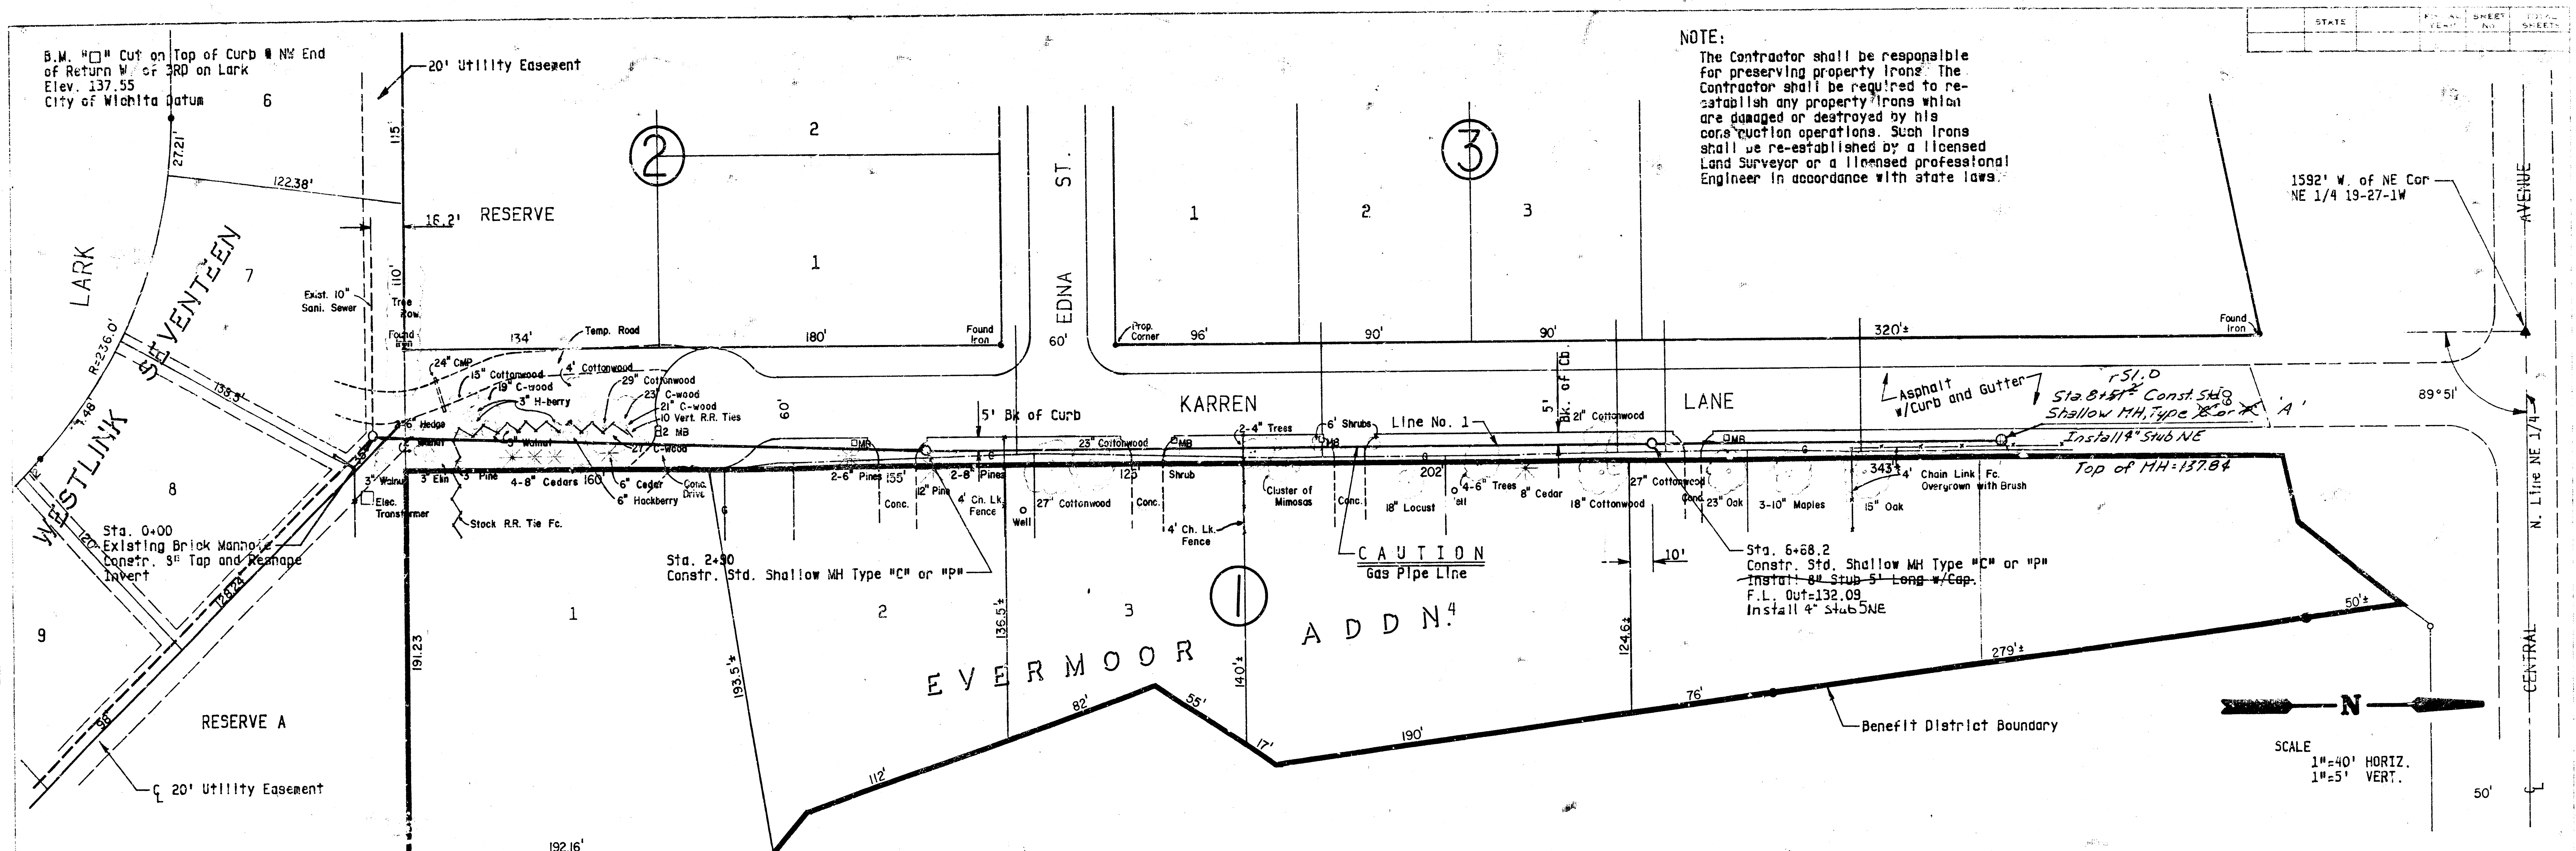


Notify the following companies prior to any excavation:

Arkio Gas Company	942-8350
Bell Telephone	268-2256
Cablevision	269-3340
Gas Service Company	263-7511
Kansas Gas & Electric	261-6375
Kansas One-Call	1-800-344-7233

GENERAL NOTES:

1. Remove and replace asphalt and concrete pavement as necessary.
2. Remove and replace curb and gutter as necessary.
3. Remove and replace mail boxes.
4. Remove trees only if necessary and after approval by Engineer.
5. Properties within the project limits which have fencing in public right-of-way which conflict with new construction have been notified to remove such improvements. Contractor will be required to remove such improvements should they not be removed by their owner at the time of construction of the project. The Contractor will be required to salvage all fencing and give such material to their owner. All work in connection with fence removal shall be considered as subsidiary to the contract pay items of work.

Revised 11/14/86

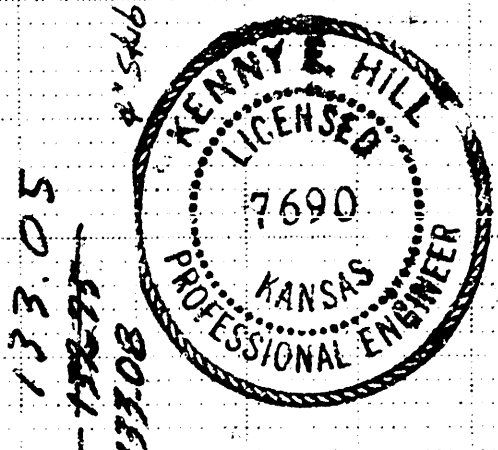

CITY OF WICHITA LATERAL 223 SOUTHWEST INTERCEPTOR SEWER	
PROJECT NO.	
468-76-245-81585-000-000-001	
ENGINEER K. HILL	ENGINEER B.F.
DRAWN BY P.V.	SCALE AS NOTED
DATE Sept. 1986	SHEET 1 OF 1

FILED FROM THE BEST AVAILABLE COPY