LATERAL 262 S.W.I.

SANITARY SEWER IMPROVEMENTS

LOT 1, EXCEPT THE NORTH 150 FEET THEREOF,
BLK. 5, FARMINGTON SQUARE 2ND ADDITION

CITY OF WICHITA, KANSAS

PROJECT NO.
468-76-248-81778-000-000-001

INDEX CODE 606657

GENERAL NOTES

1. Rubble from the removal of miscellaneous structures and excess excavation which is to be wasted shall be disposed of on sites to be provided by the Contractor. These sites shall be approved by the Engineer as to suitability, appearance and site location. Locations that, in the opinion of the Engineer, will leave an unsightly appearance will not be approved.
2. The Contractor shall be responsible for maintaining continuous flow of sewage through construction. Contractor's proposed method for maintaining sewage flow shall be approved by the Engineer. Cost of maintaining flow of sewage through construction will not be paid for directly and this cost shall be considered as subsidiary to the other pay items of work.
3. The Contractor shall be responsible for preserving property irons. The Contractor will be required to re-establish any property irons which are damaged or destroyed by his construction operations. Such irons shall be re-established by a licensed land surveyor or a licensed professional engineer in accordance with state law.

INDEX OF SHEETS

Title Sheet 1
San. Sewer Plan & Profile 2

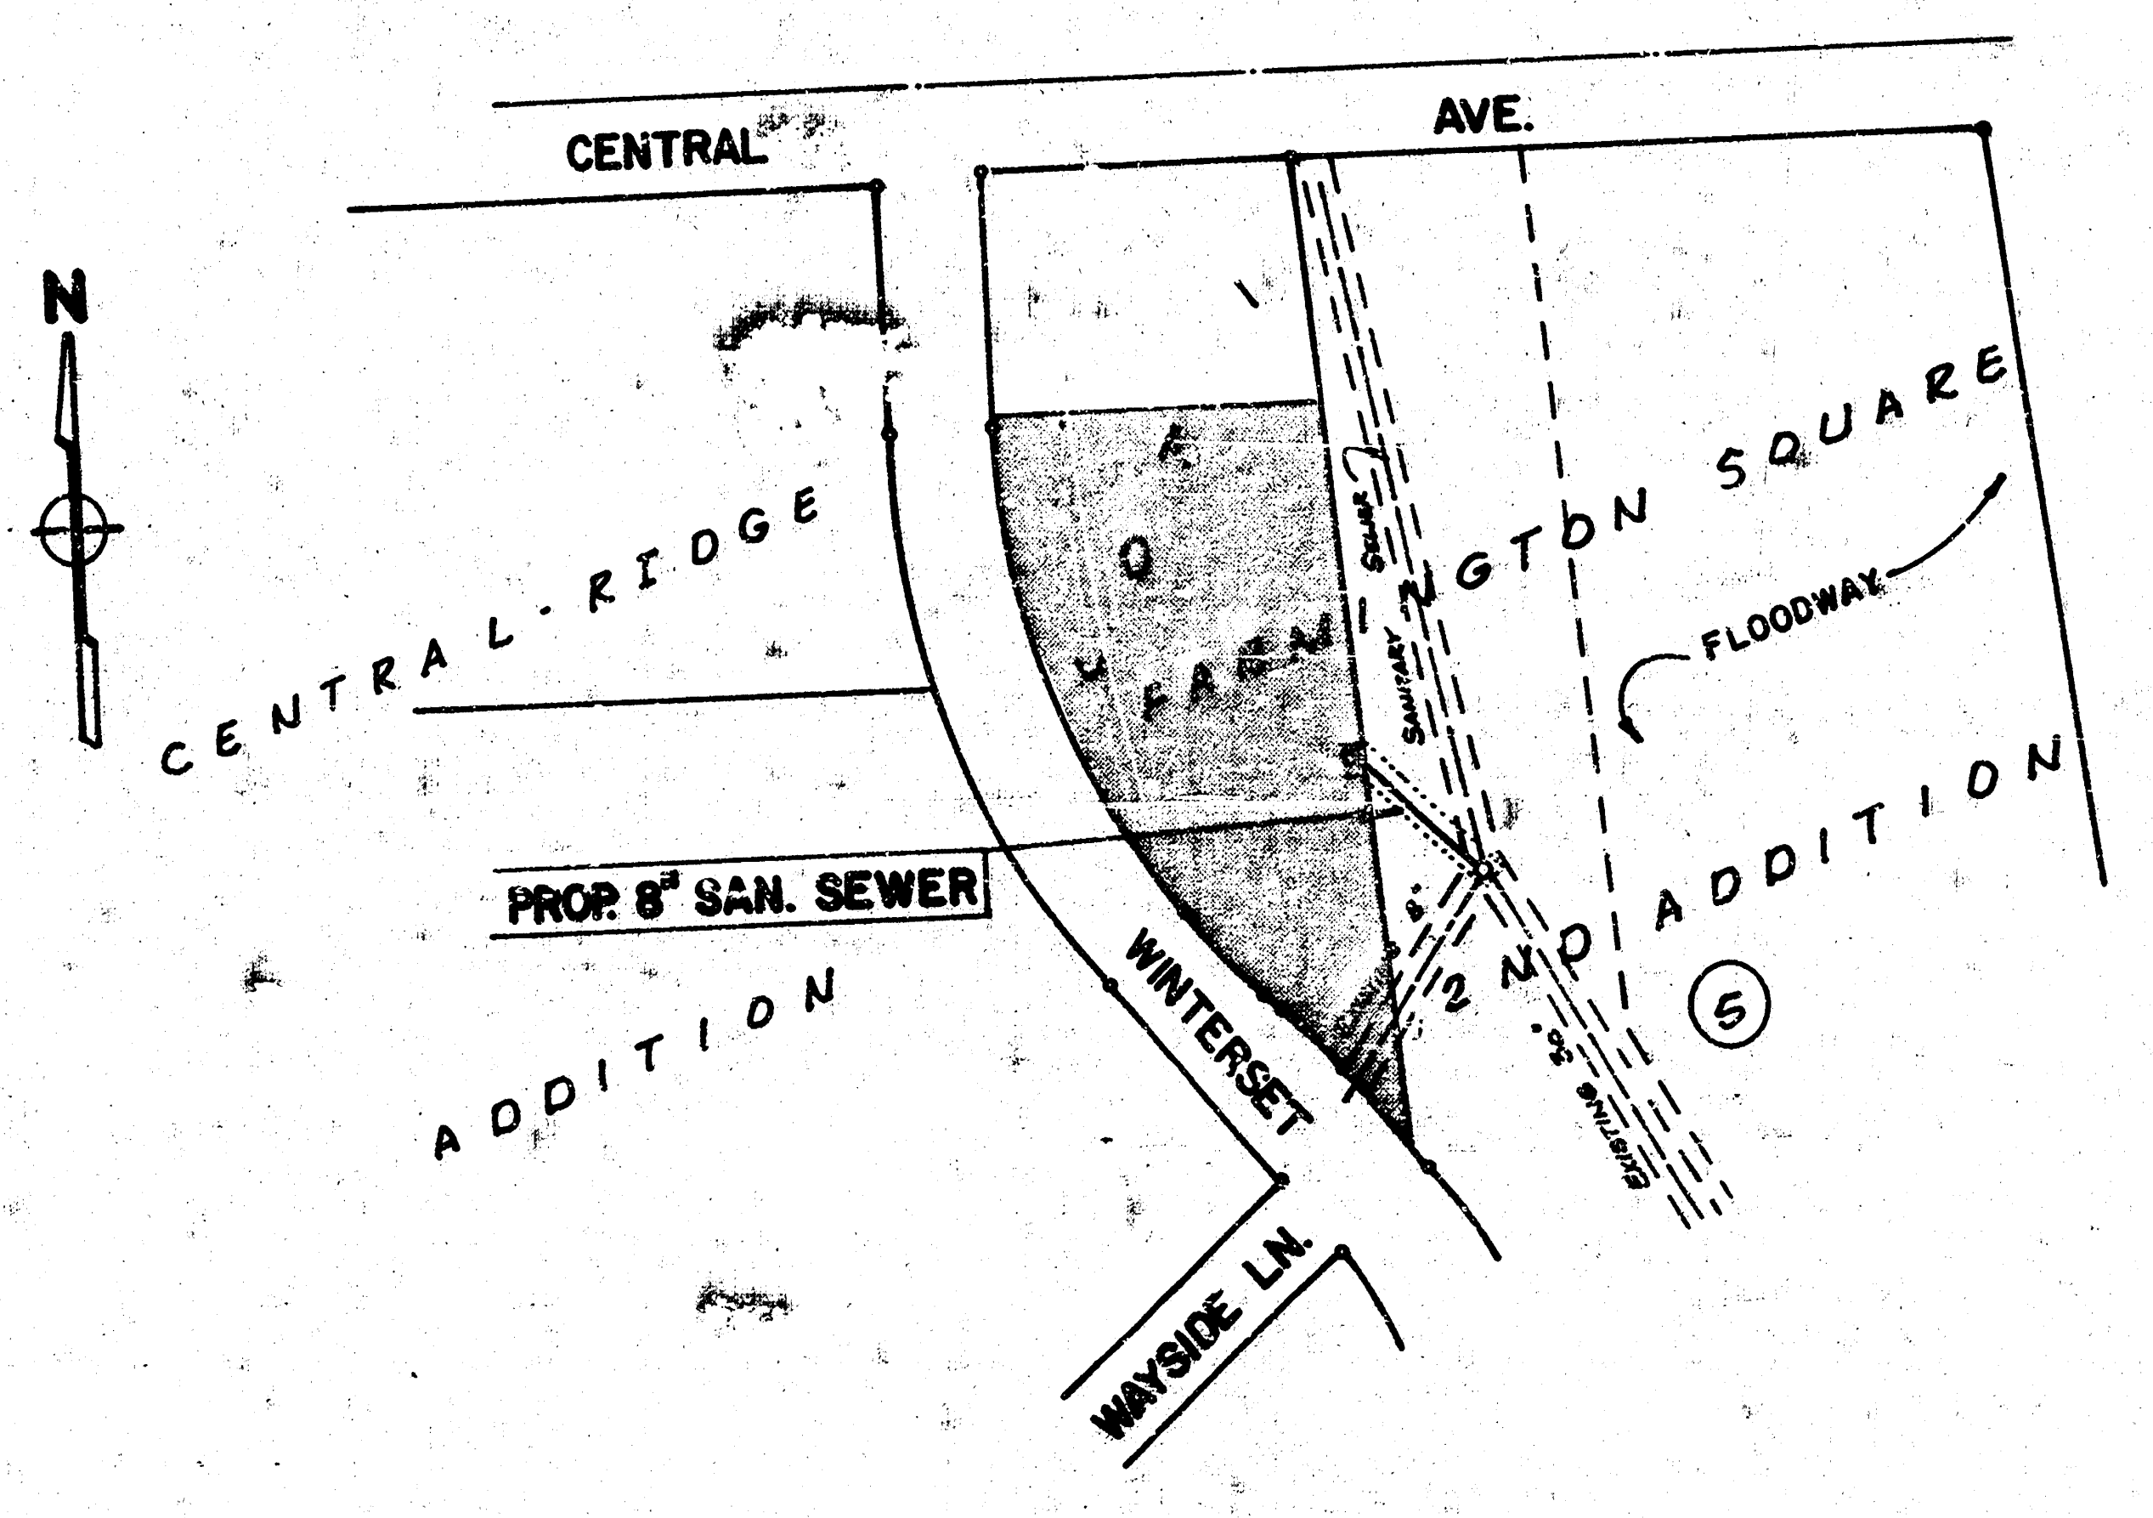

BENEFIT DISTRICT ▨

BENCH MARKS

Bench Mark: "□" Cut @ N.E. Corner of North Conc. Inlet Approx. 30' South-easterly of S.E. Corner Lot 1, Blk. 5, Farmington Square 2nd Add.
Elev. = 126.82 City Datum

Built Per Plan
RDL
12-89

N. BRENT WOOTEN
8470

BAUGHMAN COMPANY P. A. SURVEYING & ENGINEERING 316/262-7271 • 315 ELLIS • WICHITA, KANSAS 67211					REV.
DESIGN	DRAWN	APPROVED	DATE	SCALE	SHEET 1 OF 2
N.B. Wooten	R.J. Plush		Dec. 1, 1987	1" = 160'	

FILMED FROM THE BEST AVAILABLE COPY

7

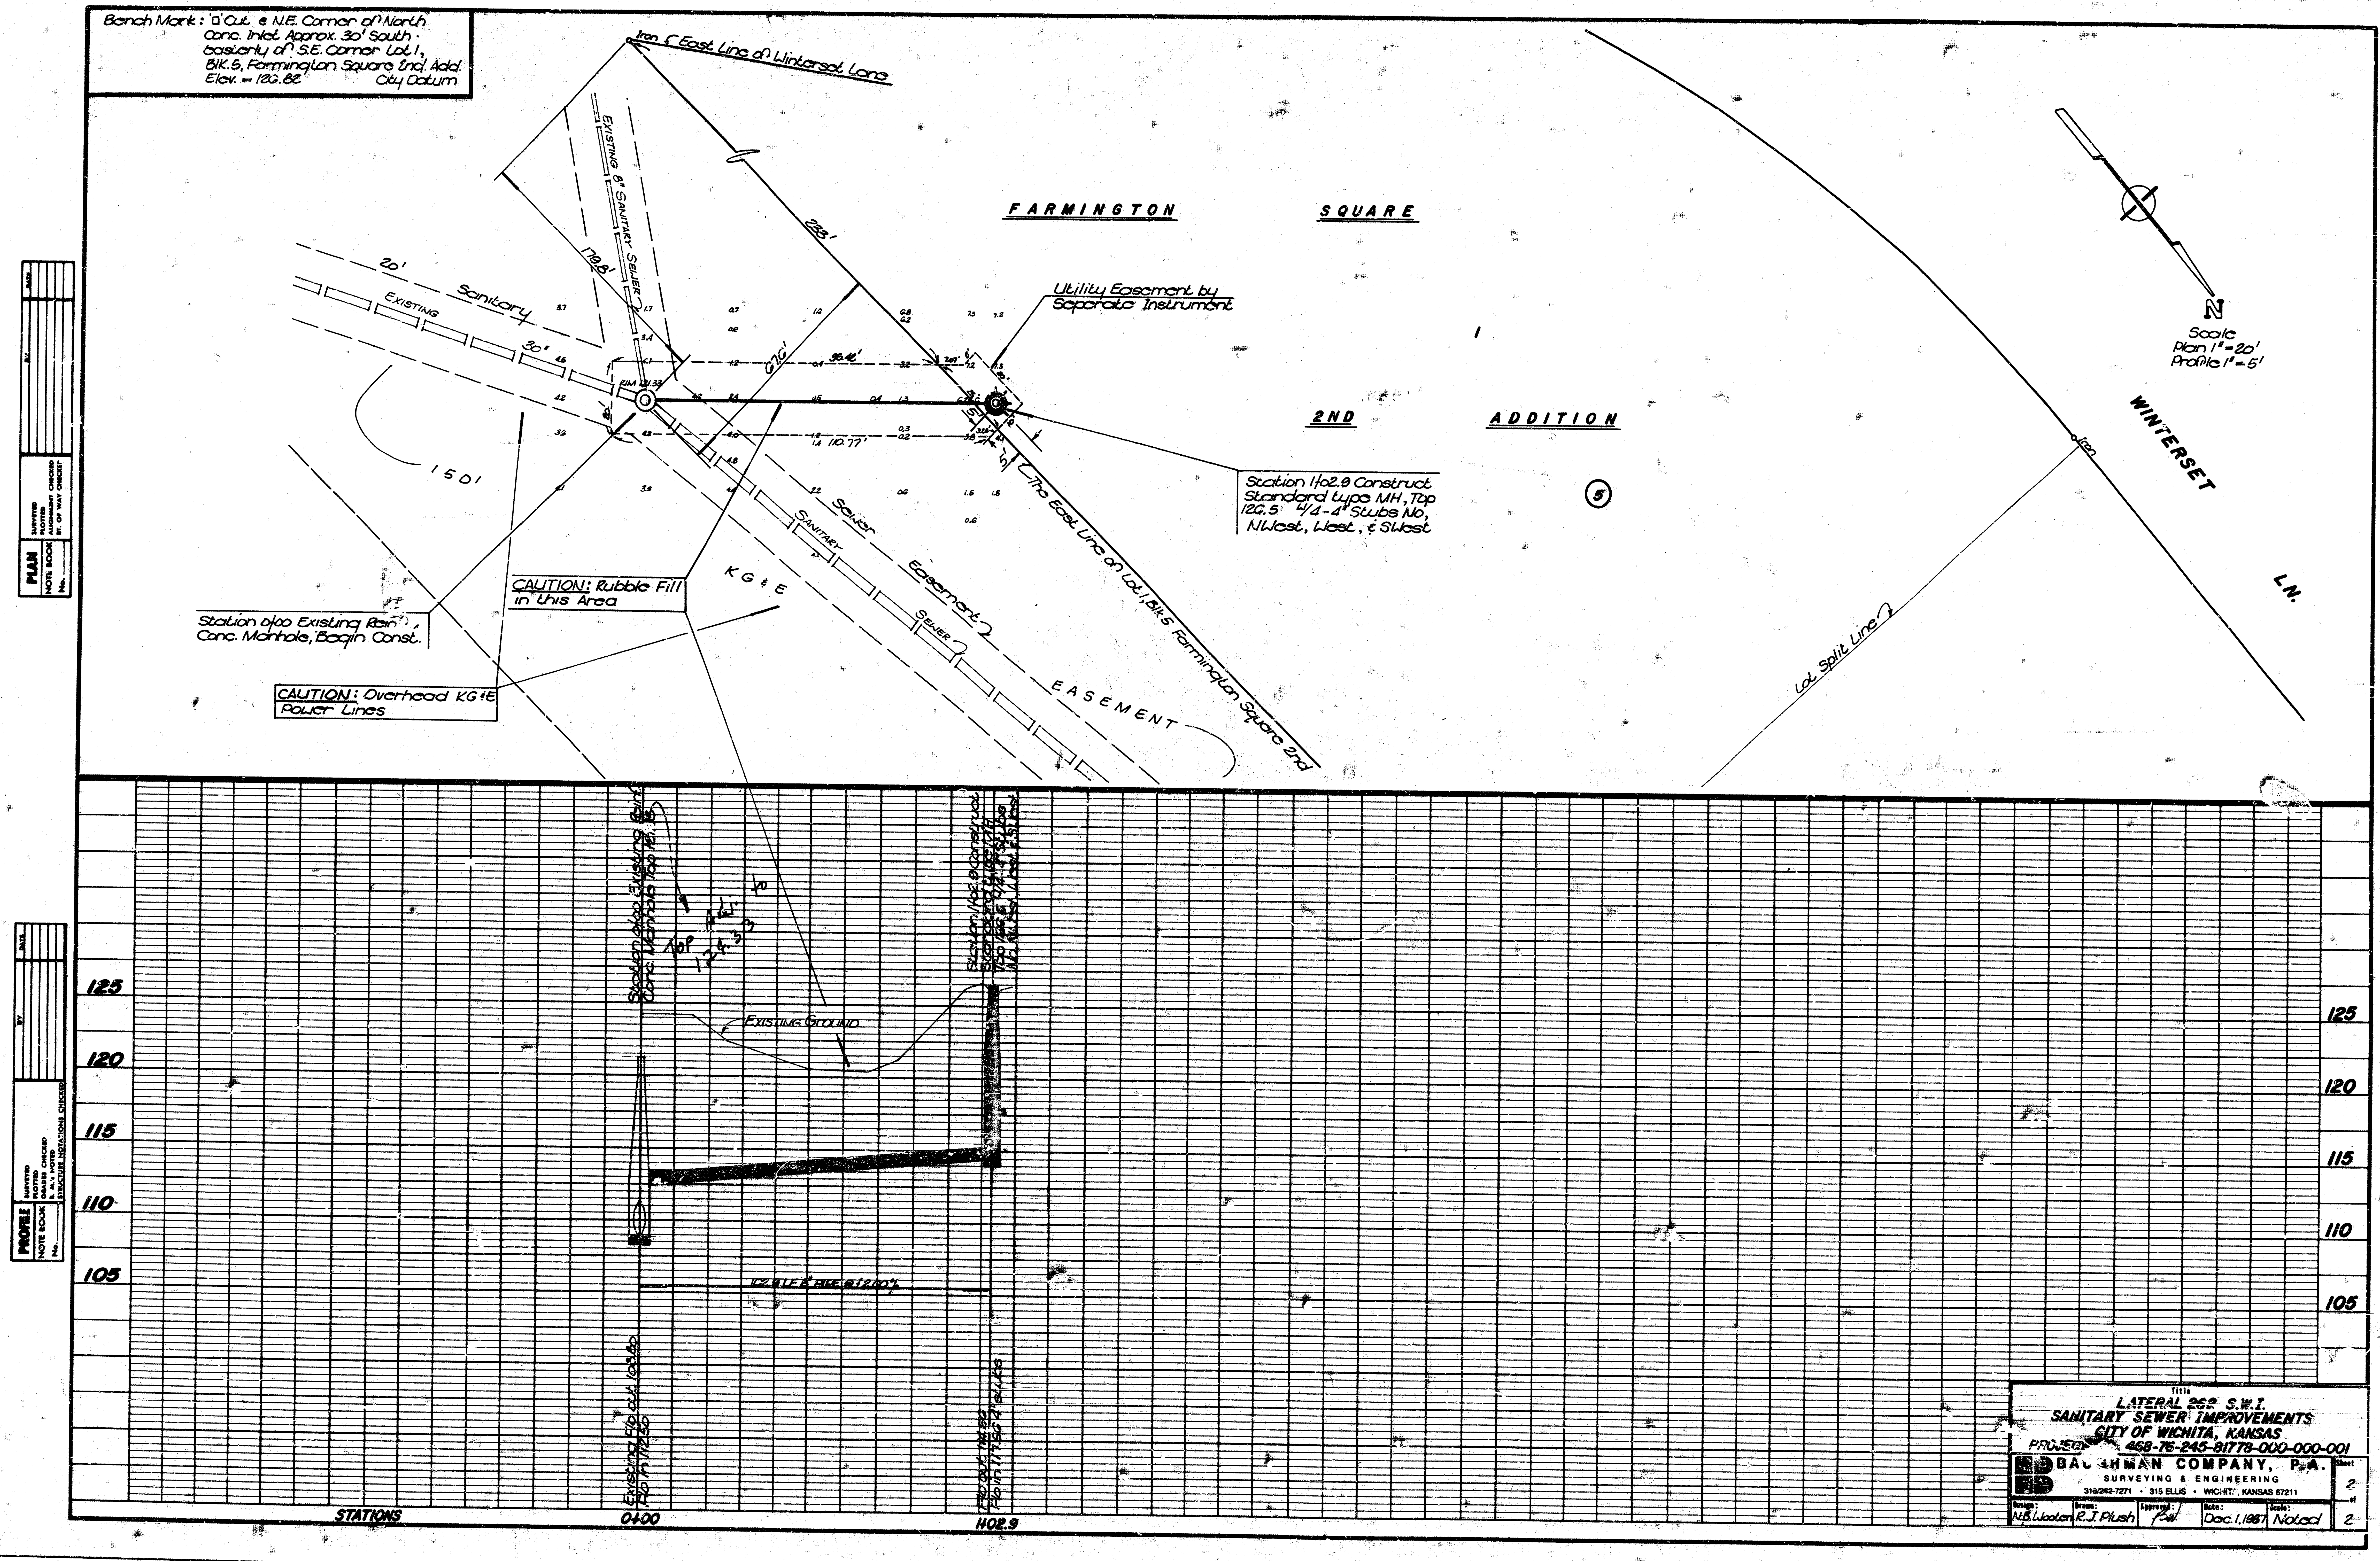
Iron € East Line of Wintersat Lane
FARMINGTON SQUARE
2ND ADDITION
⑤
WINTERSET LN.
Existing 8" Sanitary Sewer
20' Sanitary
Existing
30'
178.8'
233.1'
102.9'
95.46'
110.77'
RIM 121.33
Utility Easement by Separate Instrument
Station 1+02.9 Construct Standard Type MH, Top 126.5 4/4-4" Stubs No, NWest, West, & SWest
150'
Sewer Easement?
Sanitary Sewer
EASEMENT
KG & E
CAUTION: Rubble Fill in this Area
Station 0+00 Existing Rein. Conc. Manhole, Begin Const.
CAUTION: Overhead KG&E Power Lines
The East Line of Lot 1, Blk 5 Farmington Square 2nd
Lot Split Line?
Iron
N
Scale Plan 1"=20' Profile 1"=5'
PLAN
NOTE BOOK
No.
PROFILE
125
120
115
110
105
Station 0+00 Existing Rein. Conc. Manhole Top 121.33
Top 124.33
Existing Ground
Station 1+02.9 Construct Standard Type MH Top 126.5 4/4-4" Stubs NO, NWest, West & SWest
102.9 LF 8" Pipe @ 1.200%
Existing Flo out 108.80
Flo in 112.30
Flo out 116.56
Flo in 117.56 4" Stubs
STATIONS
0+00
1+02.9

Bench Mark: '□' Cut @ N.E. Corner of North
Conc. Inlet Approx. 30' South-
easterly of S.E. Corner Lot 1,
Blk. 5, Farmington Square 2nd. Add.
Elev. = 126.82 City Datum

Title
LATERAL 262 S.W.I.
SANITARY SEWER IMPROVEMENTS
CITY OF WICHITA, KANSAS
PROJECT 468-76-245-81778-000-000-001

BAUGHMAN COMPANY, P.A.
SURVEYING & ENGINEERING
316/262-7271 • 315 ELLIS • WICHITA, KANSAS 67211

Design:	Drawn:	Approved:	Date:	Scale:	Sheet
N.B. Wooten	R.J. Plush	B.W.	Dec. 1, 1987	Noted	2 of 2

FILMED FROM THE BEST
AVAILABLE COPY