B. M. 8041 "+" on SW cor. conc. base Derby Light tower NE cor. 51st. and Hydraulic.

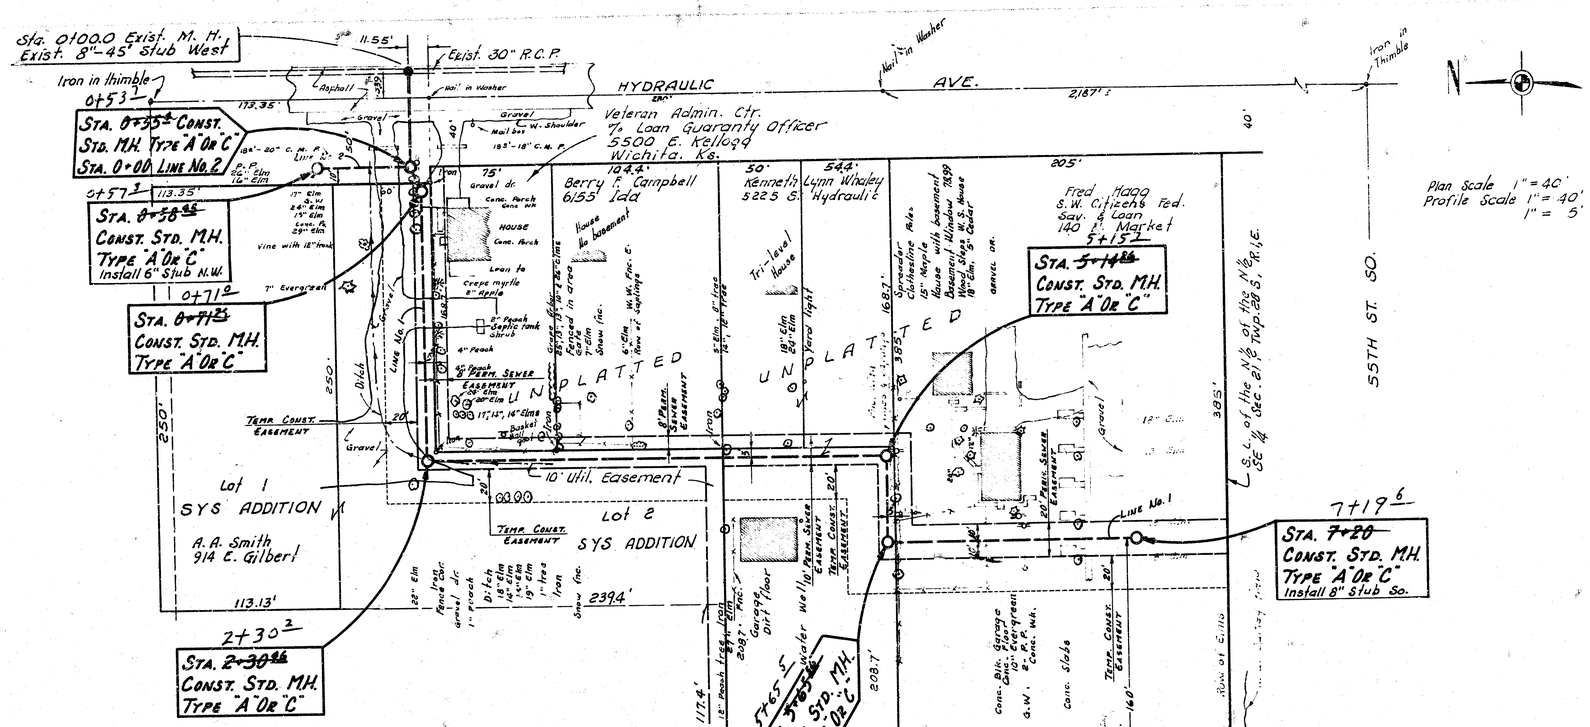

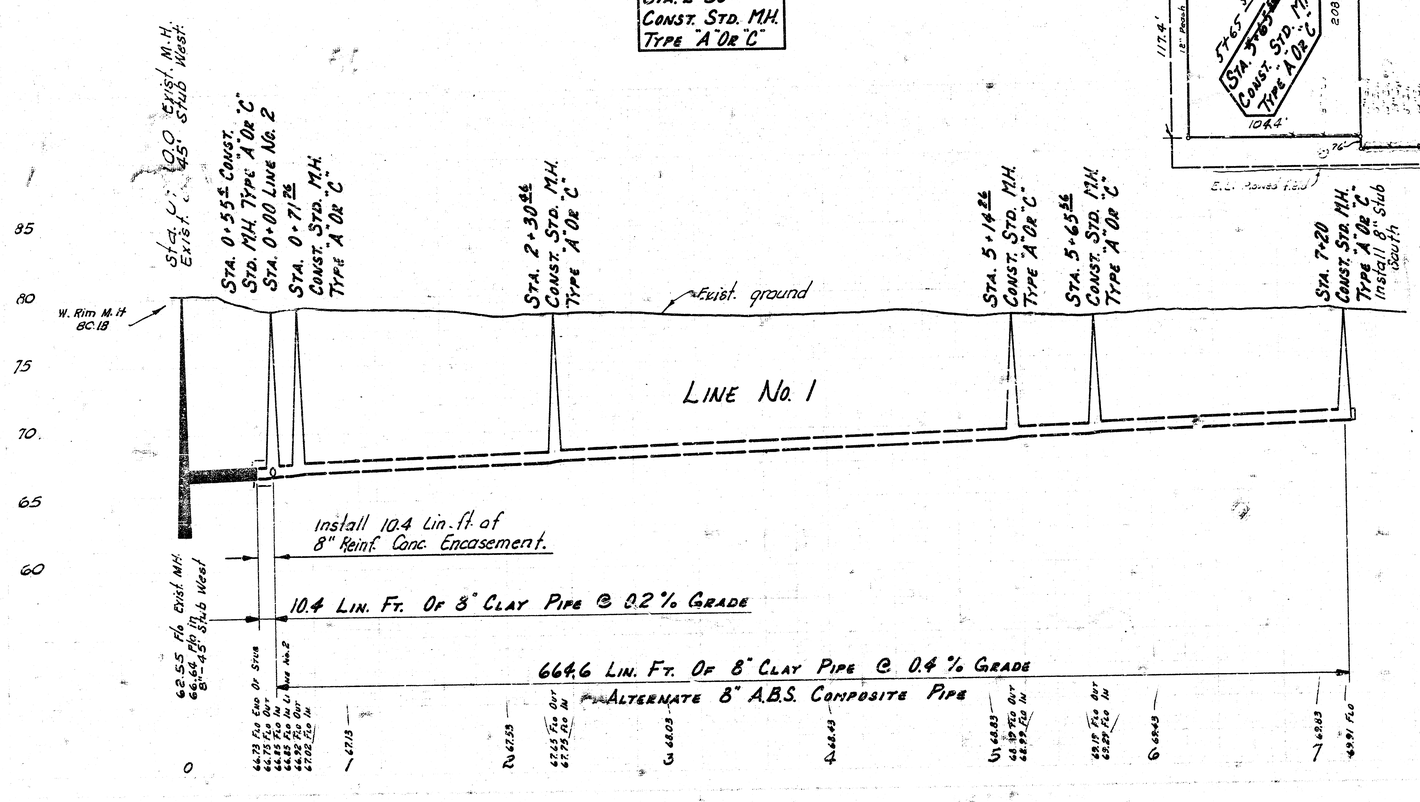

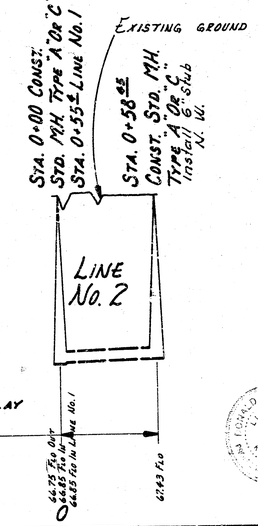

LAT. 33, MAIN I, S. W. INTERCEPTOR SEWER

CITY OF WICHITA, KANSAS

R. W. LINN — CITY ENGINEER

MARCH, 1976 PROJECT NO. DBKL572064