



B.M. 85.56 P.R. Spike in South face of Power Pole on the Northeast corner of 44th Street, South and Washington.

Plan Scale: 1" = 40'
 Profile Scale: 1" = 40' Horiz., 1" = 5' Vert.

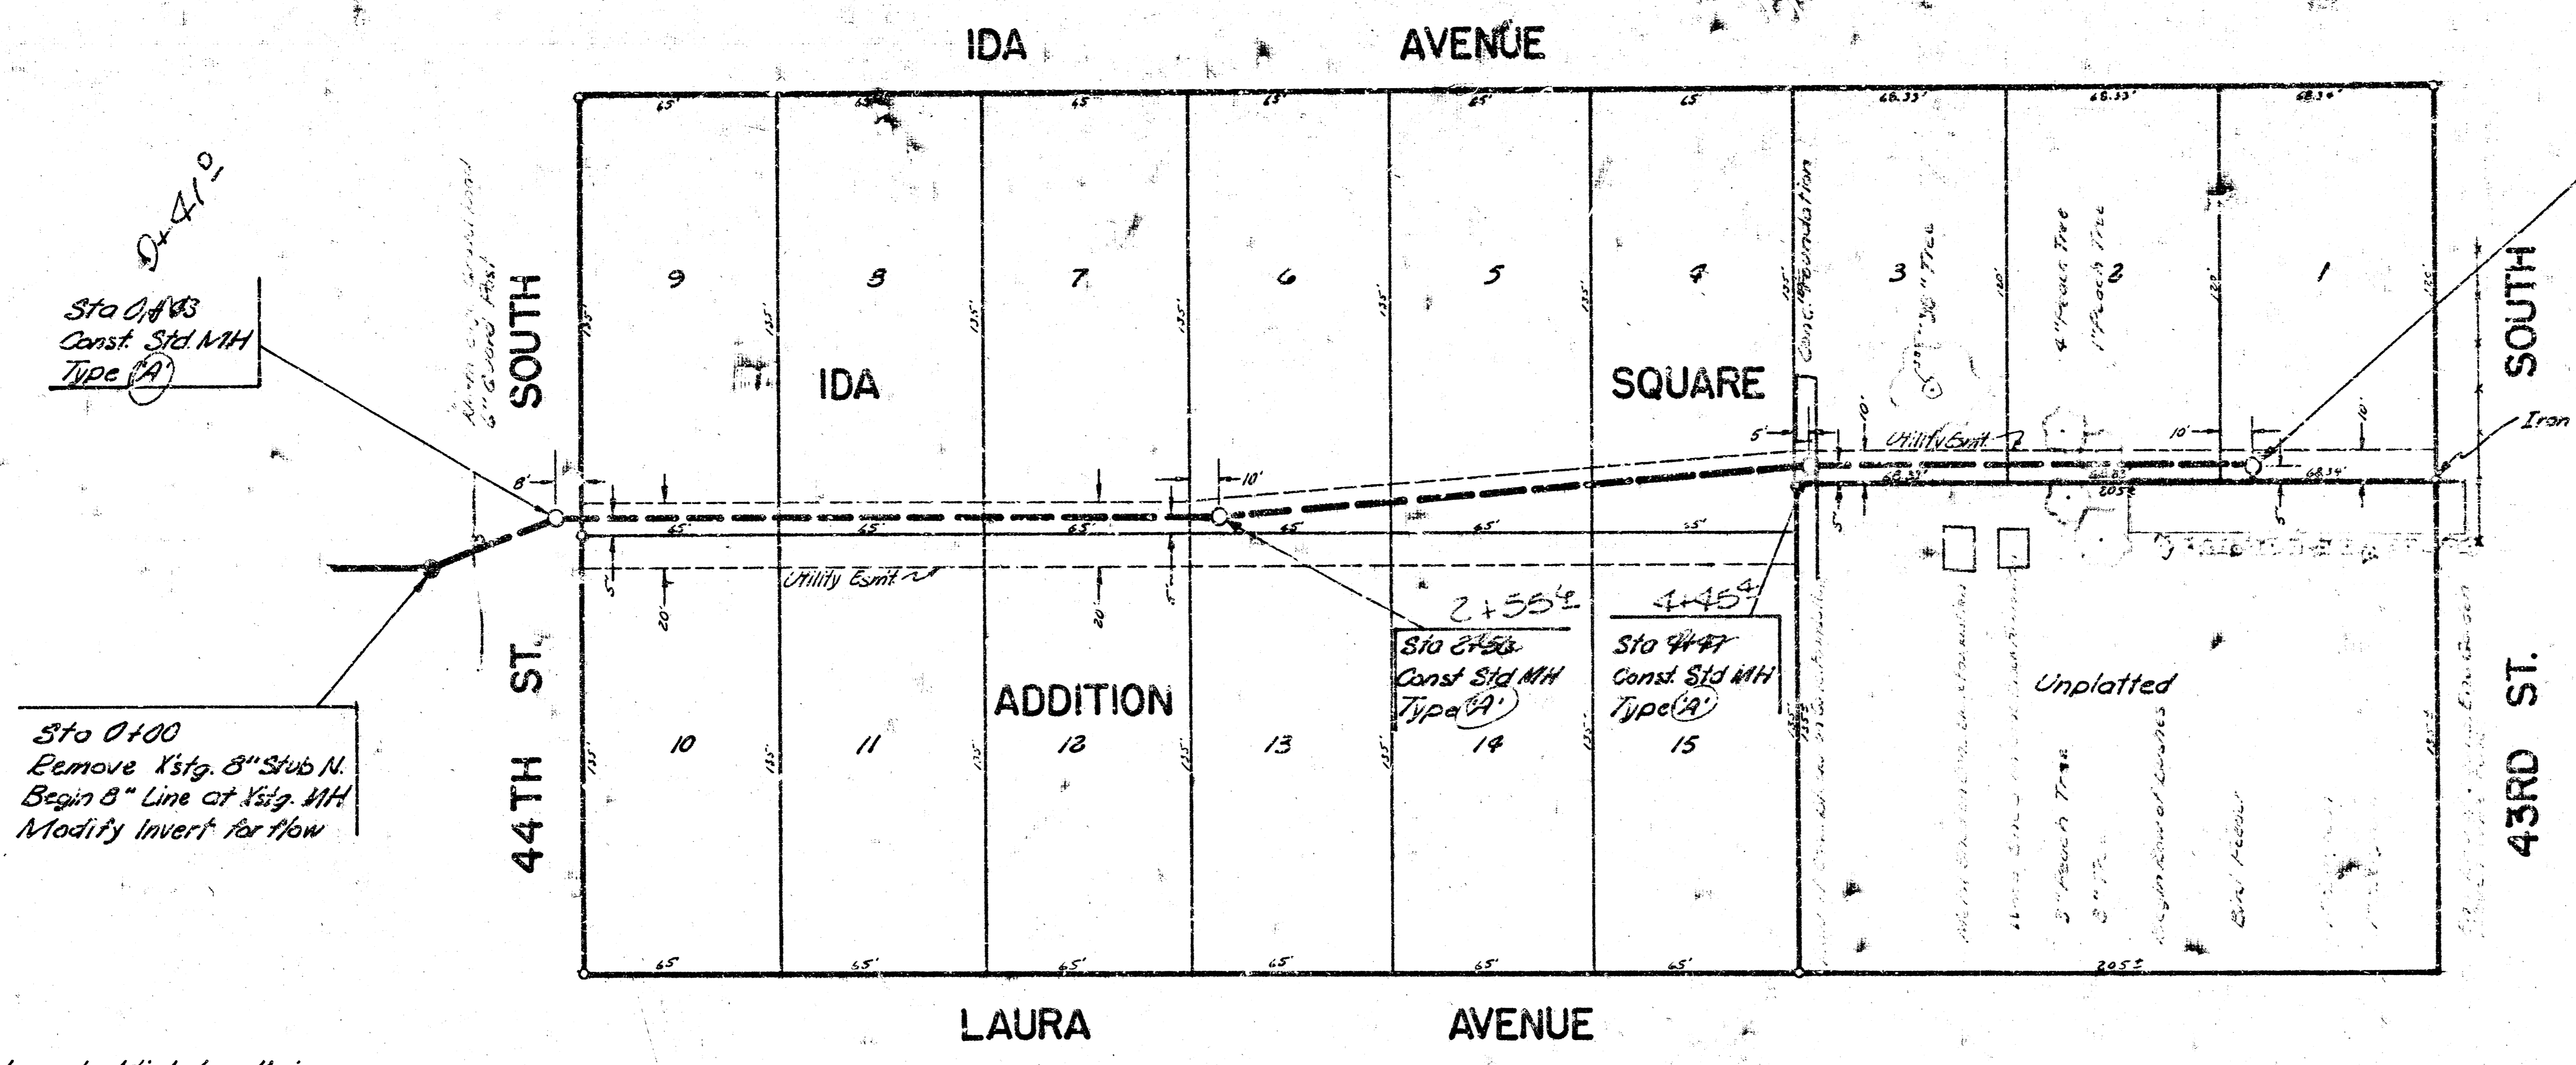

Note: Field Engineer to make 'ties' to all irons.
 Irons disturbed or destroyed are to be replaced.

NOTE: ELEVATION OF TOPS OF MANHOLES SHALL BE SET TO MATCH FINISHED GRADE AS DETERMINED BY DEVELOPER.

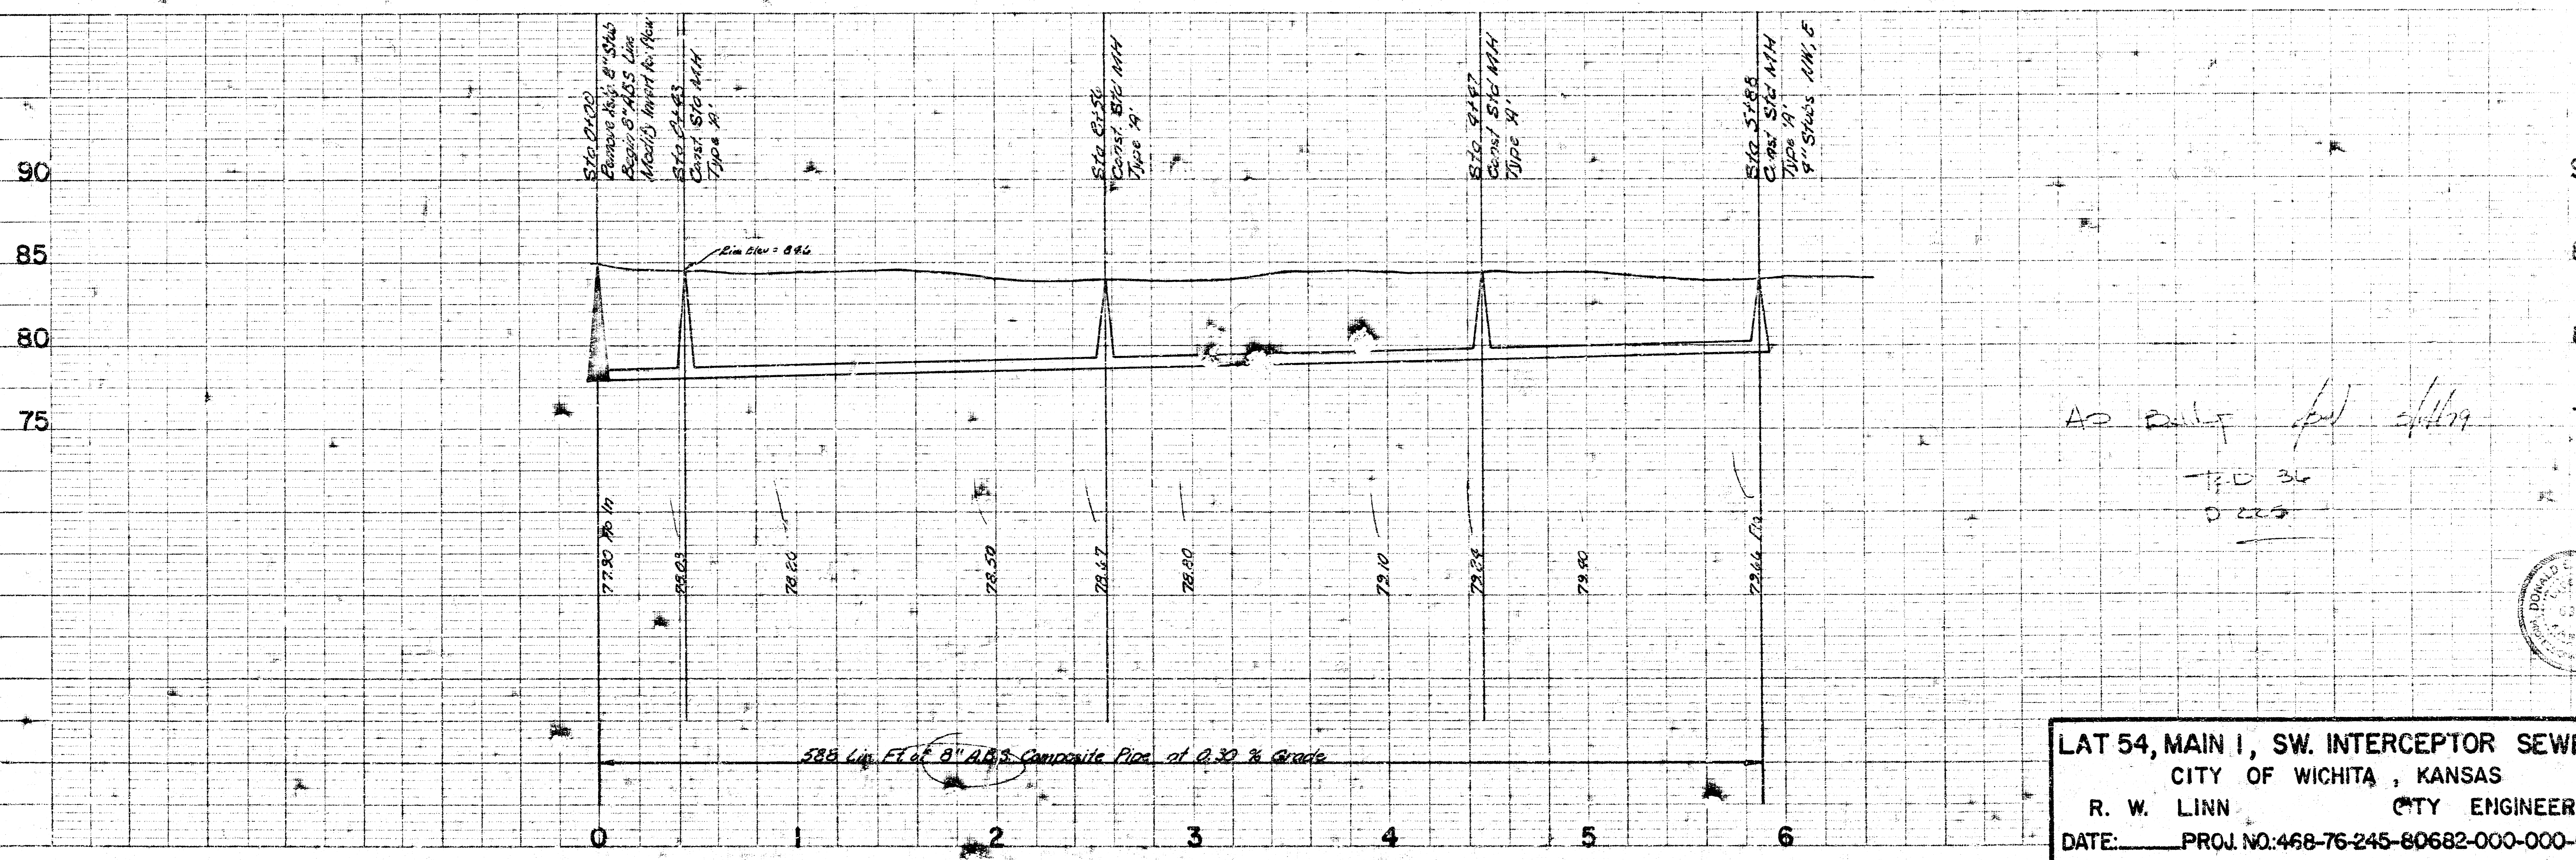

LAT 54, MAIN I, SW. INTERCEPTOR SEWER
 CITY OF WICHITA, KANSAS
 R. W. LINN CITY ENGINEER
 DATE: _____ PROJ. NO. 468-76-245-80682-000-000-00