


B.M. 99.24 J.E. Con. Cons. M.H. N.E. Cor. Carey Ln. & Ash. St. N. Approx. 1,435' W. of W.L. Seneca
 B.M. 98.23 "X" in Conc. on the S. end of the wing-wall @ the N. end of bridge span on the
 W. side of Seneca & Seneca & Carey Ln.

Plan Scale 1"=50'
 Profile Scale 1"=5' Vert.

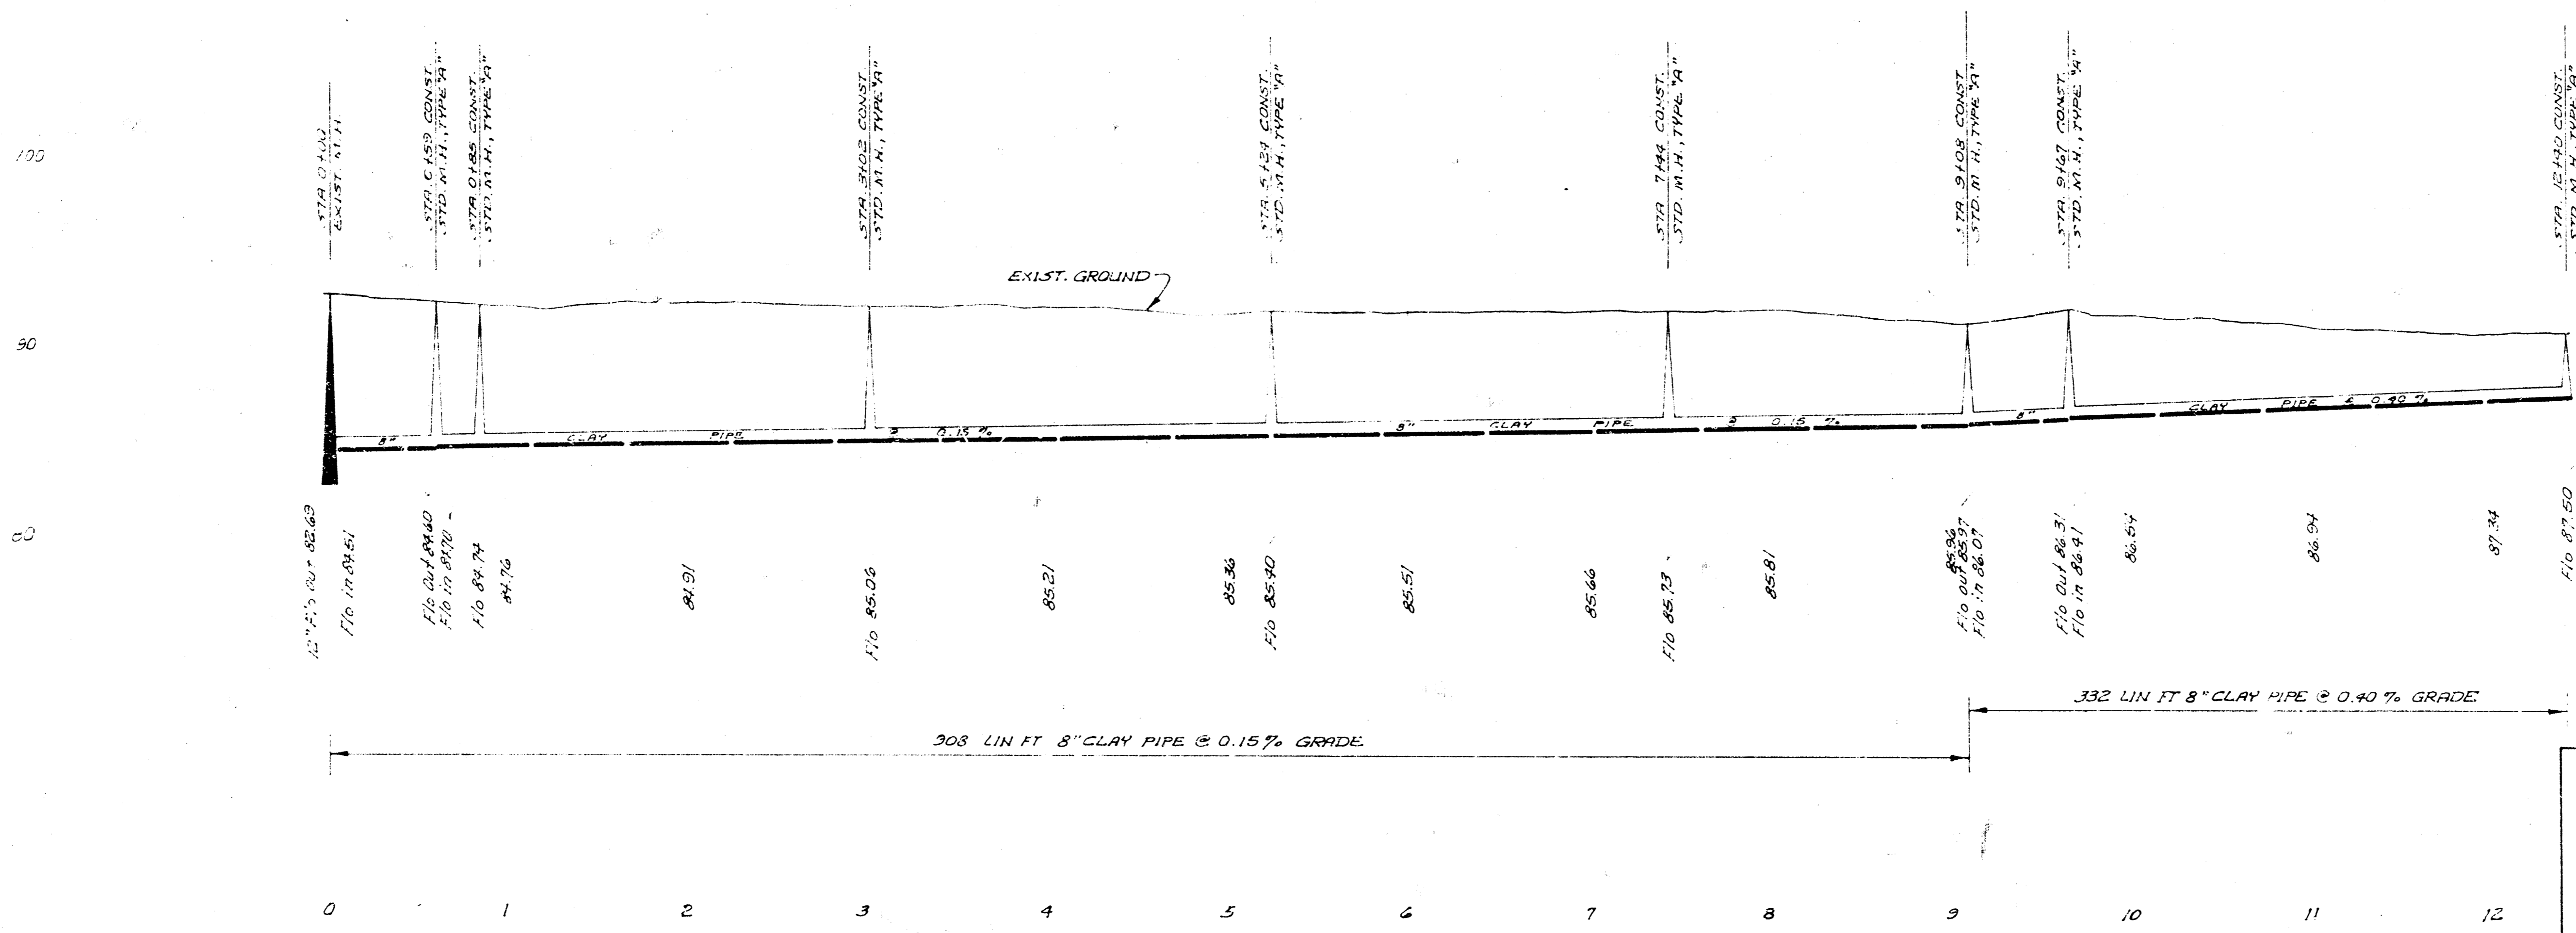

LAT. 5, MAIN 3, S.W. INTERCEPTOR
 CITY OF WICHITA, KANSAS
 R.W. LINN, CITY ENGINEER
 PROJ. NO. DBK1569051
 DATE: Dec. 1971