NOTE: TRAPS SHALL BE INSTALLED ON LINES FLOWING INTO MANHOLE AT STATION 2 + 56.5 IF INDIVIDUAL MOBILE HOME SERVICE LINES SERVED BY THESE LINES ARE NOT TRAPPED. TRAPS SHALL BE PAID FOR AT UNIT PRICE BID FOR THE VARIOUS PIPE SIZES INDICATED.

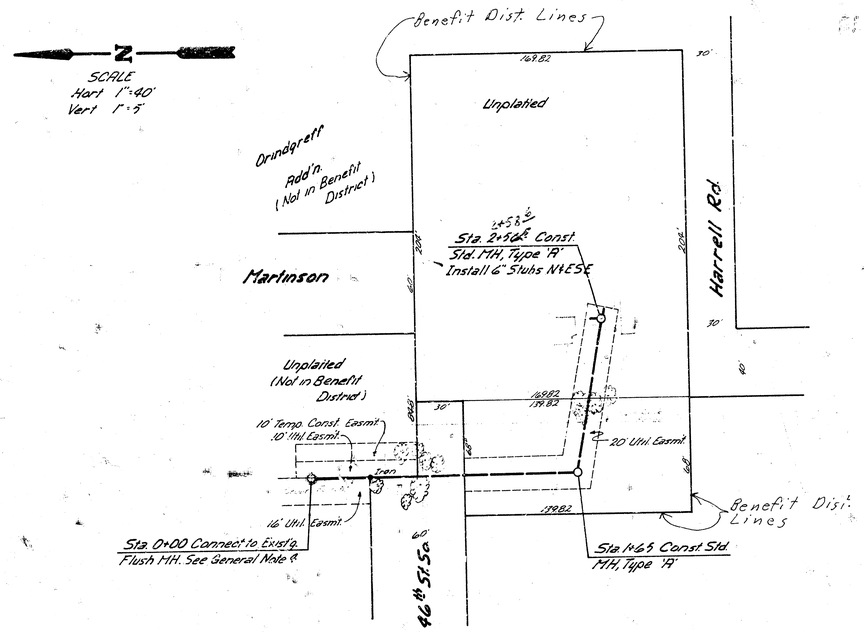

General Notes

1. Field Engineer to Take Ties to any Irons which May be Disturbed and Replace any that are Destroyed.
2. Contractor to Coordinate Construction of Manhole Sta 2+56.5 with Wayne Smith, 110 Meikle, Wichita, 722-5862
3. Contractor to Uncover Service Lines Before Beginning Construction to Verify Flow Elevations.
4. Bid Price of Connection to MH to Include Rem. Flapgate & Chain, Steps & Rework Invert.
5. Contractor to Contact Owner of House West of Sta 0+00 before Removing Fence.

B.M. 87.34 City Std. 74' N & 44' E. of ℄'s Seneca & 47th St. So.

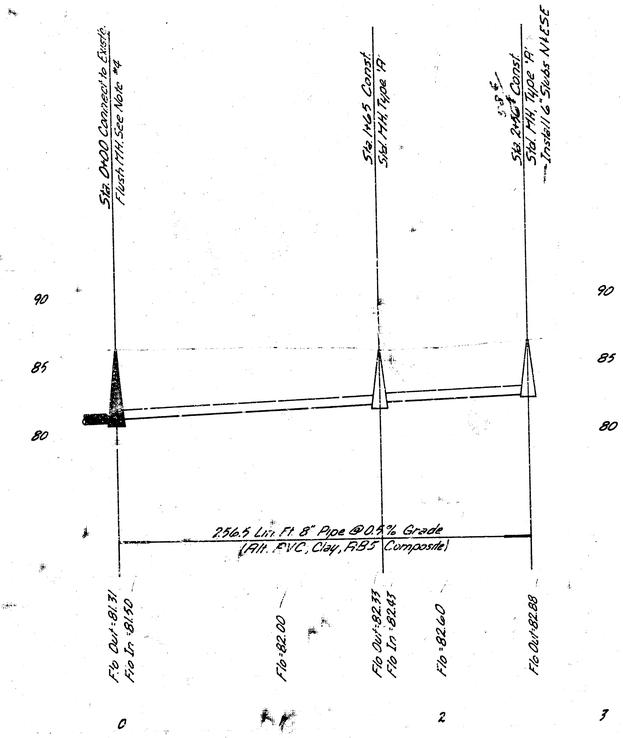

8205

As-Built 3-13-86

Lat. 32, Main 3, SWI
468-76-245-80708-000-000-001
City of Wichita, Kansas
Dept. of Public Works - Eng. Div.
Dean S. Sellers - Acting City Engineer

1/1