SHEET 1 OF 1

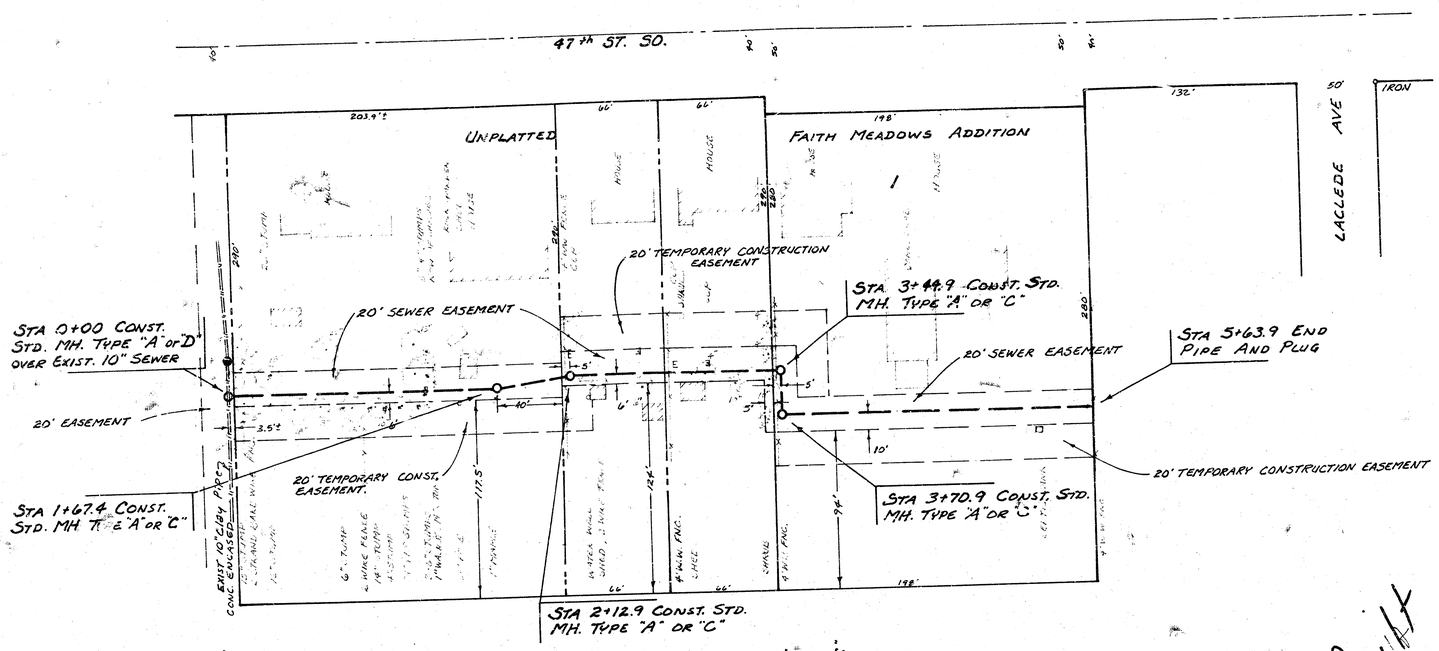

SCALE PLAN 1" = 40'
PROFILE 1" = 40' HORZ.
1" = 5' VERT.

THE CONTRACTOR SHALL BE RESPONSIBLE FOR PRESERVING PROPERTY IRONS. THE CONTRACTOR SHALL BE REQUIRED TO RE-ESTABLISH ANY PROPERTY IRONS WHICH ARE DAMAGED OR DESTROYED BY HIS CONSTRUCTION OPERATIONS. SUCH IRONS SHALL BE RE-ESTABLISHED BY A LICENSED LAND SURVEYOR OR A LICENSED PROFESSIONAL ENGINEER IN ACCORDANCE WITH STATE LAWS.

B.M. 86.85 CITY STD. 47th ST. SO. & GOLD 128 ft. W. AND 35 ft. N OF 1/4 SEC. CORNER.

B.M. 87.69 R.R. SPIKE NW FACE P.P. SE. CORNER 47th ST. SO. AND LACLEDE.

REGISTERED PROFESSIONAL ENGINEER 8217 KANSAS

As Built 1-83 J.L.L.

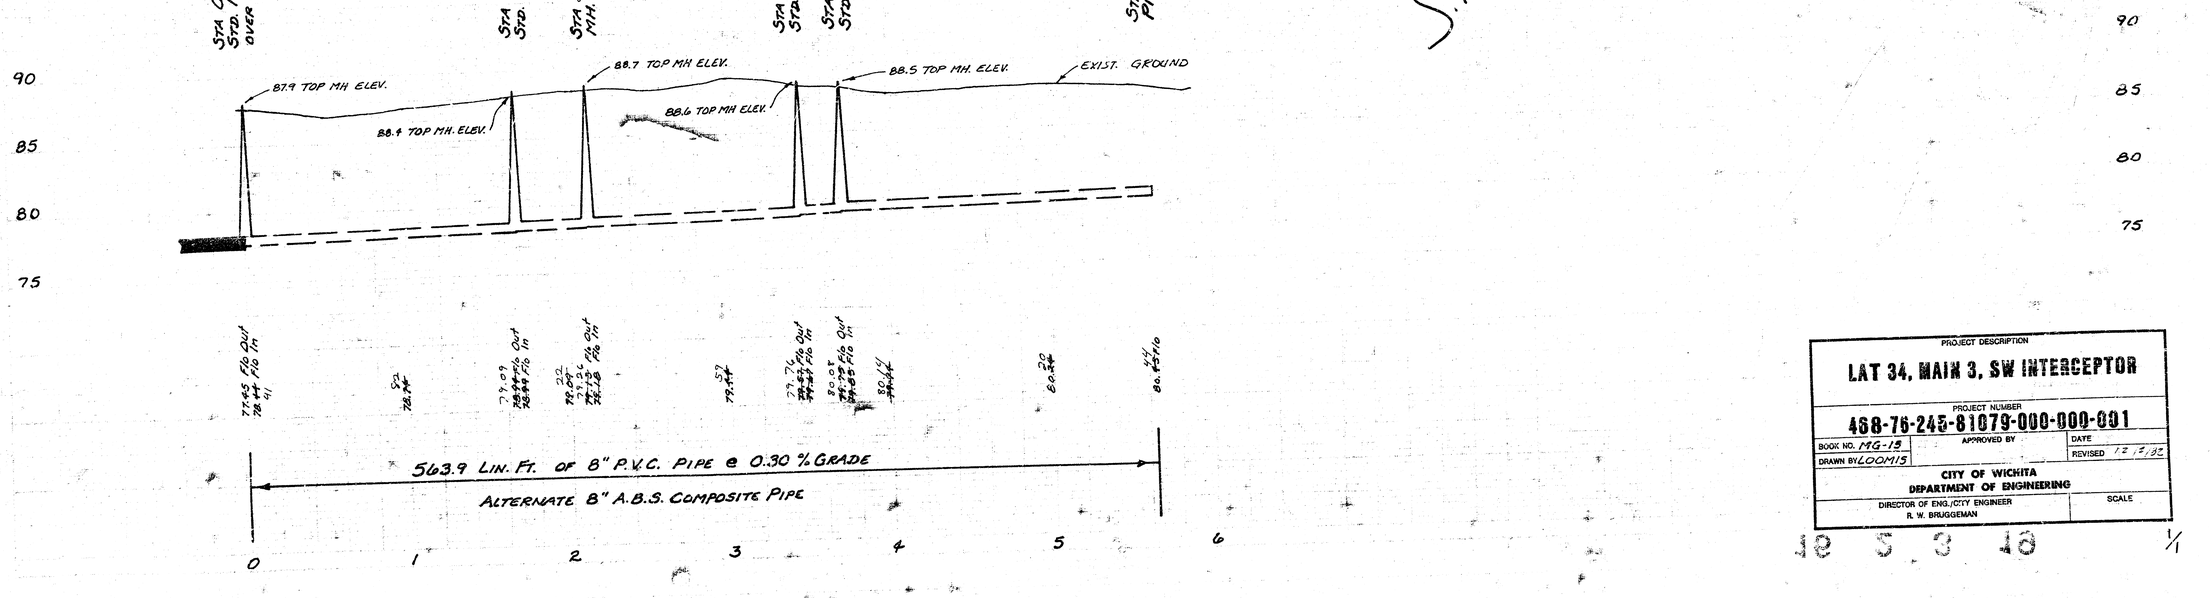

PROJECT DESCRIPTION	
LAT 34, MAIN 3, SW INTERCEPTOR	
PROJECT NUMBER 468-76-245-81079-000-000-001	
BOOK NO. MG-13 / DRAWN BY LOOMIS	APPROVED BY / DATE / REVISED 12/5/82
CITY OF WICHITA DEPARTMENT OF ENGINEERING	
DIRECTOR OF ENG./CITY ENGINEER R. W. BRUGGEMAN	SCALE

1/1