SHEET 1 OF 1

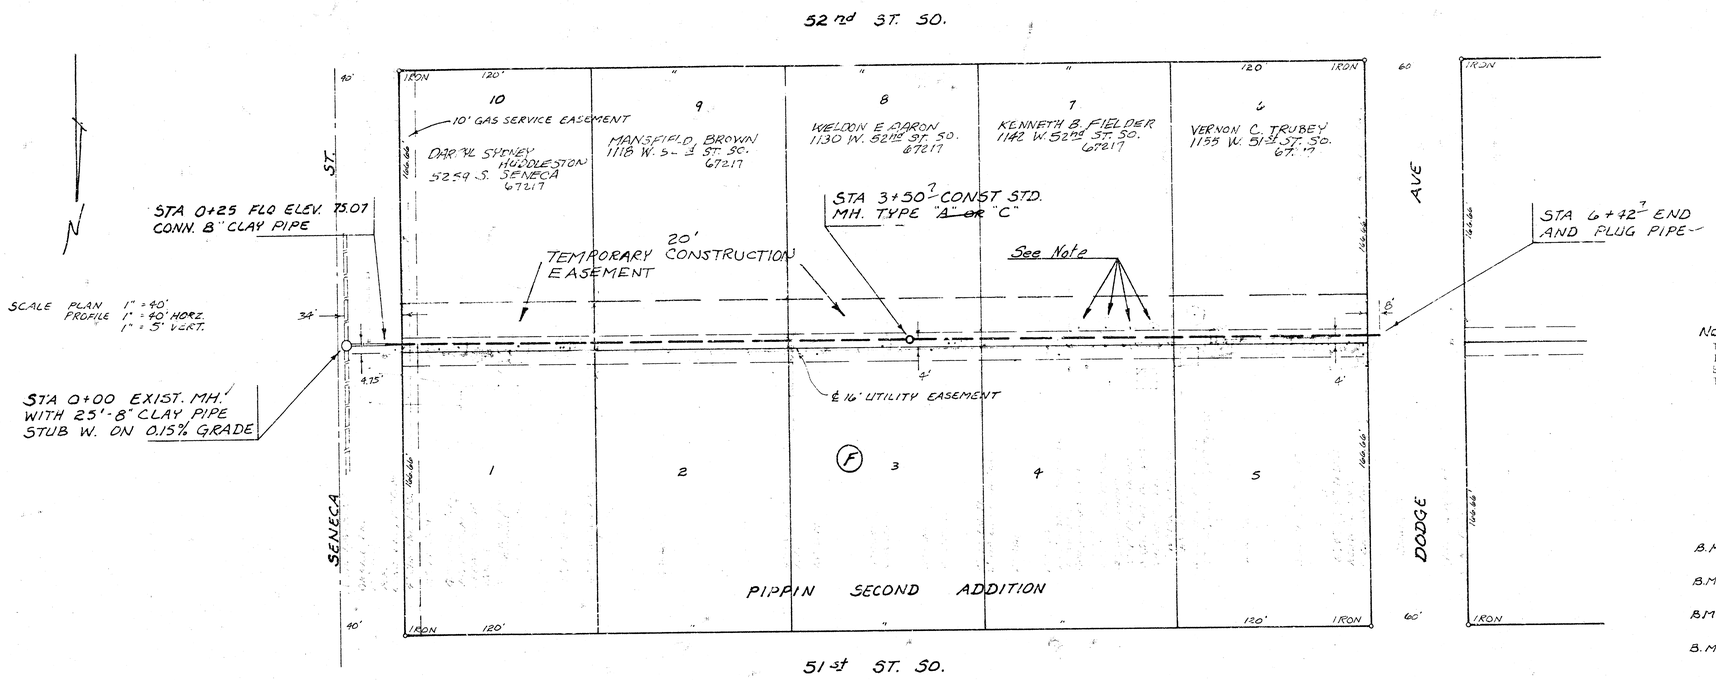

Note:
THE CONTRACTOR SHALL MAKE EVERY EFFORT TO AVOID DISTURBING FRUIT TREES & SHALL REPLACE WITH TREES OF EQUAL OR BETTER QUALITY, SIZE, & CONDITION, IF REMOVAL OF EXISTING TREES IS NECESSARY.

THE CONTRACTOR SHALL BE RESPONSIBLE FOR PRESERVING PROPERTY CORNERS. THE CONTRACTOR WILL BE HELD TO BE ESTABLISHED WITH RESPONSIBLE FOR THE DAMAGED OR DESTROYED BY HIS CONSTRUCTION OPERATIONS. SUCH CORNERS SHALL BE REESTABLISHED BY A LICENSED LAND SURVEYOR OR A LICENSED PROFESSIONAL ENGINEER IN ACCORDANCE WITH STATE LAWS.

B.M. 83.03 R.R. SPIKE E. FACE P.P. NW CORNER 52nd ST. SO. AND DODGE.

B.M. 80.72 CITY STD. DISC 30' S. & 45' E. OF ℄ BOTH SENECA AND 55th ST. SO.

B.M. 82.89 R.R. SPIKE E. FACE P.P. NW CORNER 51st ST. SO. AND SENECA.

B.M. 83.31 R.R. SPIKE E. FACE P.P. NW CORNER 52nd ST. SO. AND SENECA.

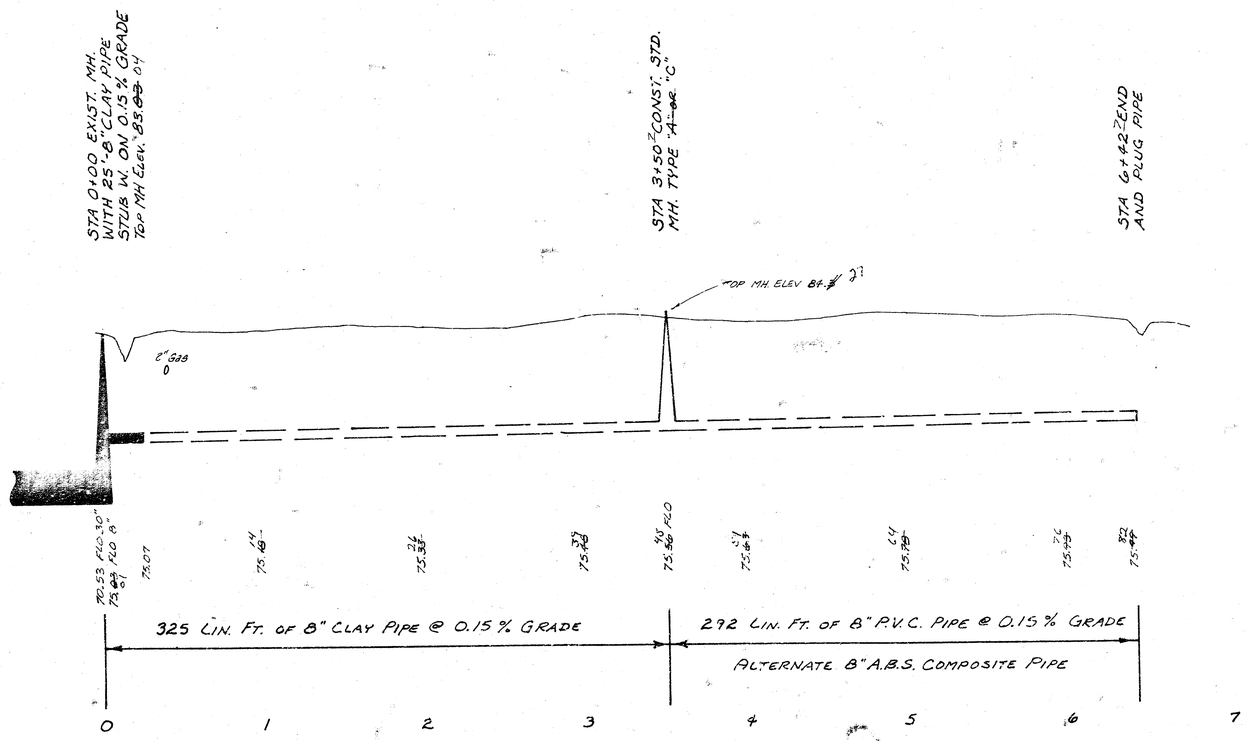

PROJECT DESCRIPTION
LAT 36, MAIN 3, S. W. INTERCEPTOR

PROJECT NUMBER
468-76-245-81207-000-000-001

BOOK NO. MGP-17	APPROVED BY	DATE 6-82
DRAWN BY LOOMIS		REVISED

CITY OF WICHITA
DEPARTMENT OF ENGINEERING

DIRECTOR OF ENG. CITY ENGINEER
R. W. BRUGGEMAN

SCALE