


**LATERAL 38, MAIN 3  
SOUTHWEST INTERCEPTOR SEWER**



*Project no. 468-76-245-80854-000-000-001*

**CITY OF WICHITA, KANSAS  
MIKE LINDEBAK CITY ENGINEER**

*TS Built  
J.H.  
4-84*

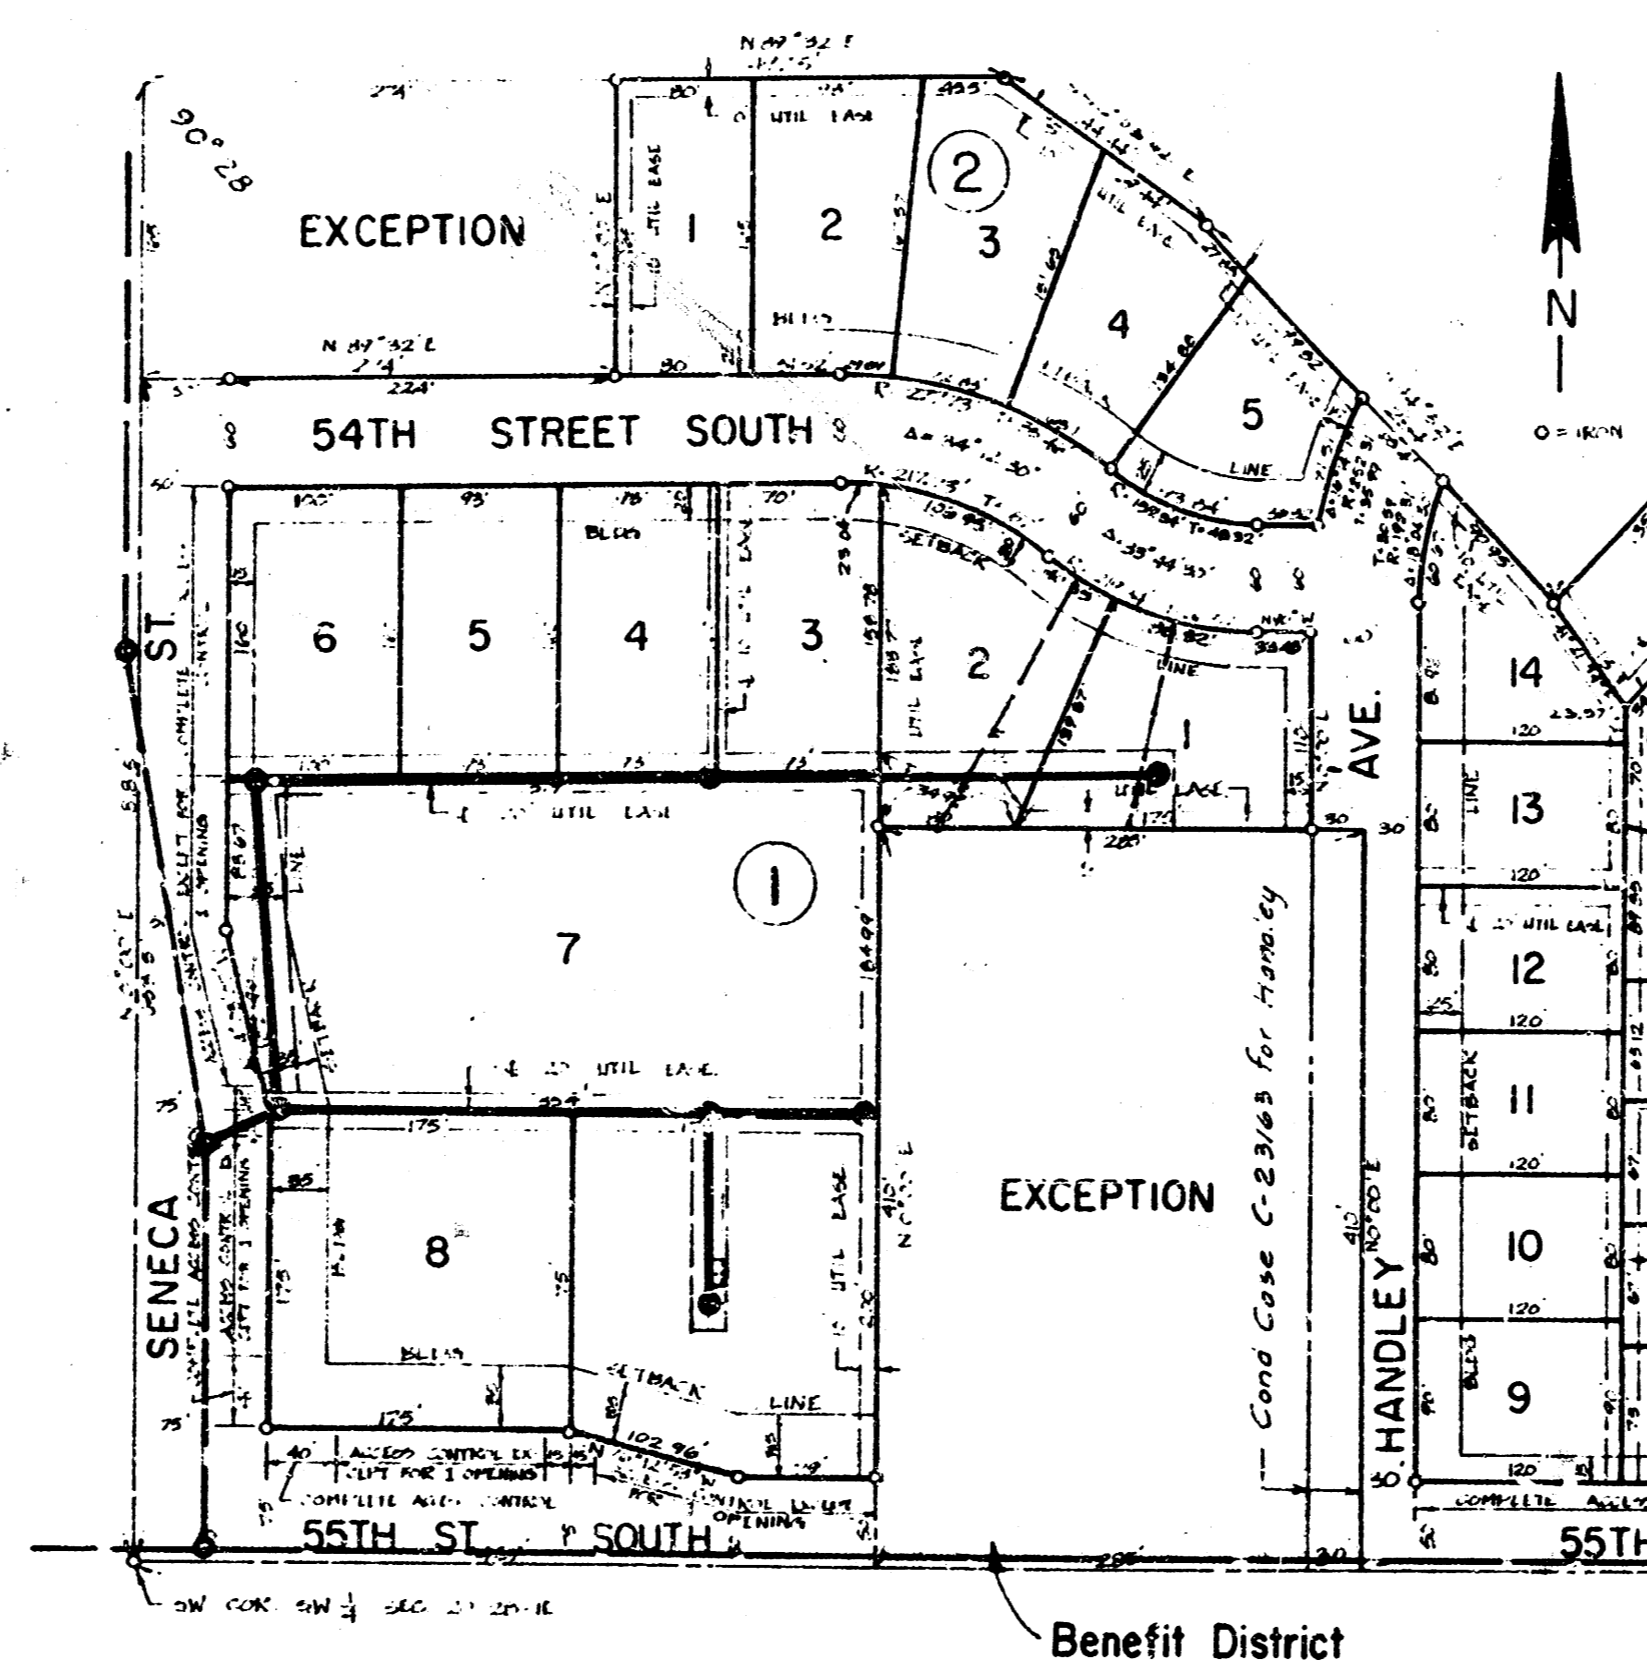


*1/3*  
Revised 1-24-84

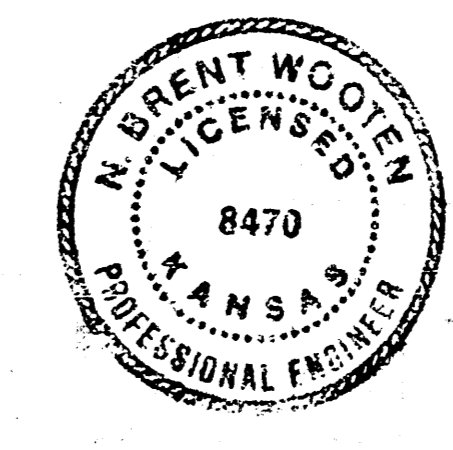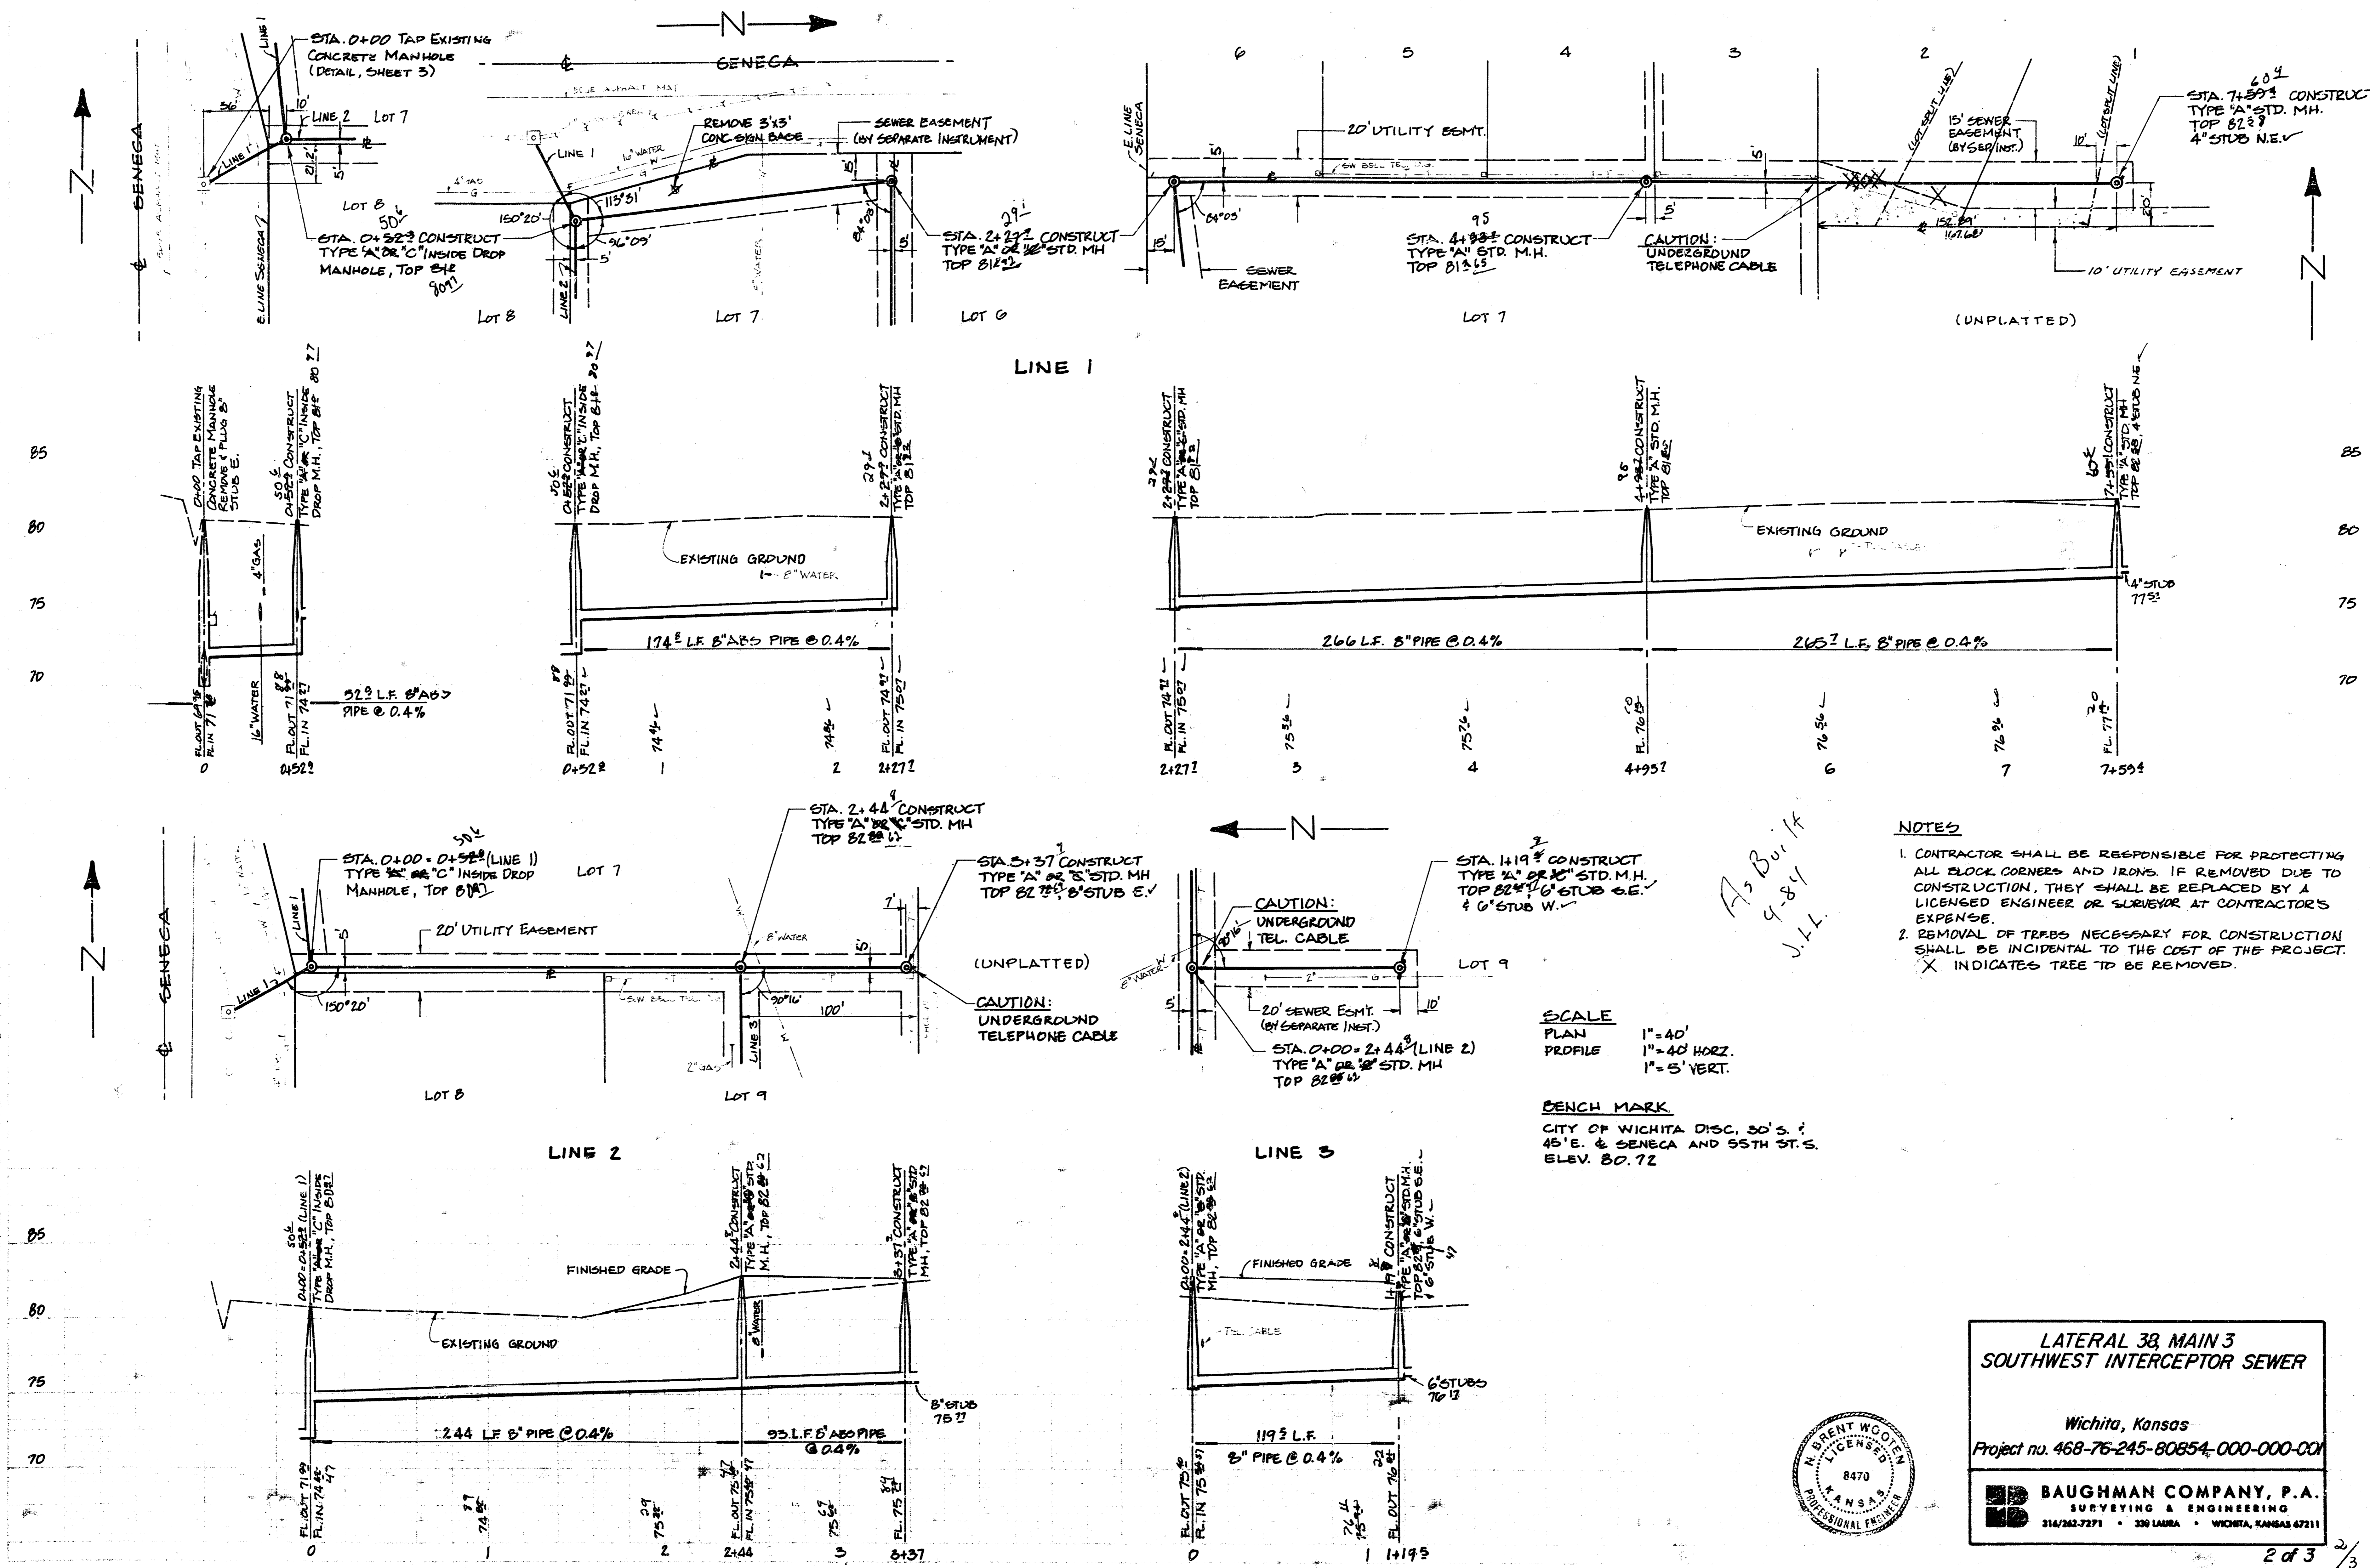




**LATERAL 38, MAIN 3  
SOUTHWEST INTERCEPTOR SEWER**

Wichita, Kansas  
 Project no. 468-76-245-80854-000-000-000

**BAUGHMAN COMPANY, P.A.**  
 SURVEYING & ENGINEERING  
 314/363-7371 • 330 LAURA • WICHITA, KANSAS 67211

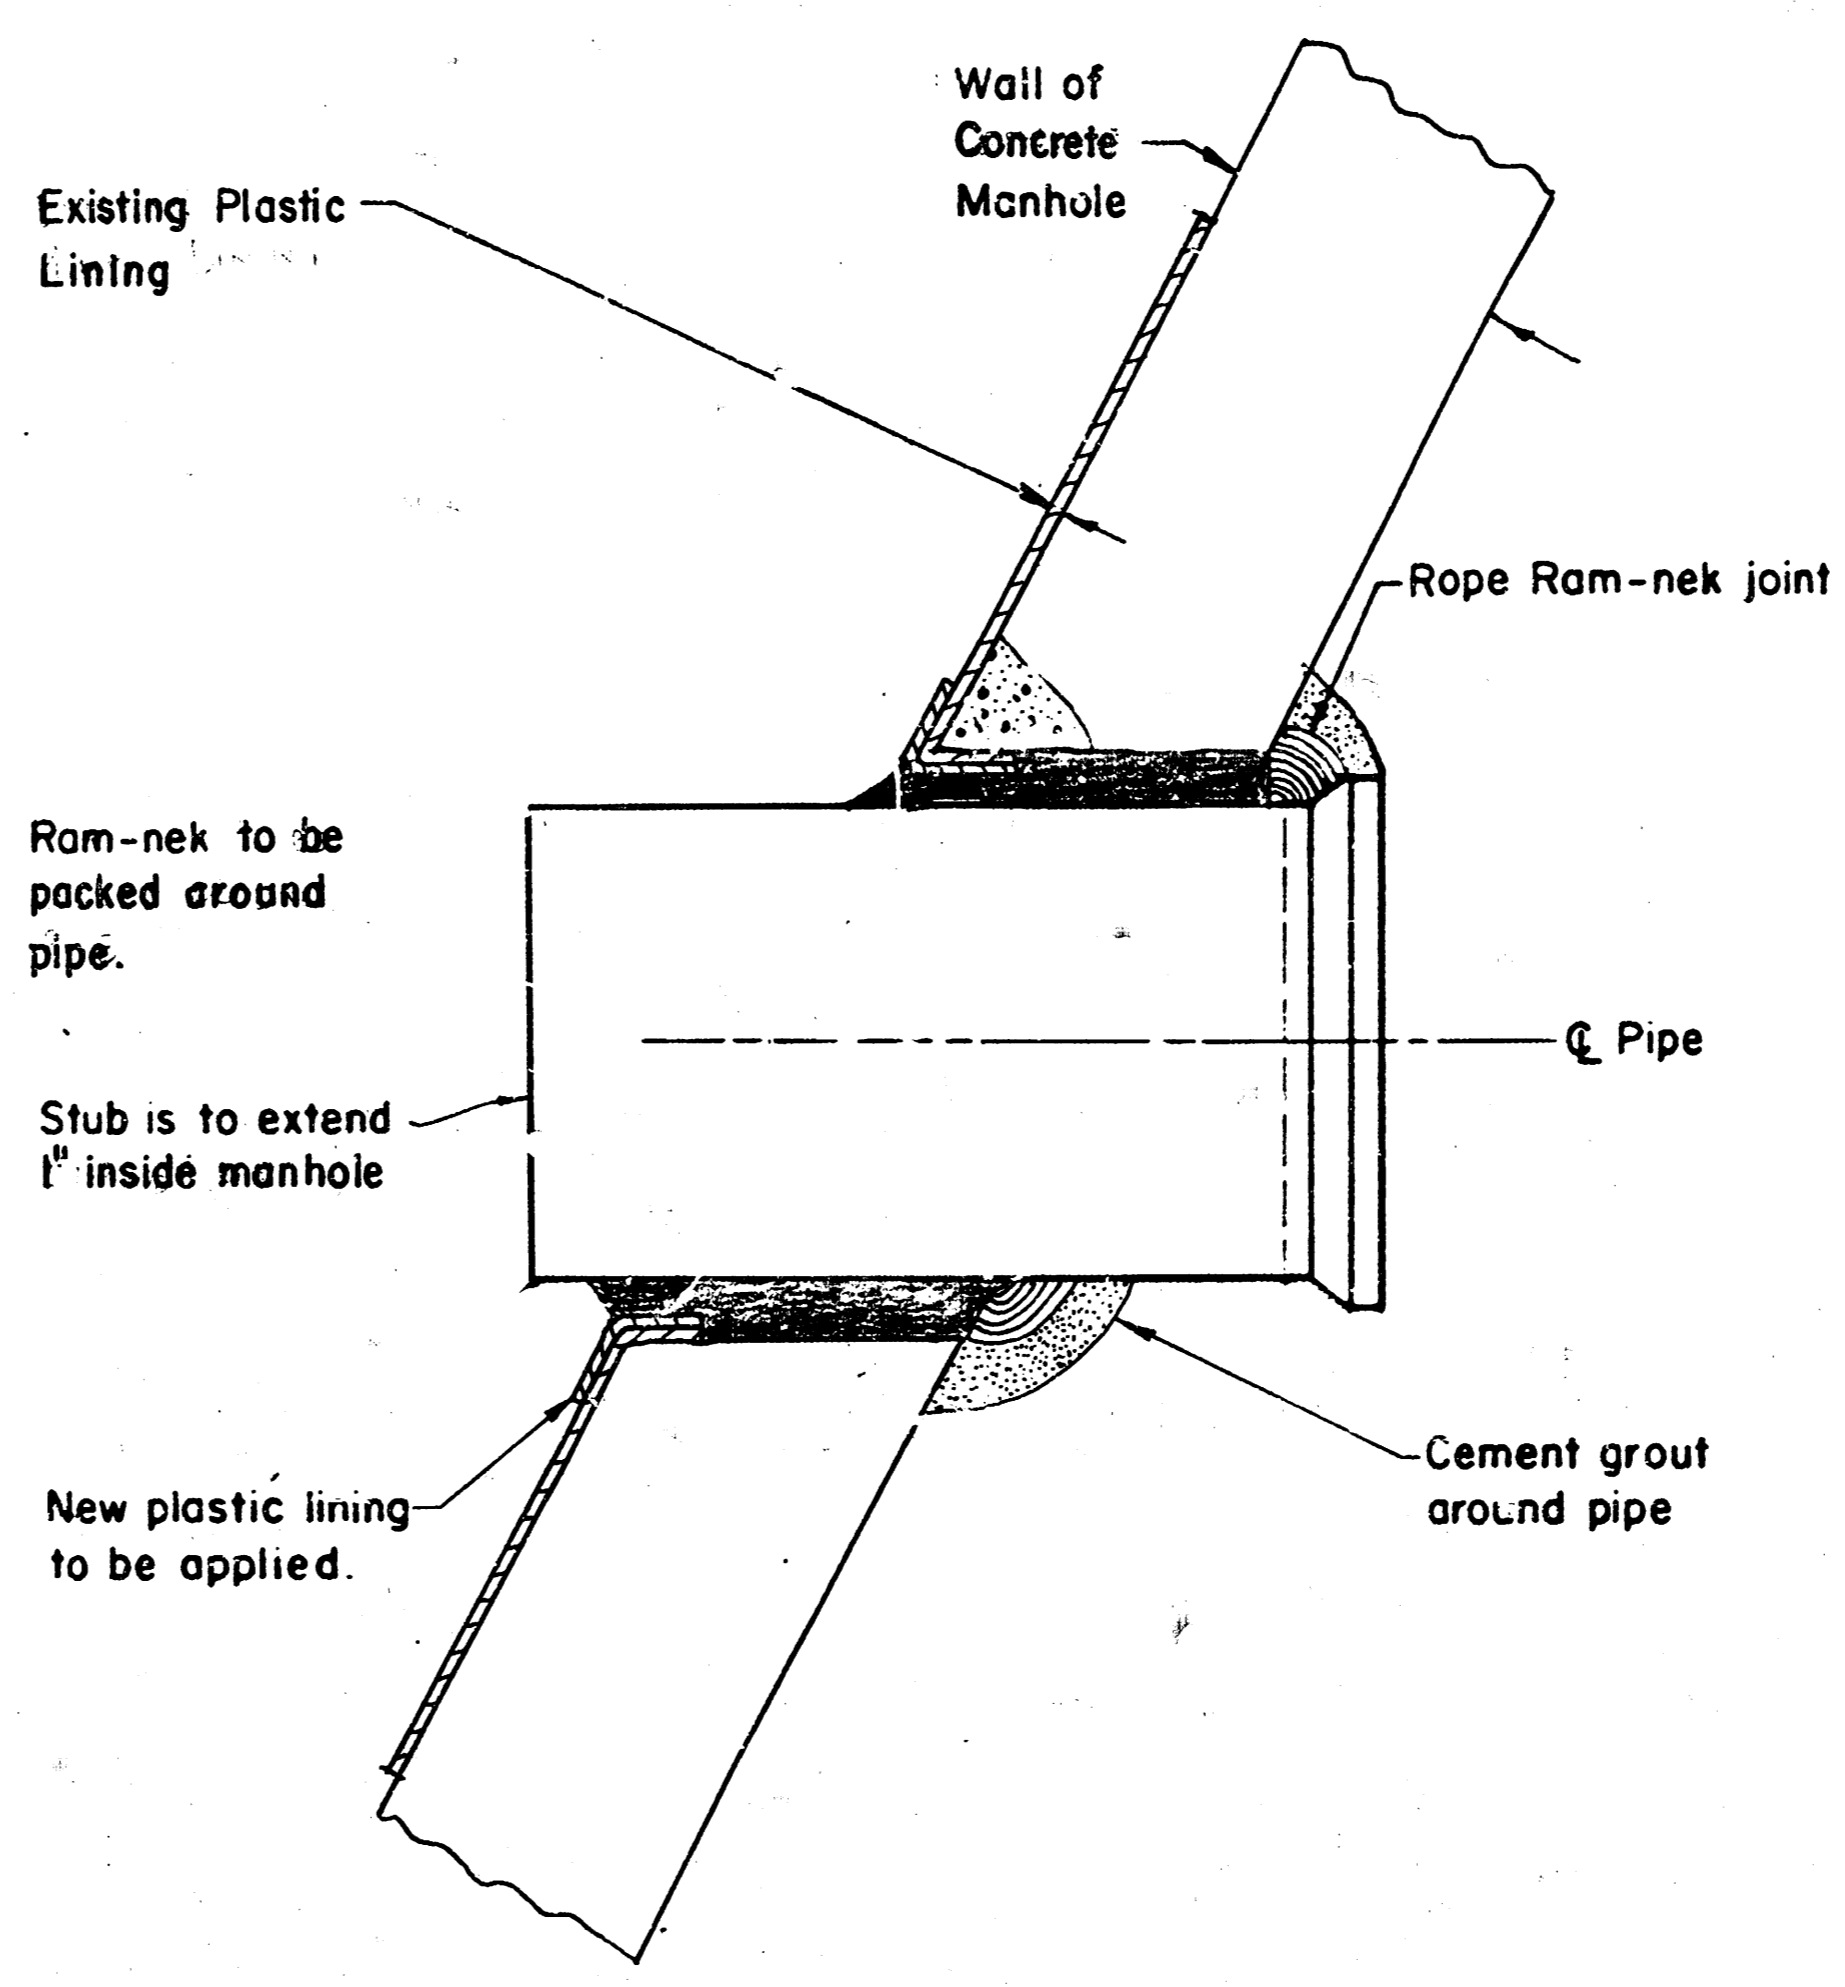

SECTIONAL PLAN

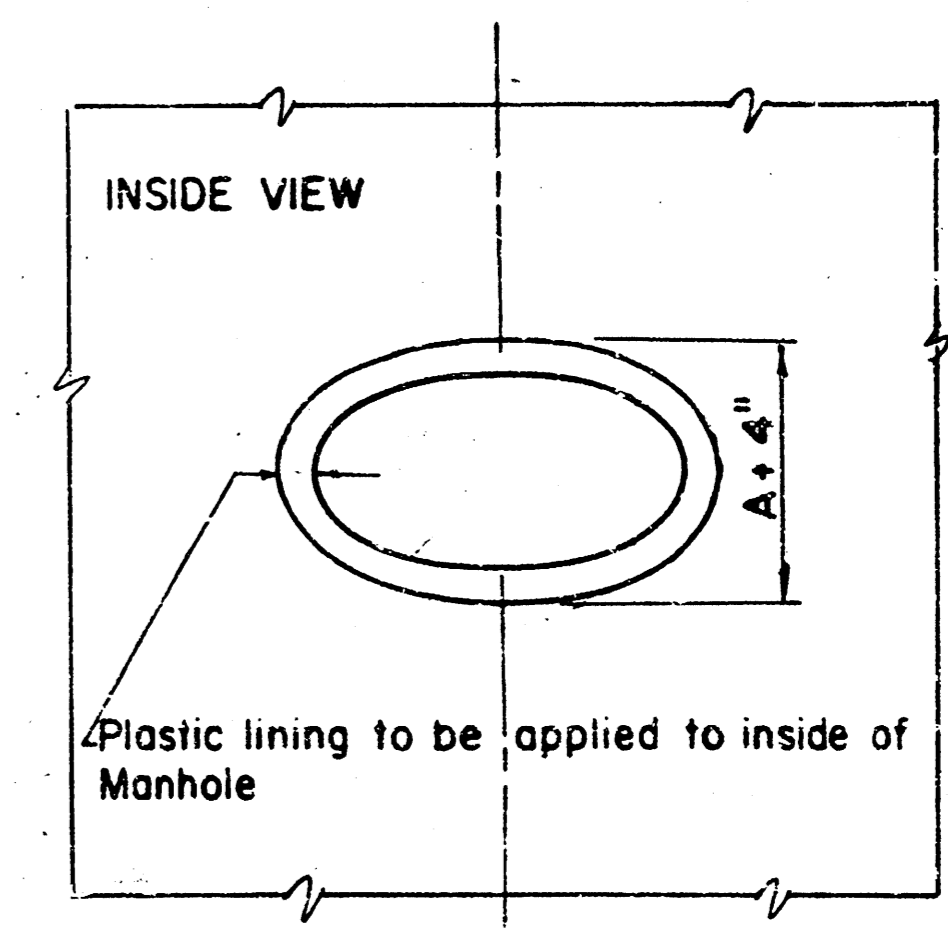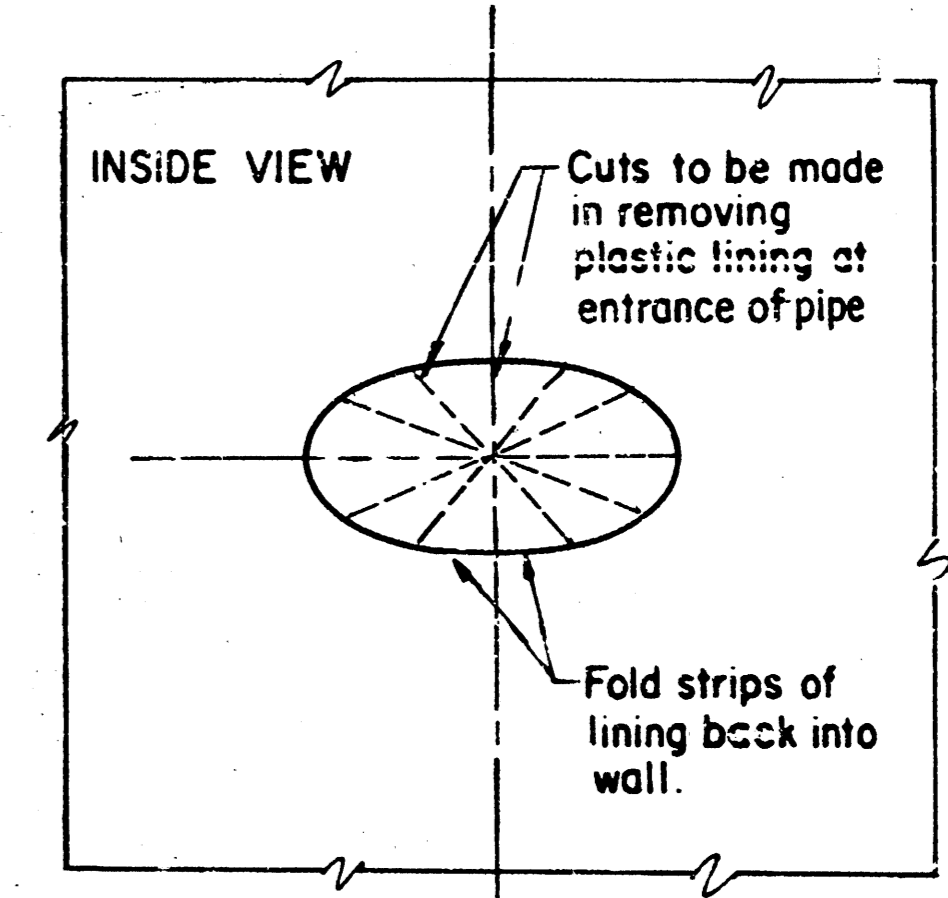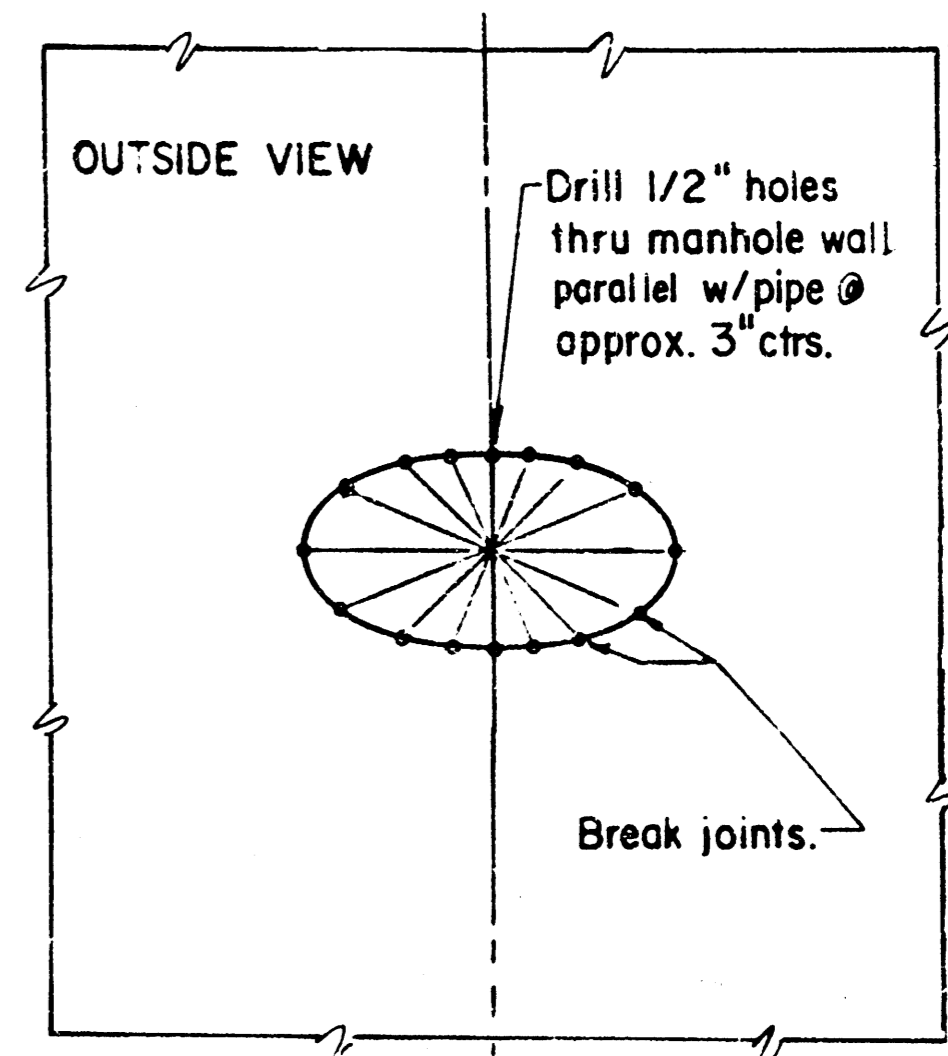

A = OUTSIDE DIAMETER OF PIPE + 2"

DETAIL OF PIPE CONNECTION  
TO PLASTIC - LINED MANHOLE  
CITY OF WICHITA , KANSAS  
PROJECT NUMBER: 468-76-245-80854-000-000-001