
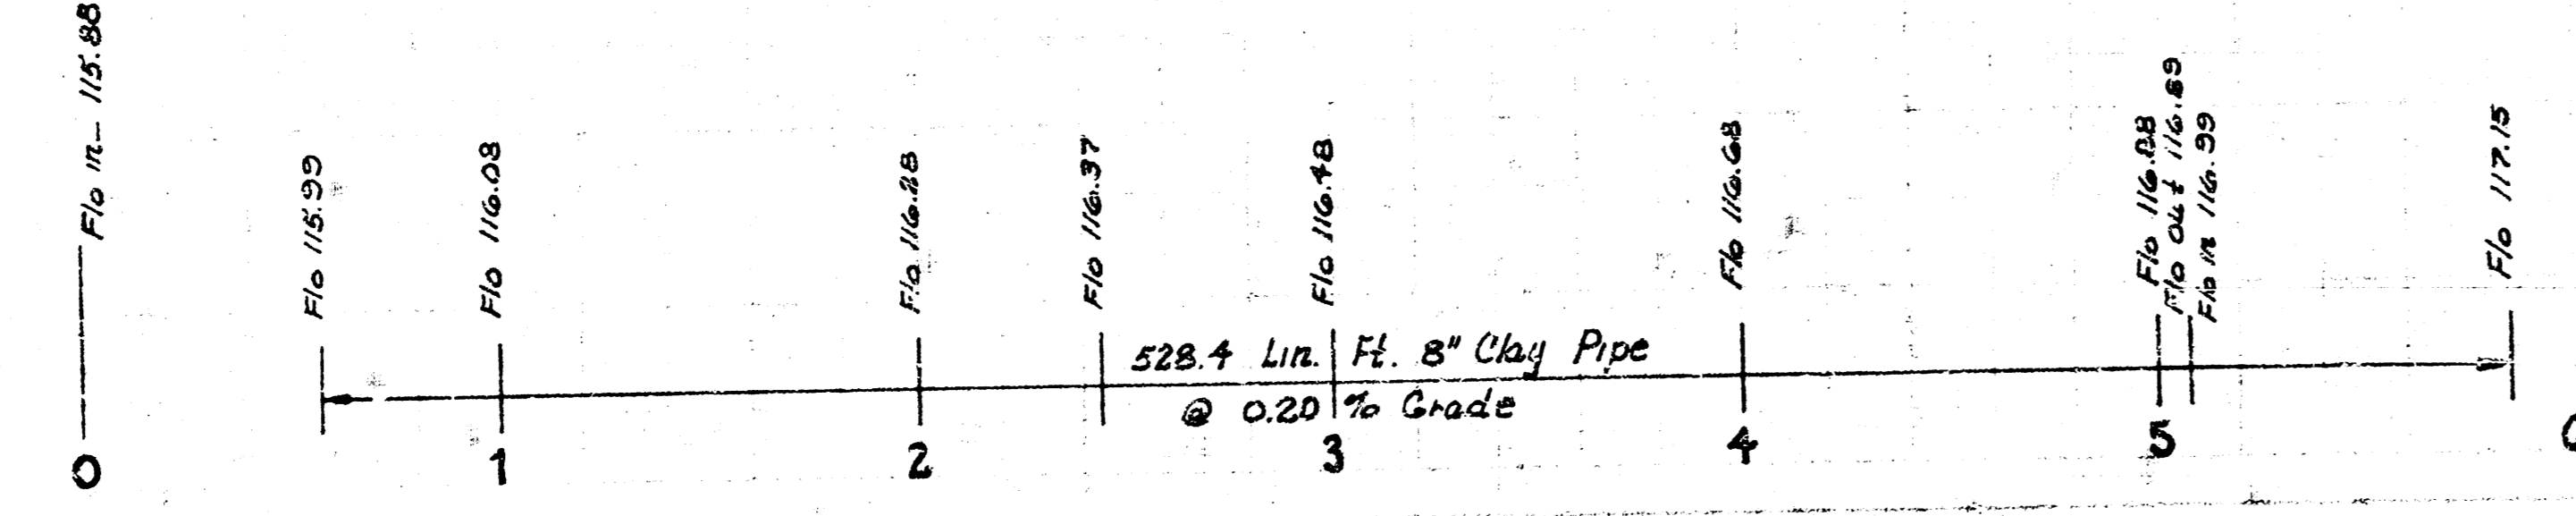
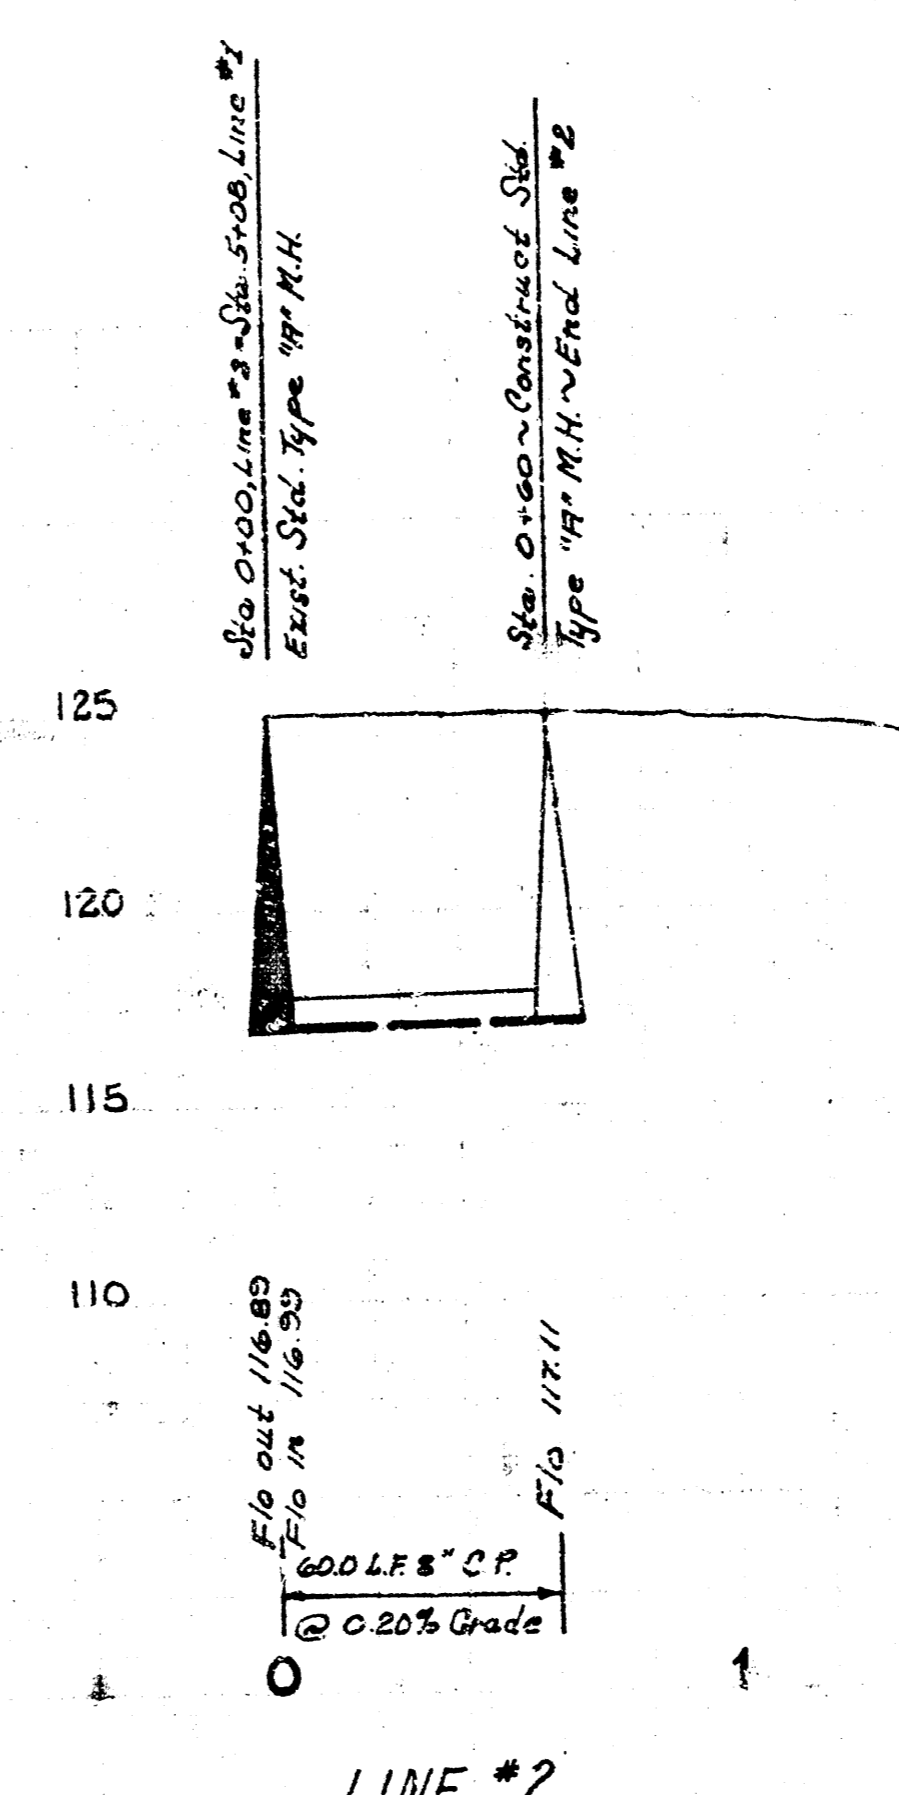
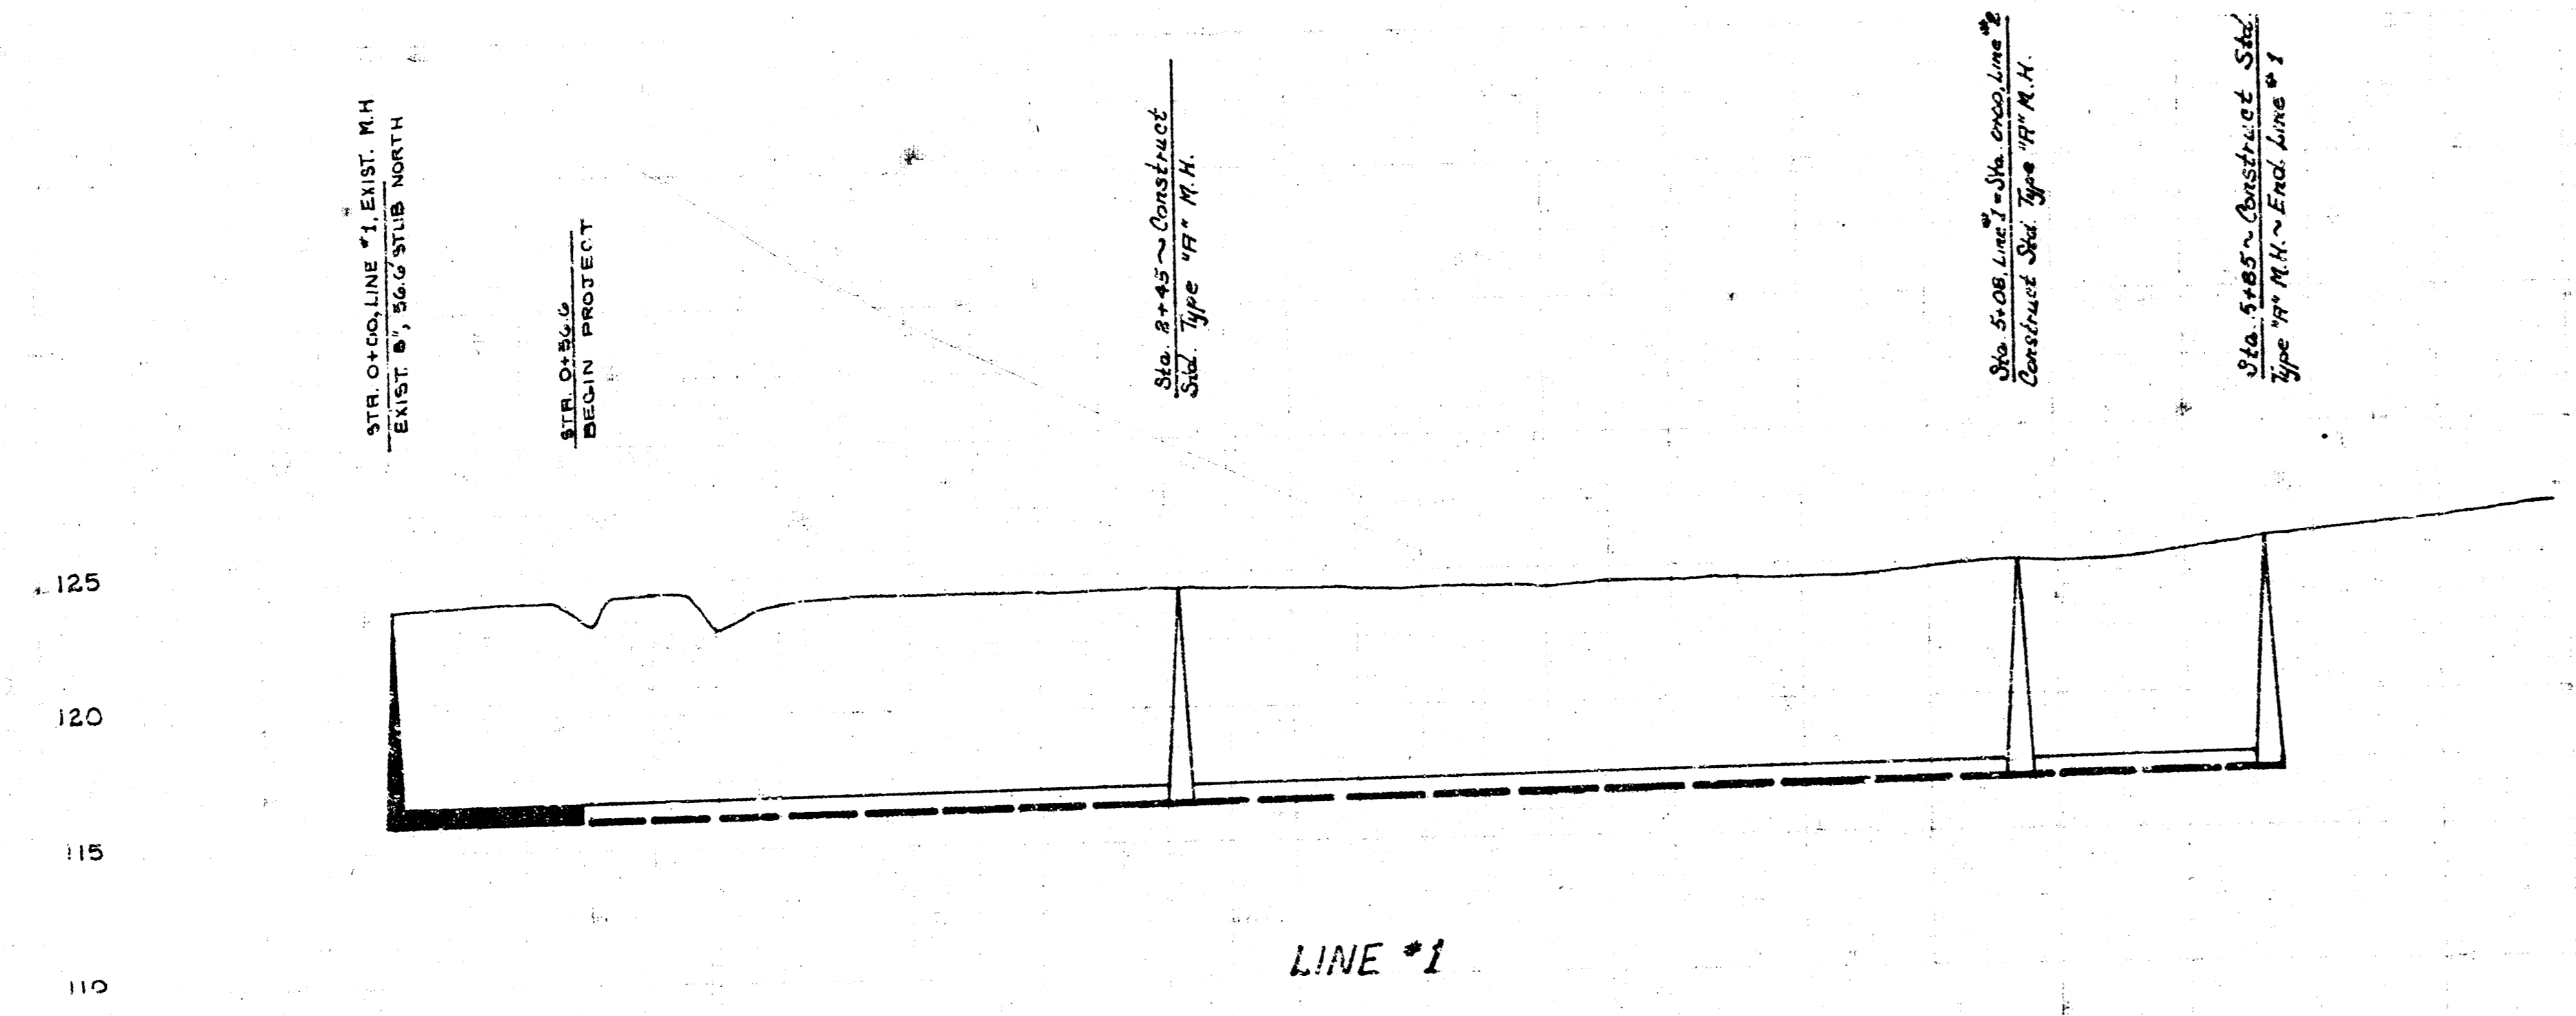


CONTRACT TYPE

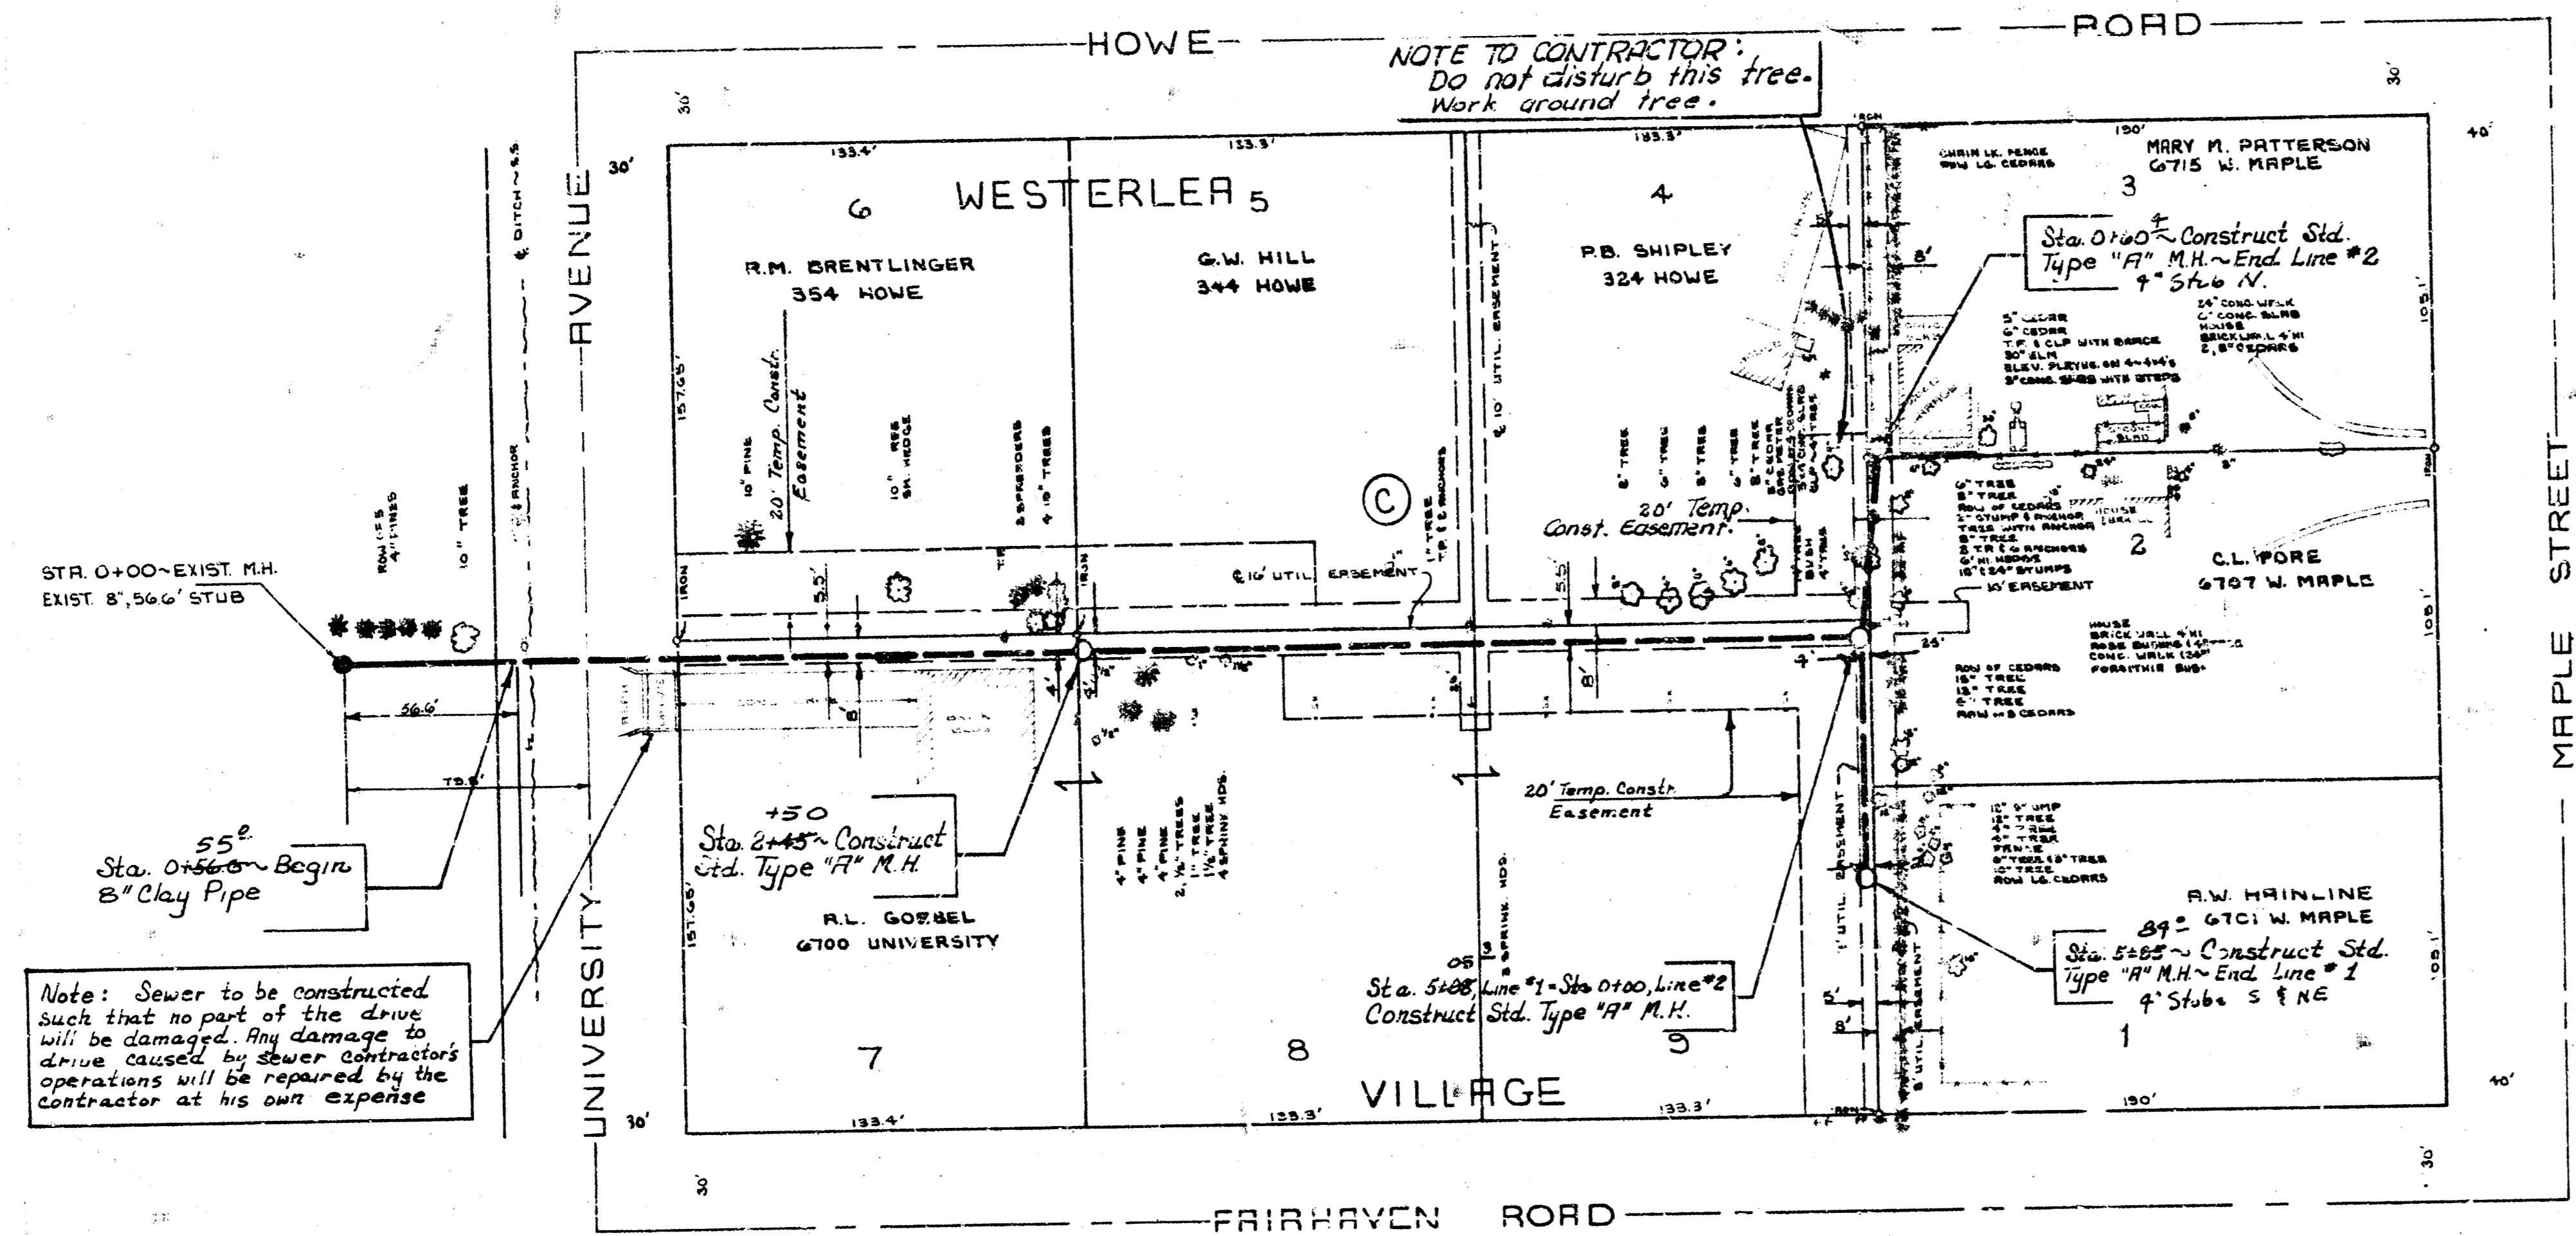

LAT. 11, MAIN 4 S.W.I. SEWER
CITY OF WICHITA
R.W. LINN CITY ENGINEER
DATE Jan. 24, 1974 PROJ. NO. DBKL 572006

14 e s 8