B.M. 116.05 A.R. spike W. face P.P. SE corner Lot 6, Block C, Garst Garden.
B.M. 122.726 ⊐ cut on NW corner concrete flume w/ SW corner Hoover & U.S. 54.

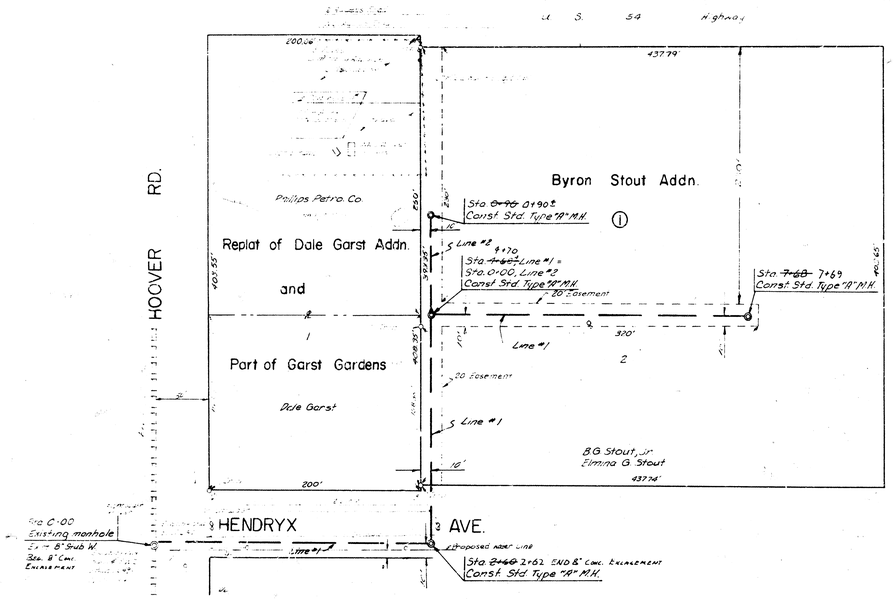

Note: Field Engineer shall check studs flow elevation prior to construction of sanitary sewer.

Plan Scale 1" = 50'
Profile Scale for 1" = 50'
Profile Scale for 1" = 5'

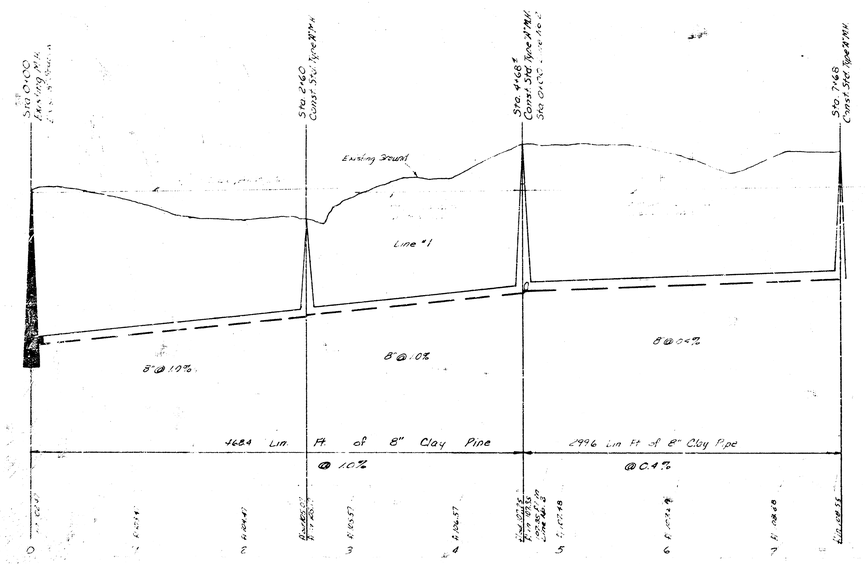

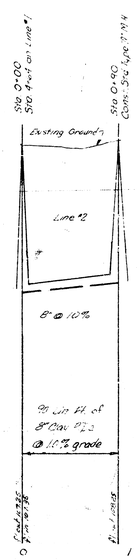

"As Built" Final Measurements K-83

LAT. 15, MAIN 4, S.W. INTERCEPTOR
LINES 1 & 2
R. W. LINN CITY ENGINEER
CITY OF WICHITA, KS.
PR. NO. DBKL 572025 DATE 7-72