NOTE: BENEFIT DISTRICT IS ALL LOTS IN WHEATLAND PLACE THIRD ADDITION.

N
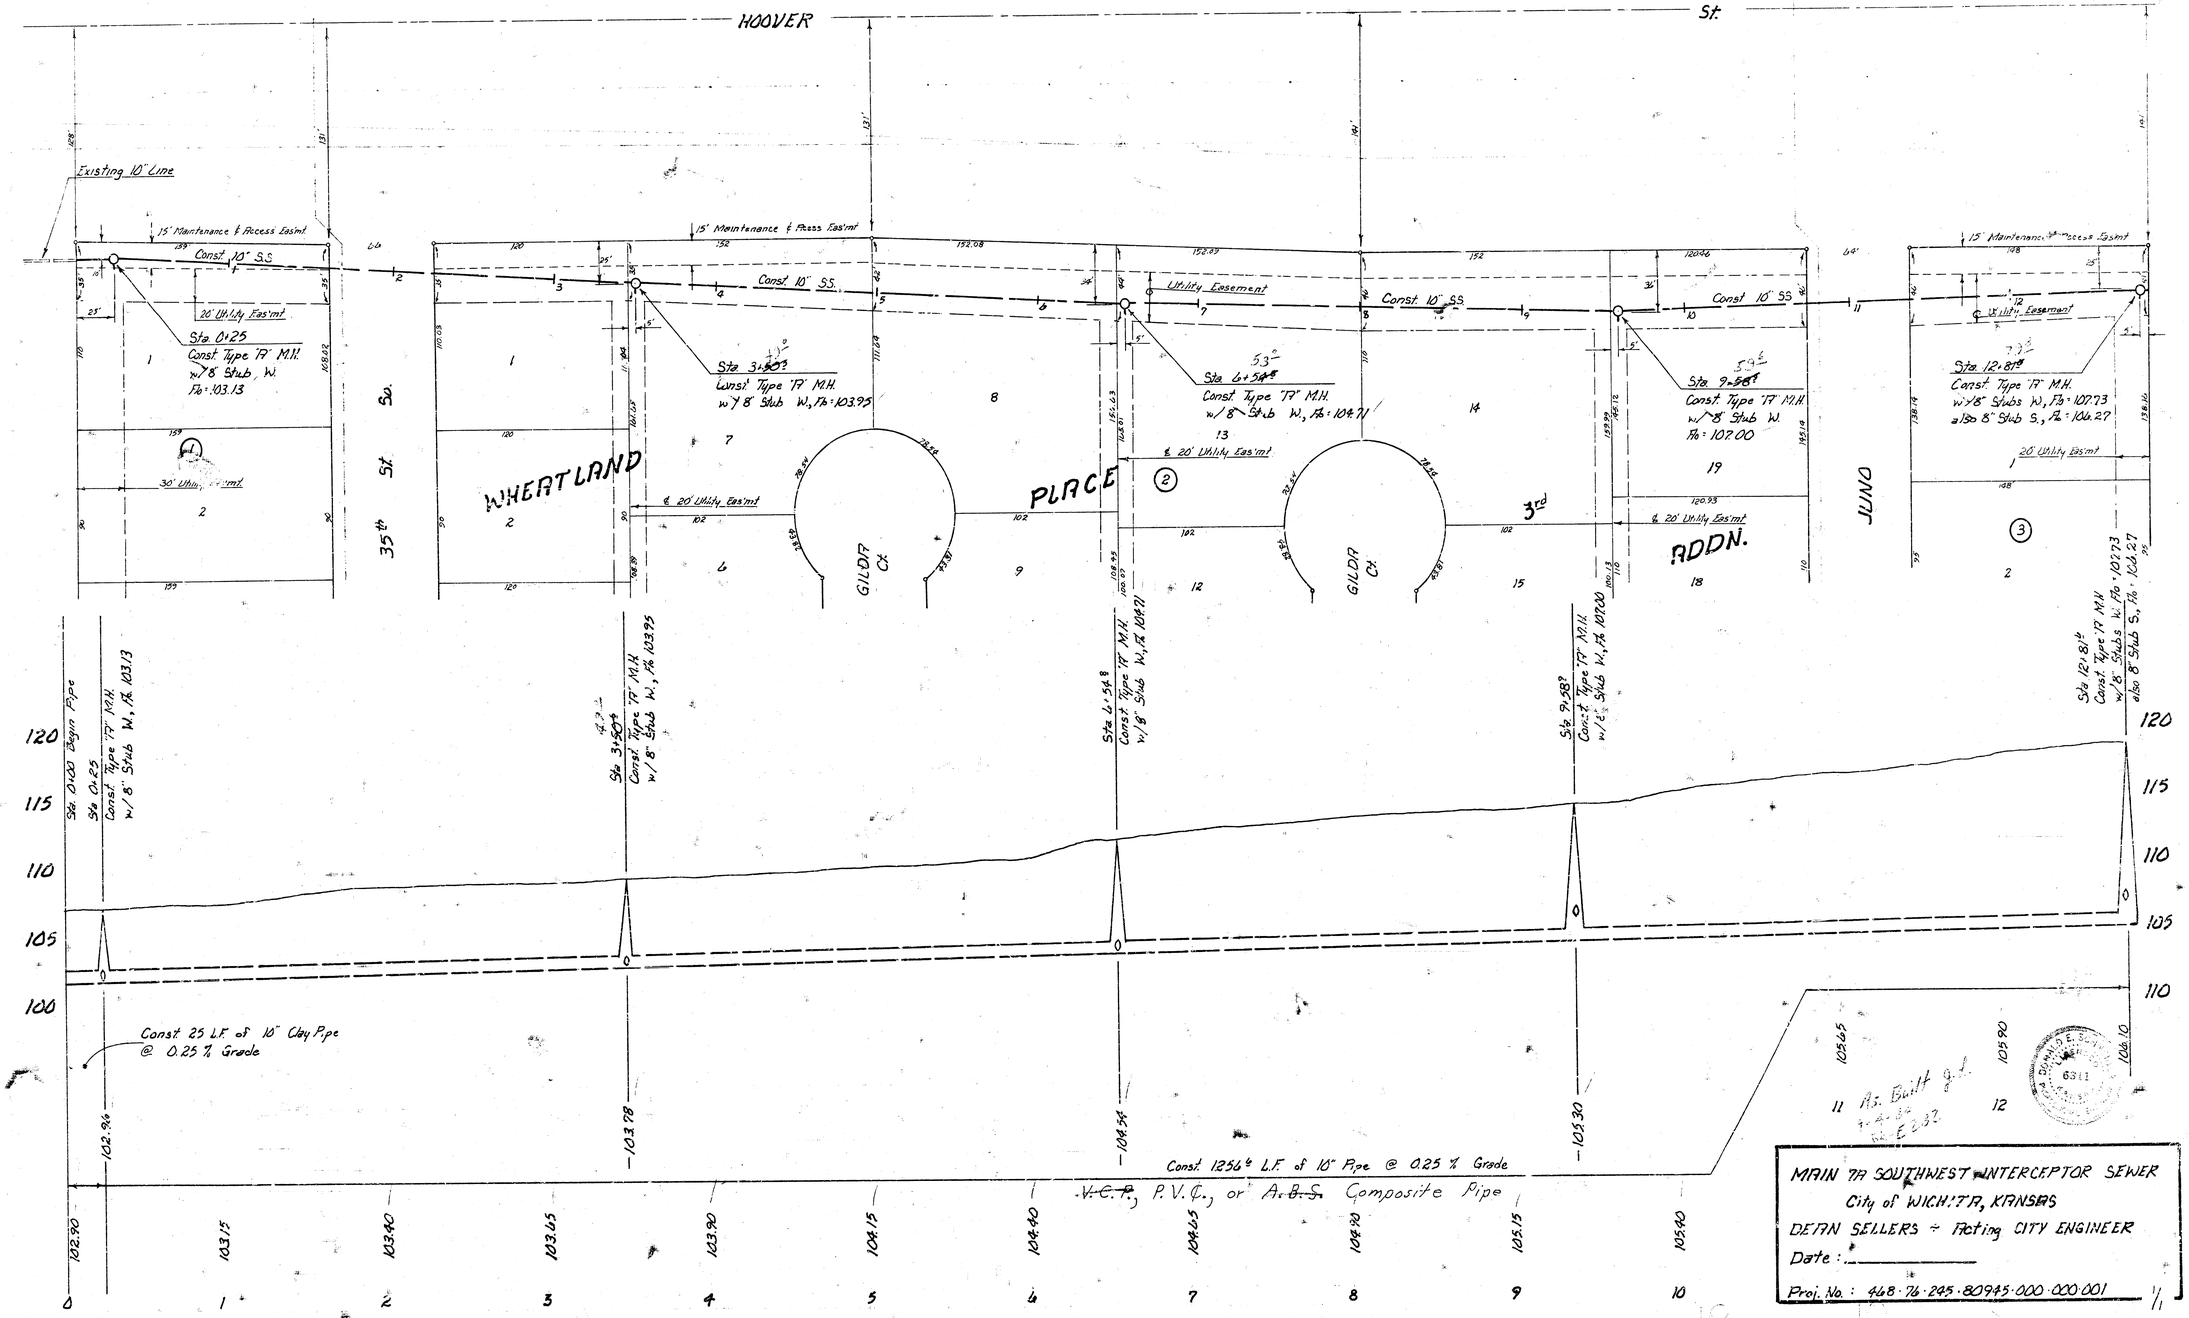
SCALE
Horz. 1" = 40'
Vert. 1" = 5'