

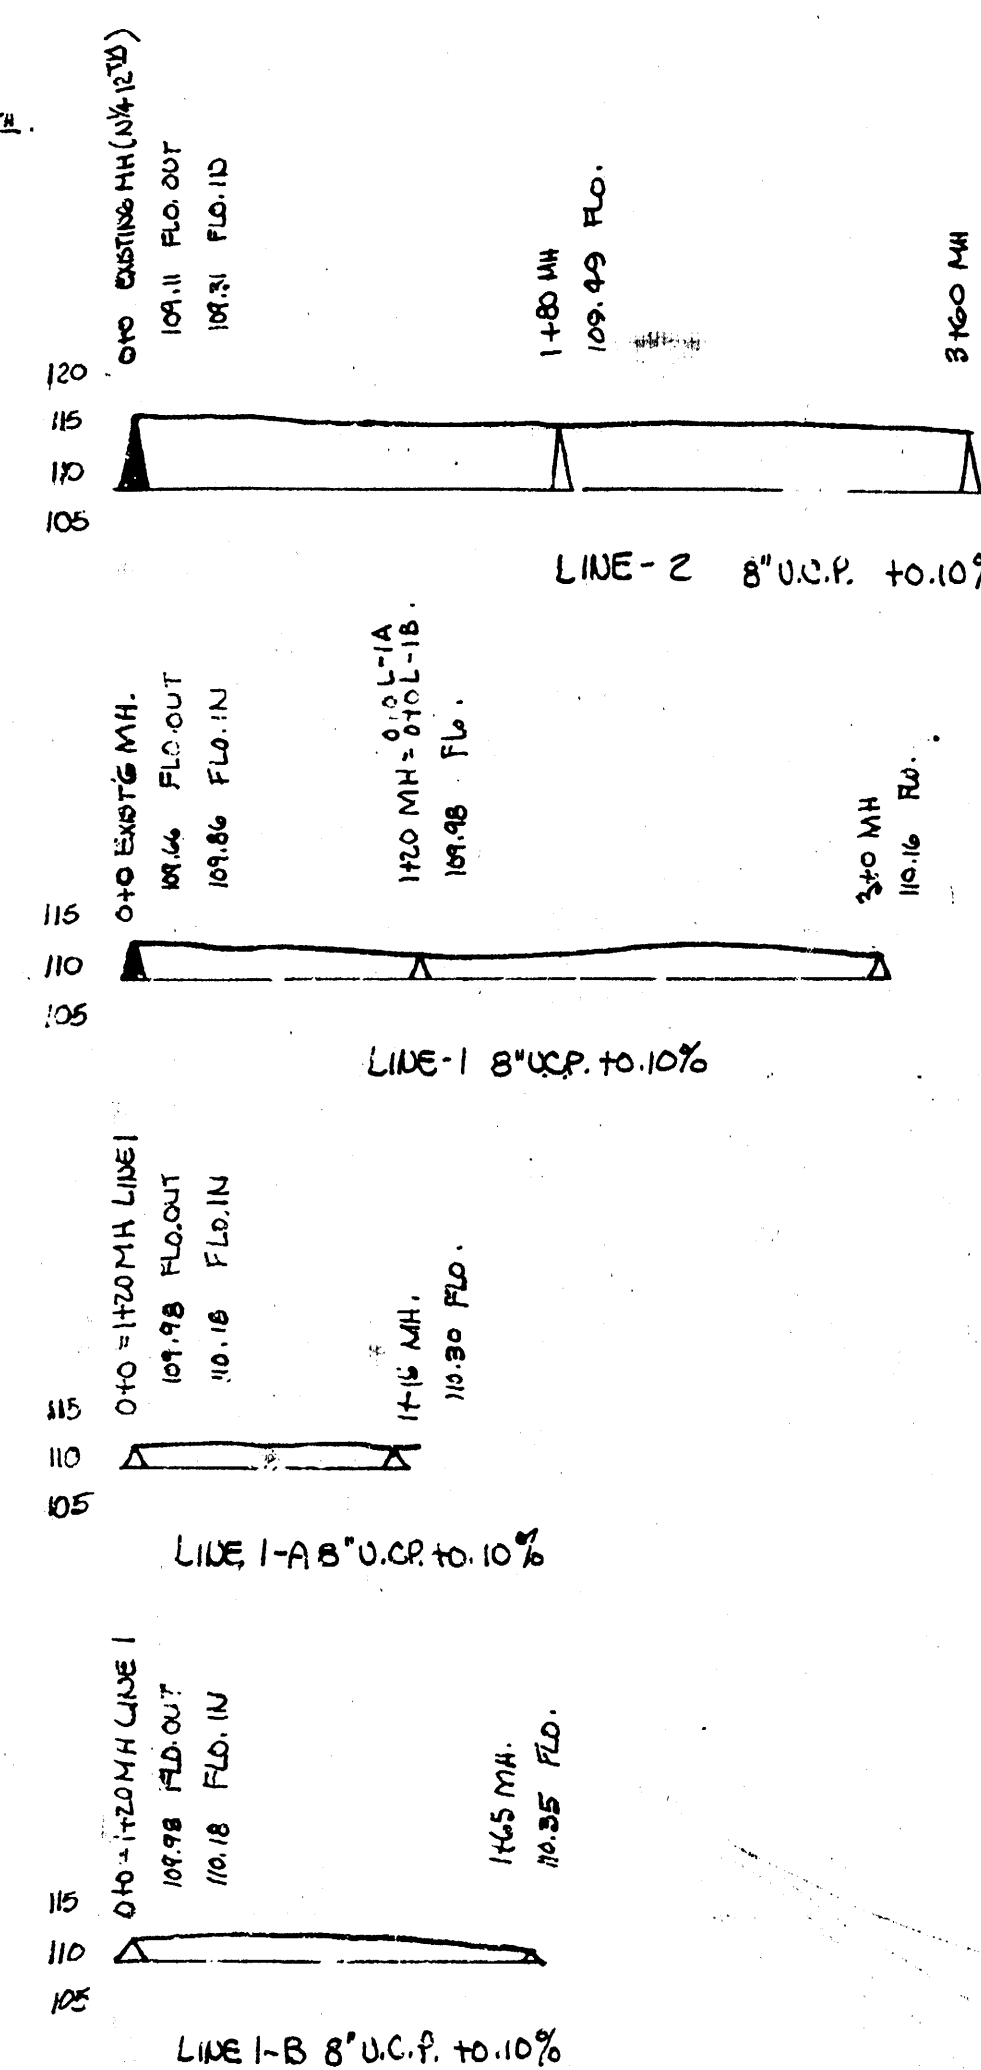
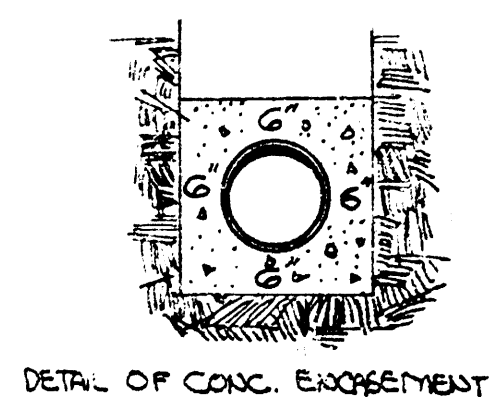


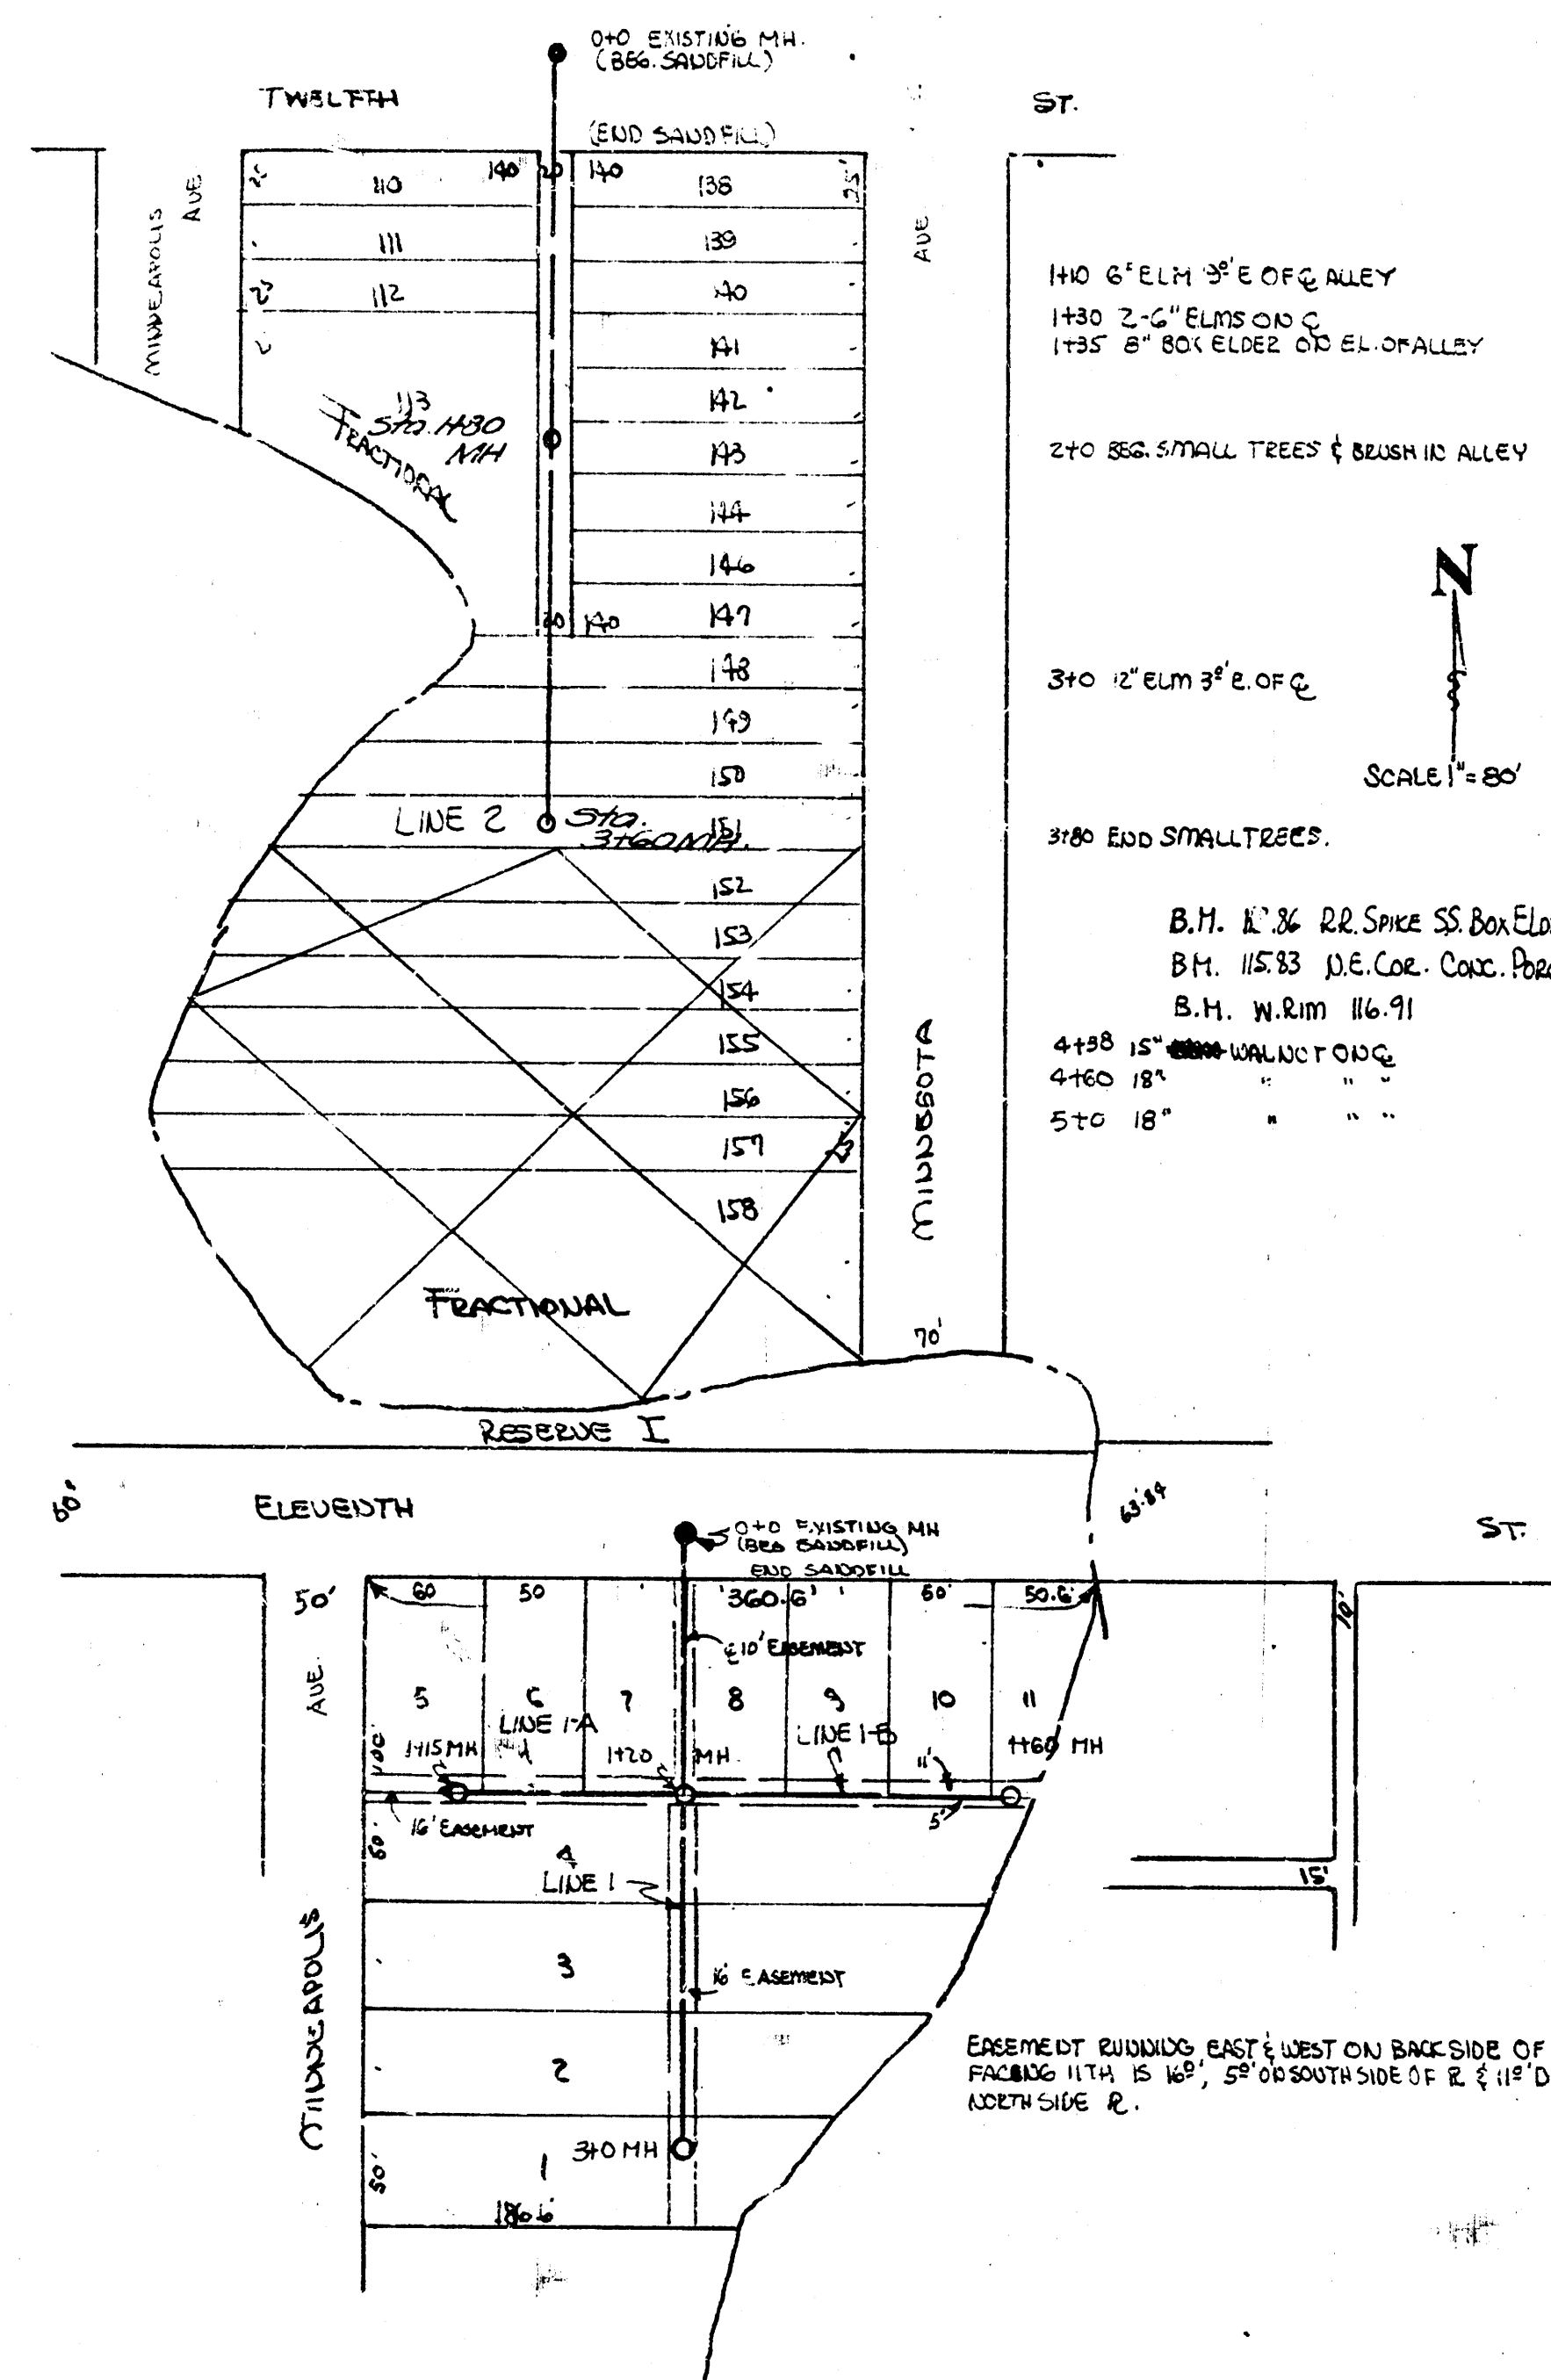

NOTE: ANY SEWER DITCH WITH LESS THAN 30" OF COVER IS TO BE CONCRETE EXPOSED.

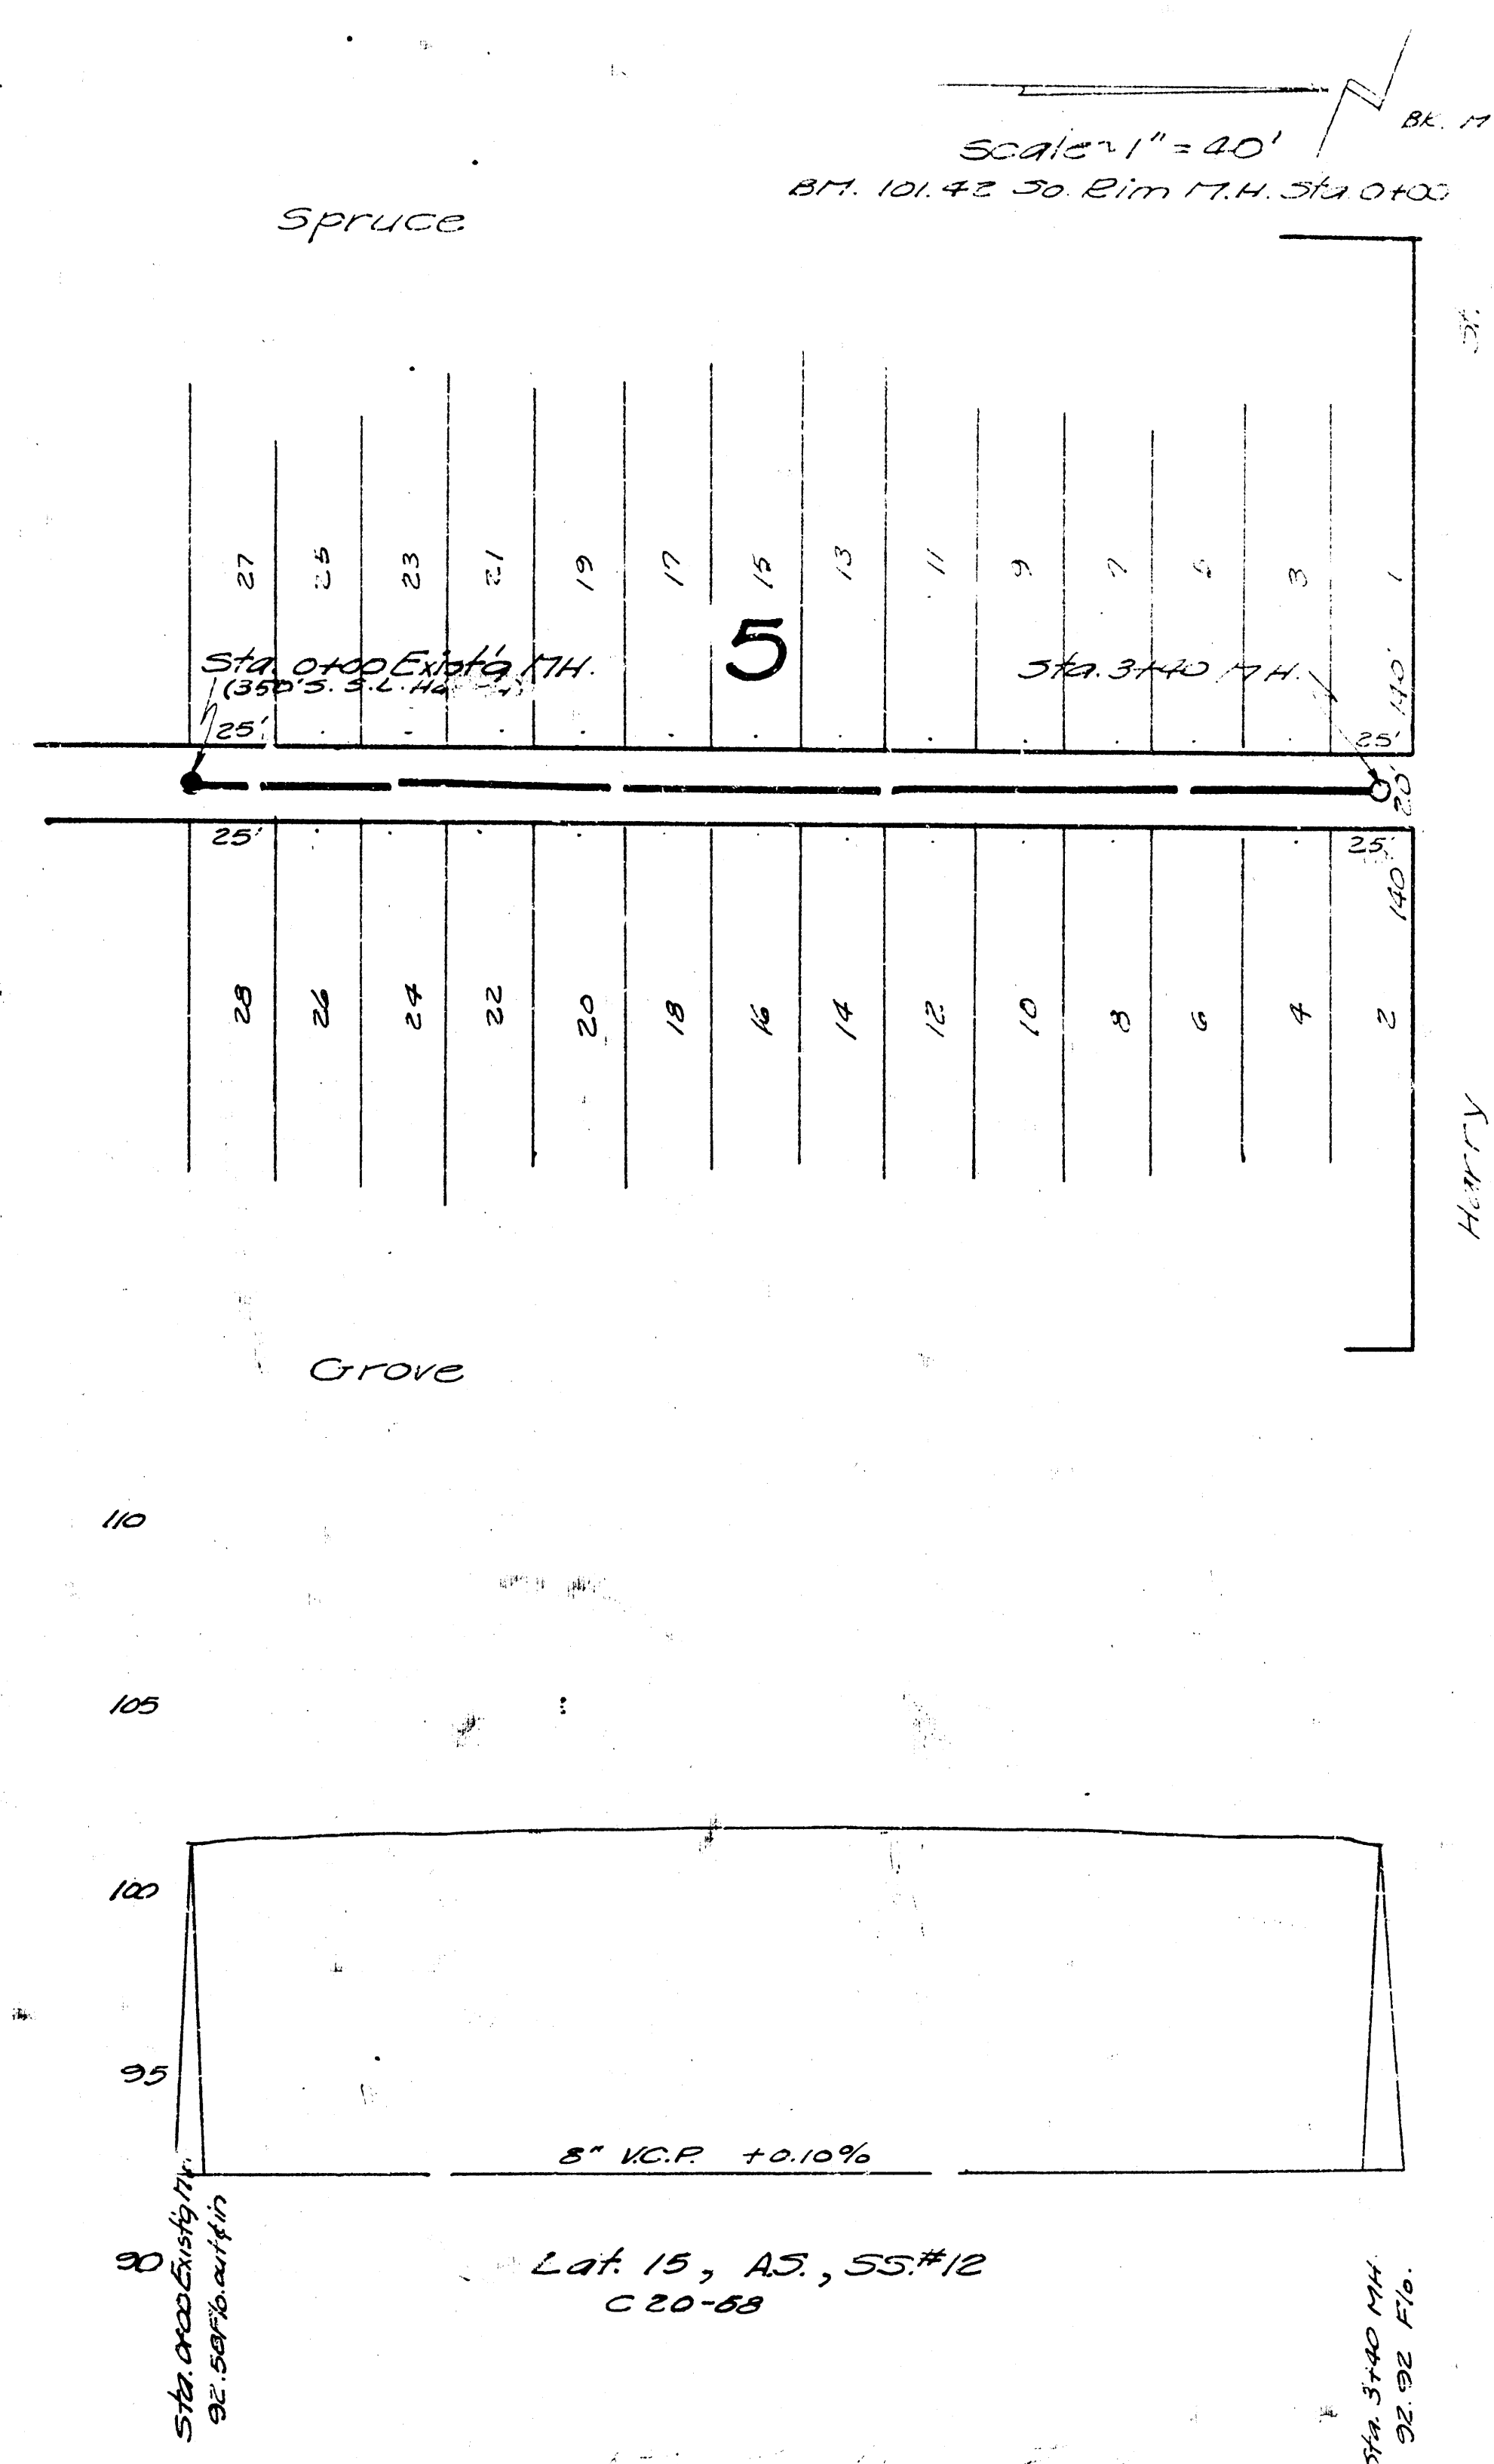

LAT. D, DIST. 7, SS #12
CITY OF WICHITA, KANSAS
ENGINEER'S DIVISION
L.K. WHITE ... CITY ENGINEER
DATE: 8-17-50 PROJ. NO. C20-56