



SCALE 1"=100'

SCHRECKS ADDITION

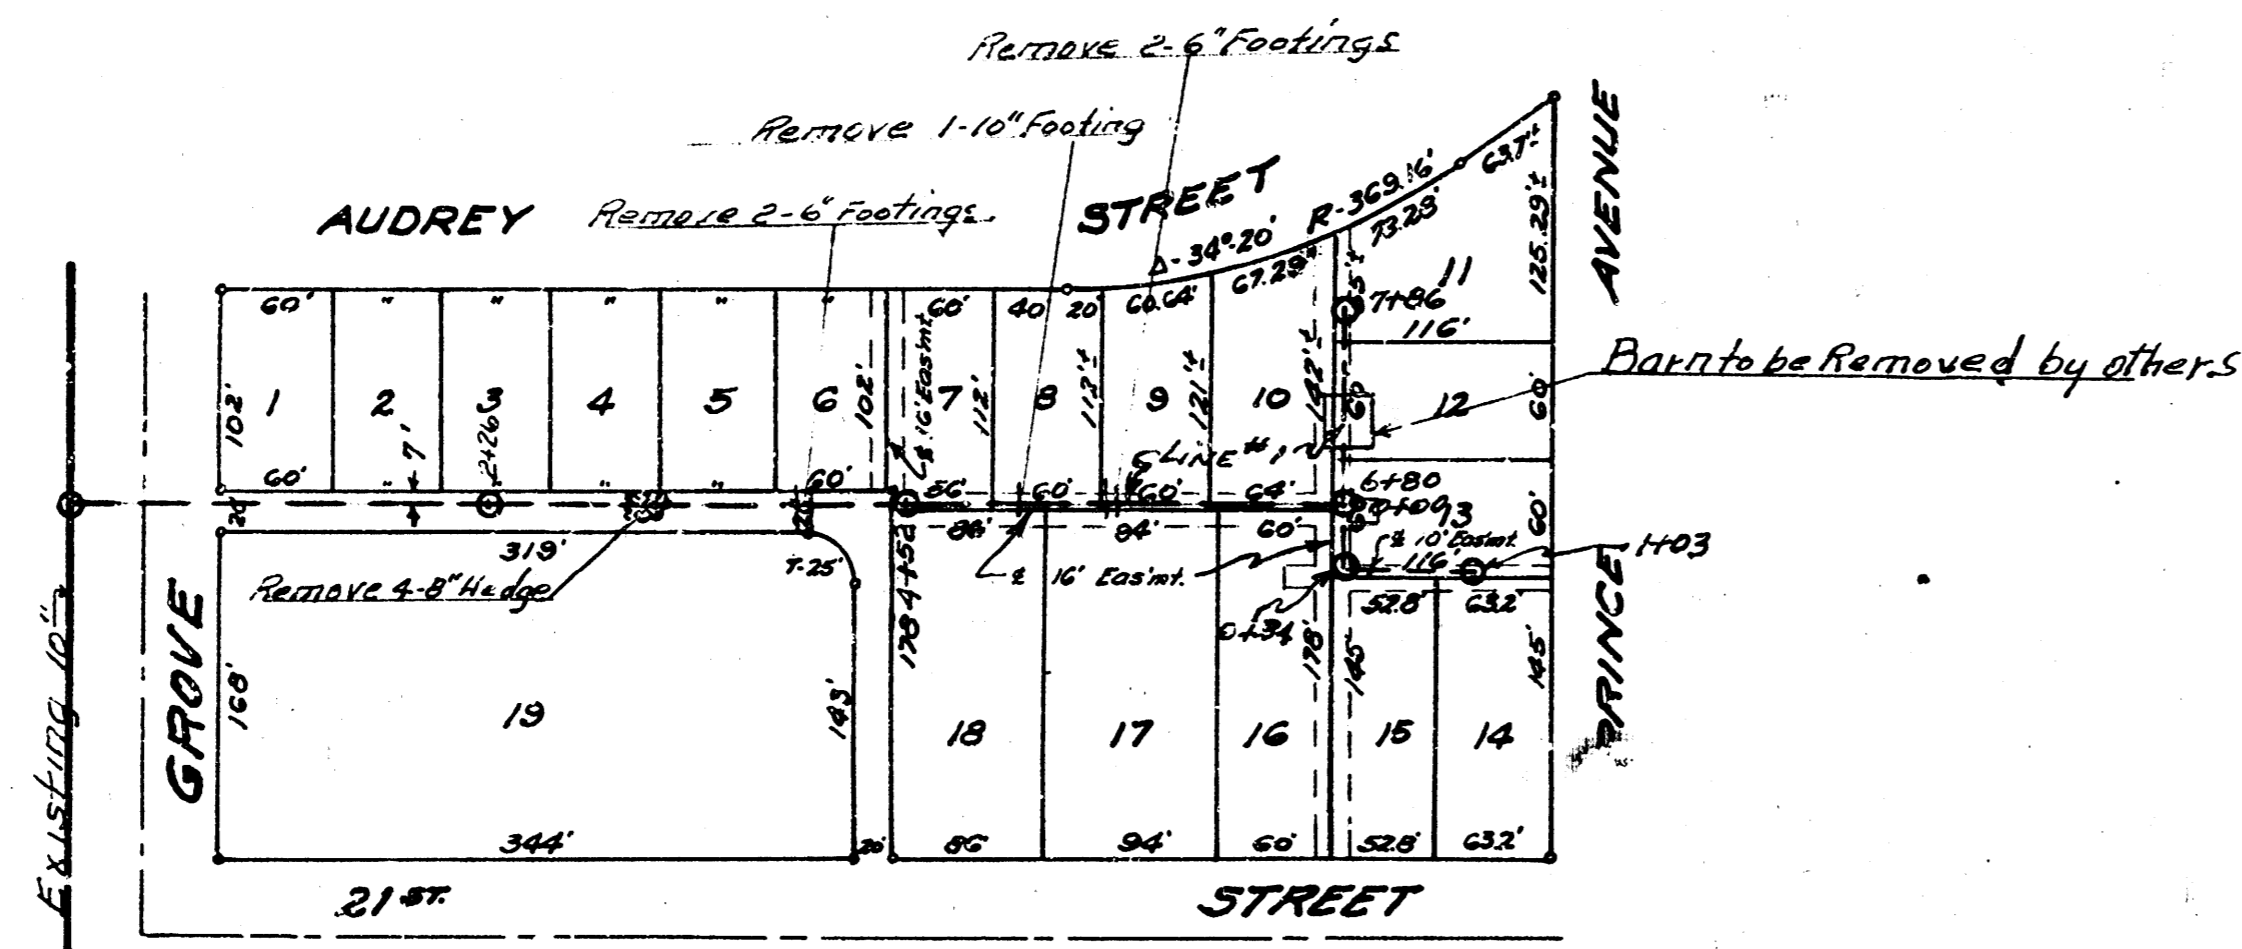

Sand backfill trench
Sta 0+09 to Sta 0+55

SCHOOL HOUSE

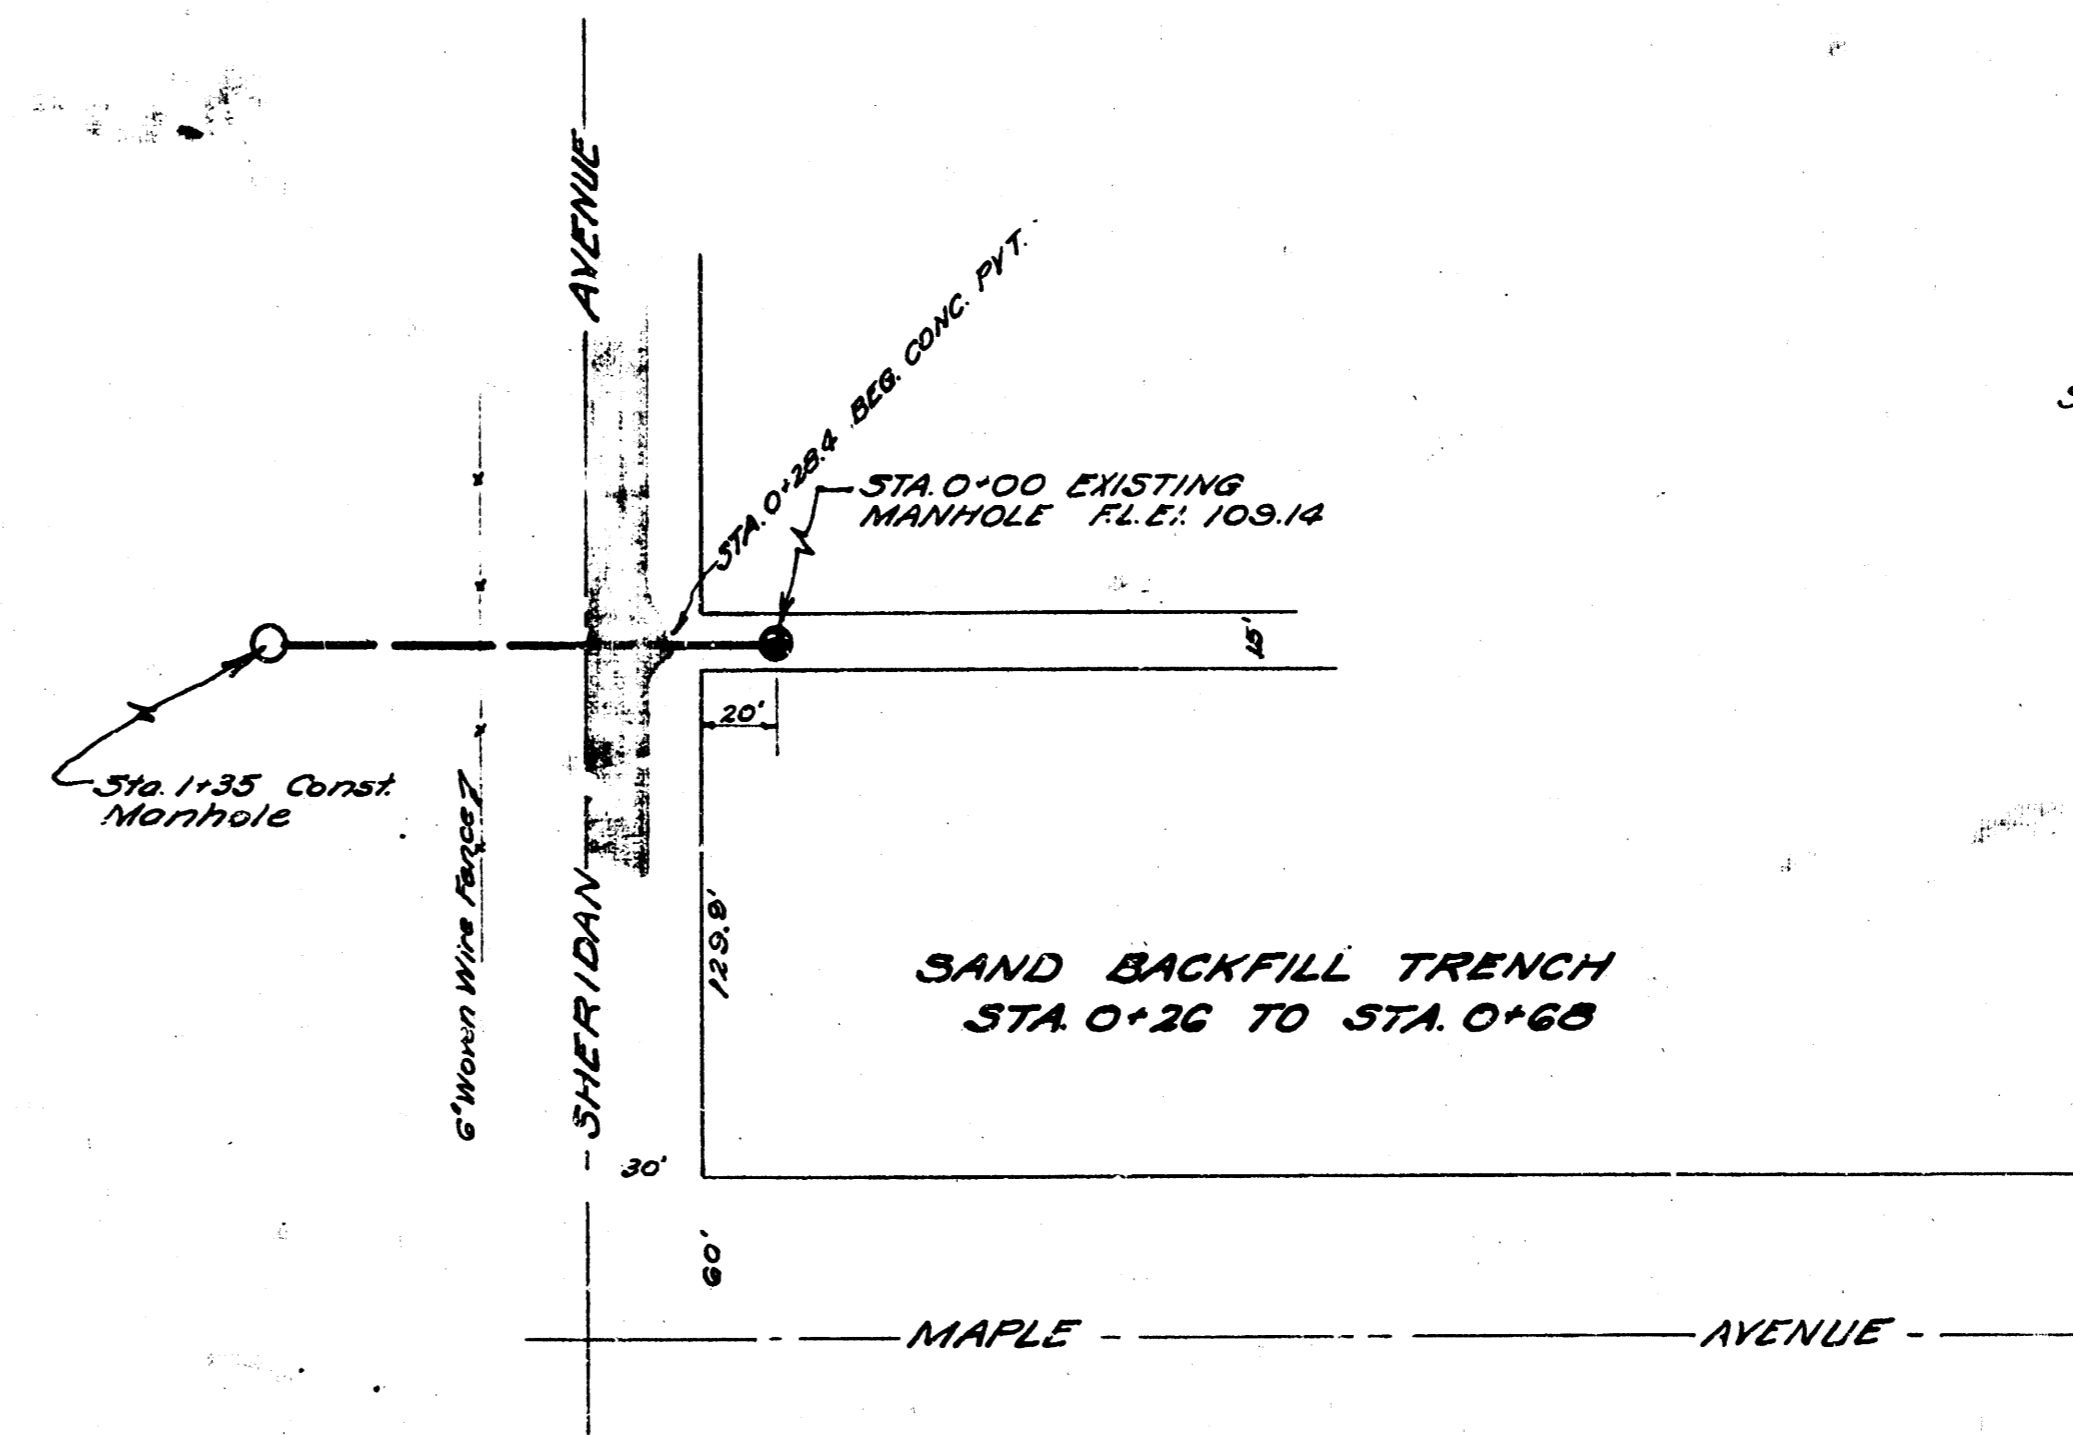


SCALE 1"=50'

B.M. 133.84 5" Rim MH No. 0+00


B.M. 133.55 'G' in Globe E. cb. of Grove
S.L. 21.8' No. End 40' Radius

B.M. 'G' in Globe E.S. Int. Square
walk NE Cor. Maple & Sheridan E.I. 113.60

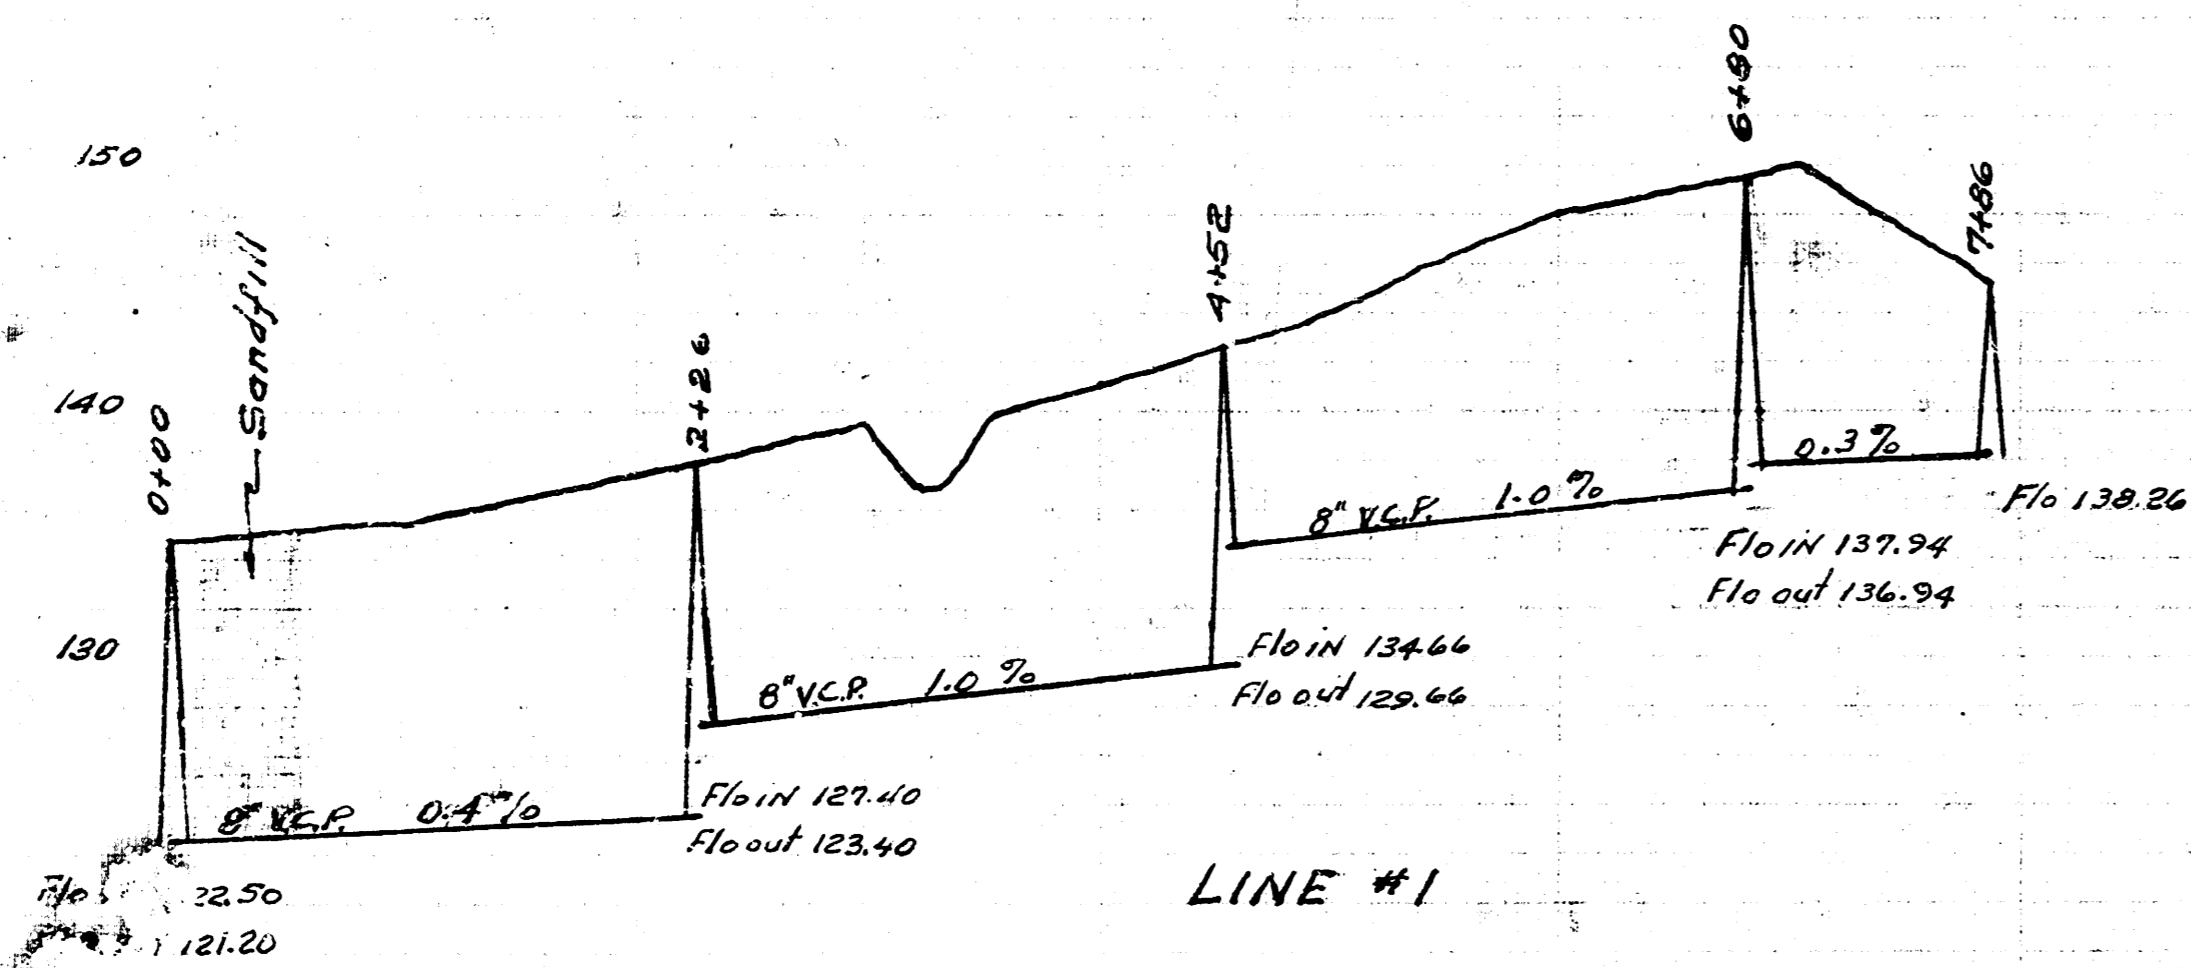


LINE #1

Scale: 1/2"=80' Horiz.
1"=4' Vert.

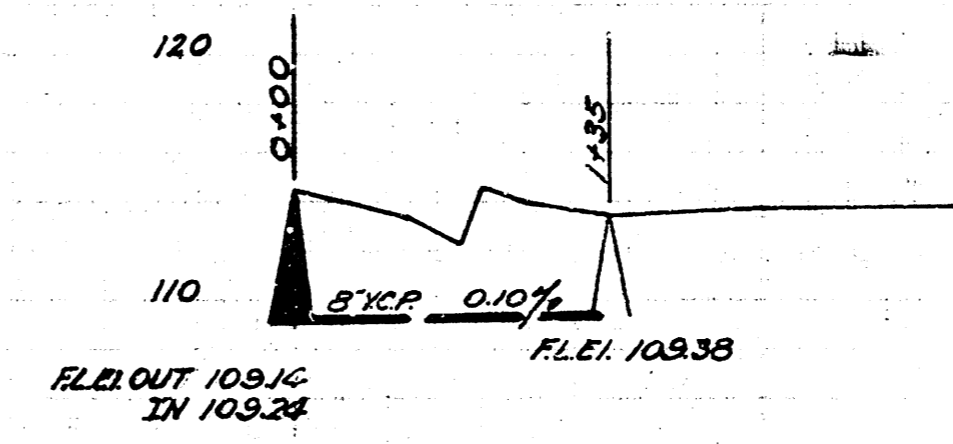

SCALE 1"=80' Horiz.
1"=8' Vert.
NOTE BOOK NO. JF. 61

1-7-52
 Drawn by
 LHM, RLLA
 Checked by
 Note Book No.
 M-17

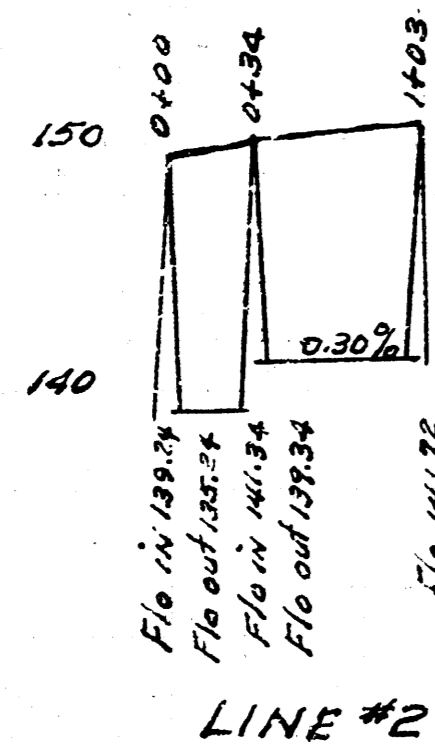

LINE #2



LAT 1 DIST 13 SS #12
 CITY OF WICHITA KANSAS
 L.K. WHITE CITY ENGINEER
 Proj. No. C21-75