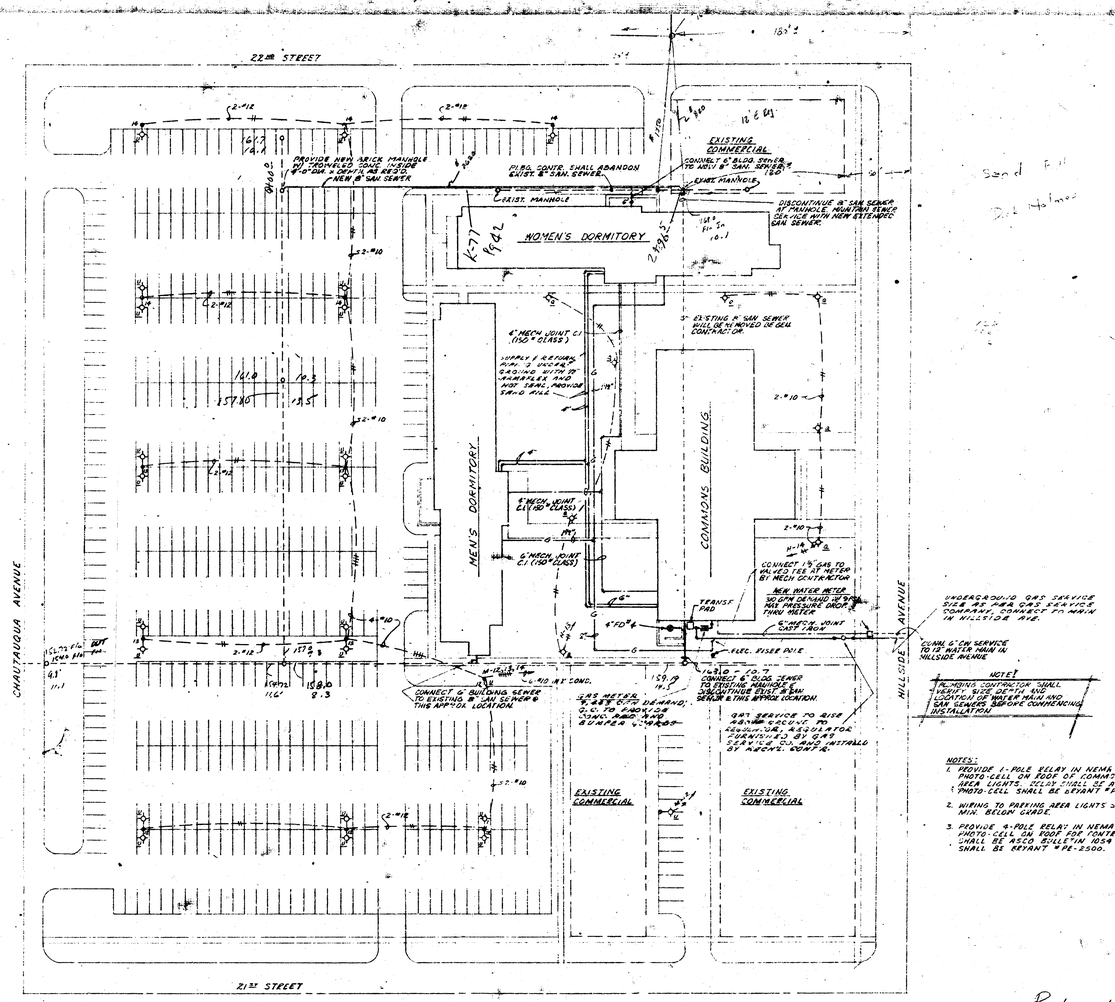

SITE PLAN

SCALE 1" = 40'-0"

Relocation of a part of Lot 3, Dist 13 # 12

Booker
Gr-17d
Blk K-77

DORMITORY COMPLEX FOR WICHITA STATE UNIVERSITY	McGEHEE & NICHOLSON ARCHITECTS 2600 POPLAR AVE. MEMPHIS, TENN.	SITE PLAN	MPE