


Date 2-18-59  
 Drawn by M.C.C.  
 Checked by C.B.M.  
 27-55' L&M M.L.S.

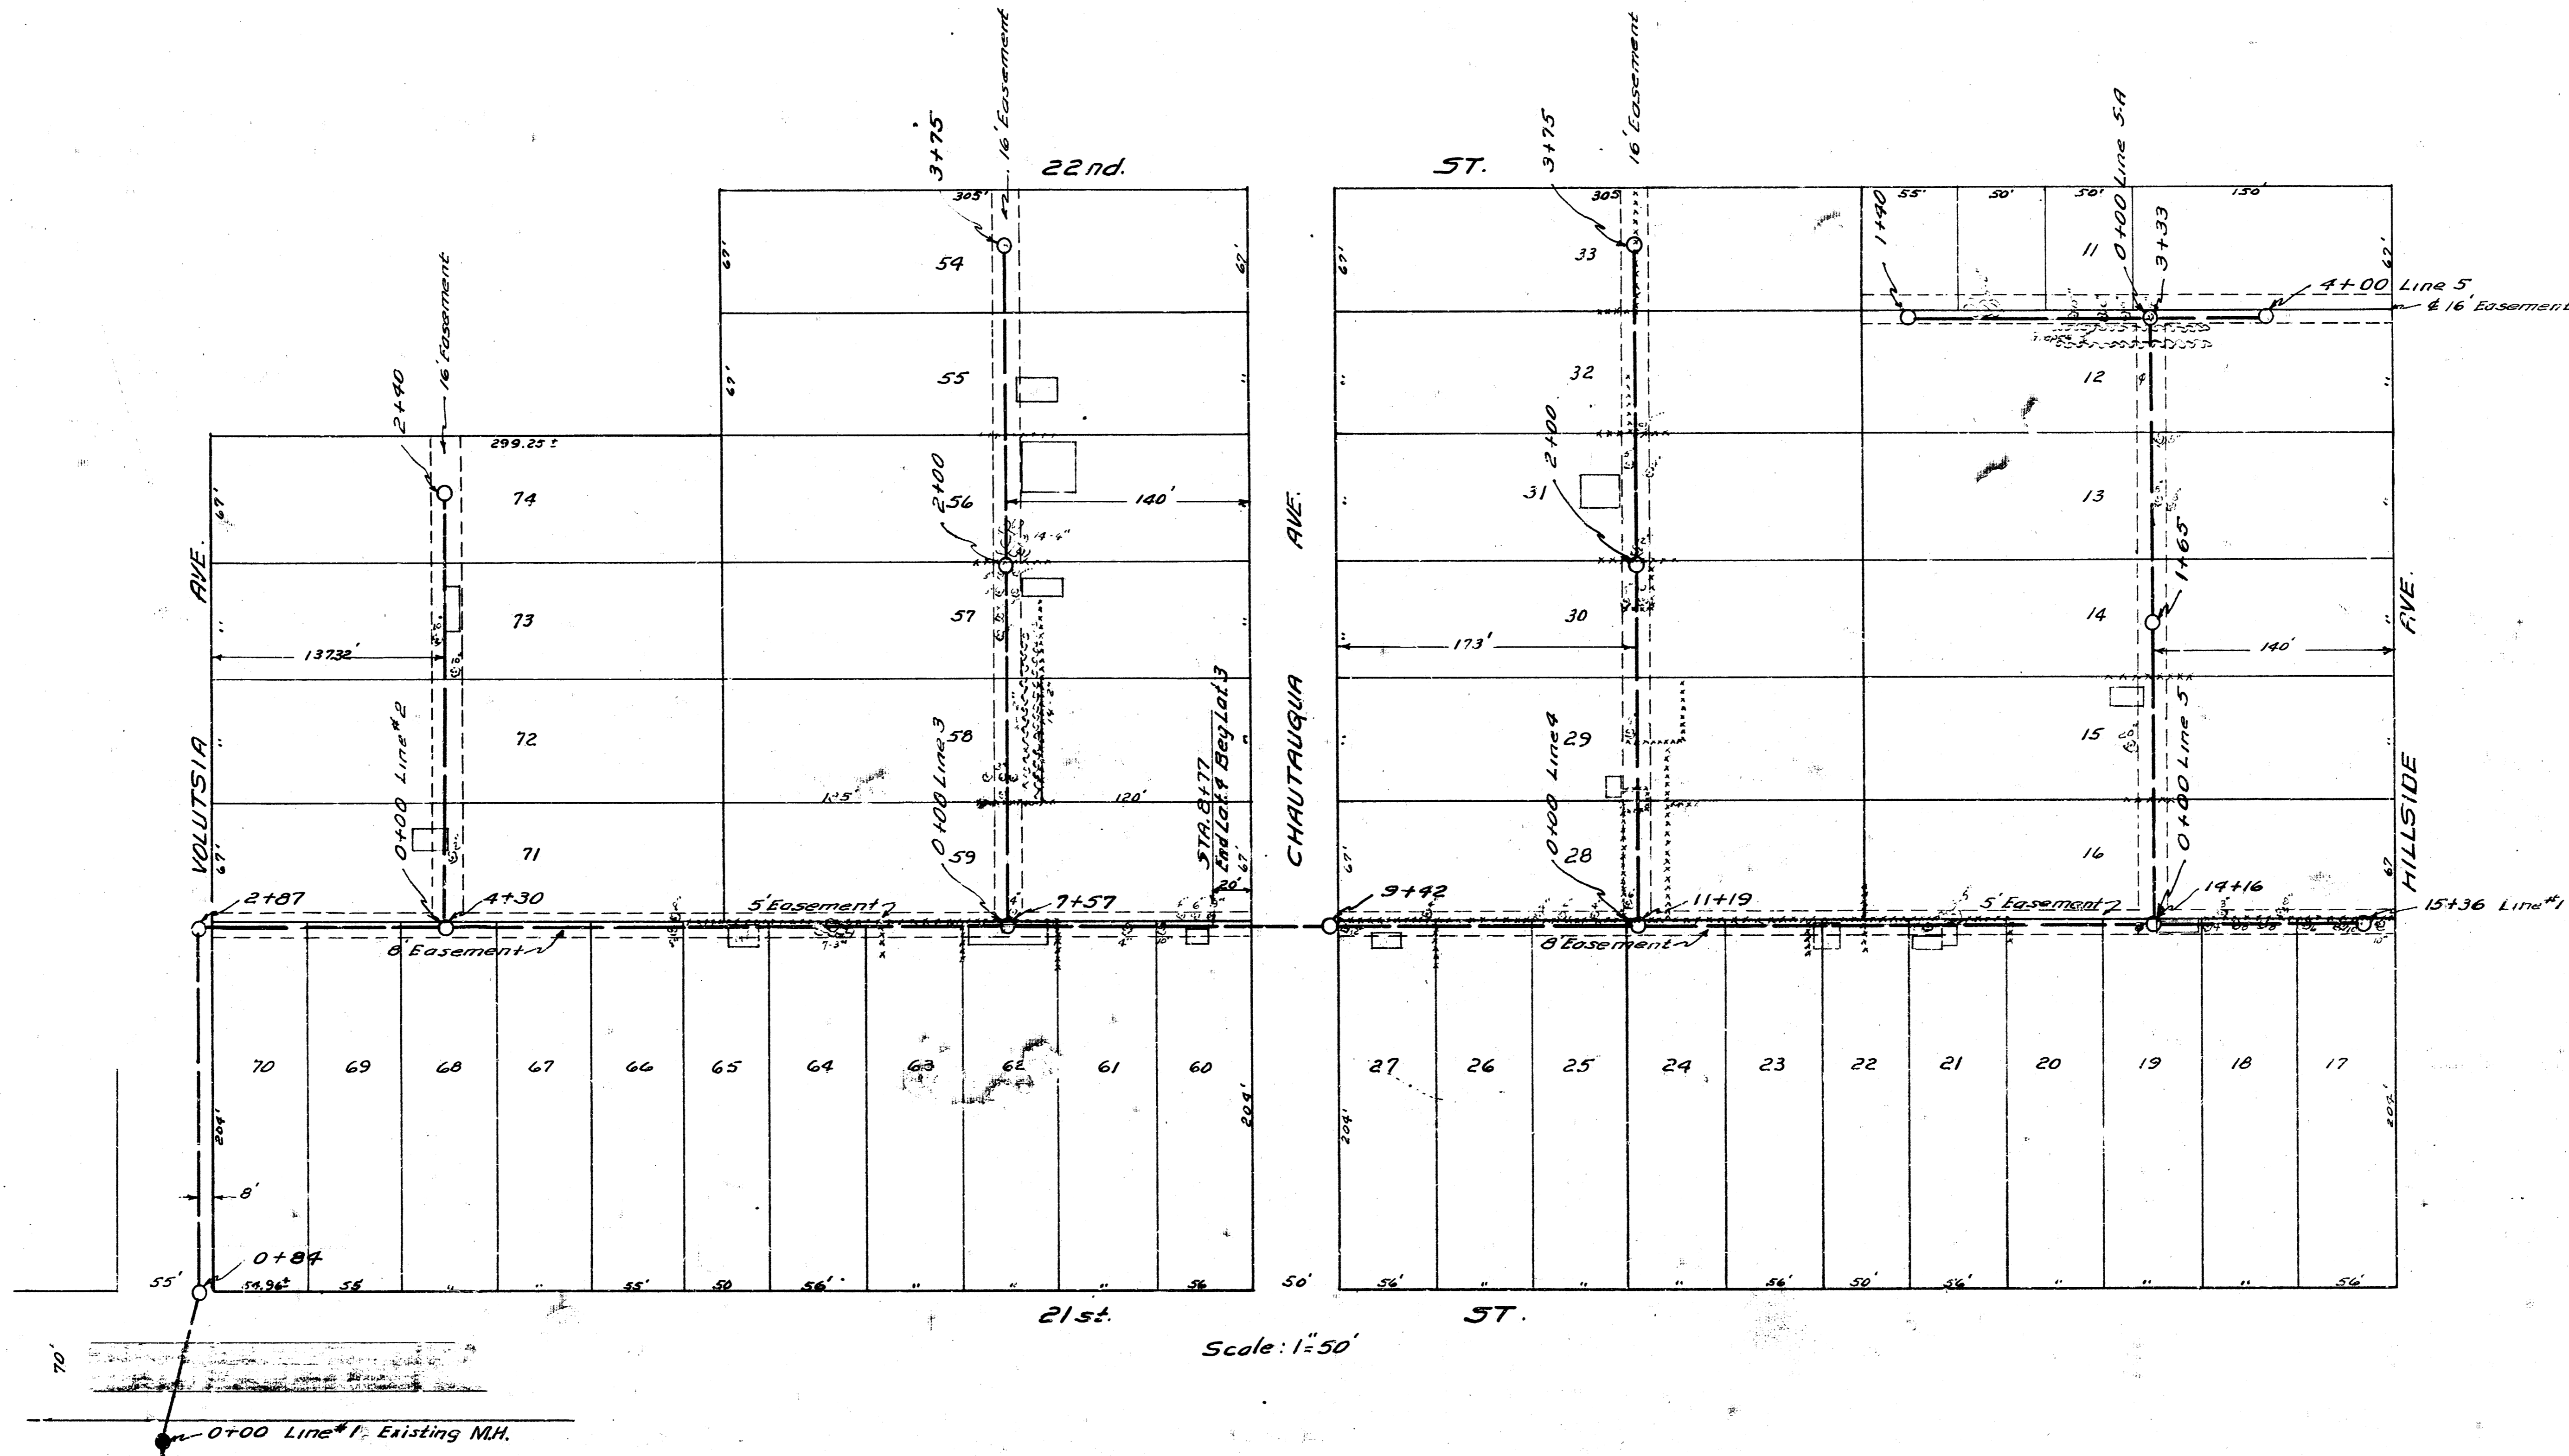


Scale: 1"=50'

LAT. 4 DIST. 13 SS. 12  
 CITY OF WICHITA KANSAS  
 B.E. SMITH CITY ENGINEER  
 Proj. No. C-22-60

LAT. 3 DIST. 13 SS. 12  
 CITY OF WICHITA KANSAS  
 B.E. SMITH CITY ENGINEER  
 Proj. No. C-22-45

Date 2-18-54  
 Drawn by McClain  
 Checked by [unclear]  
 228-4284-11 SS - JHK Misc

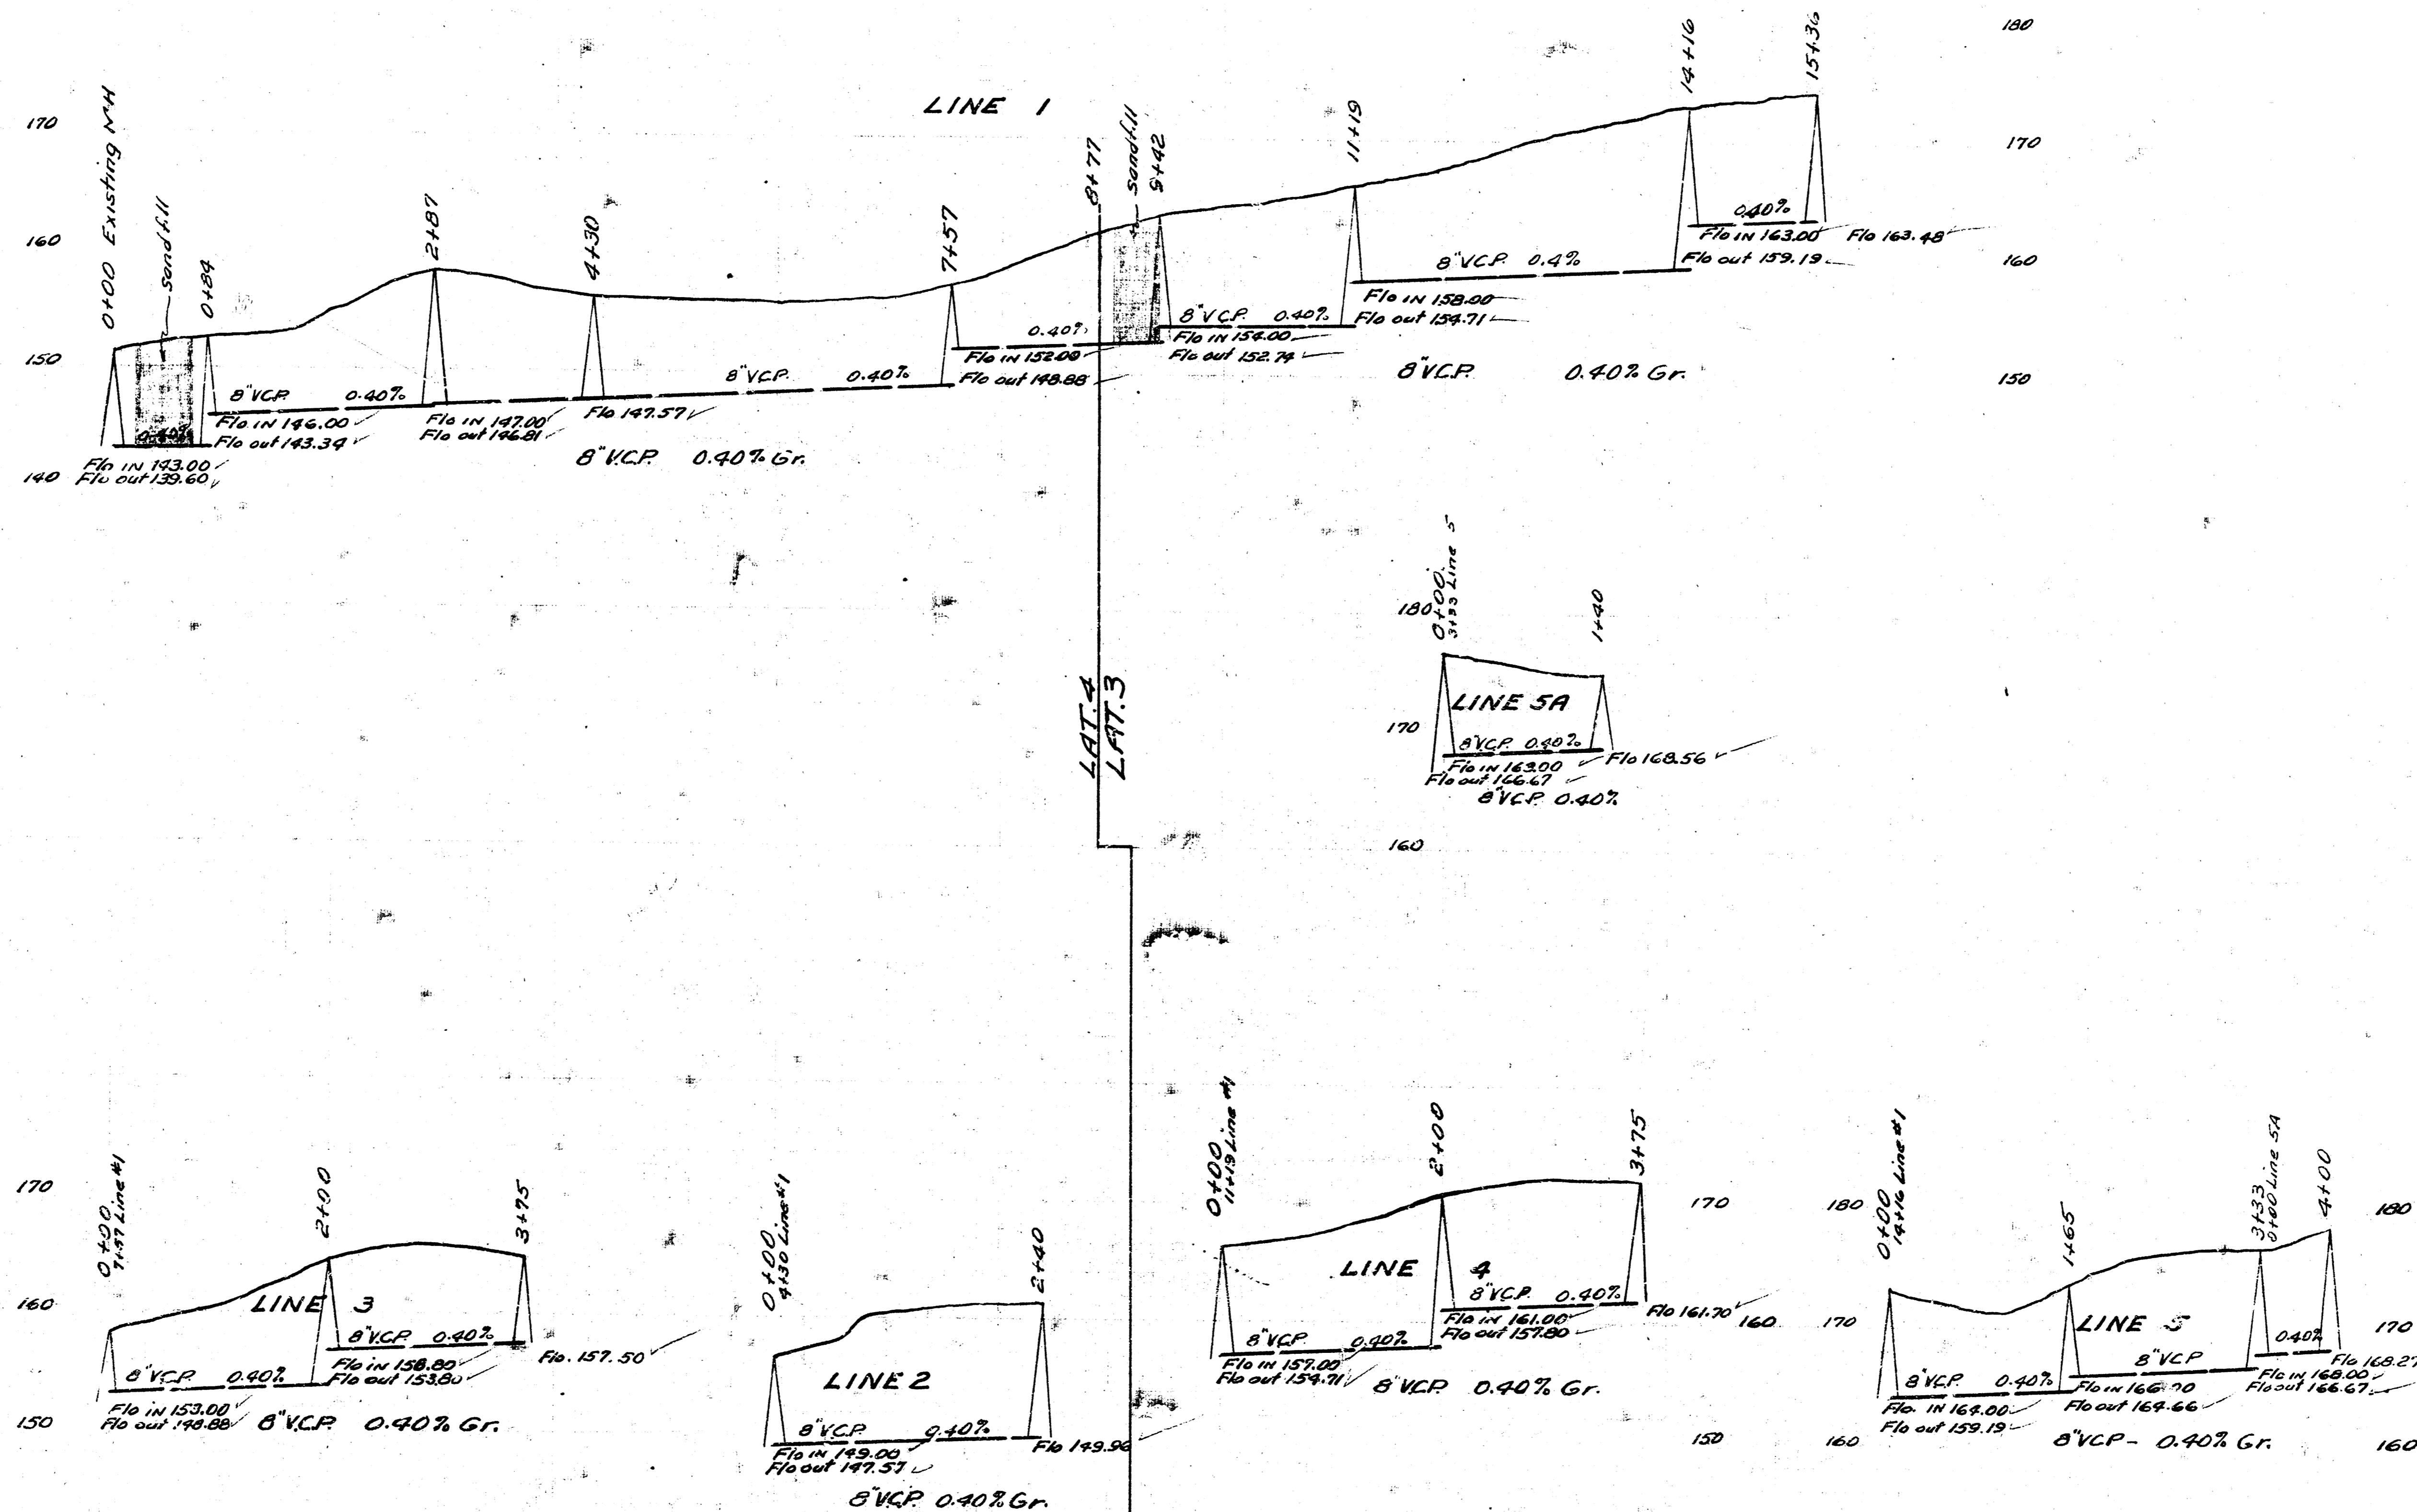

LAT. 4 DIST. 13 S.S. 12  
 CITY OF WICHITA KANSAS  
 B.F. SMITH CITY ENGINEER  
 Proj. No. C-22-60

LAT. 3 DIST. 13 S.S. 12  
 CITY OF WICHITA KANSAS  
 B.F. SMITH CITY ENGINEER  
 Proj. No. C-22-45