



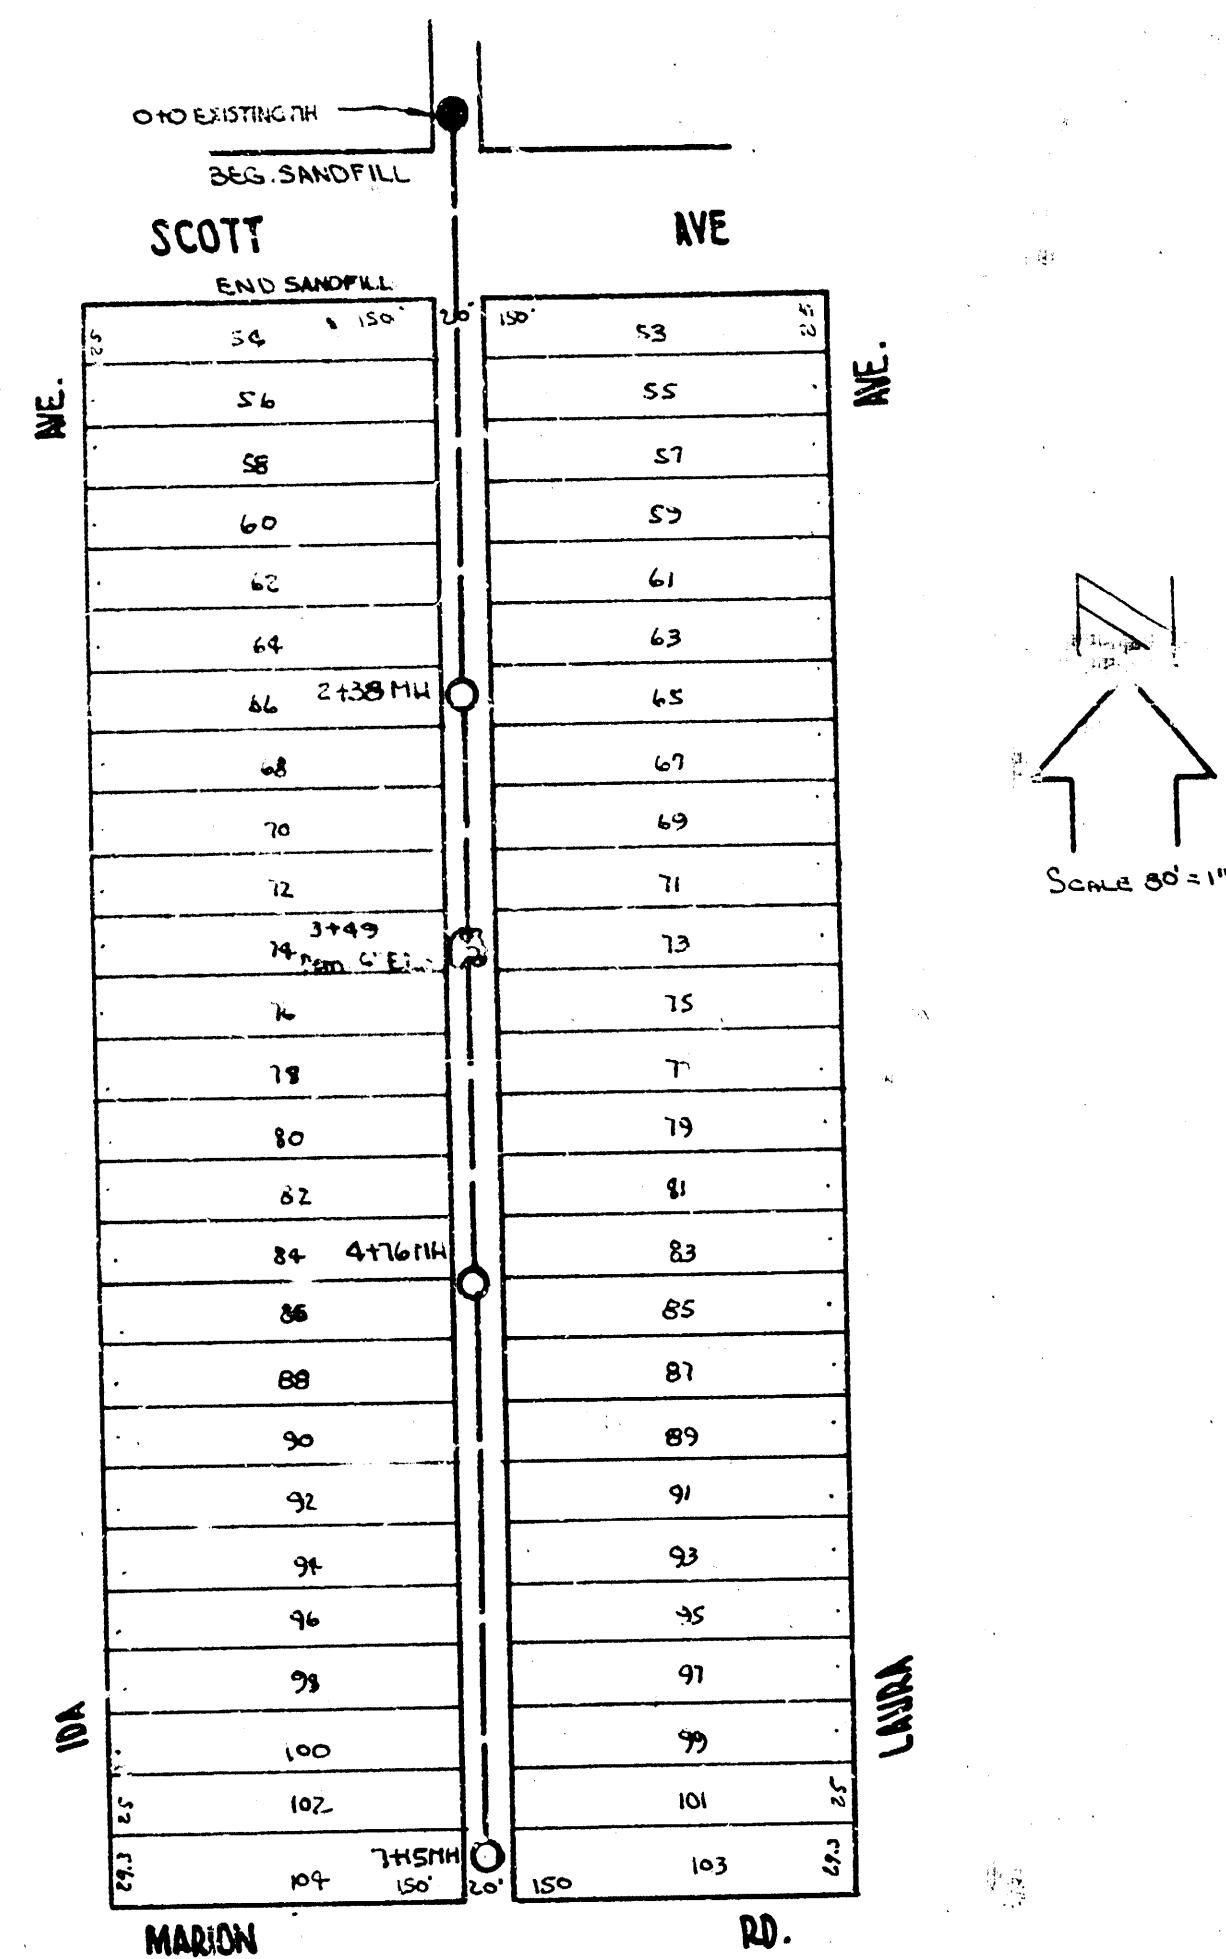


LAT. 14, DIST. R, SS*20

Bk. 76.34 E. Sub. Pk. 50. Sub. Scott (Sphinx in Base of Rd.)

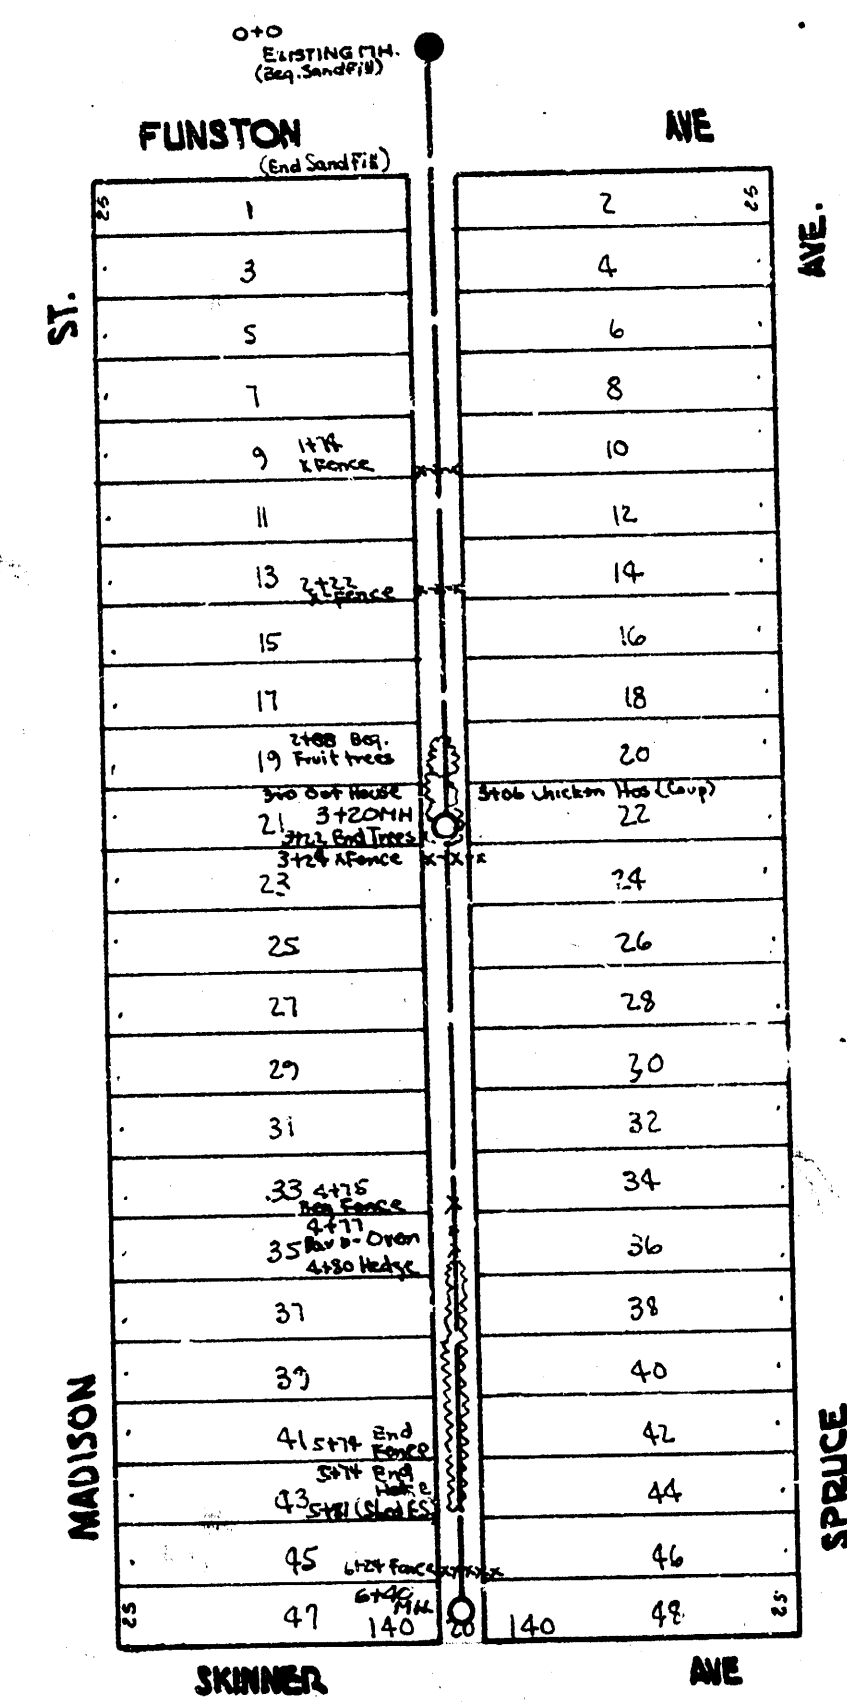


LAT. 10, DIST. AS, SS*12

Bk. 79.25 "G" in Guide So. End. N. 46. Spruce & Funston

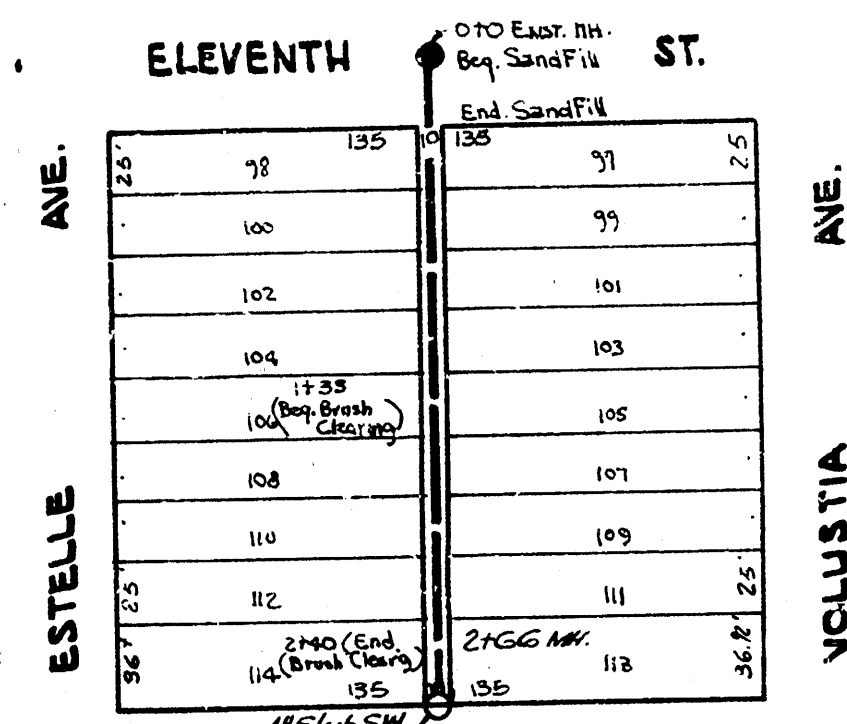


LAT. 12, DIST. E, SS*12

Bk. 12.11 No. 21m 114 in Eleventh Street.

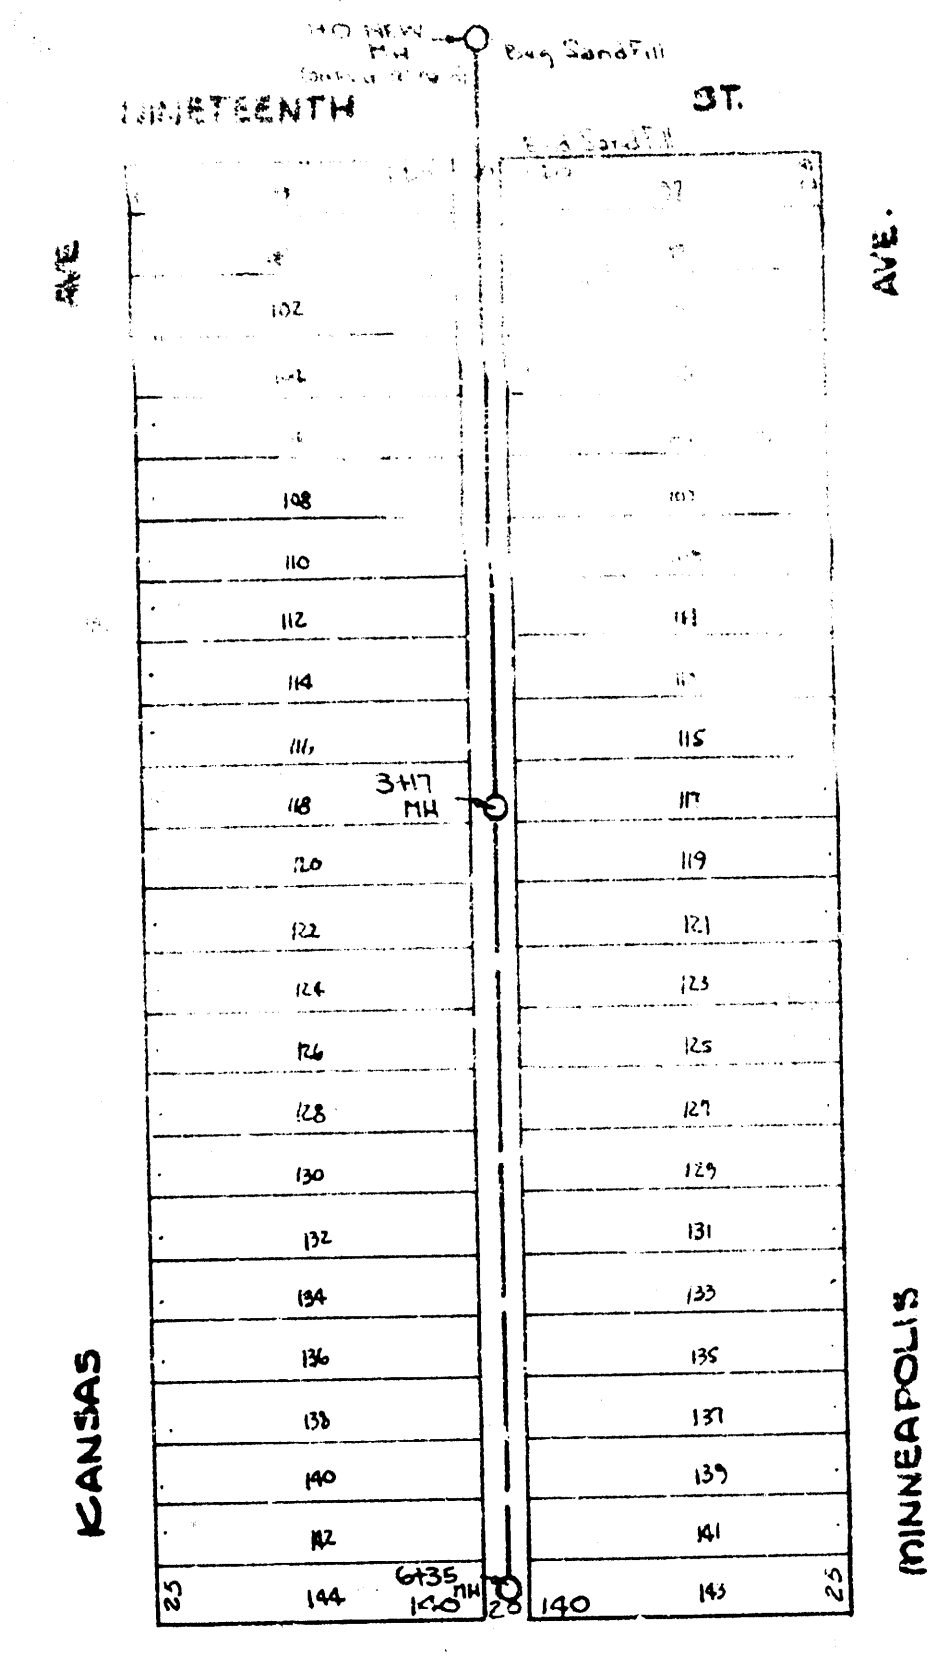


LAT. 17, DIST. T, SS*12


Bk. 120.23 No. 7m of So. Spruce 1914 Hydraulic

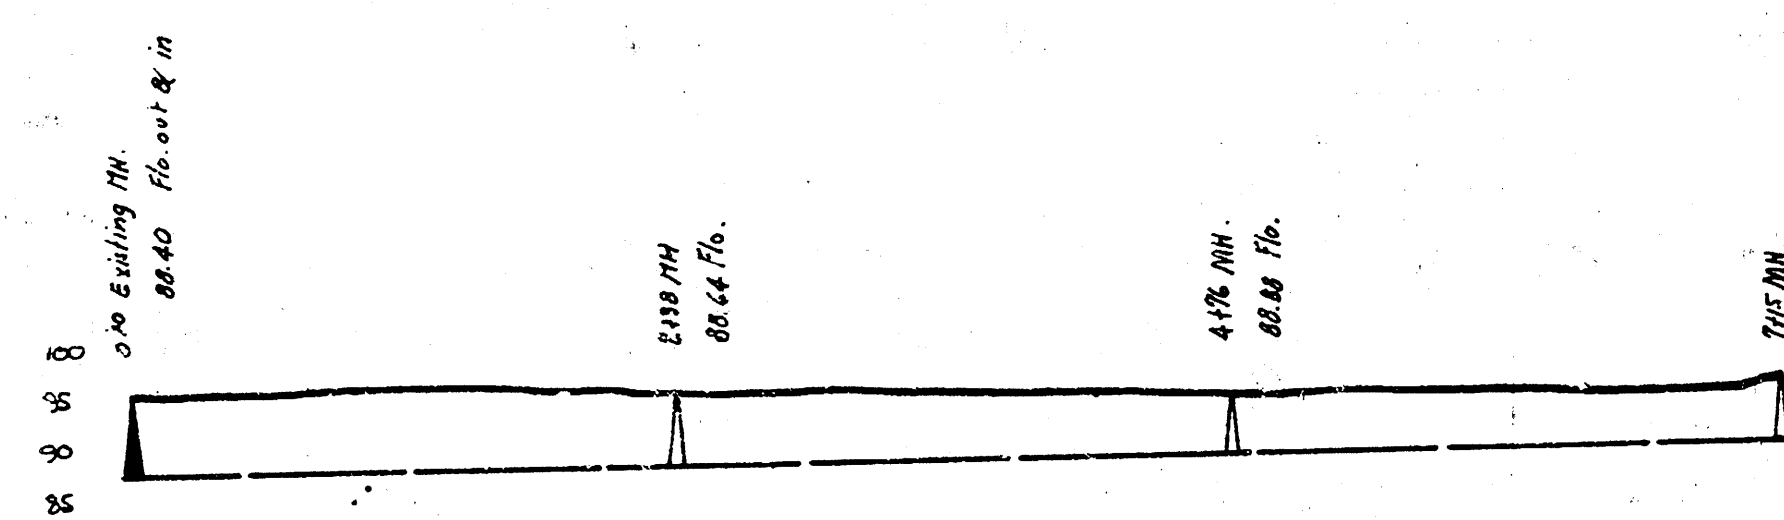


LAT. 14, DIST. R, SS*20

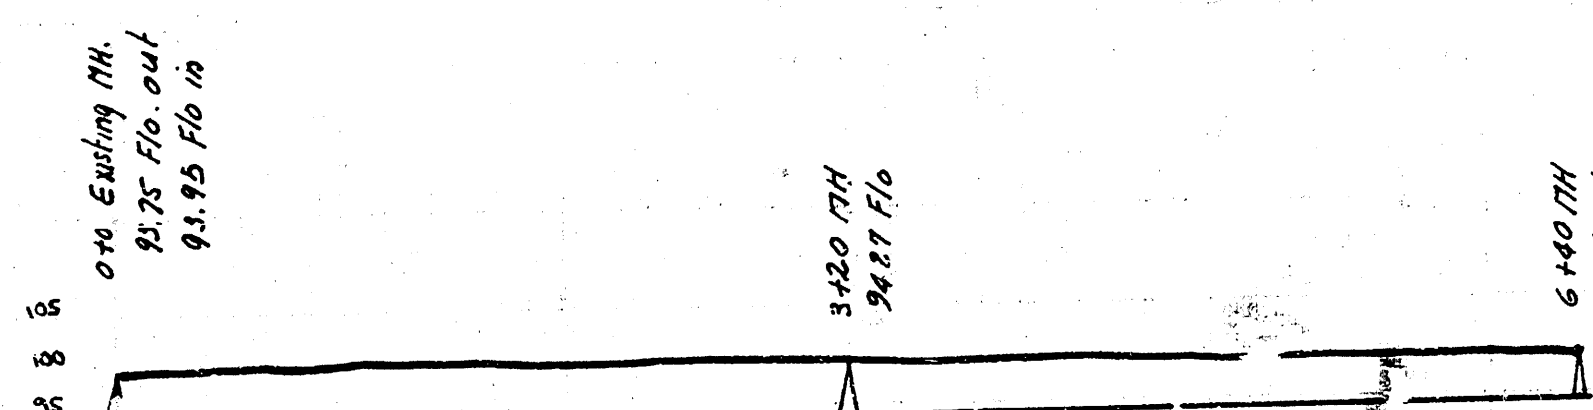

LAT. 10, DIST. AS, SS*12

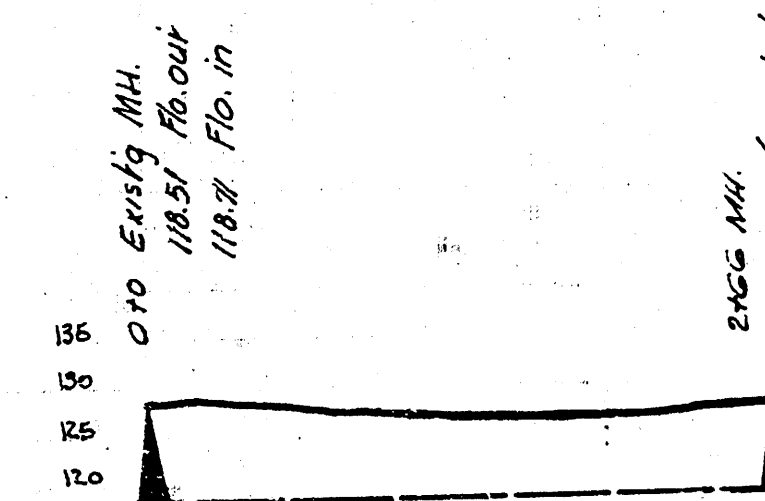

LAT. 12, DIST. E, SS*12

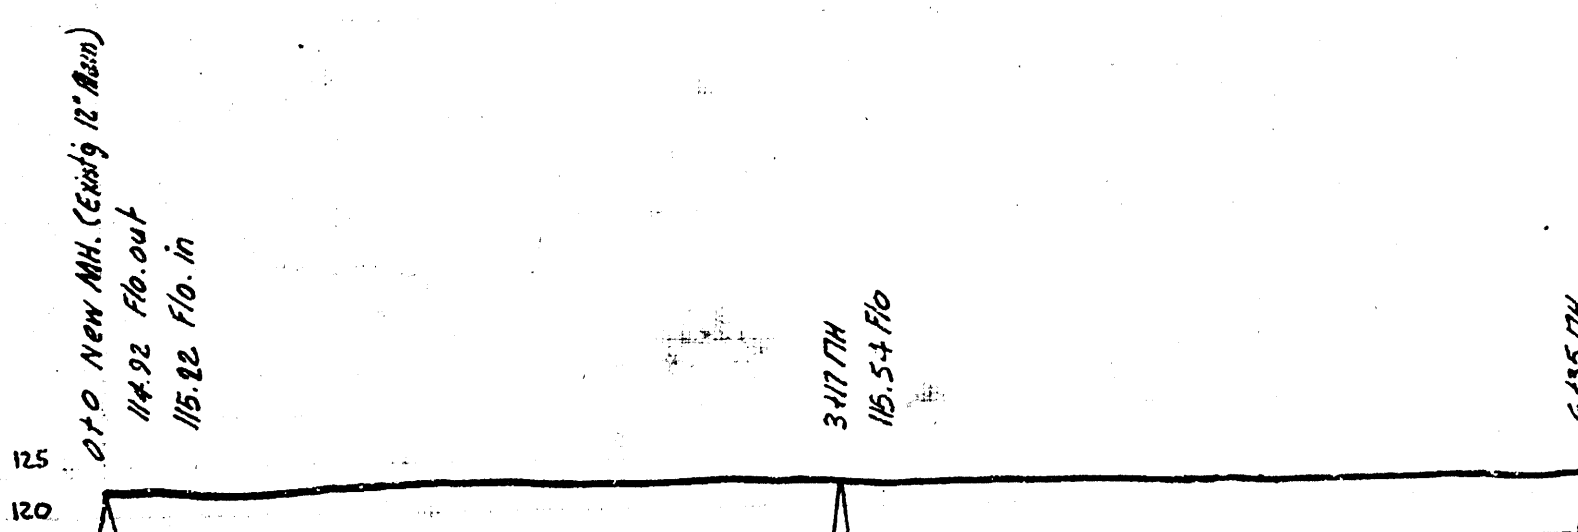

LAT. 17, DIST. T, SS*12

LAT. 14, DIST. R, SS*20 — LAT. 10, DIST. AS, SS*12
LAT. 12, DIST. E, SS*12 — LAT. 17, DIST. T, SS*12

CITY OF WICHITA, KANSAS

L.C. WHITE - CITY ENGINEER

1949