



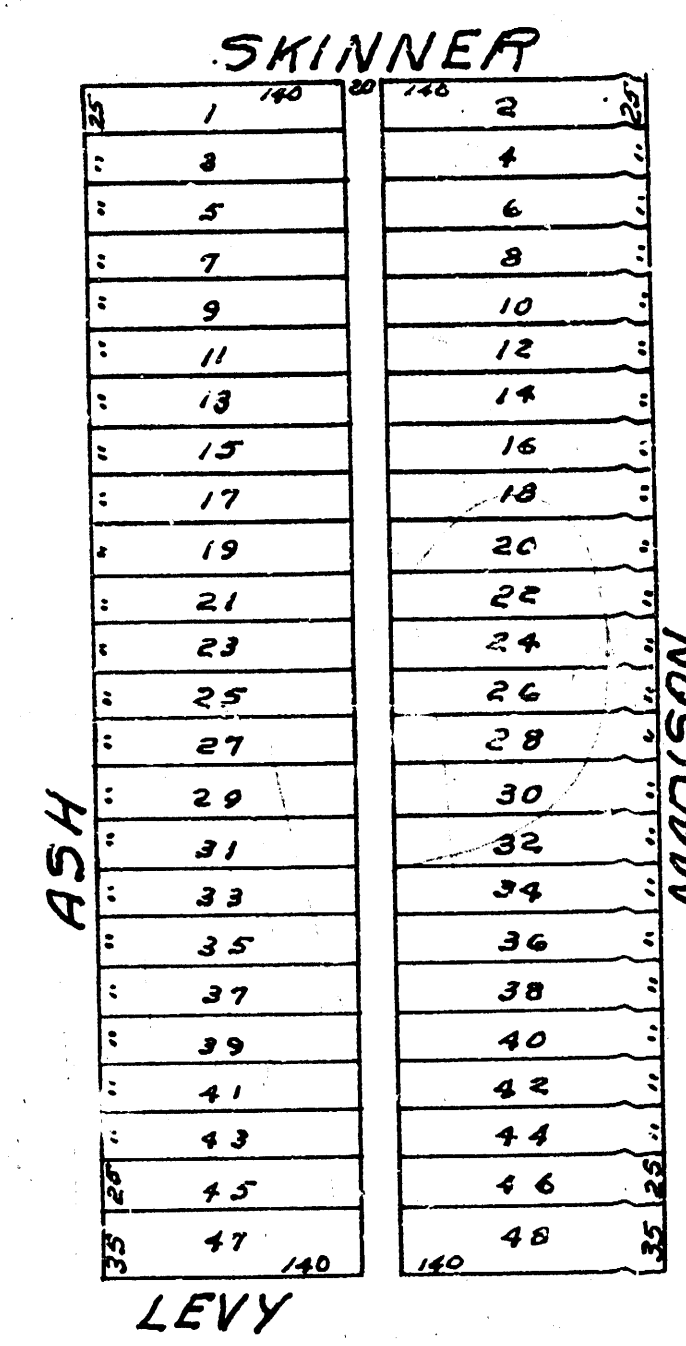




Scale: 1"=100'

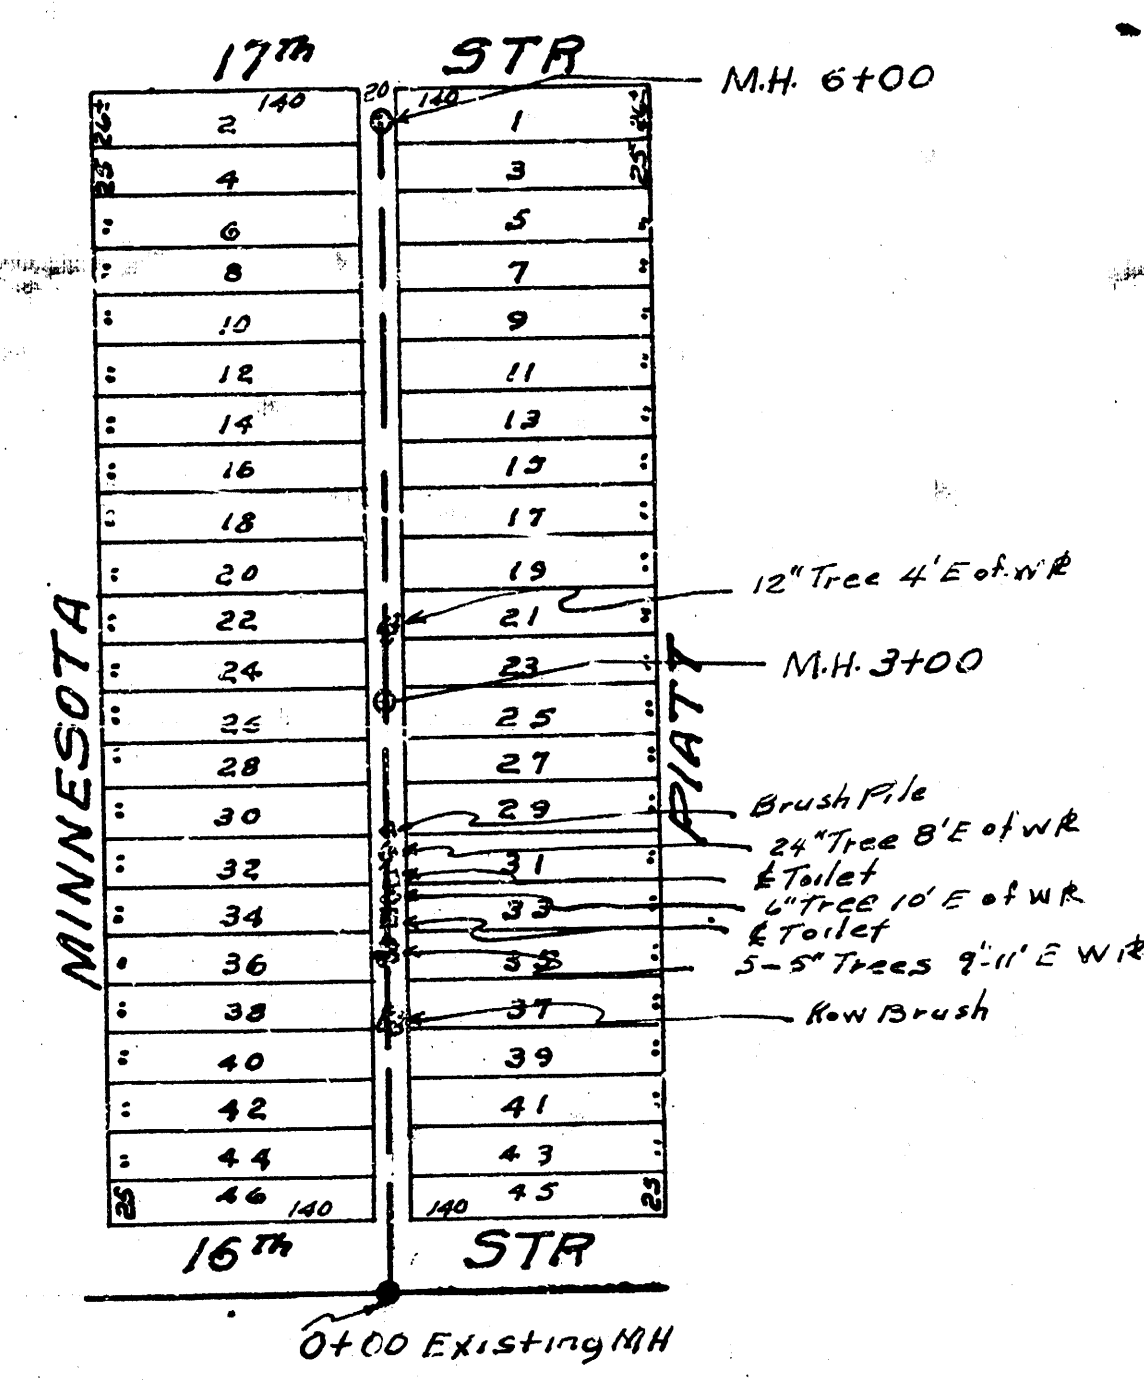

Sand fill Sta 0+00 to 0+30

B.M. So Rm MH 16 & Platt 117.89


DETWILER'S 2ND ADDITION

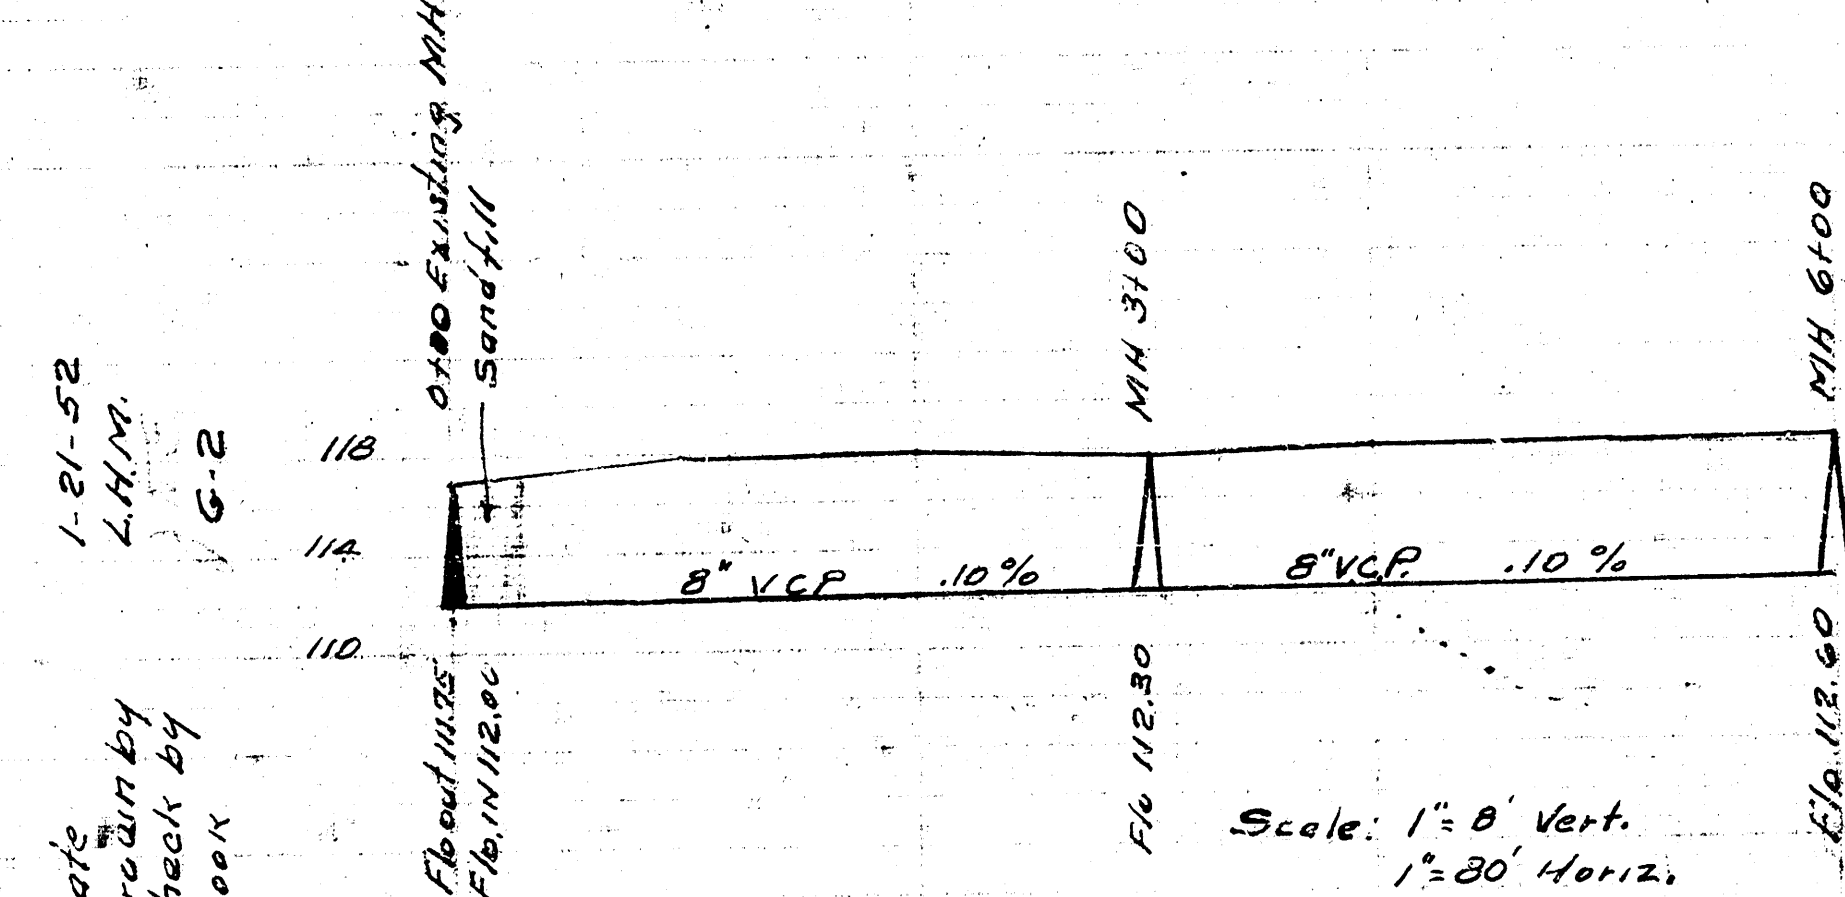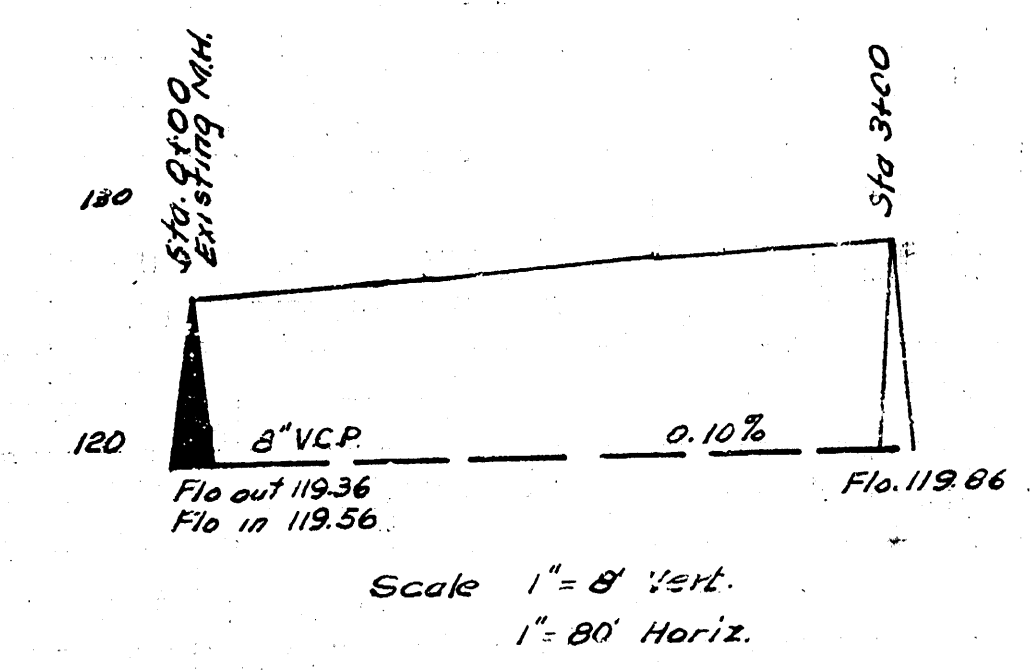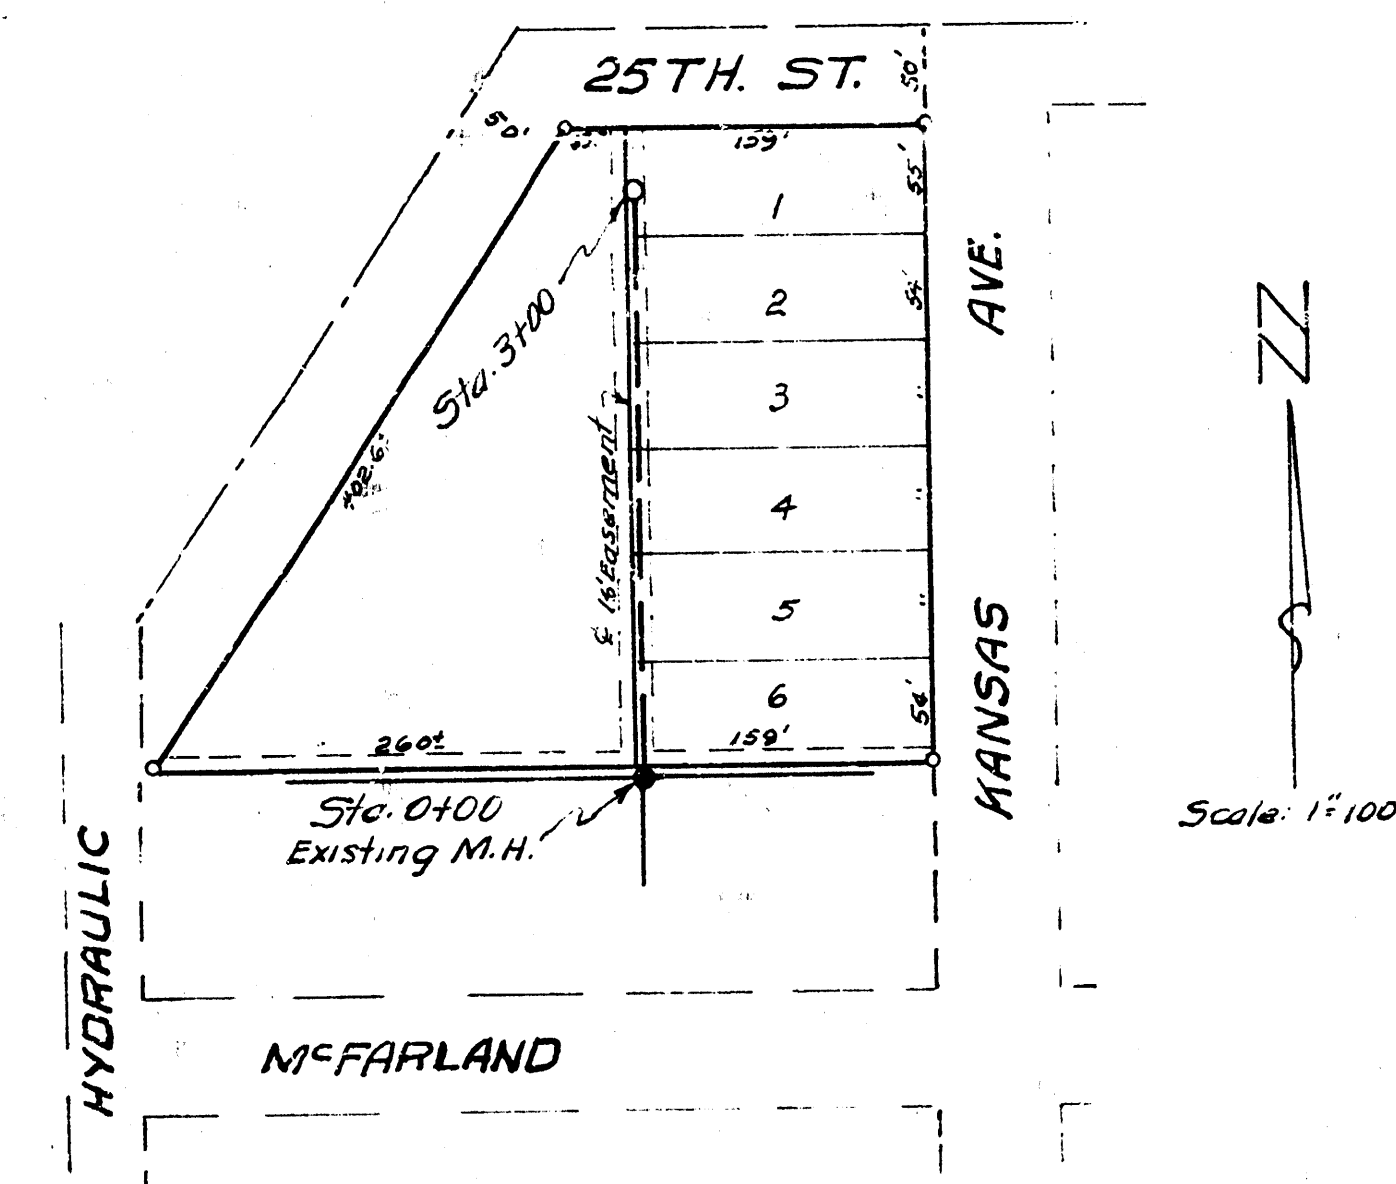

LAT. 18 DIST. AS. SS#12
CITY OF WICHITA KANSAS
L.K. WHITE CITY ENGINEER
Proj No. C-21-80

LAT. 6. SUBY. SS#12
CITY OF WICHITA KANSAS
L.K. WHITE CITY ENGINEER
Proj No. C-21-83

SUBLAT. 1 LAT. 22 DIST. T. MAIN 12
CITY OF WICHITA KANSAS
L.K. WHITE CITY ENGINEER
Proj No. C-22-23

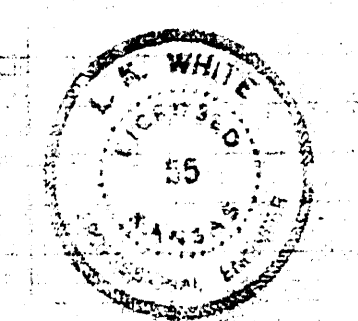

Date
Drawn by
Checked by
Book No.

Date
Drawn by
Checked by
Book