




Date 7-18-52
 Drawn by L. McClain
 Checked by B. McKee
 11-24

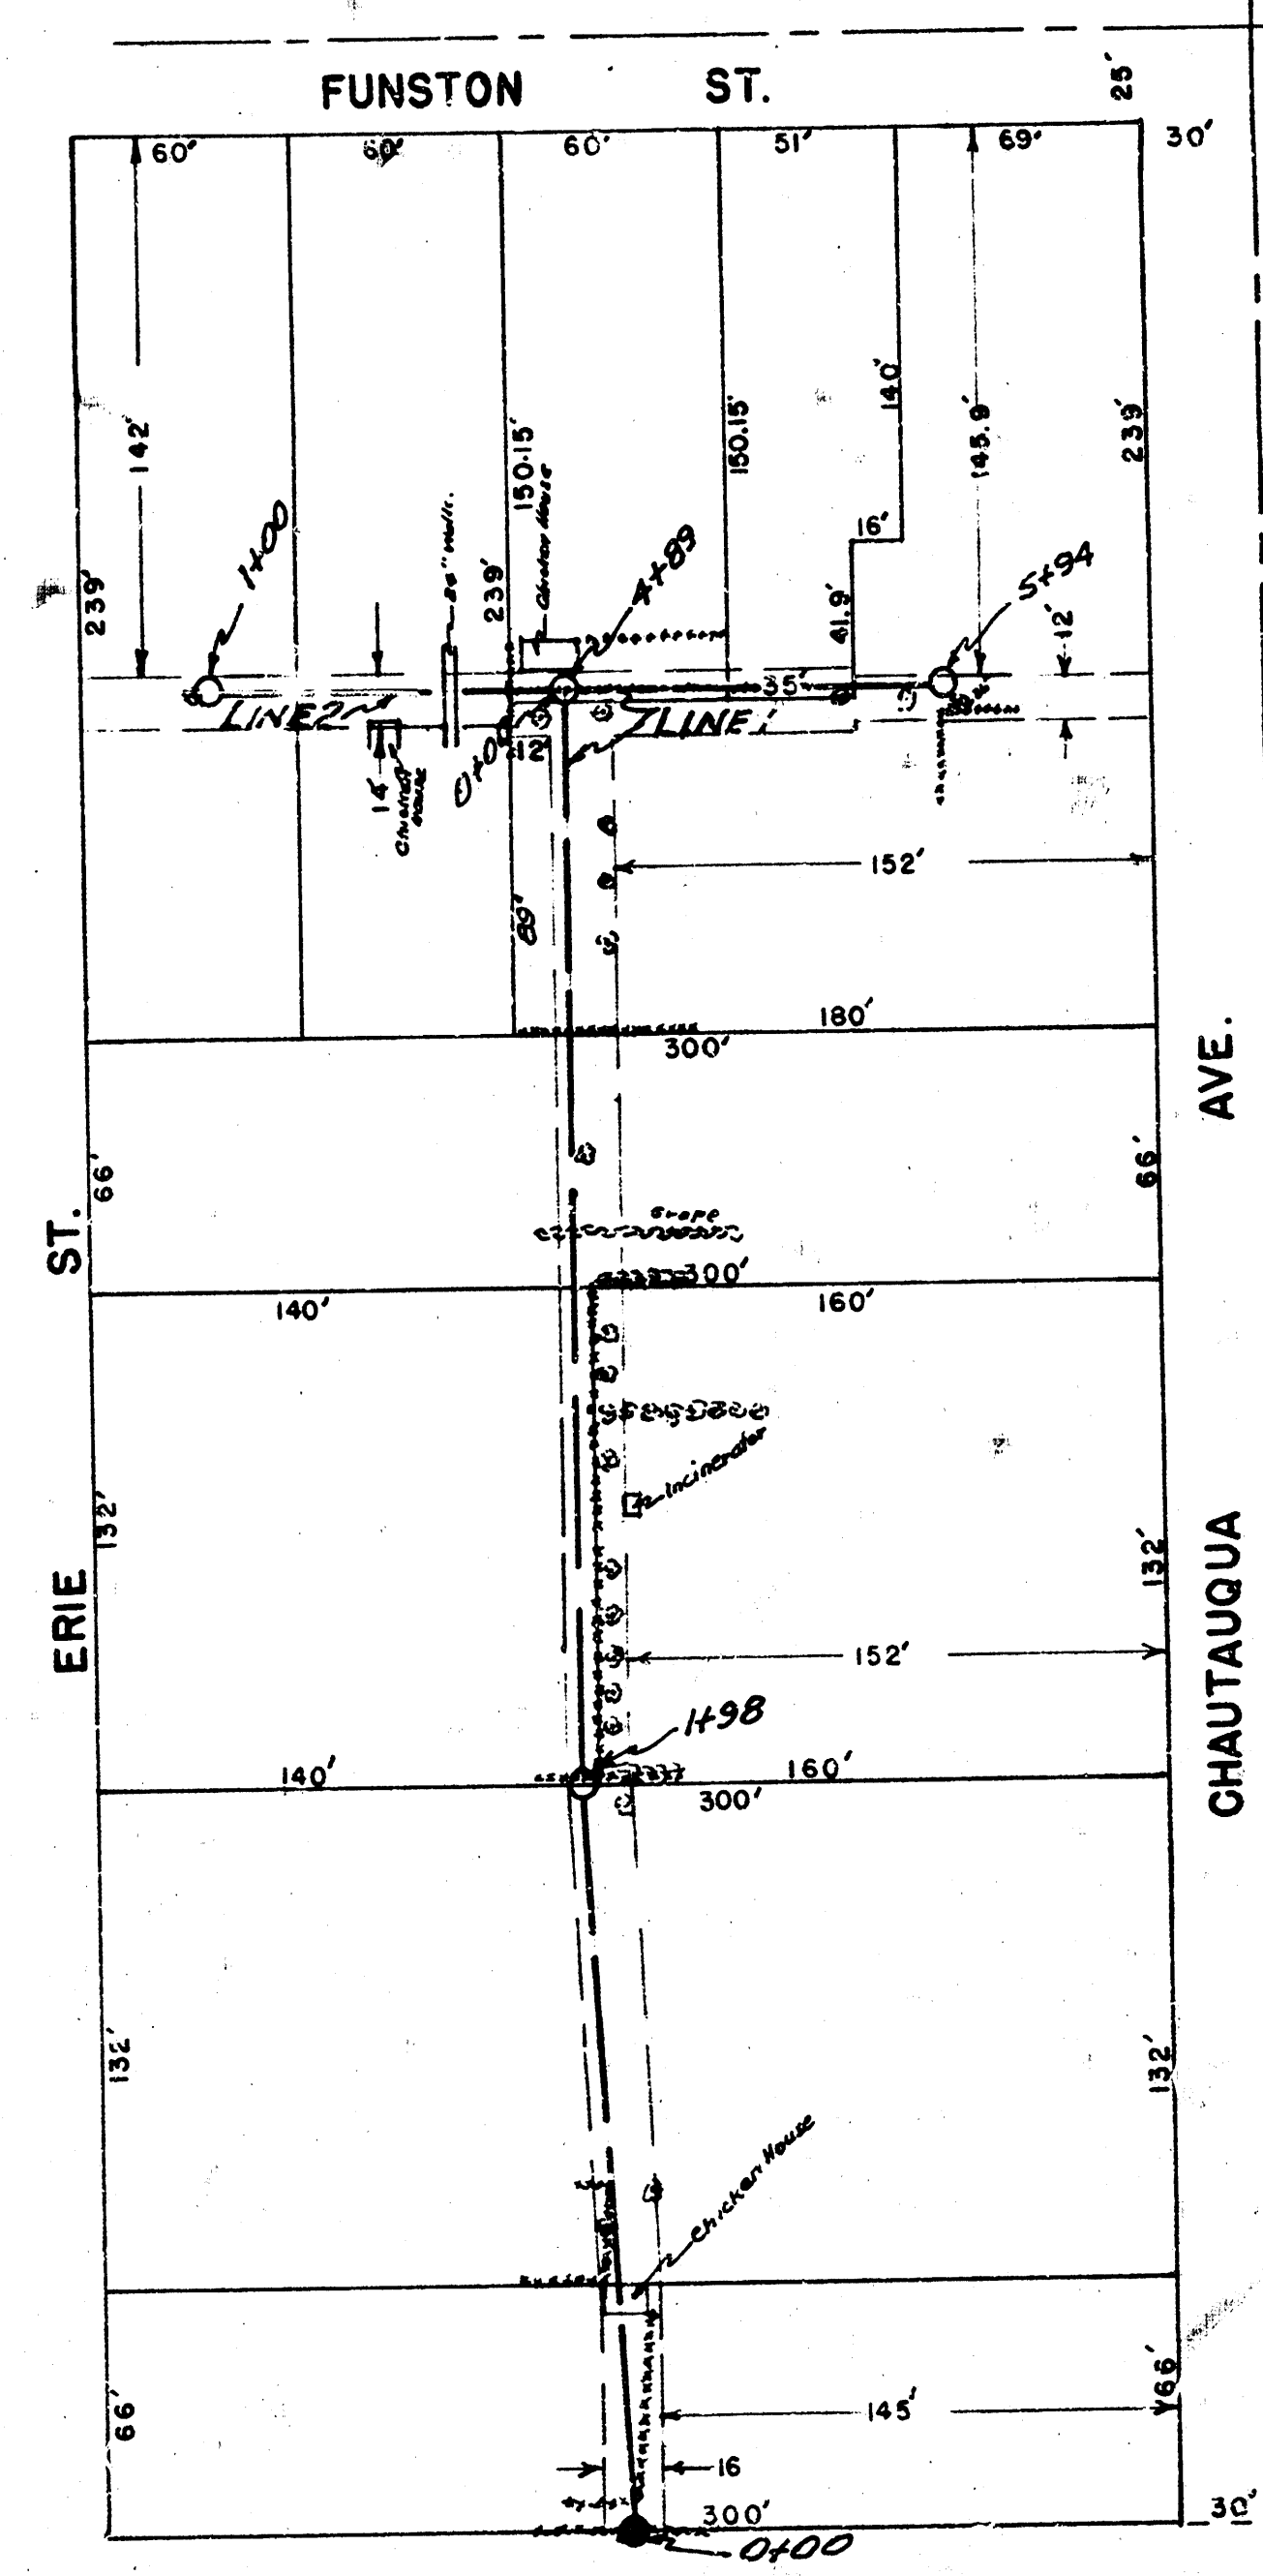


Scale 1"=50'

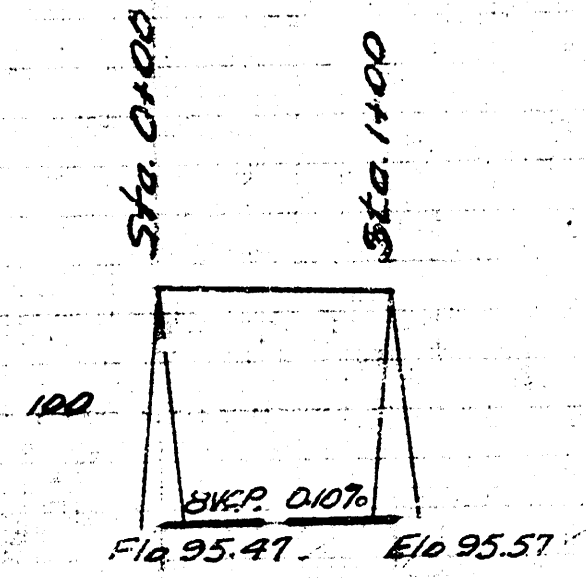

Date 7-29-52
 Drawn by L. McClain
 Checked by B. McKee
 11-24

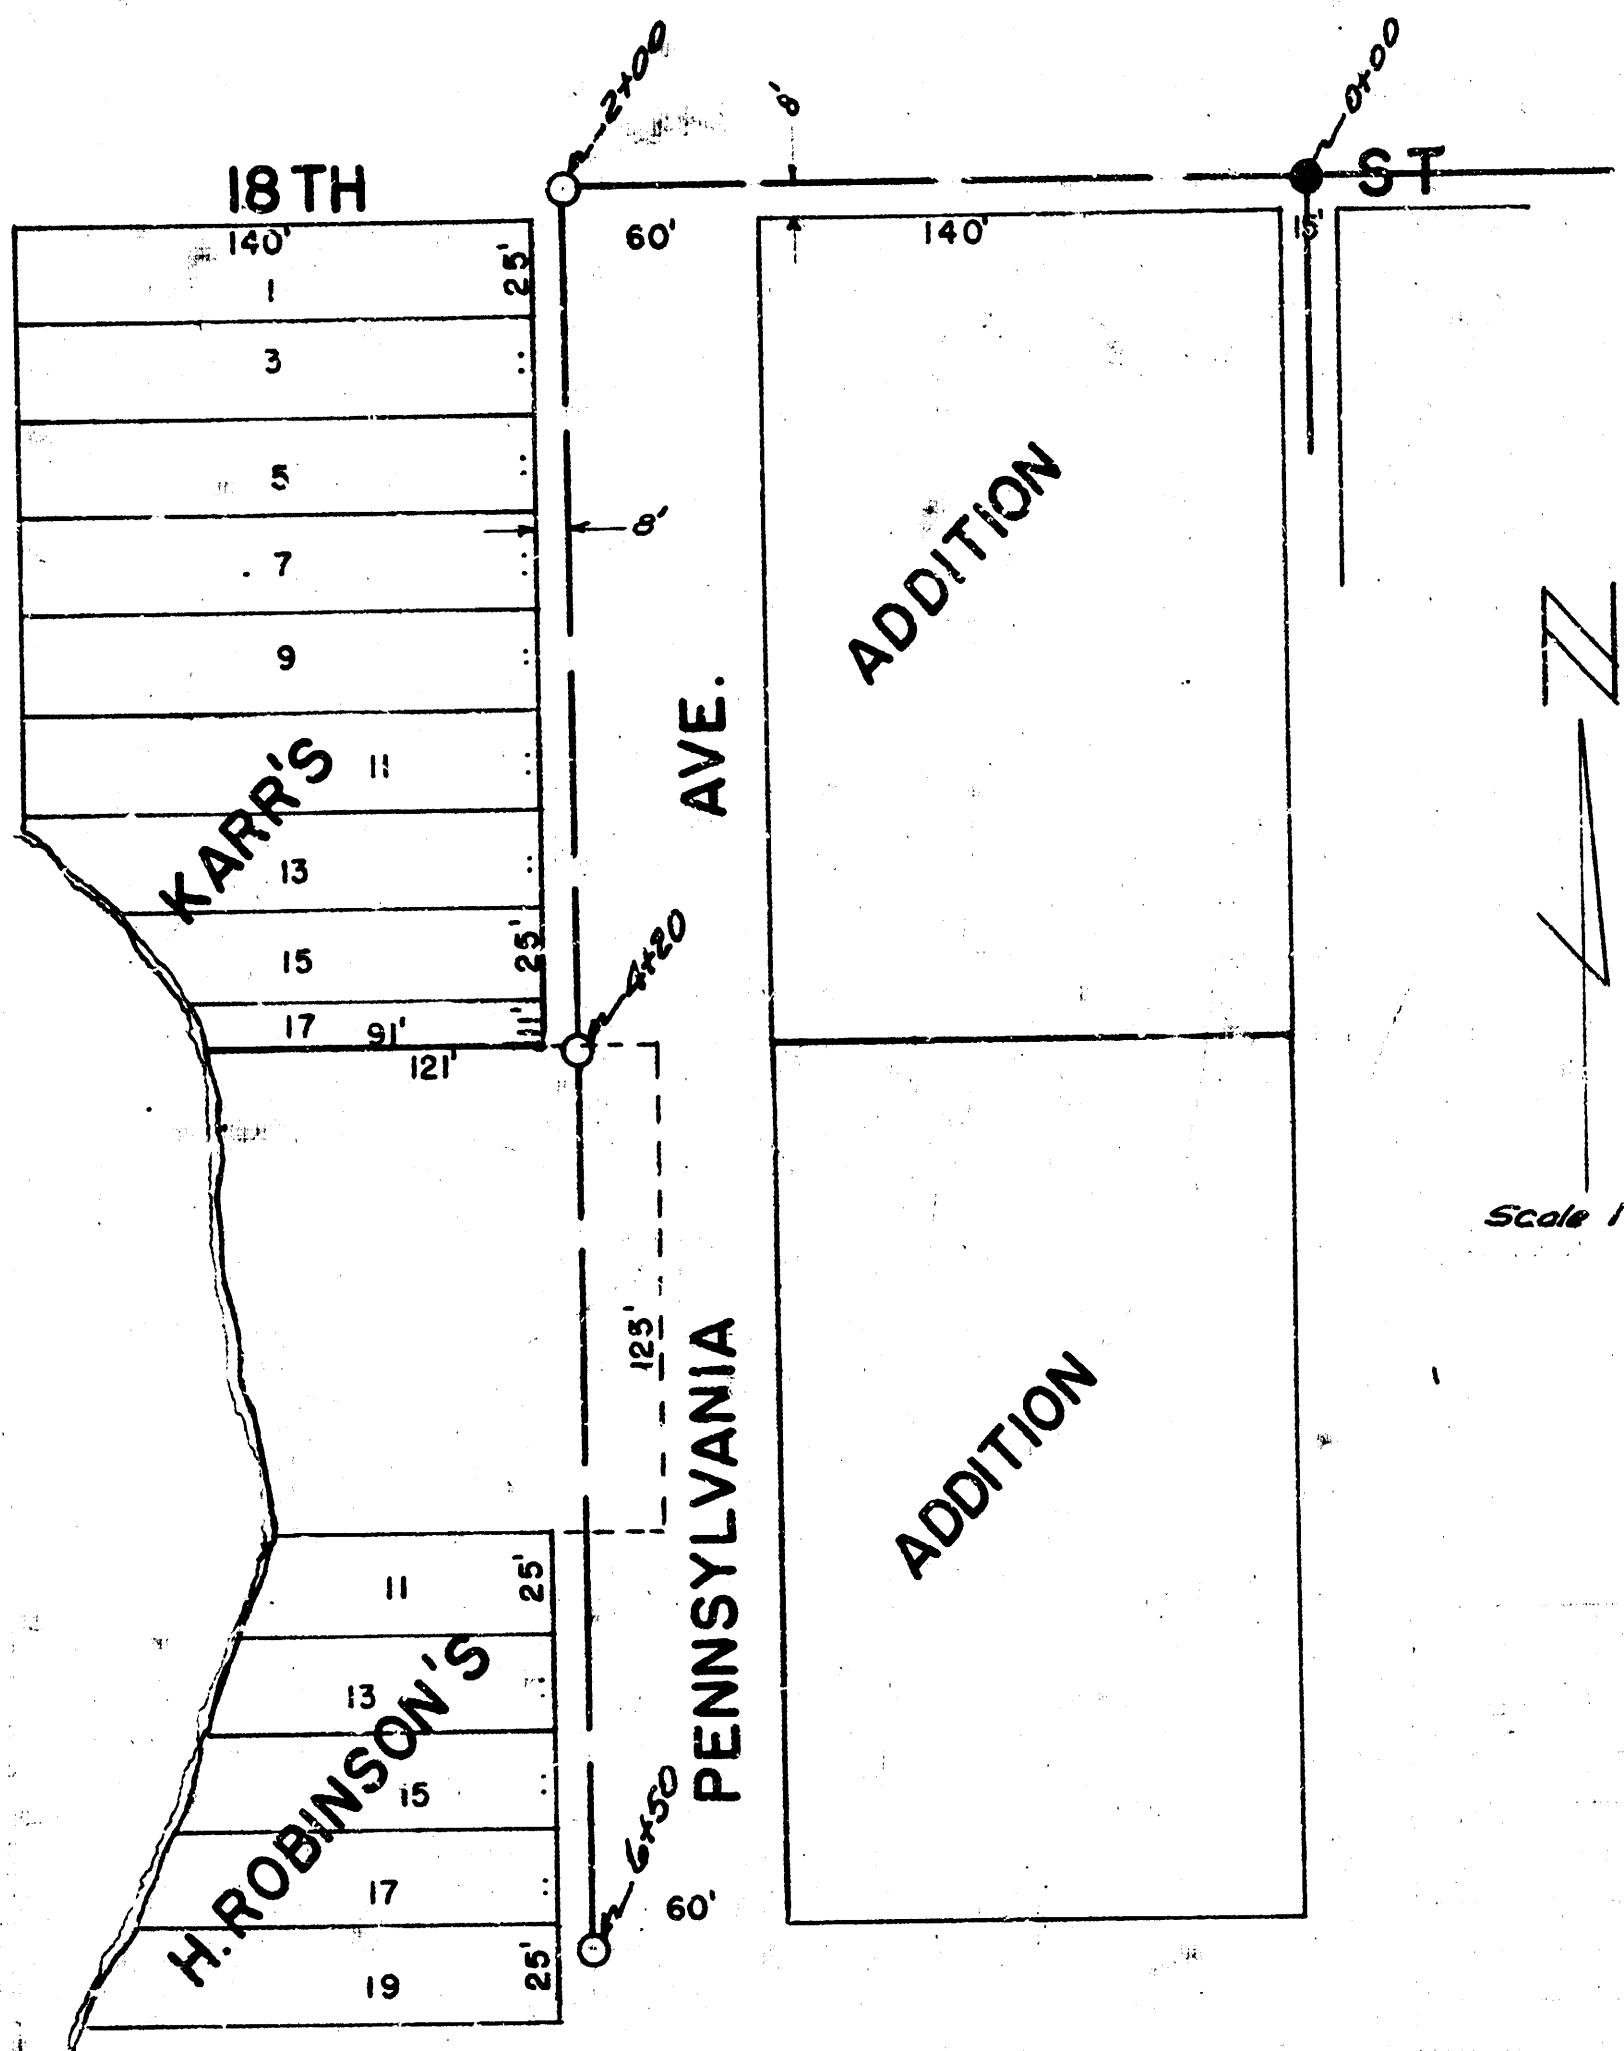

Scale 1"=50'

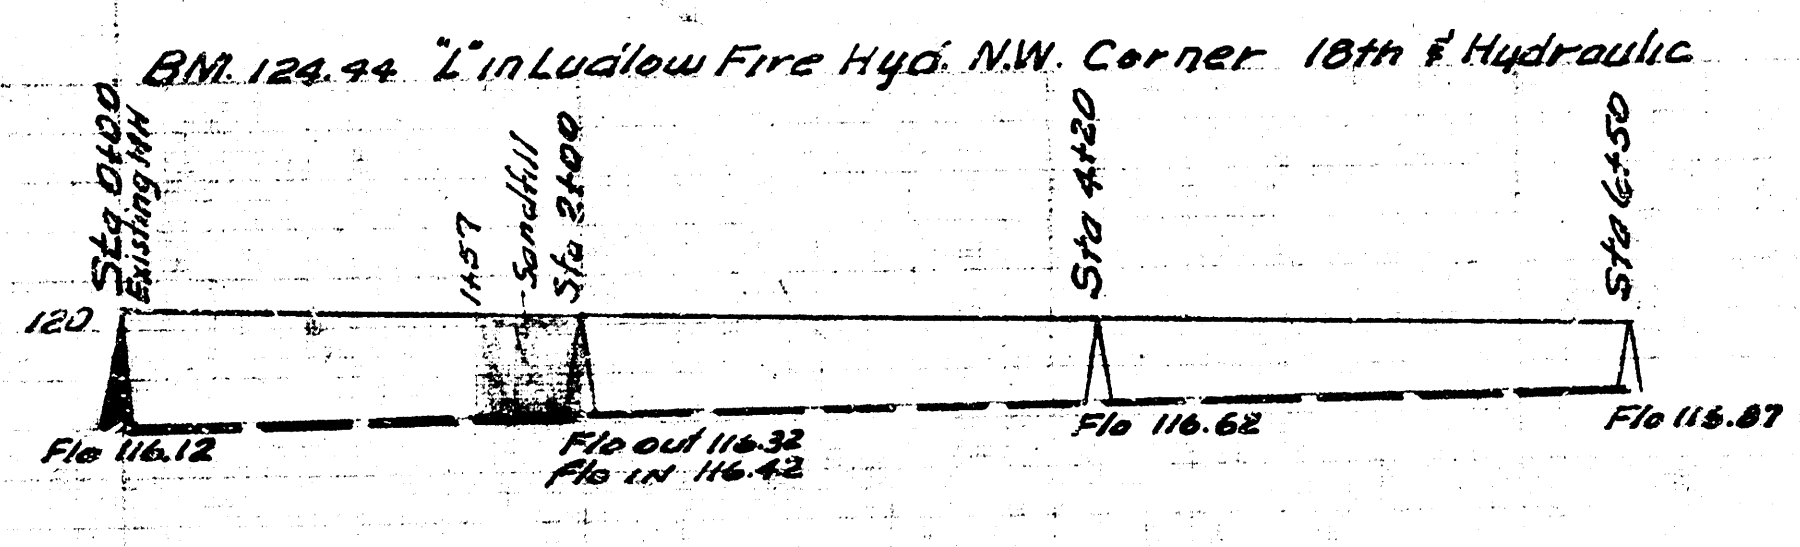

LAT. 21 DCS2 - 5512
 CITY OF WICHITA KANSAS
 LK. WHITE CITY ENGINEER
 Proj No. C-22-44



LAT. 21 DCS2 - 5512
 CITY OF WICHITA KANSAS
 LK. WHITE CITY ENGINEER
 Proj No. C-22-44