



DI SANTE ADDITION

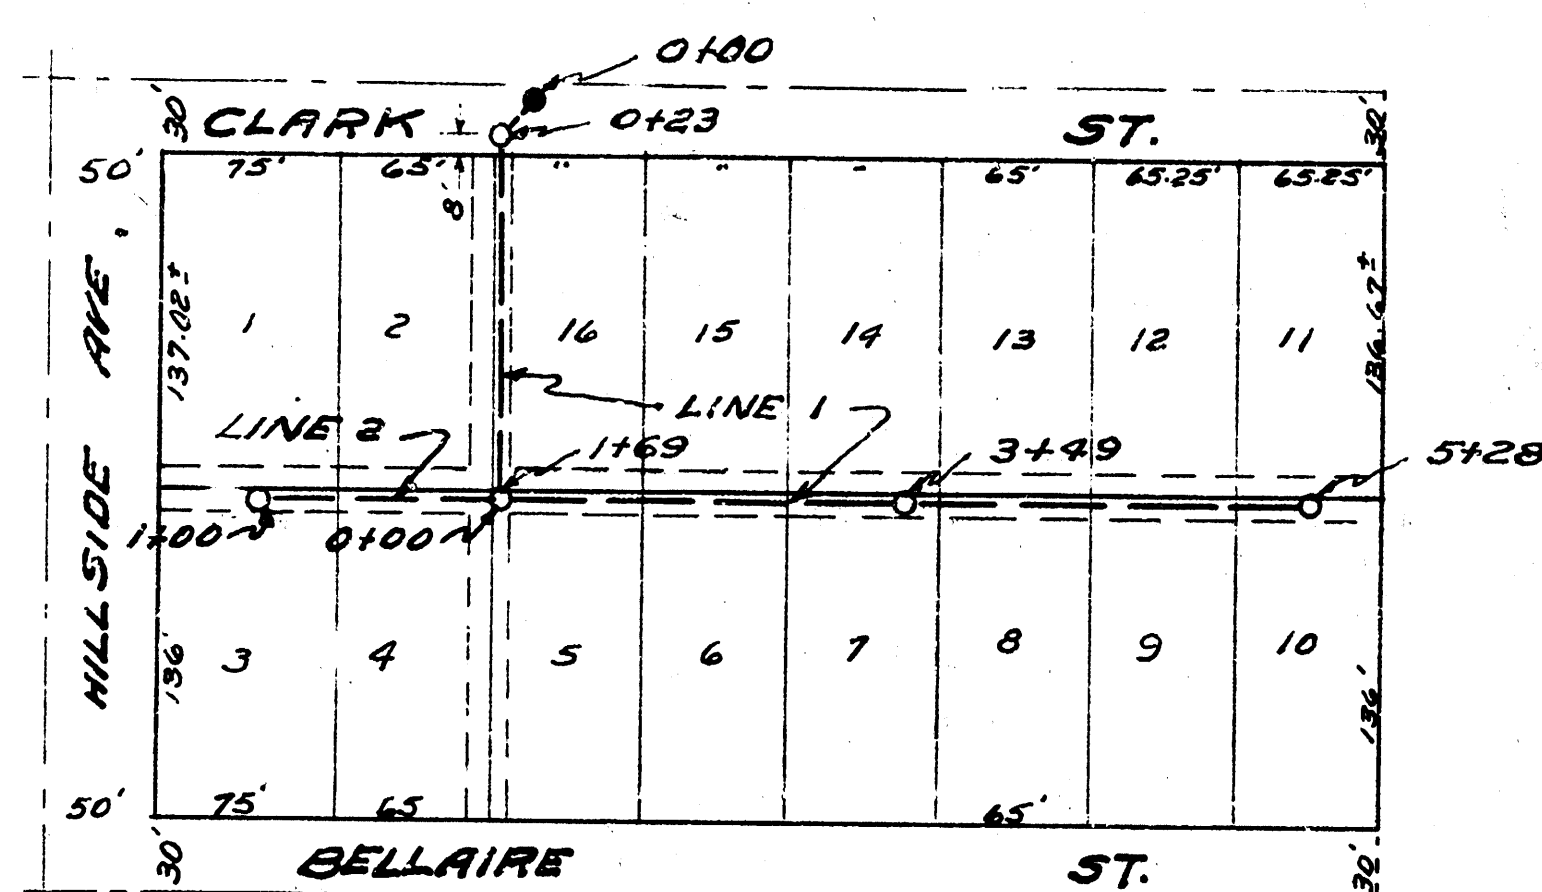

Scale: 1"=60'


E.A. FISHER'S ADDITION

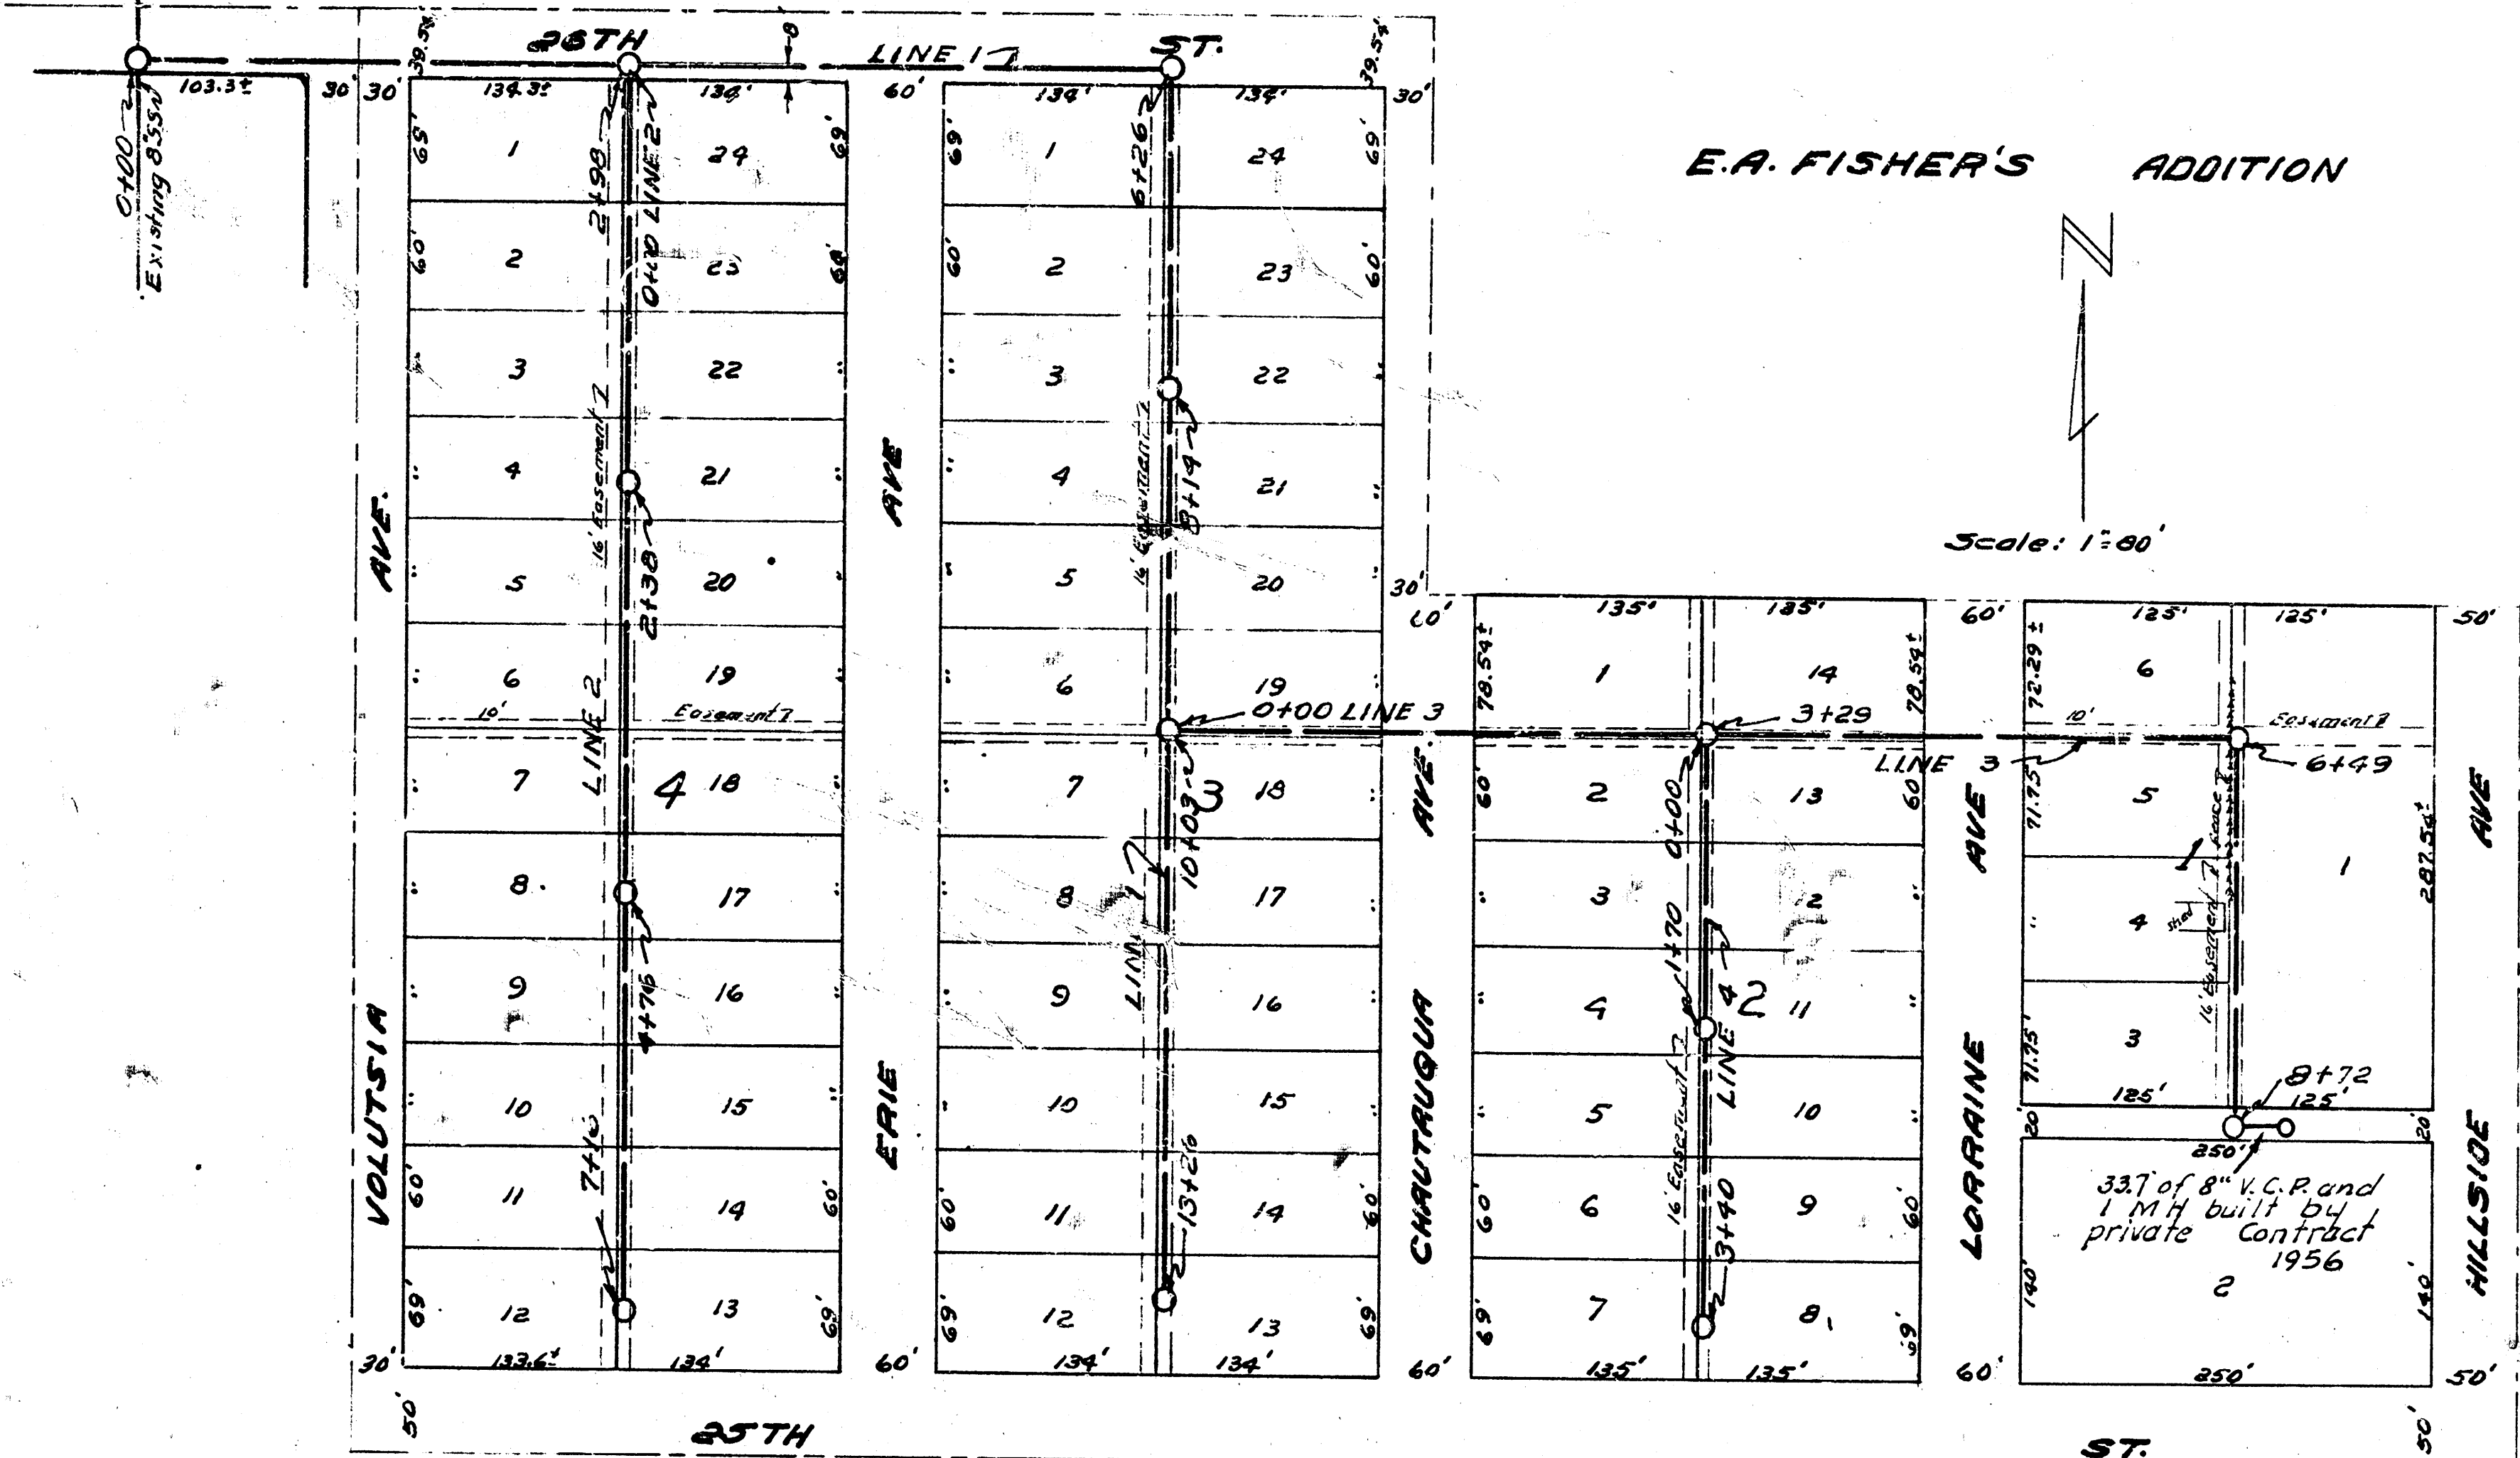

Scale: 1"=60'


Date 6-20-53
Drawn by M. Smith
Checked by E. E. Smith
Book No. 531

BM. 100.80 60" Nail E.S. Bell Tele. Pole
SE Corner Hillside & Clark.

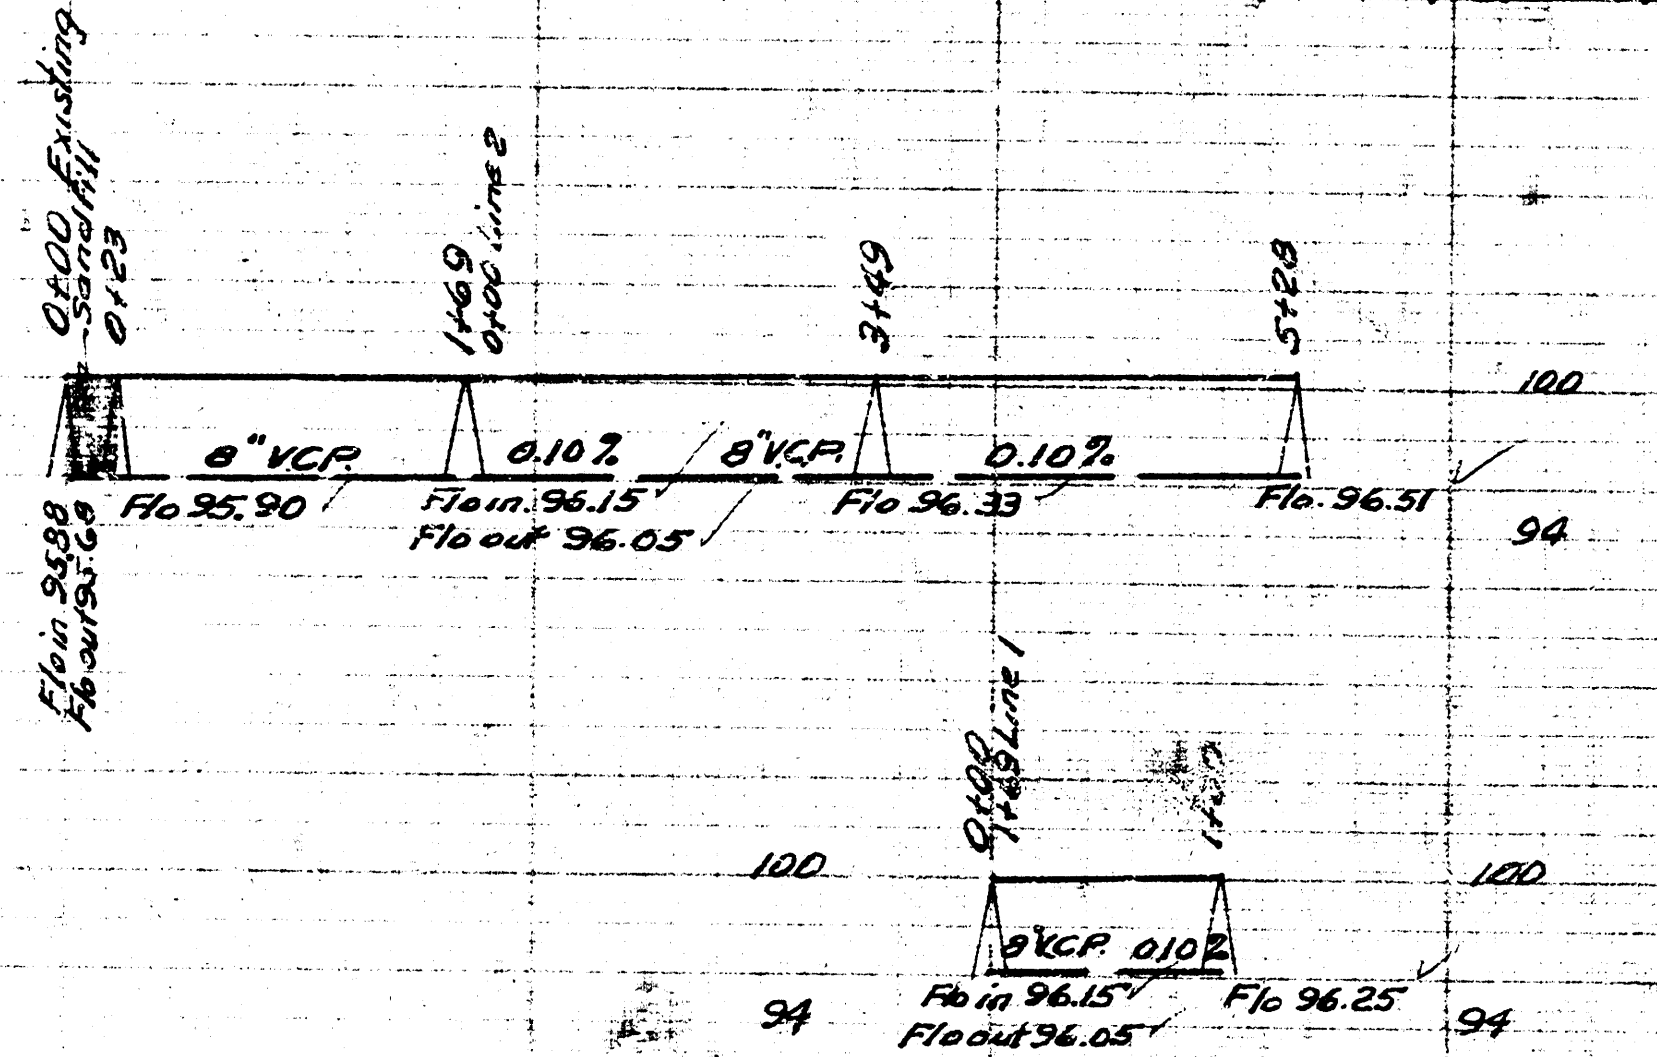

LAT. 33 DIST. 2 SS. 12
CITY OF WICHITA KANSAS
BE SMITH CITY ENGINEER
Proj. No. C-23-33

Date 6-1-53
Drawn by M. Smith
Checked by E. E. Smith
Book No. 531

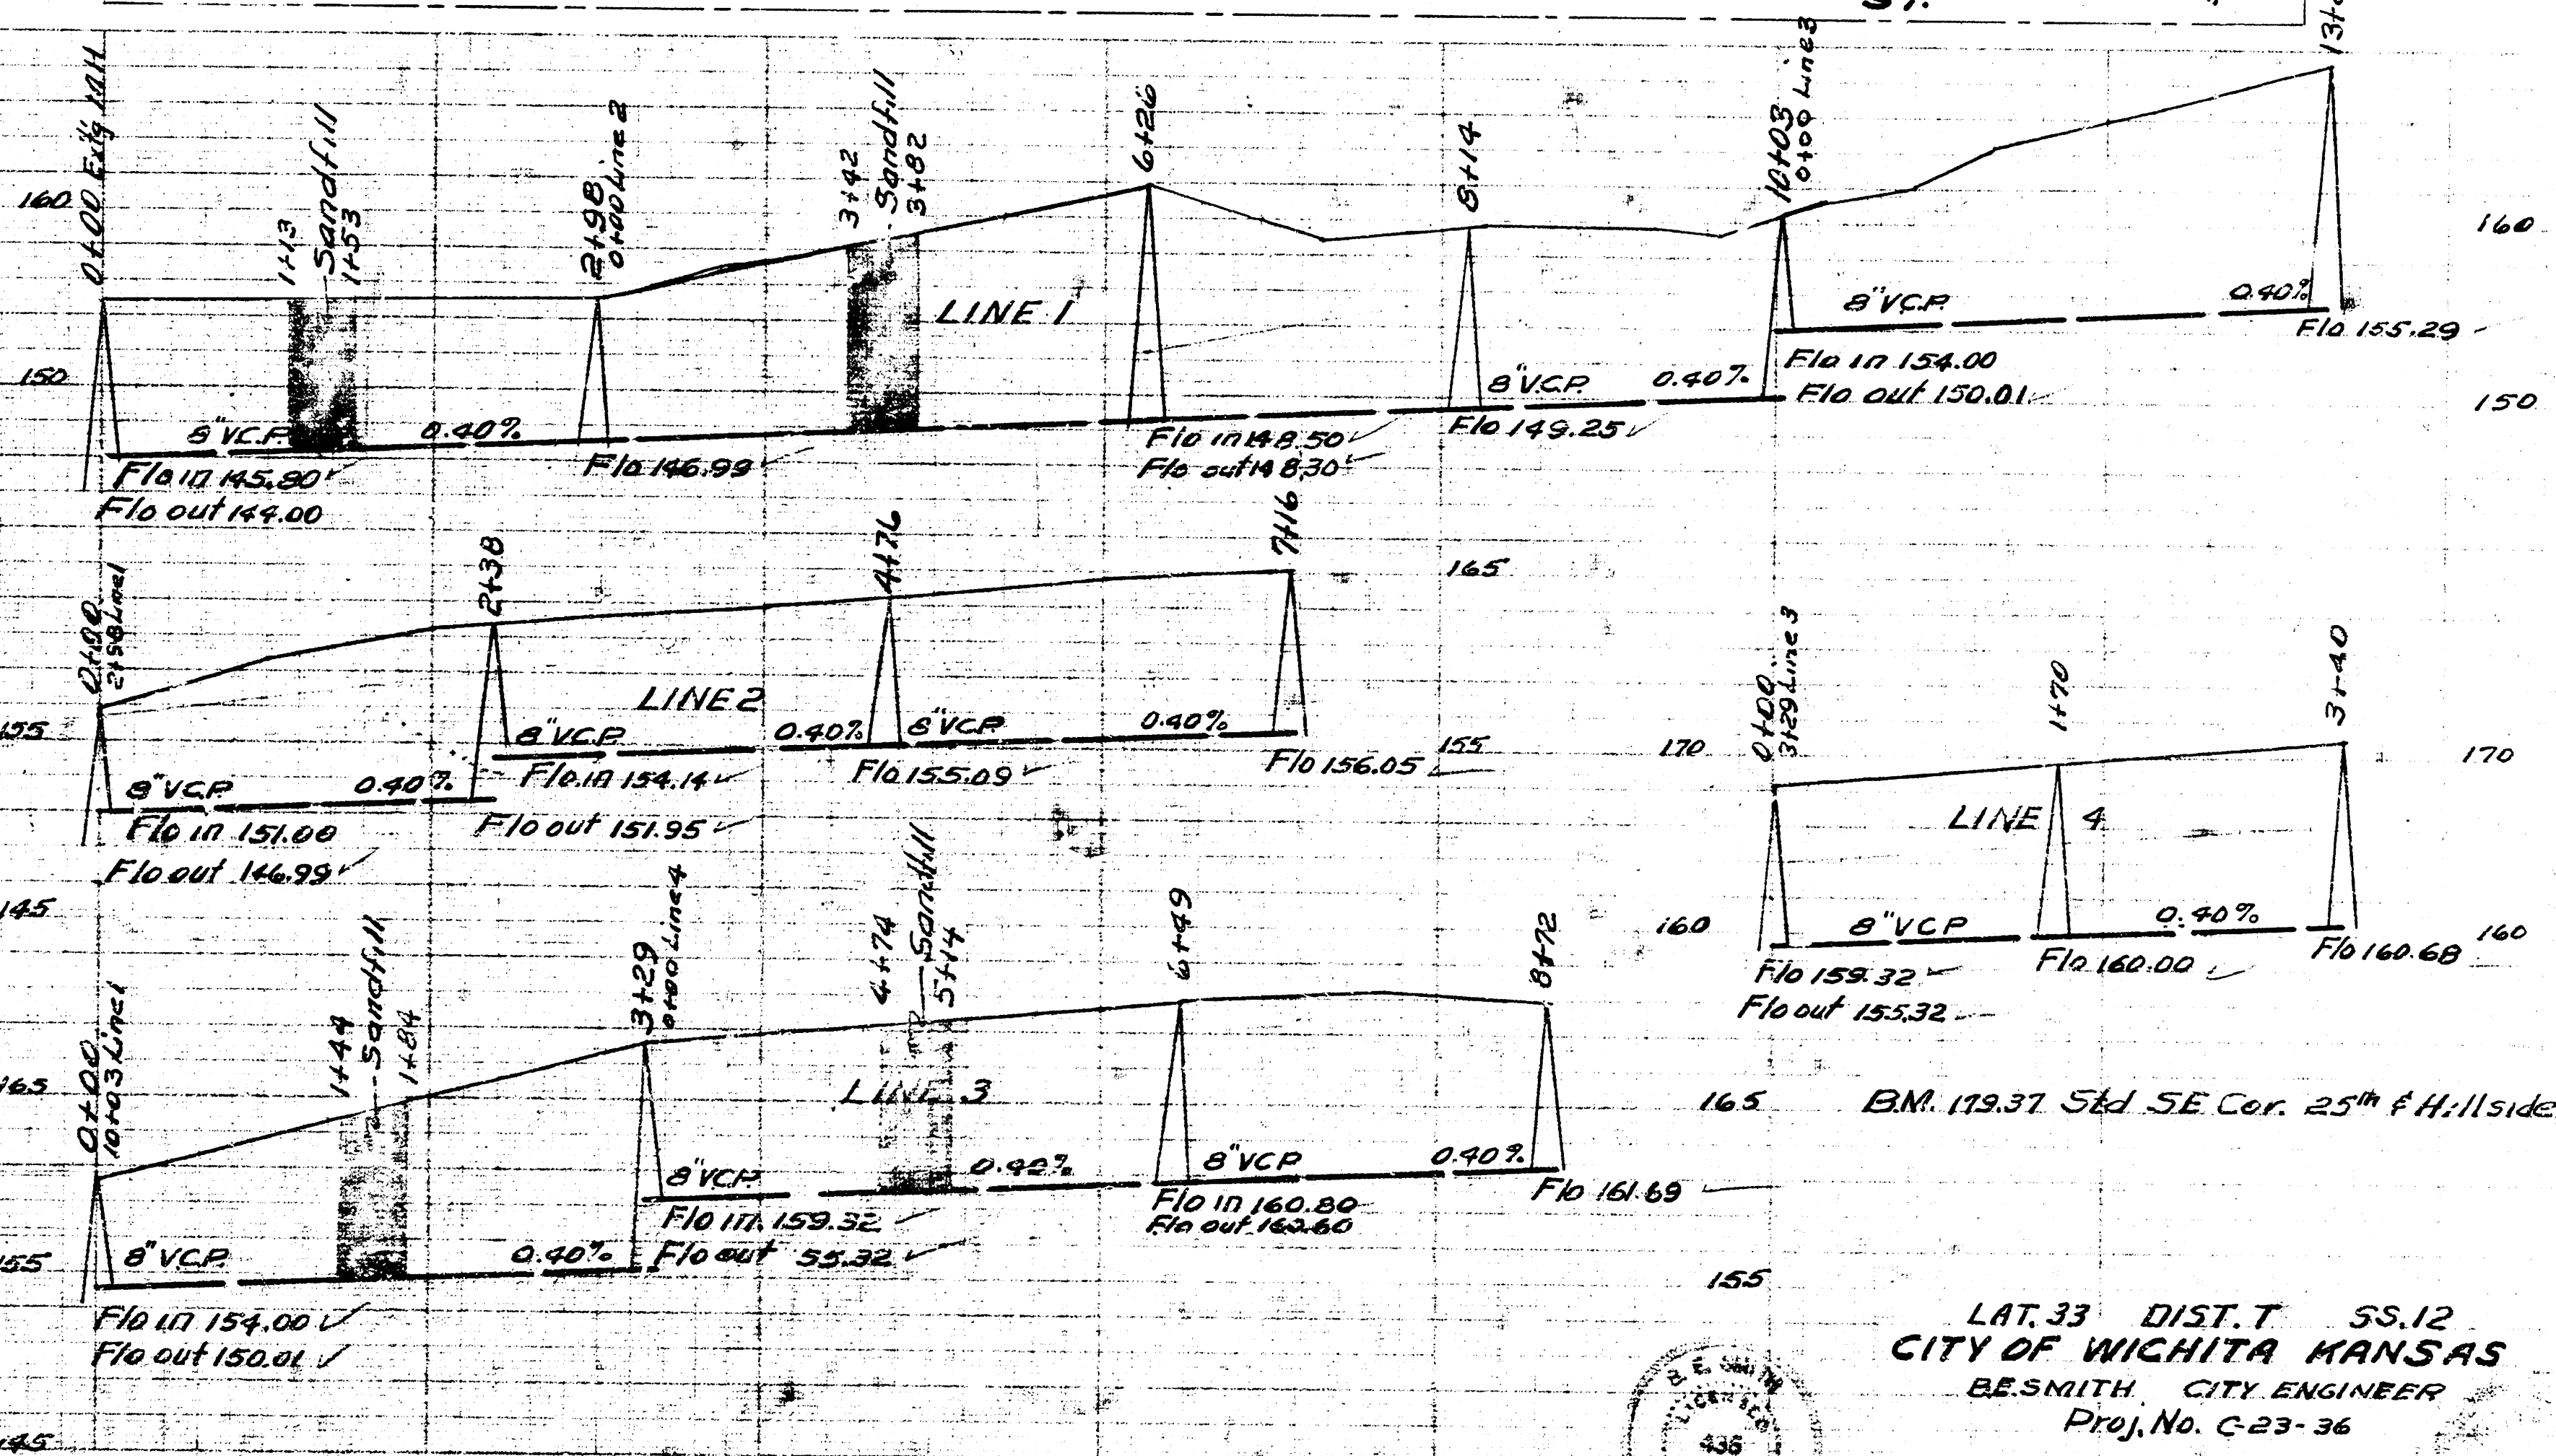

LAT. 33 DIST. T SS. 12
CITY OF WICHITA KANSAS
BE SMITH CITY ENGINEER
Proj. No. C-23-36