



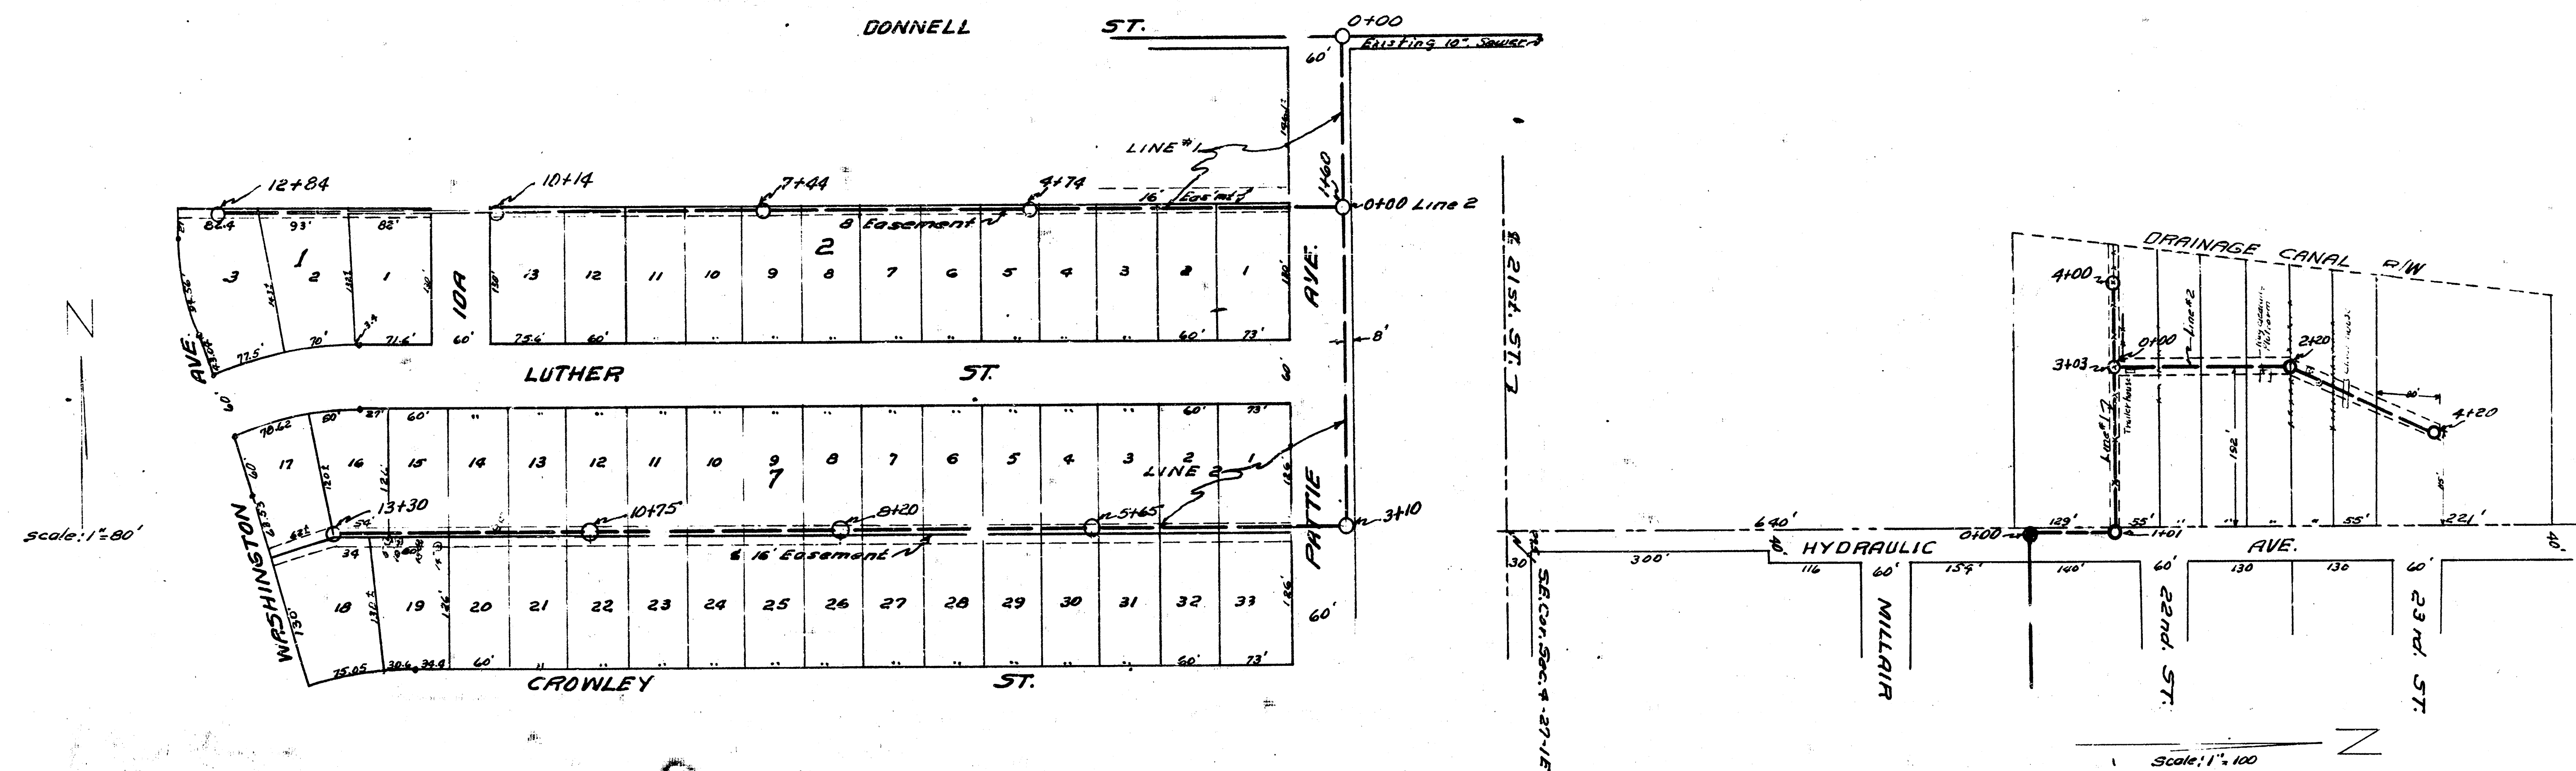


2-9-54
 Drawn by
 McGinn
 Checked by
 Boon No. 15

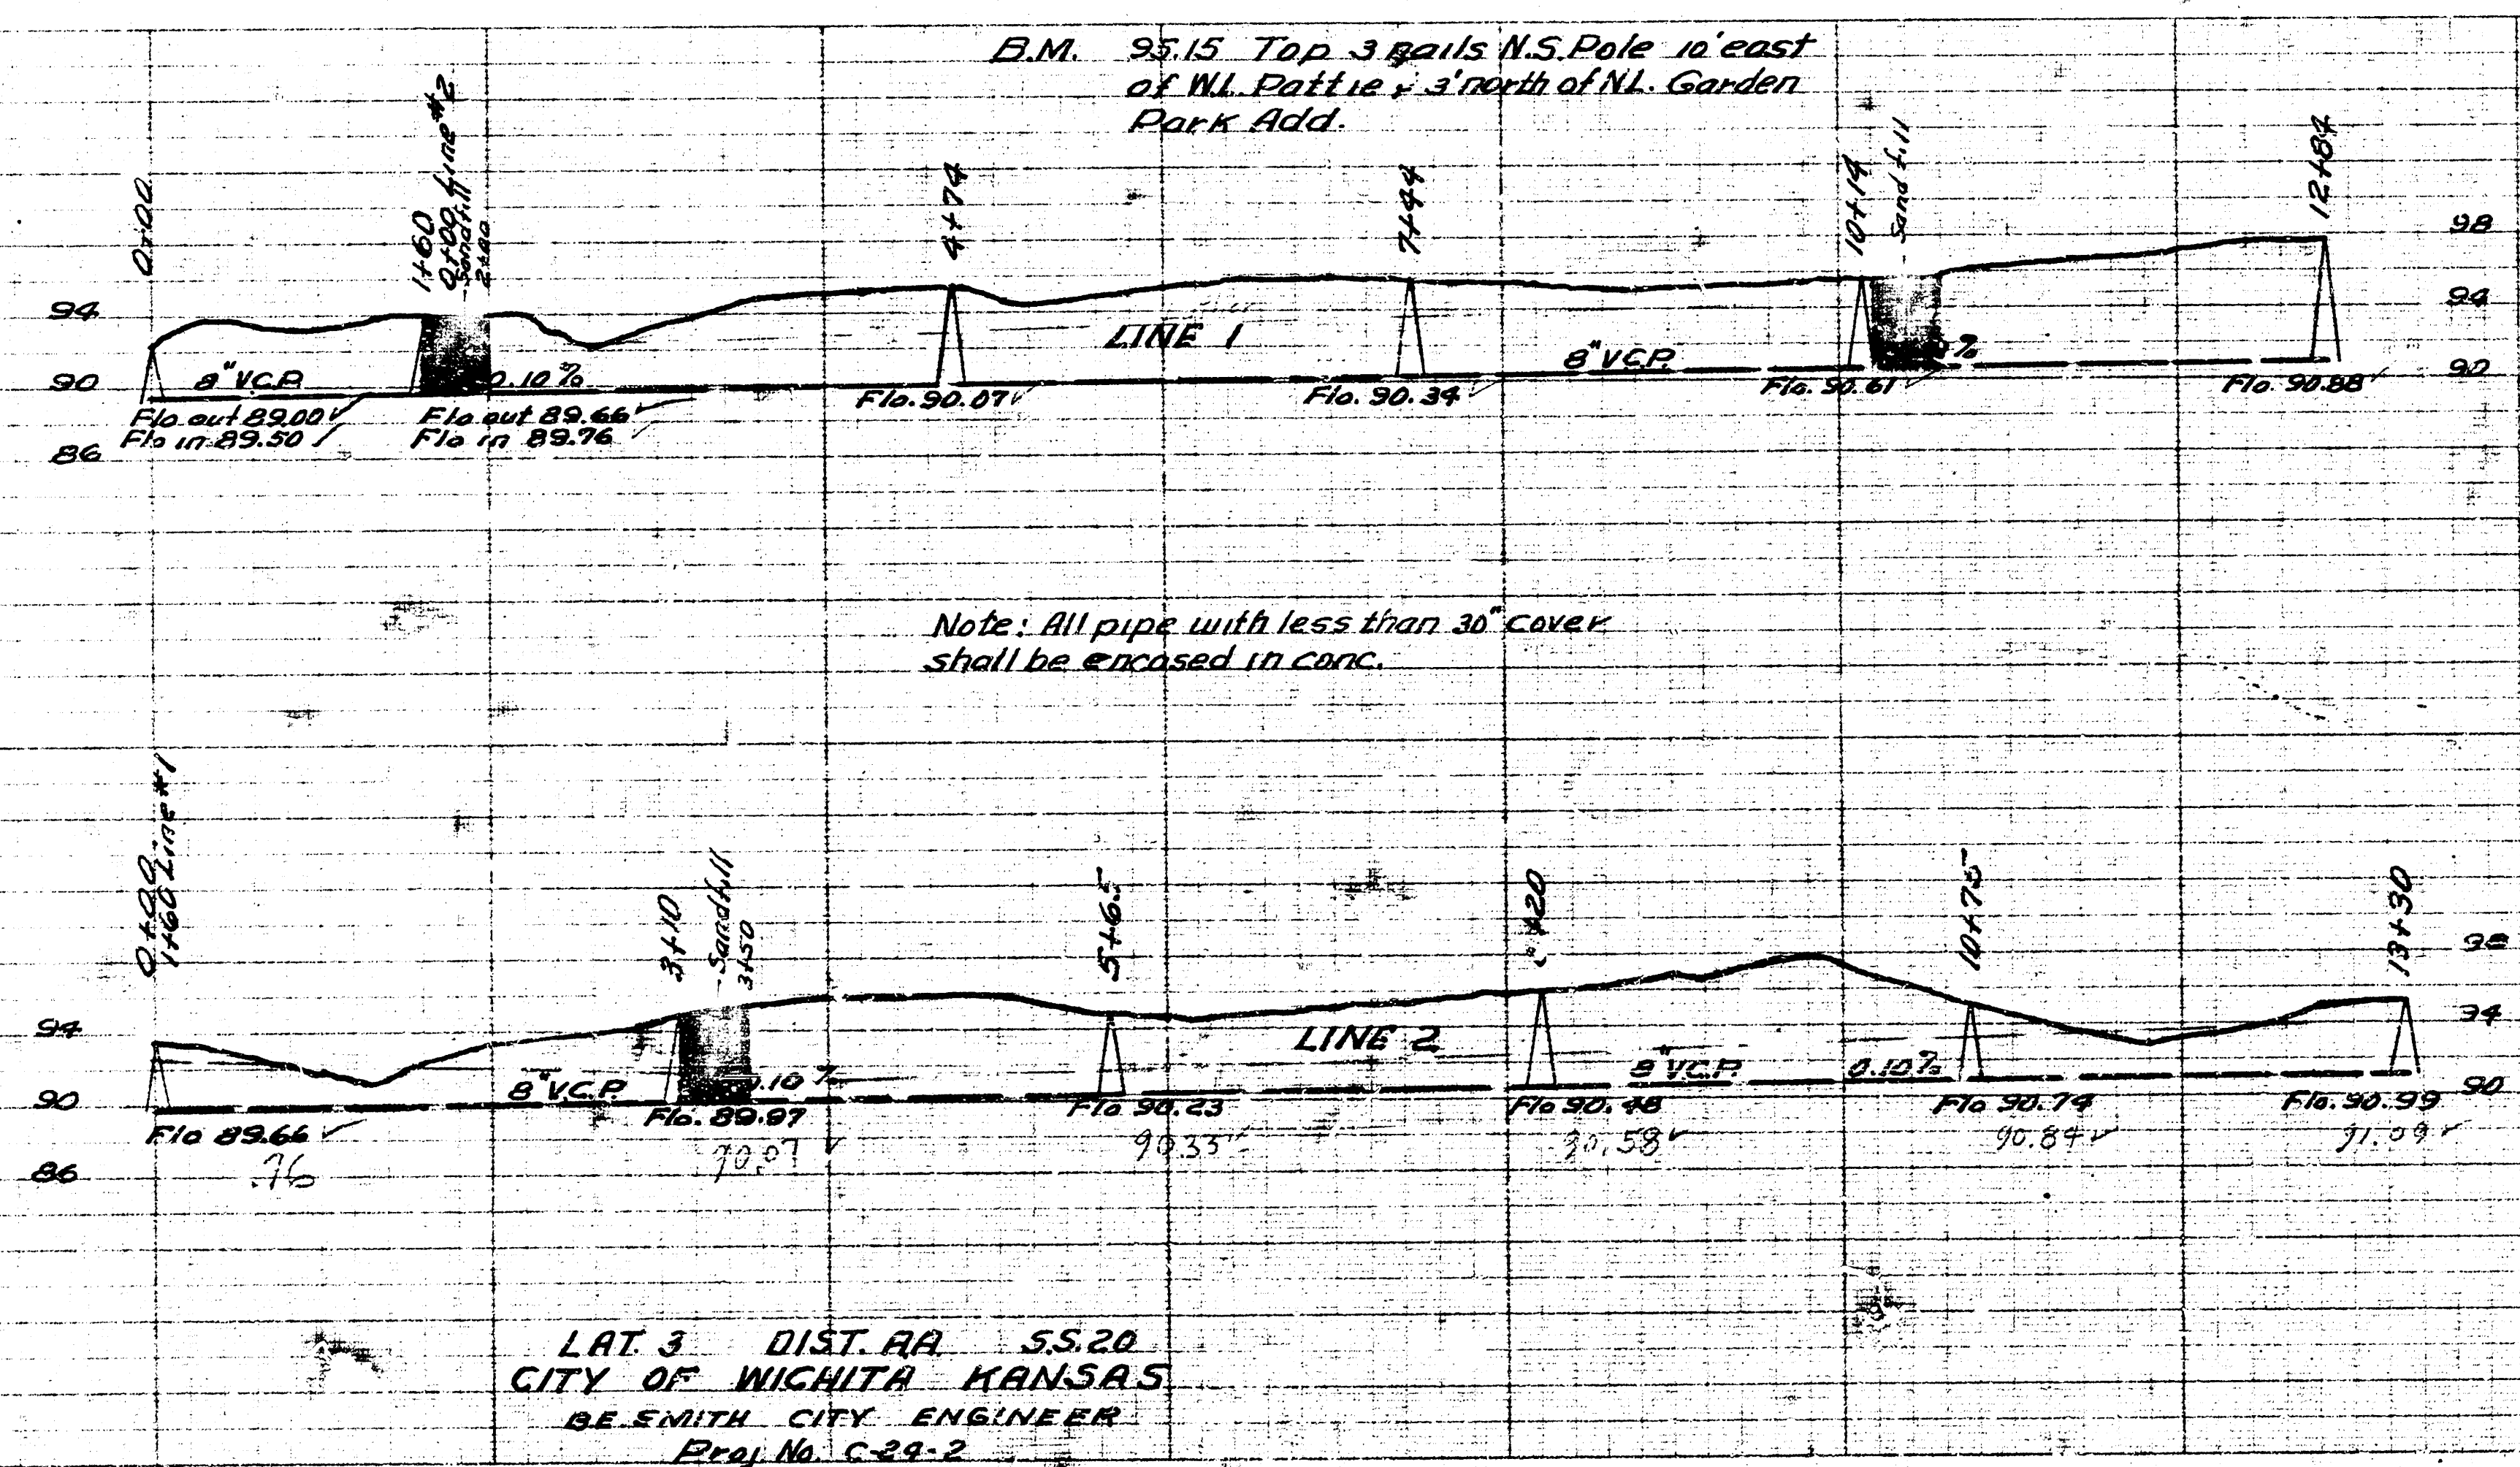

 CITY OF WICHITA KANSAS
 BE SMITH CITY ENGINEER

2-9-54
 Drawn by
 McGinn
 Checked by
 Boon No. 15

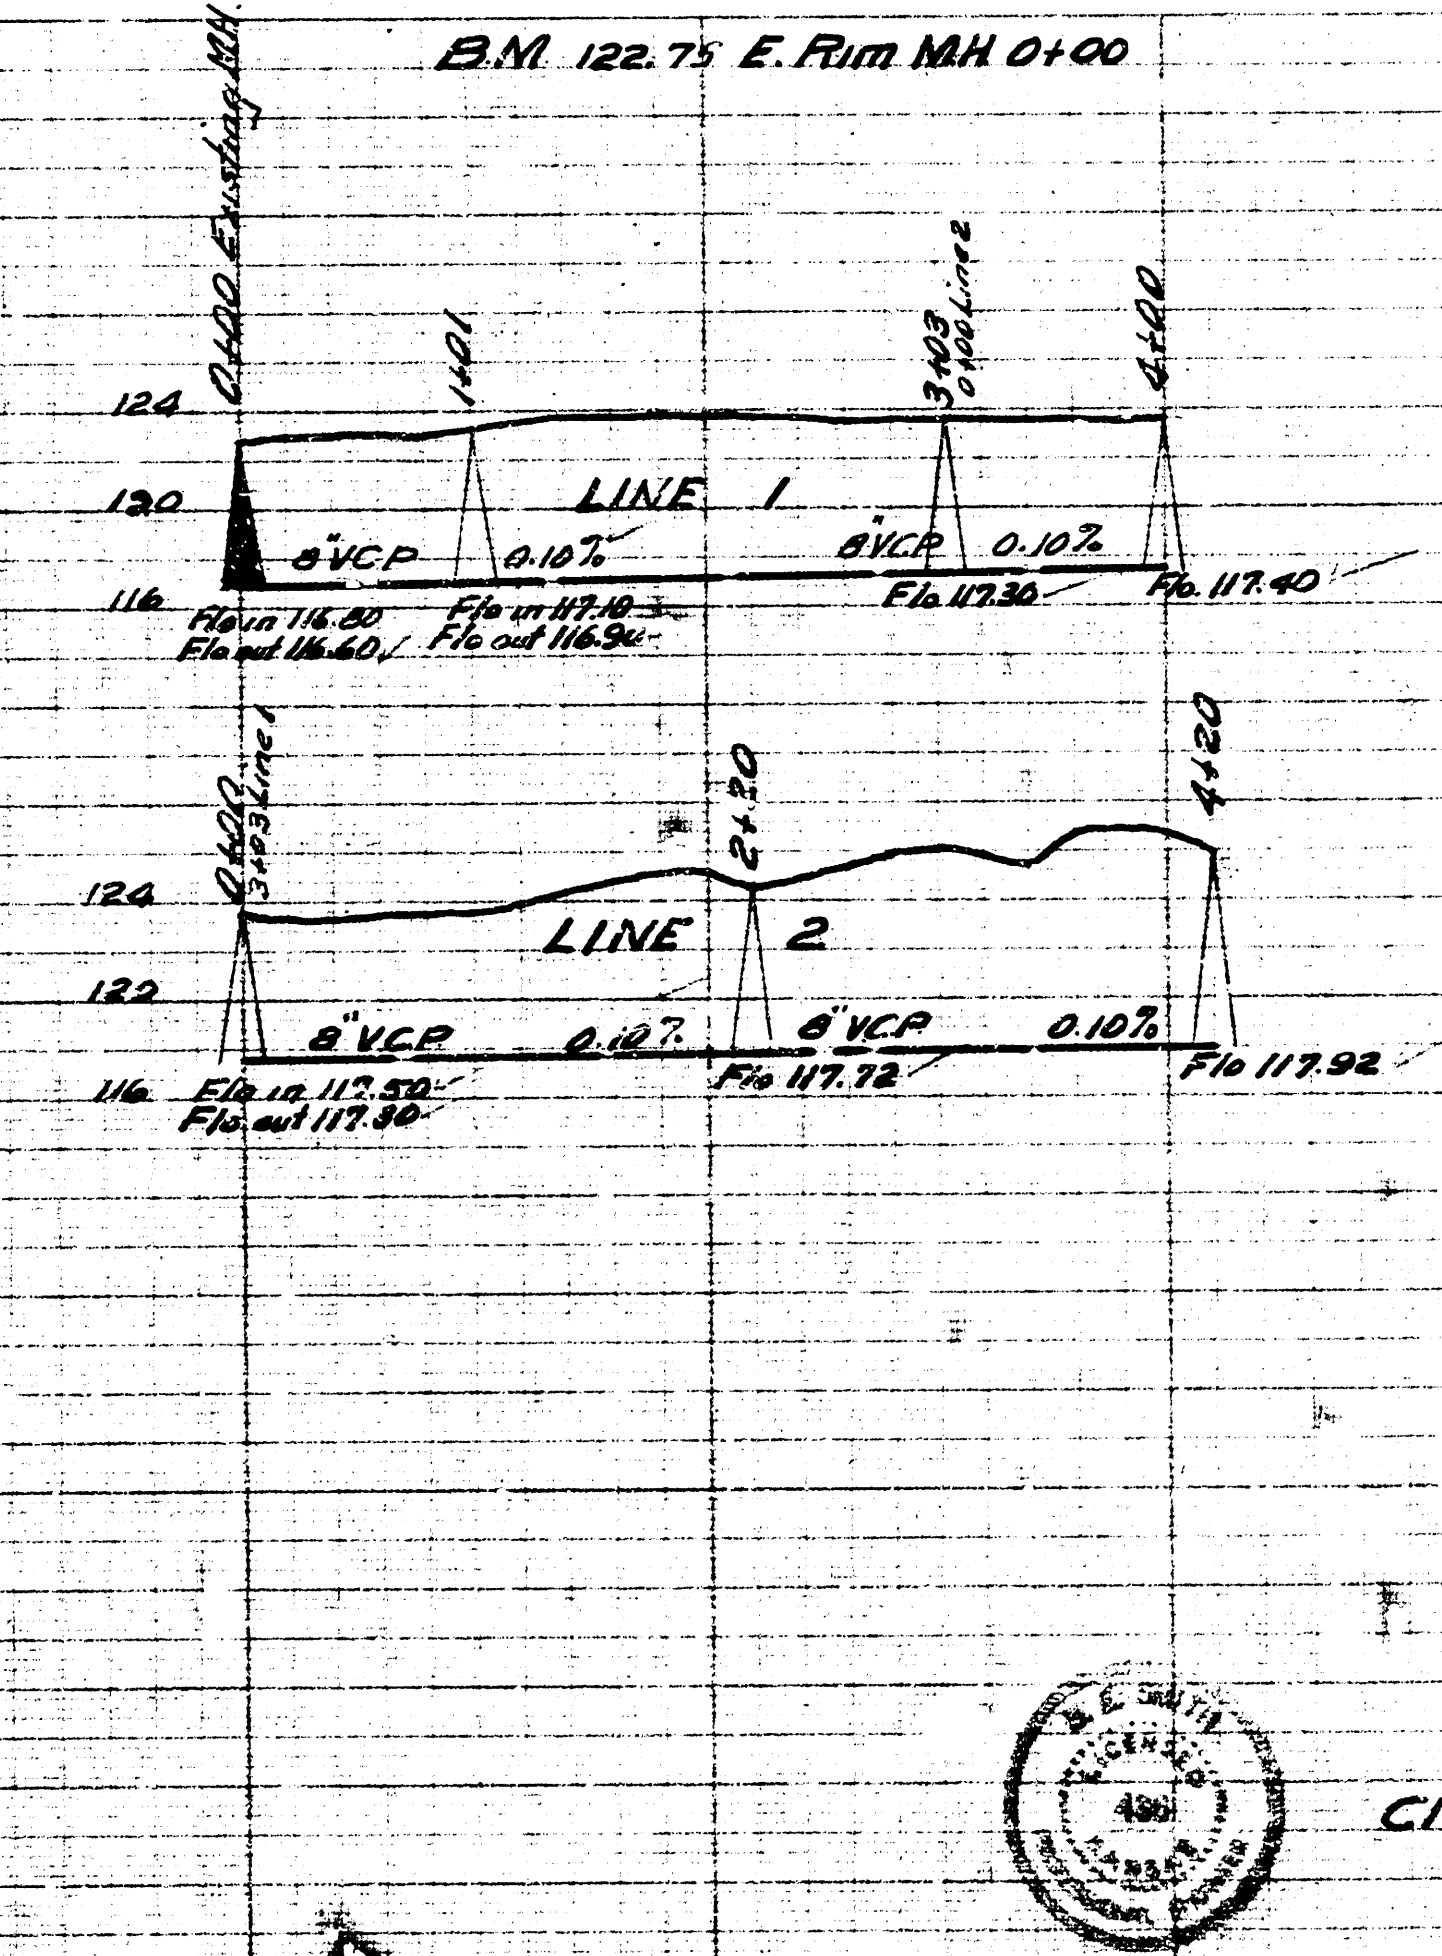

LAT. 34 DIST. T. 55.12
 CITY OF WICHITA KANSAS
 BE SMITH CITY ENGINEER
 Proj. No. C-23-44

Engineer: Please note chicken house shown to be moved by owner.