


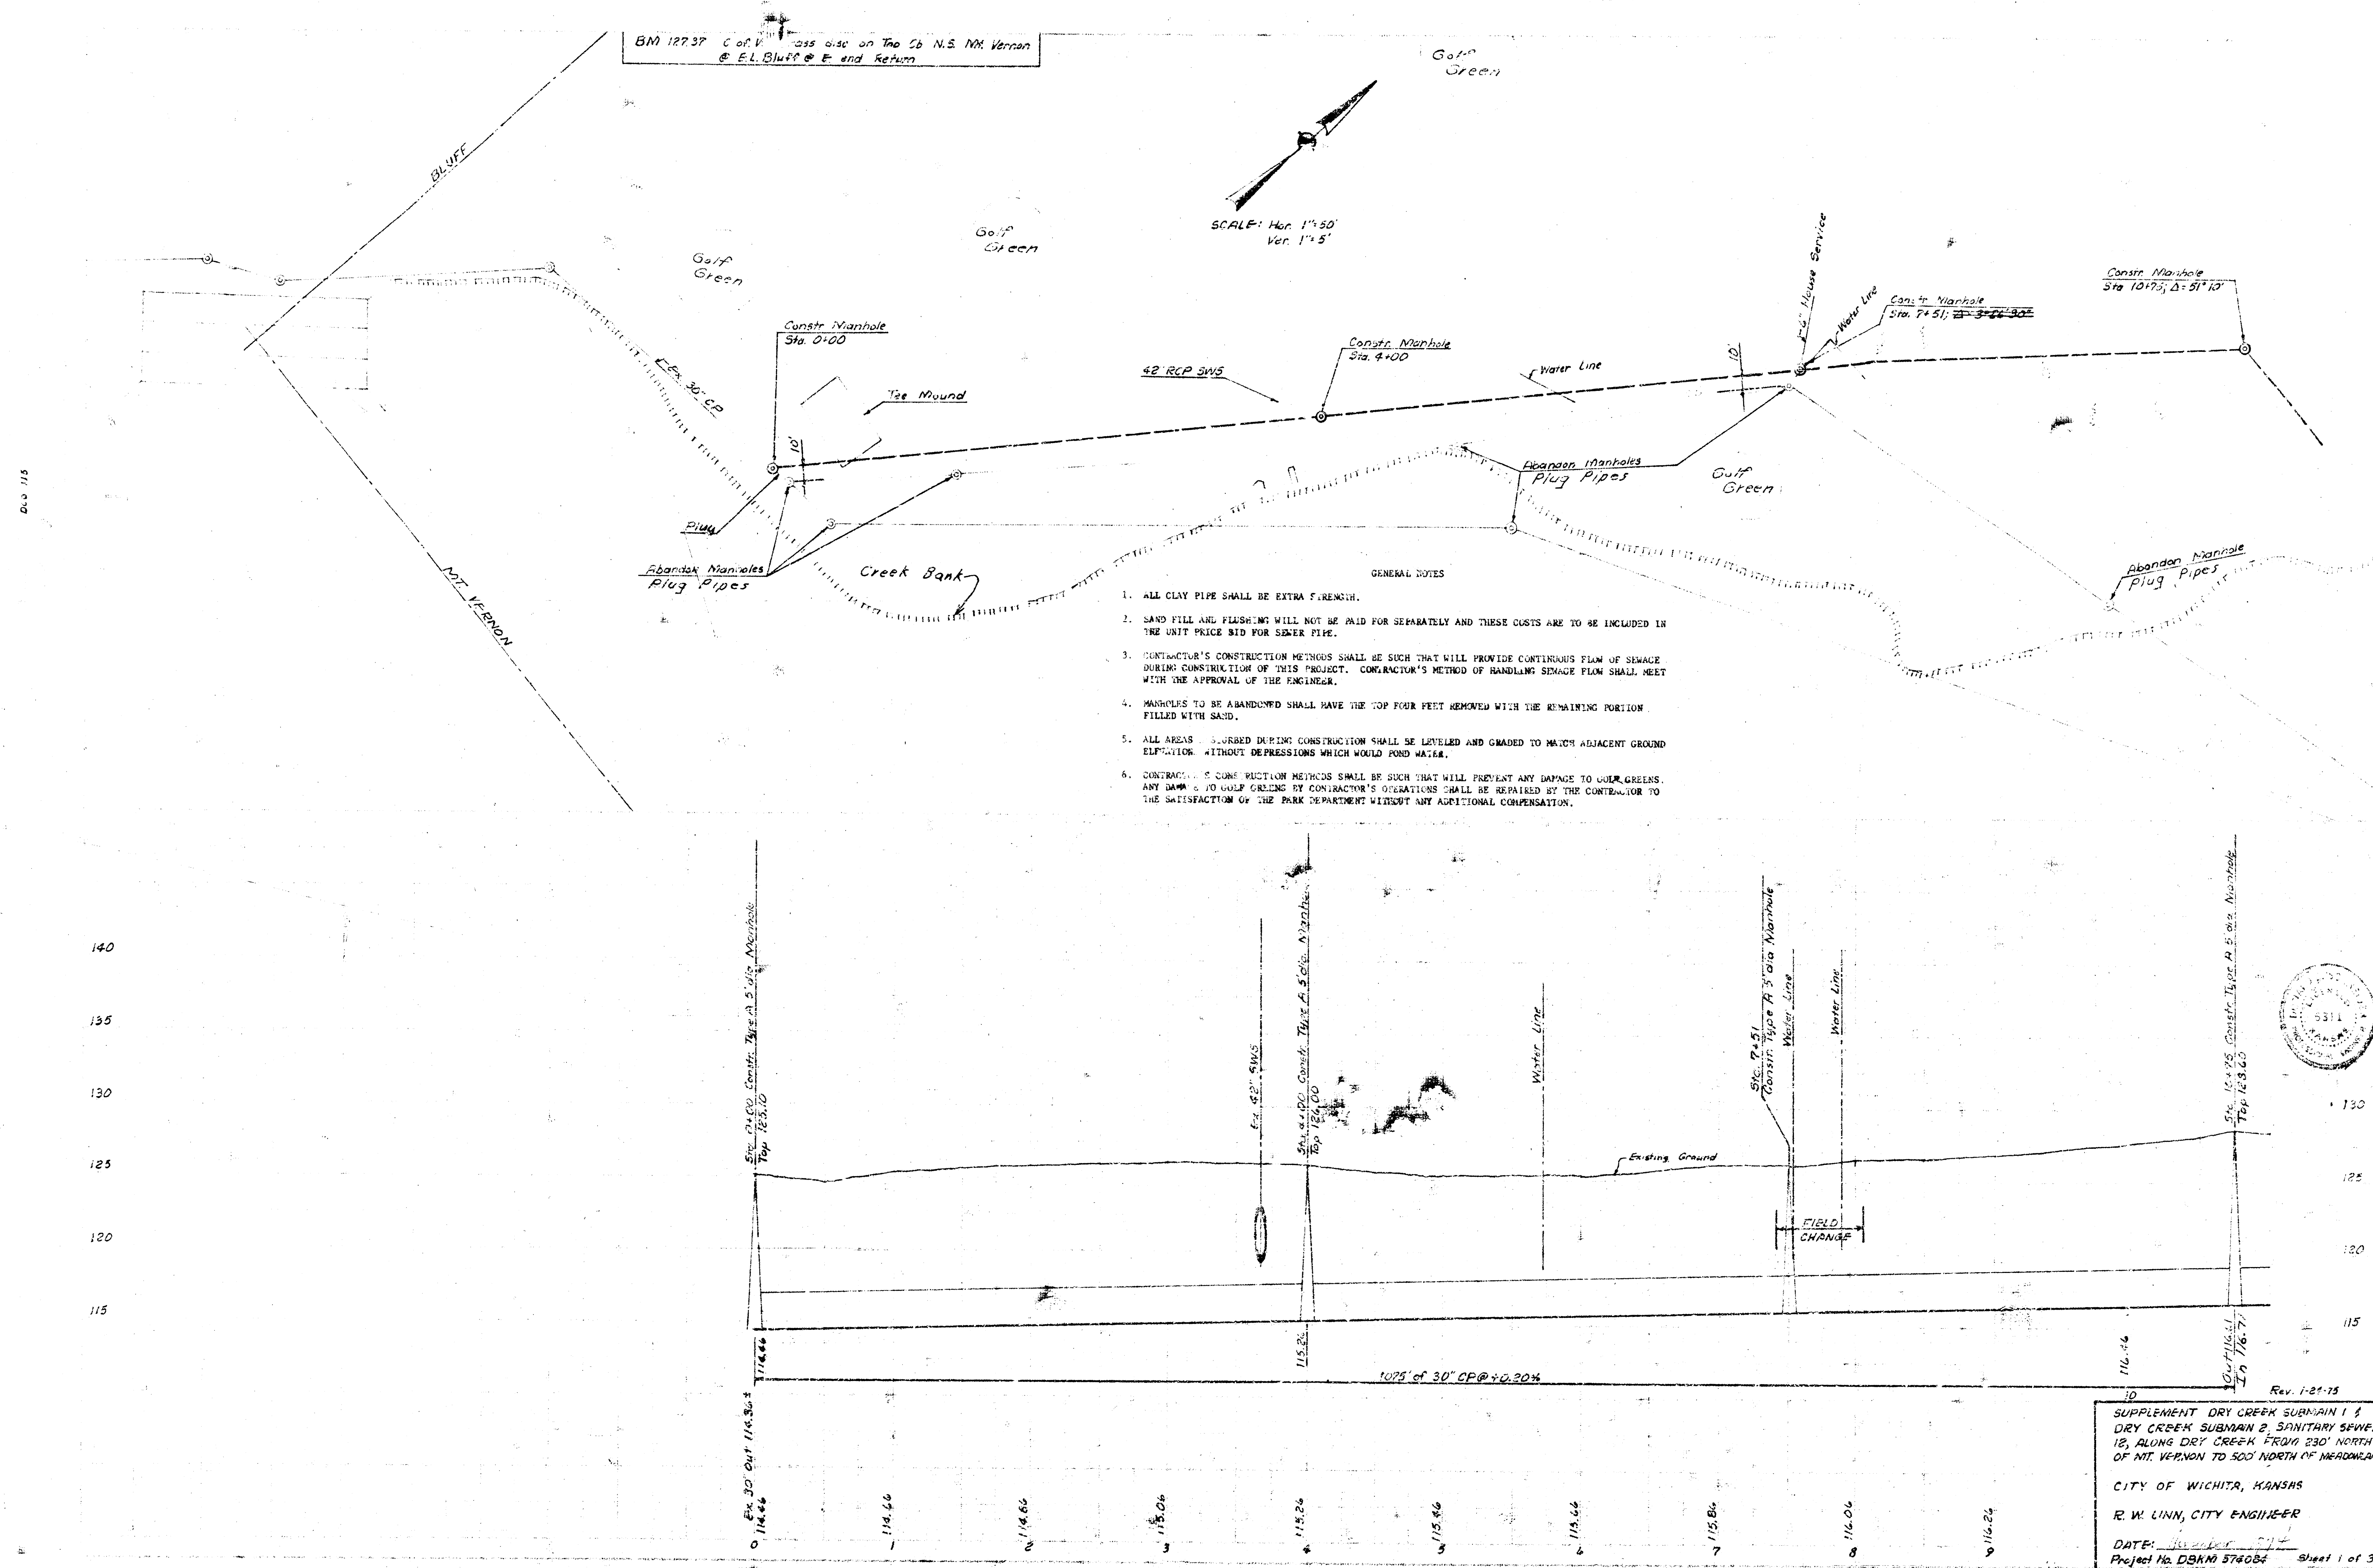



DWG 115

