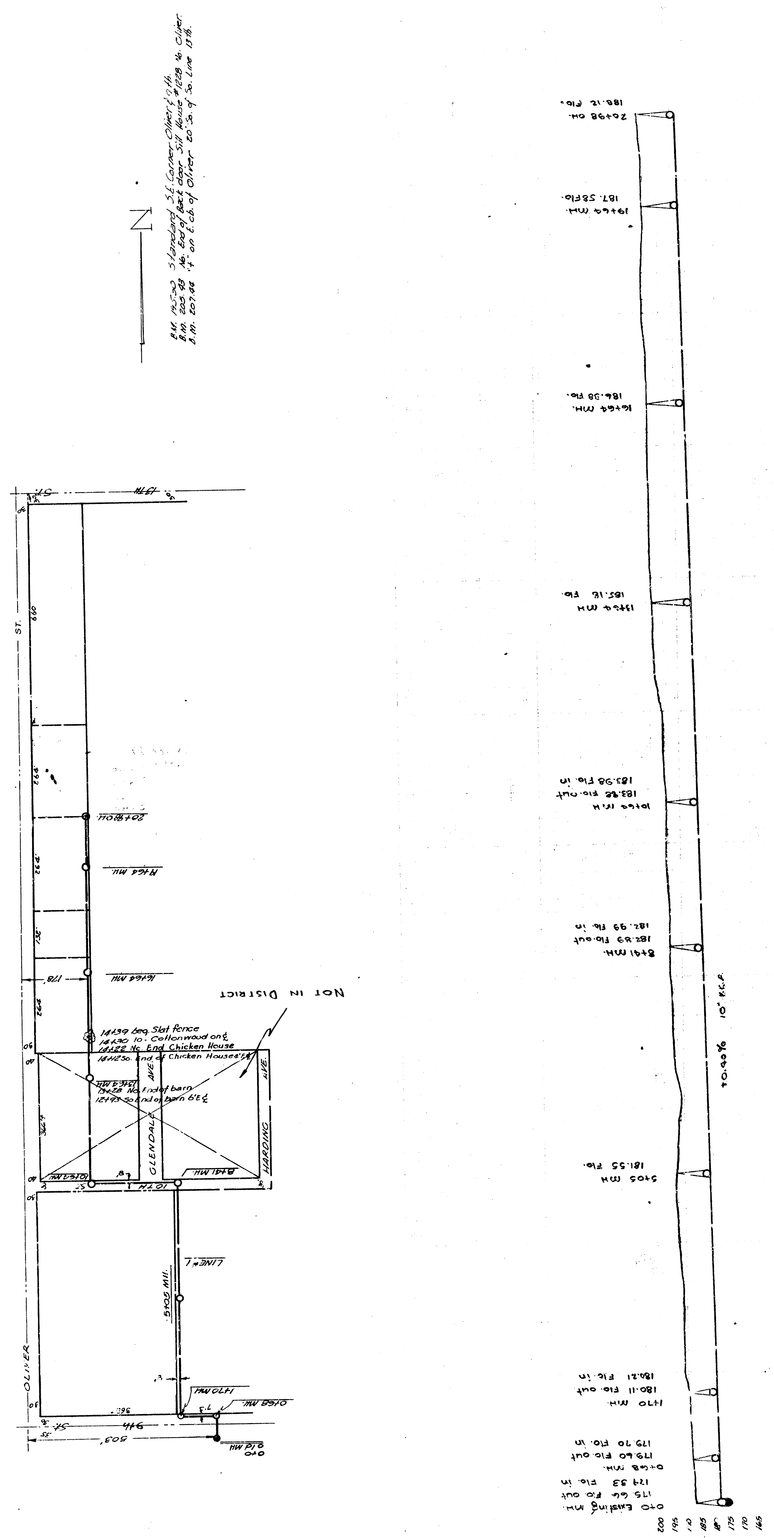
LAT. 29 D.C.S. MAIN 12
City of Wichita, Kans.
L.K. White City Engineer
Date 12-1-48 Proj. No. C28-26
Existing Mh. 175.66 Flo. out 174.33 Flo. in
1170 Mh. 180.11 Flo. out 180.21 Flo. in
3105 Mh. 181.55 Flo.
8141 Mh. 182.83 Flo. out 182.93 Flo. in
10166 Mh. 183.82 Flo. out 183.92 Flo. in
20498 Ch. 188.12 Flo.
Oliver St.
Glendale Ave.
Harding Ave.
Barn
Not in District
Line "L"
