
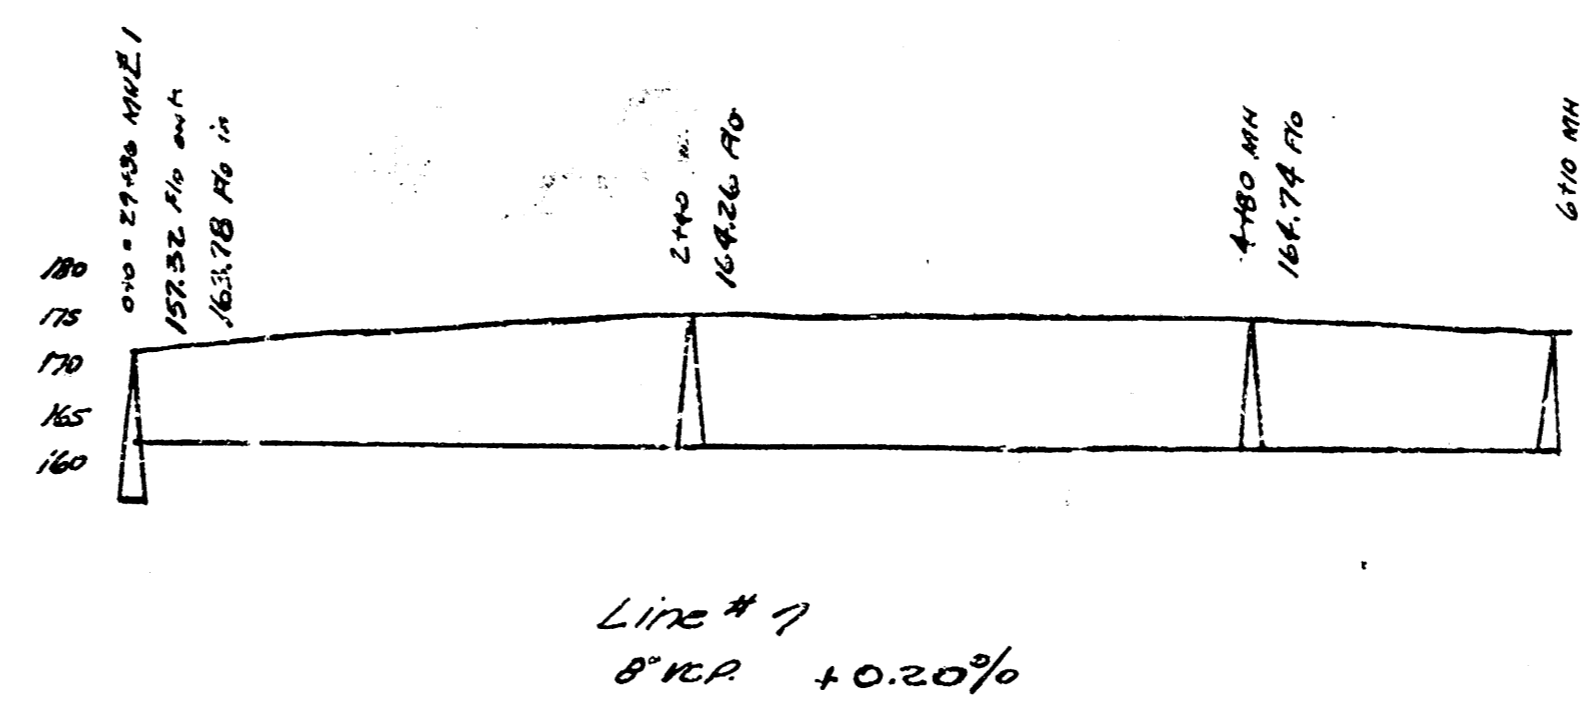
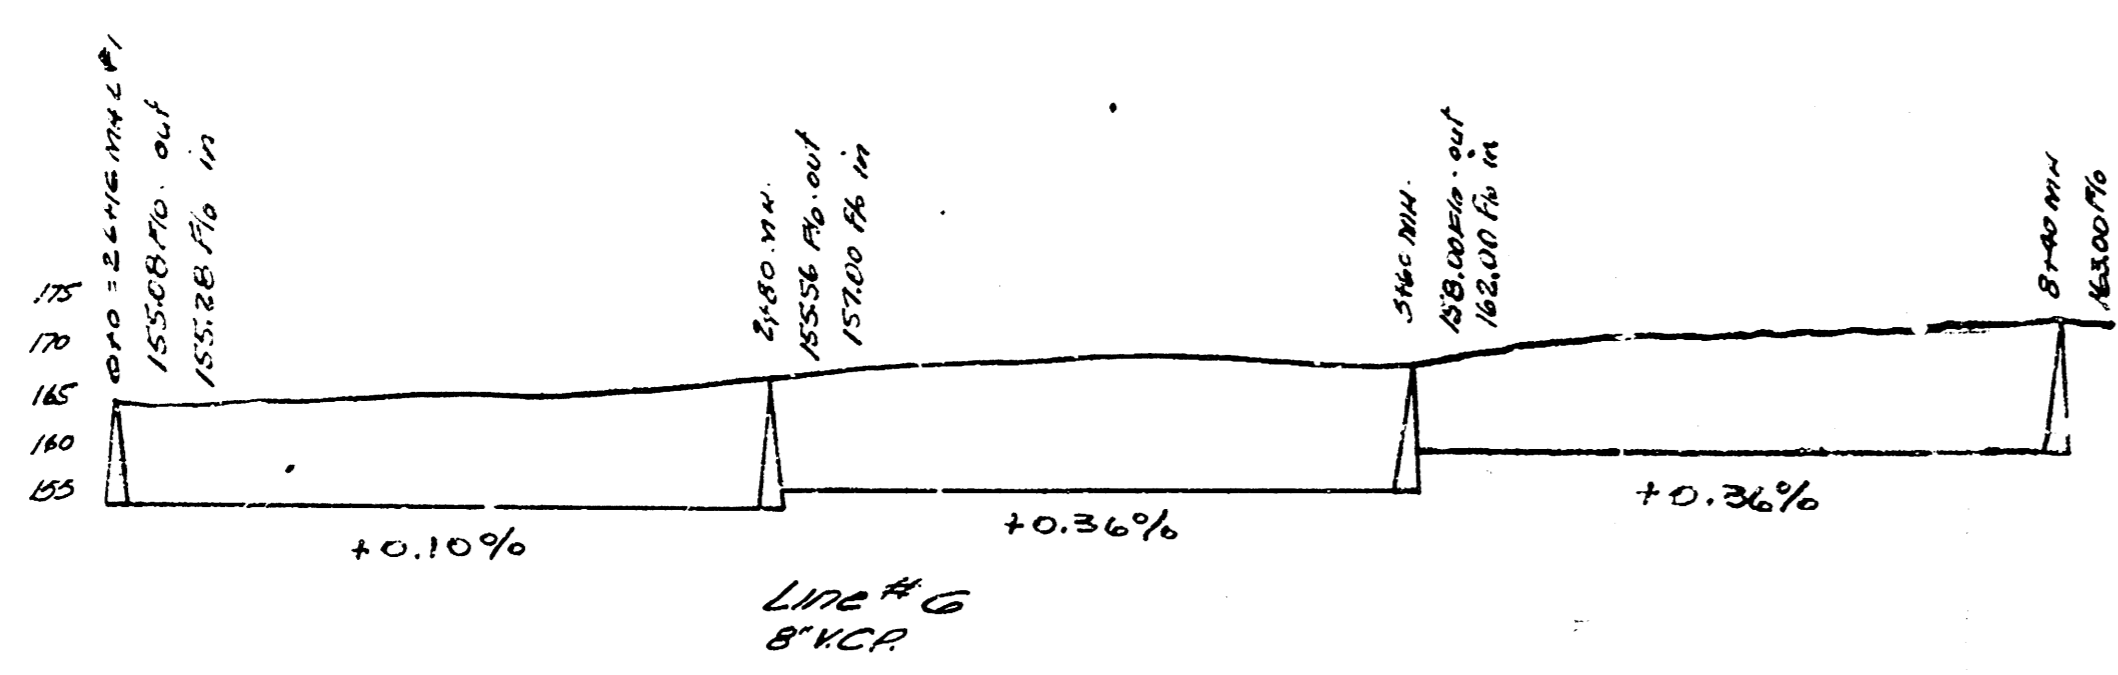


B.M. 163.95 X IN W. RM. M.H. C. E. & 45' S. of S.E. COR.
 STL. FENCE VETS. HOSP.
 B.M. 164.19 'G' IN GLOBE S END RAD. W. S. EDGE MOOR.
 & S.P.L. ENGLISH.
 B.M. 166.08 N.E. COR. CULVERT HEADWALL @ DOUGLAS
 & BROOKSIDE.

LAT. 35. DRY CREEK SUBMAIN, S. S. #12
 CITY OF WICHITA, KANSAS
 L. K. WHITE CITY ENGINEER
 AUGUST 1949 Proj. No. C 29-10

SEE PAGE 1
FOR LINE LAYOUT

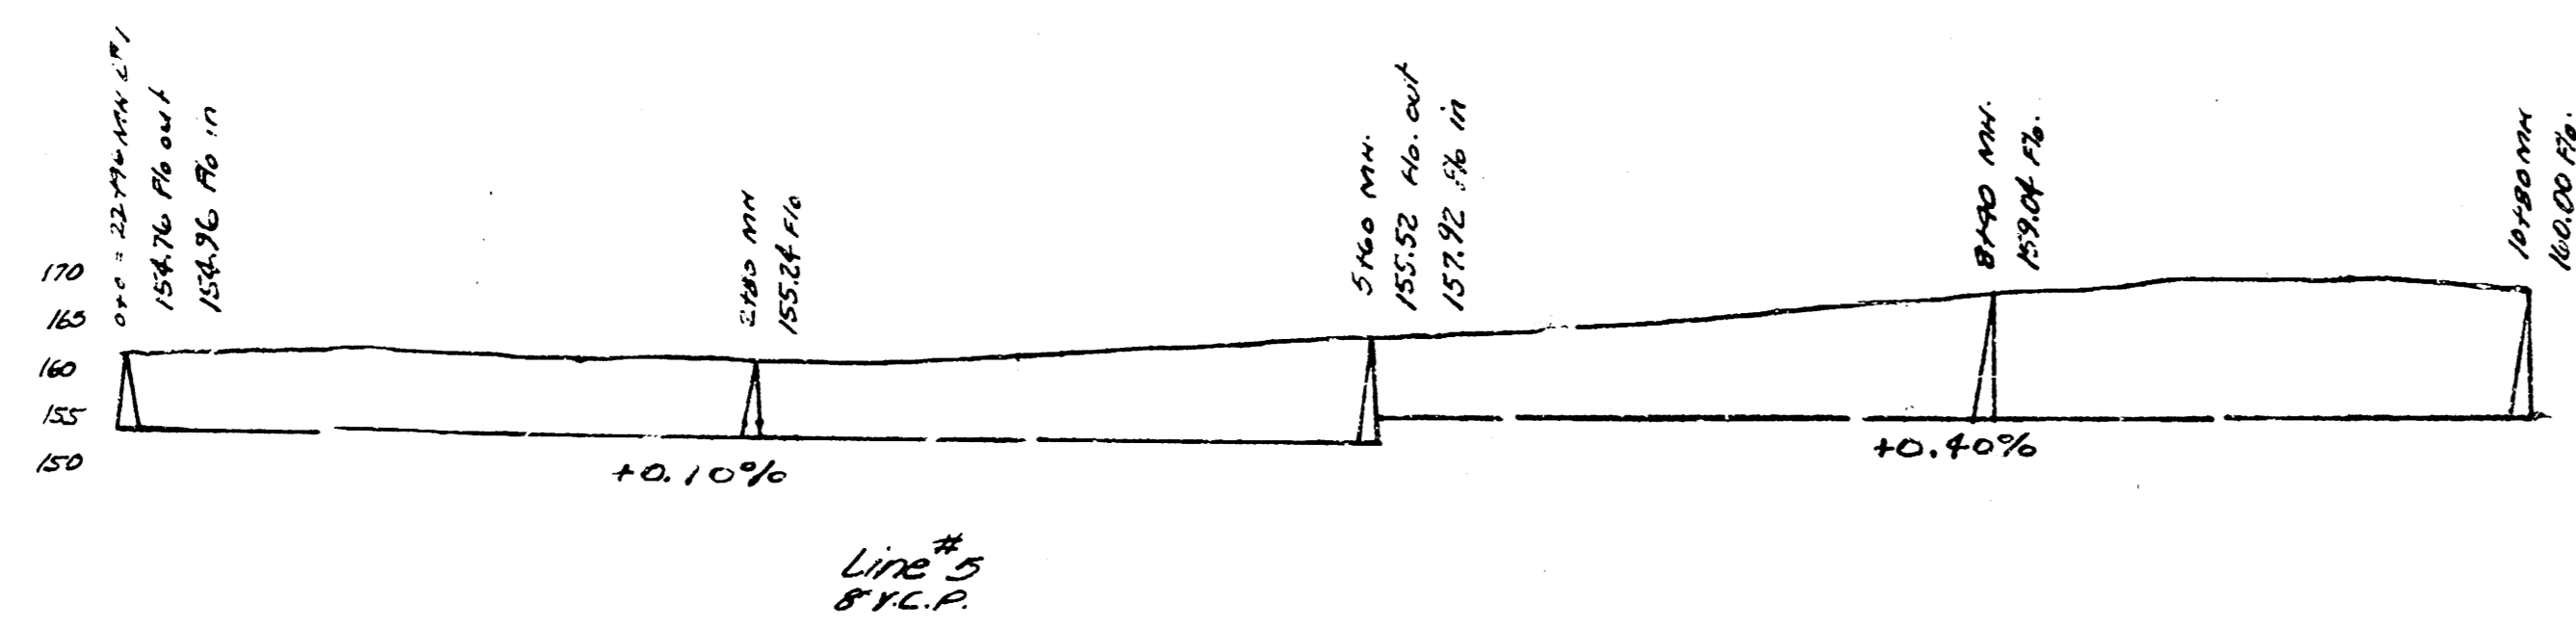

LAT3 DRY CREEK SUBMAIN S.S.#12
City of Wichita, Kans.
L.K. White City Engineer
Aug. 1949 Proj. No. C-29-18