

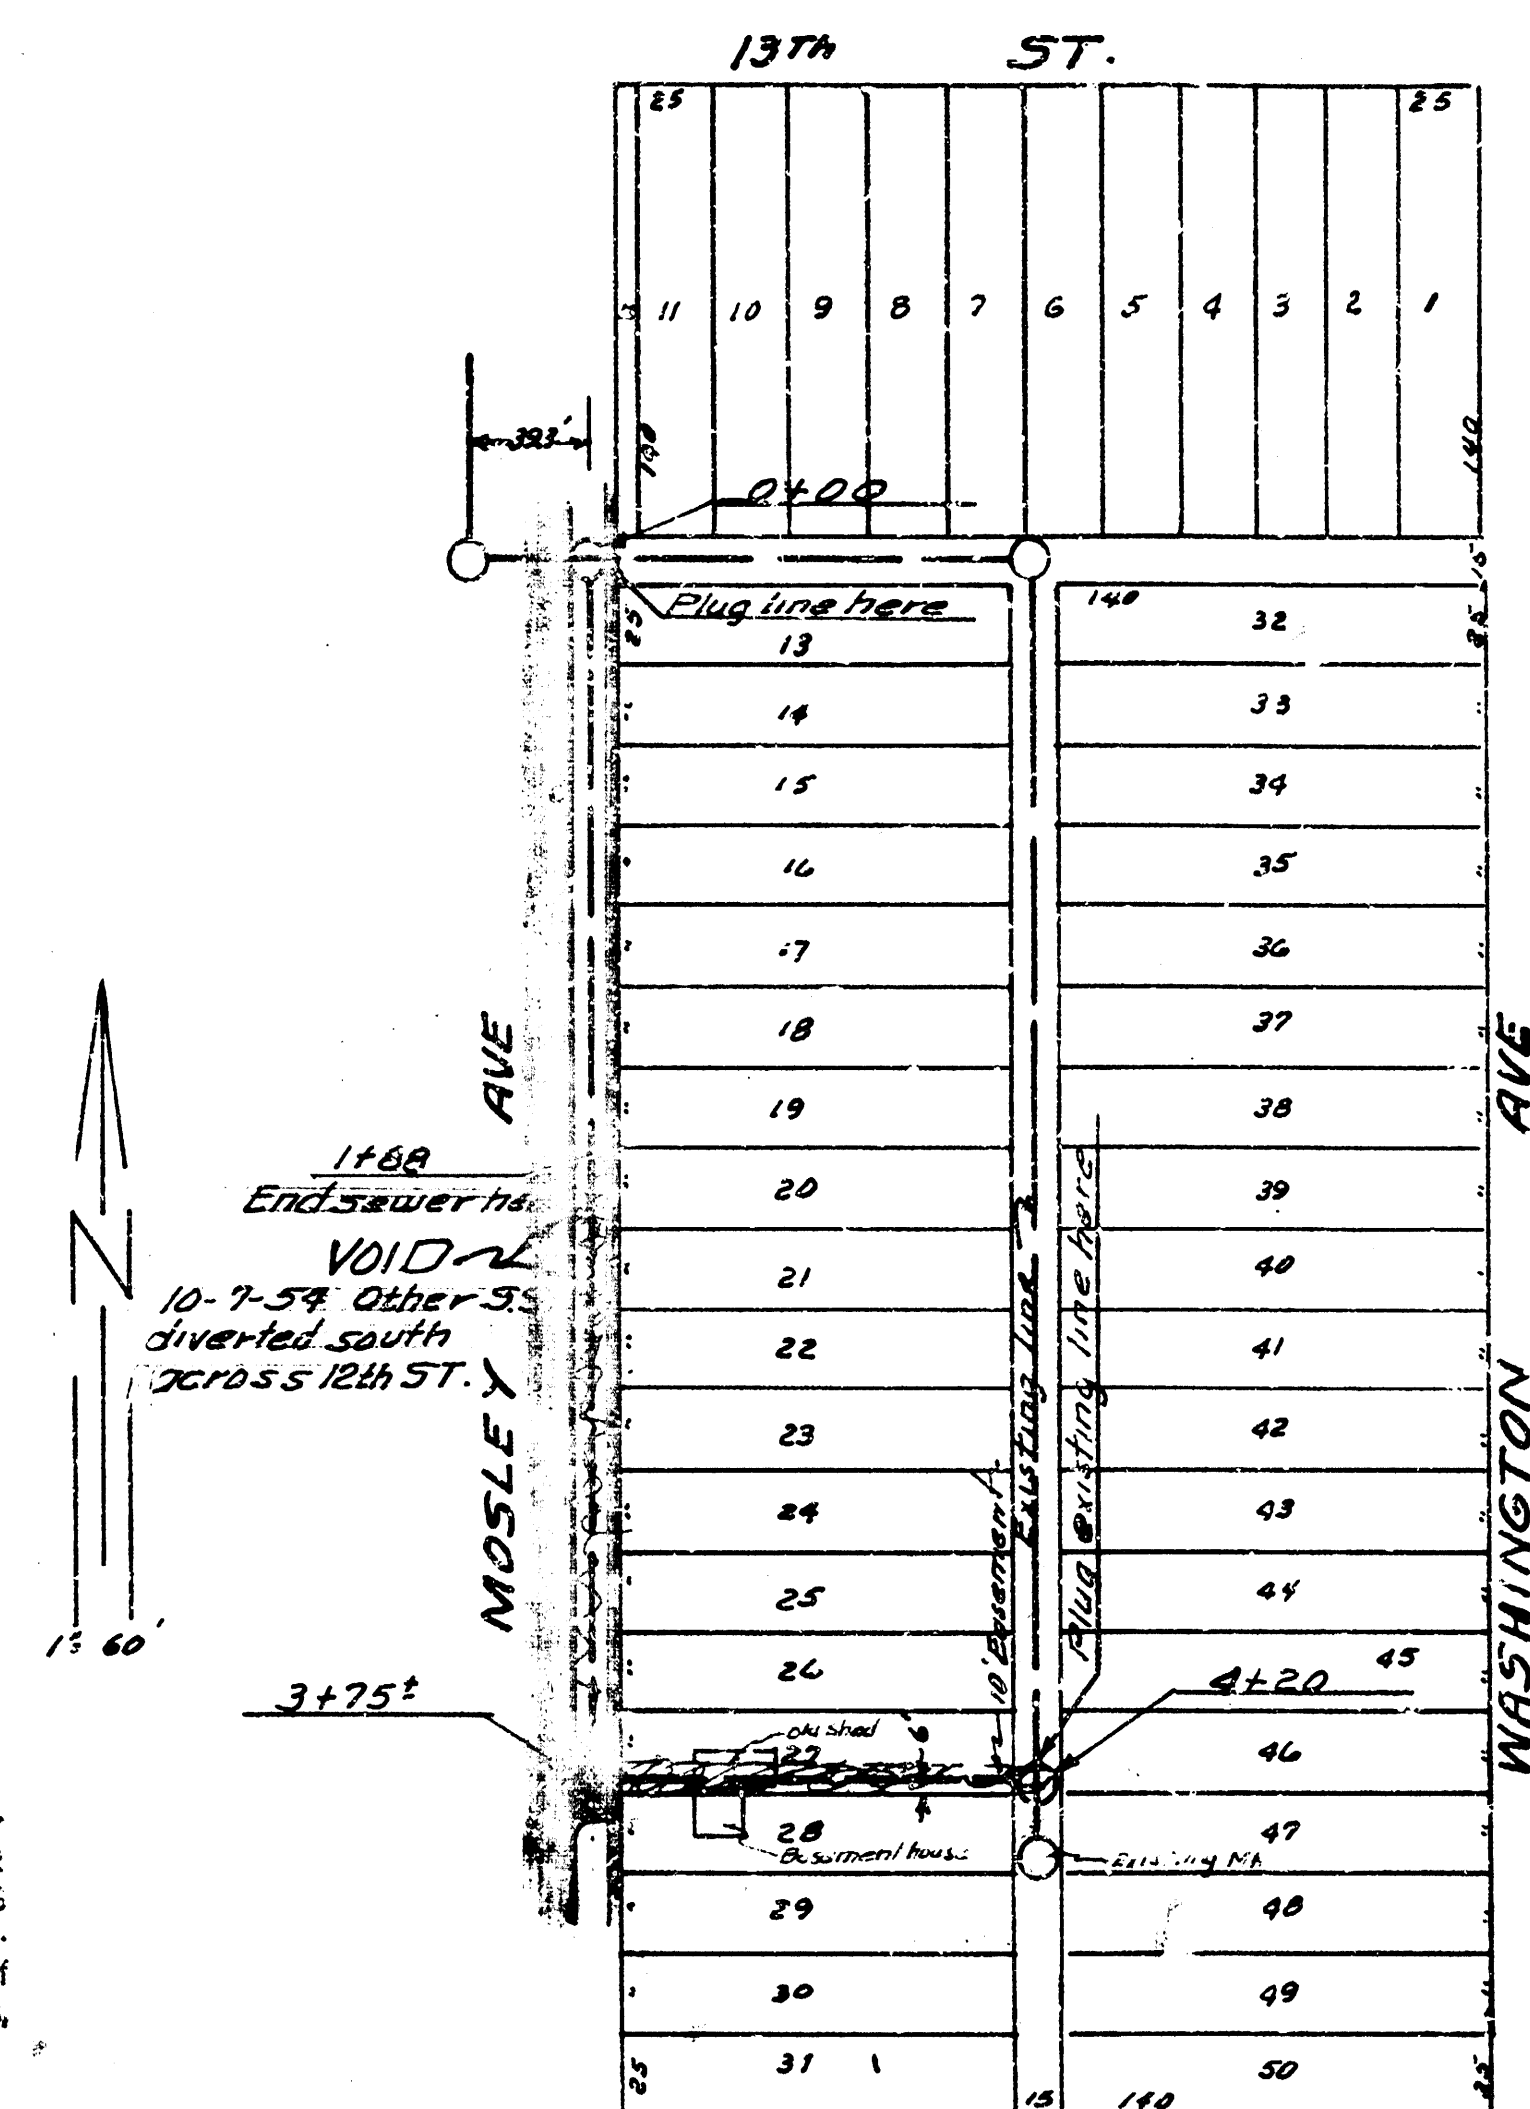


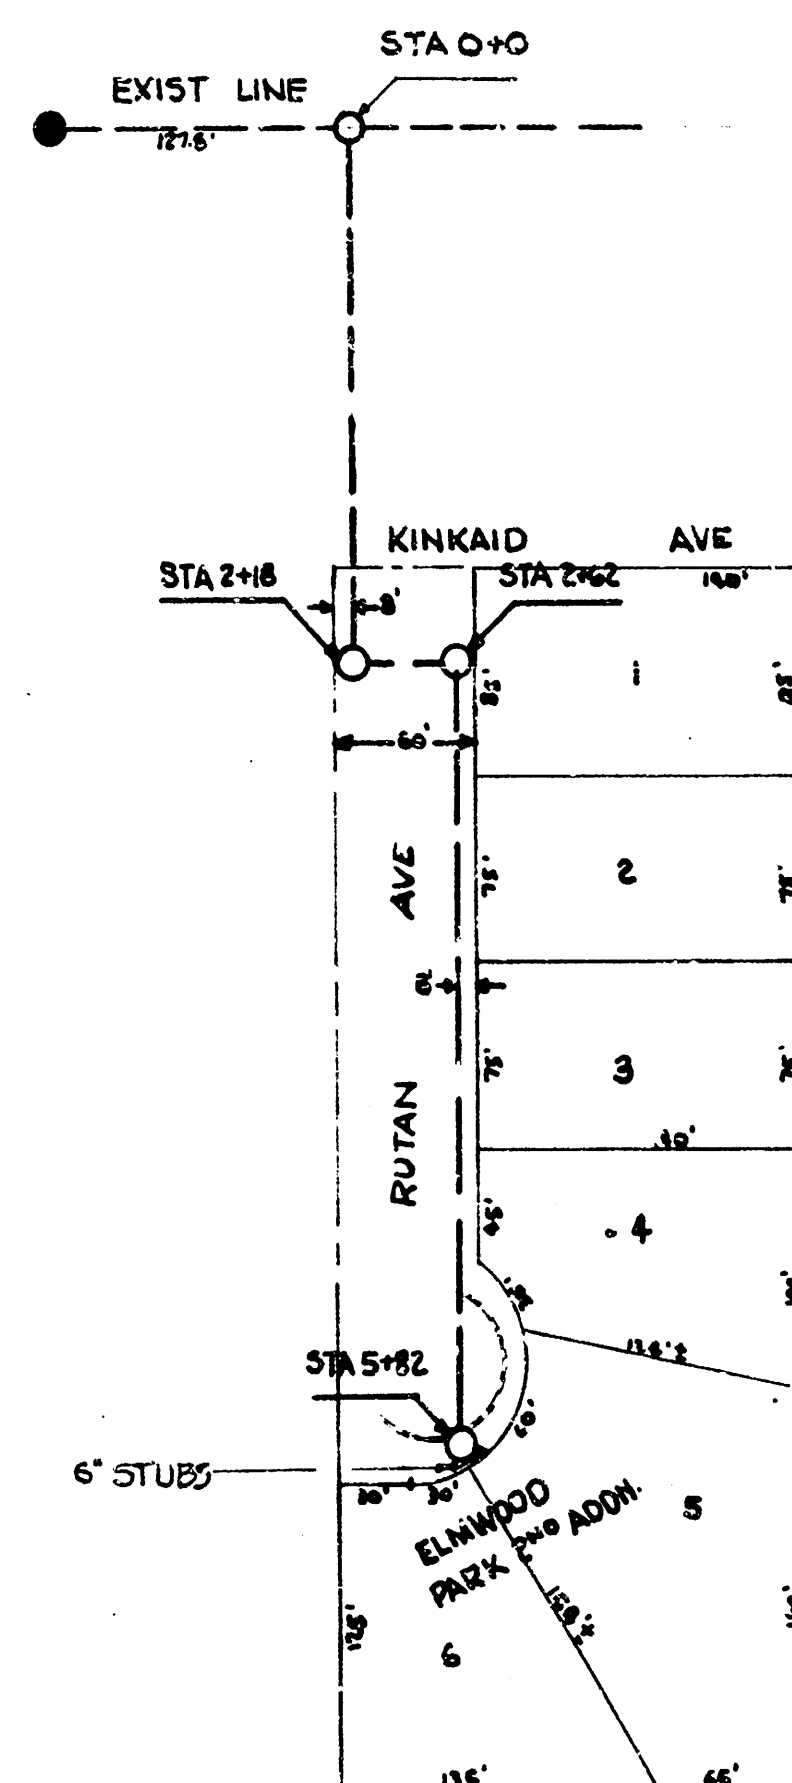


NOTE TO CONTRACTOR
The profile will be constructed under the supervision of the CITY ENGINEER and CONTRACTOR. The CONTRACTOR will reimburse the City of Wichita for all cost of Engineering, Plans, and Inspection.

B.M. 10127 LARGE STAPLE N. FACE RR. S.W. COR. RUTAN & KINKAID

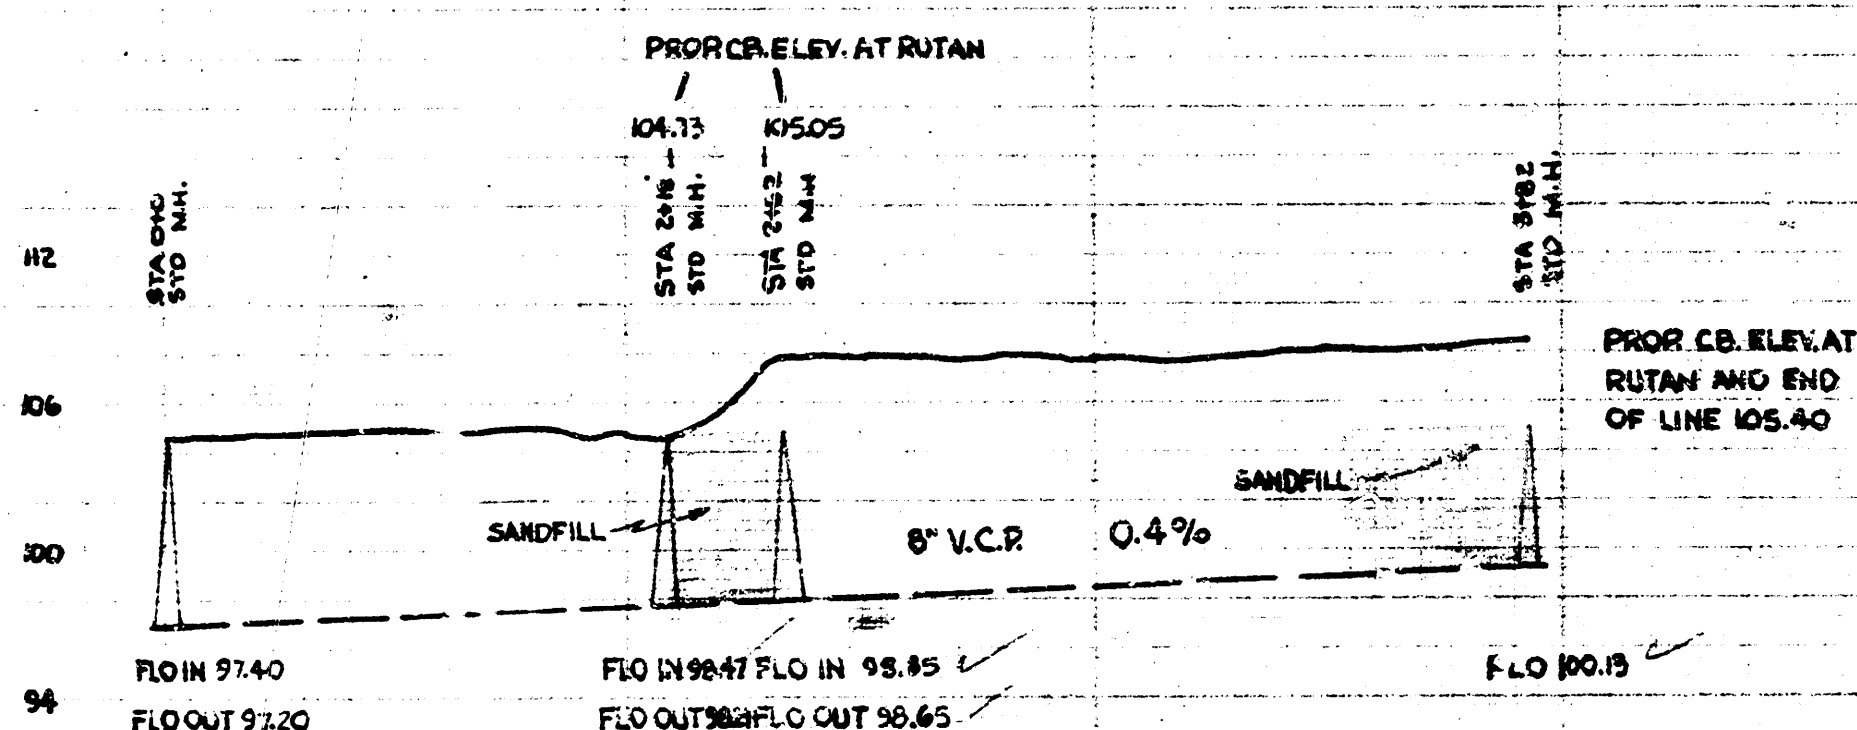

B.M. 116.16 E. FROM M.H. 393 West of 0+00

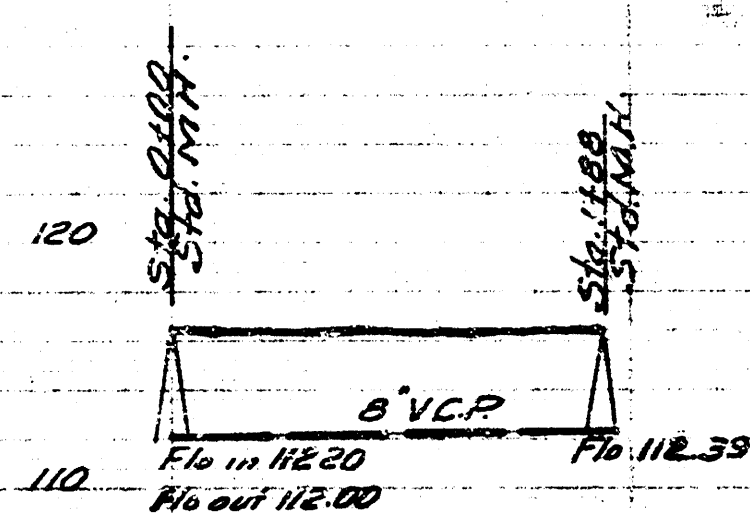

LAT 38 D.C.S. #2 S.S. 12
CITY OF WICHITA, KANS.
B.E. SMITH CITY ENGINEER
PROJ. NO. C 24-42

PRIVATE SEWER
ROCK ISLAND LUMBER CO.
CITY OF WICHITA, KANSAS
B.E. SMITH CITY ENGINEER