
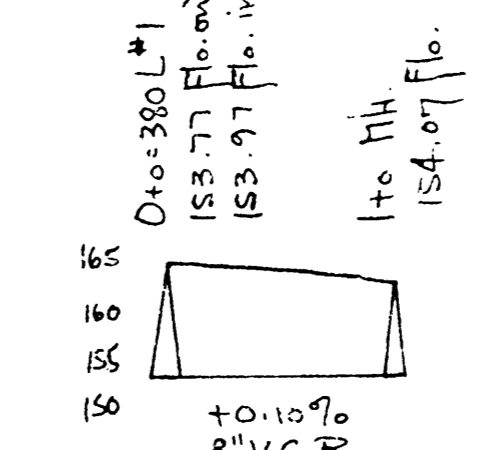
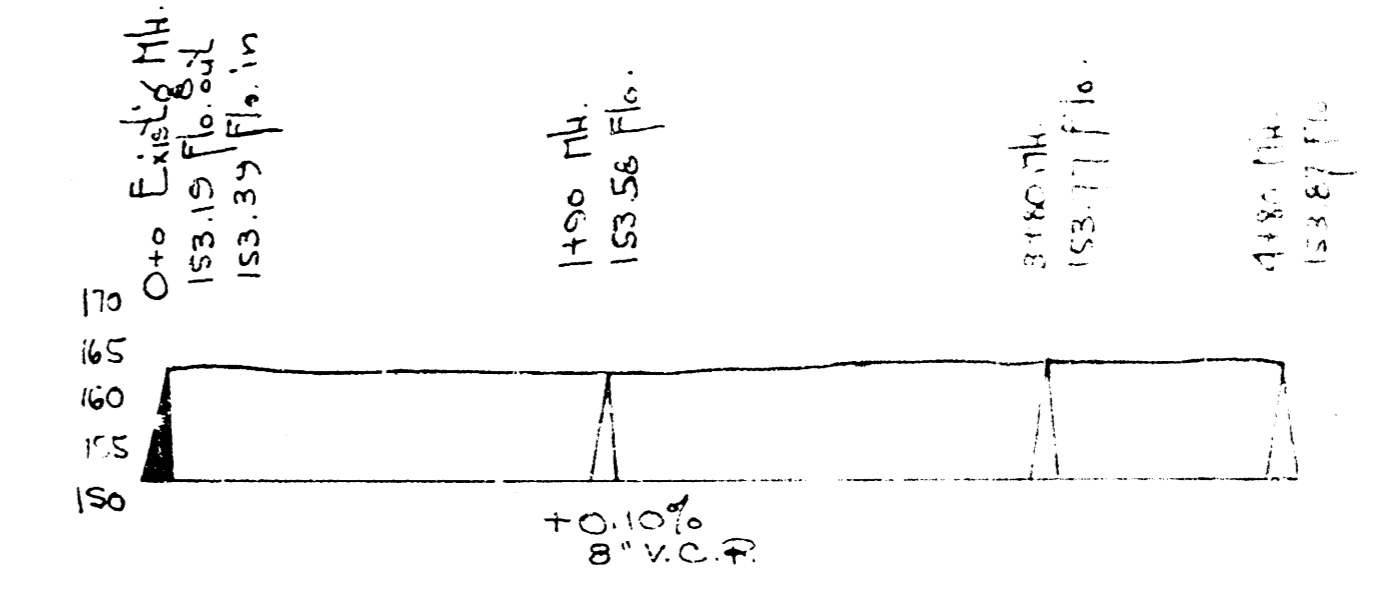
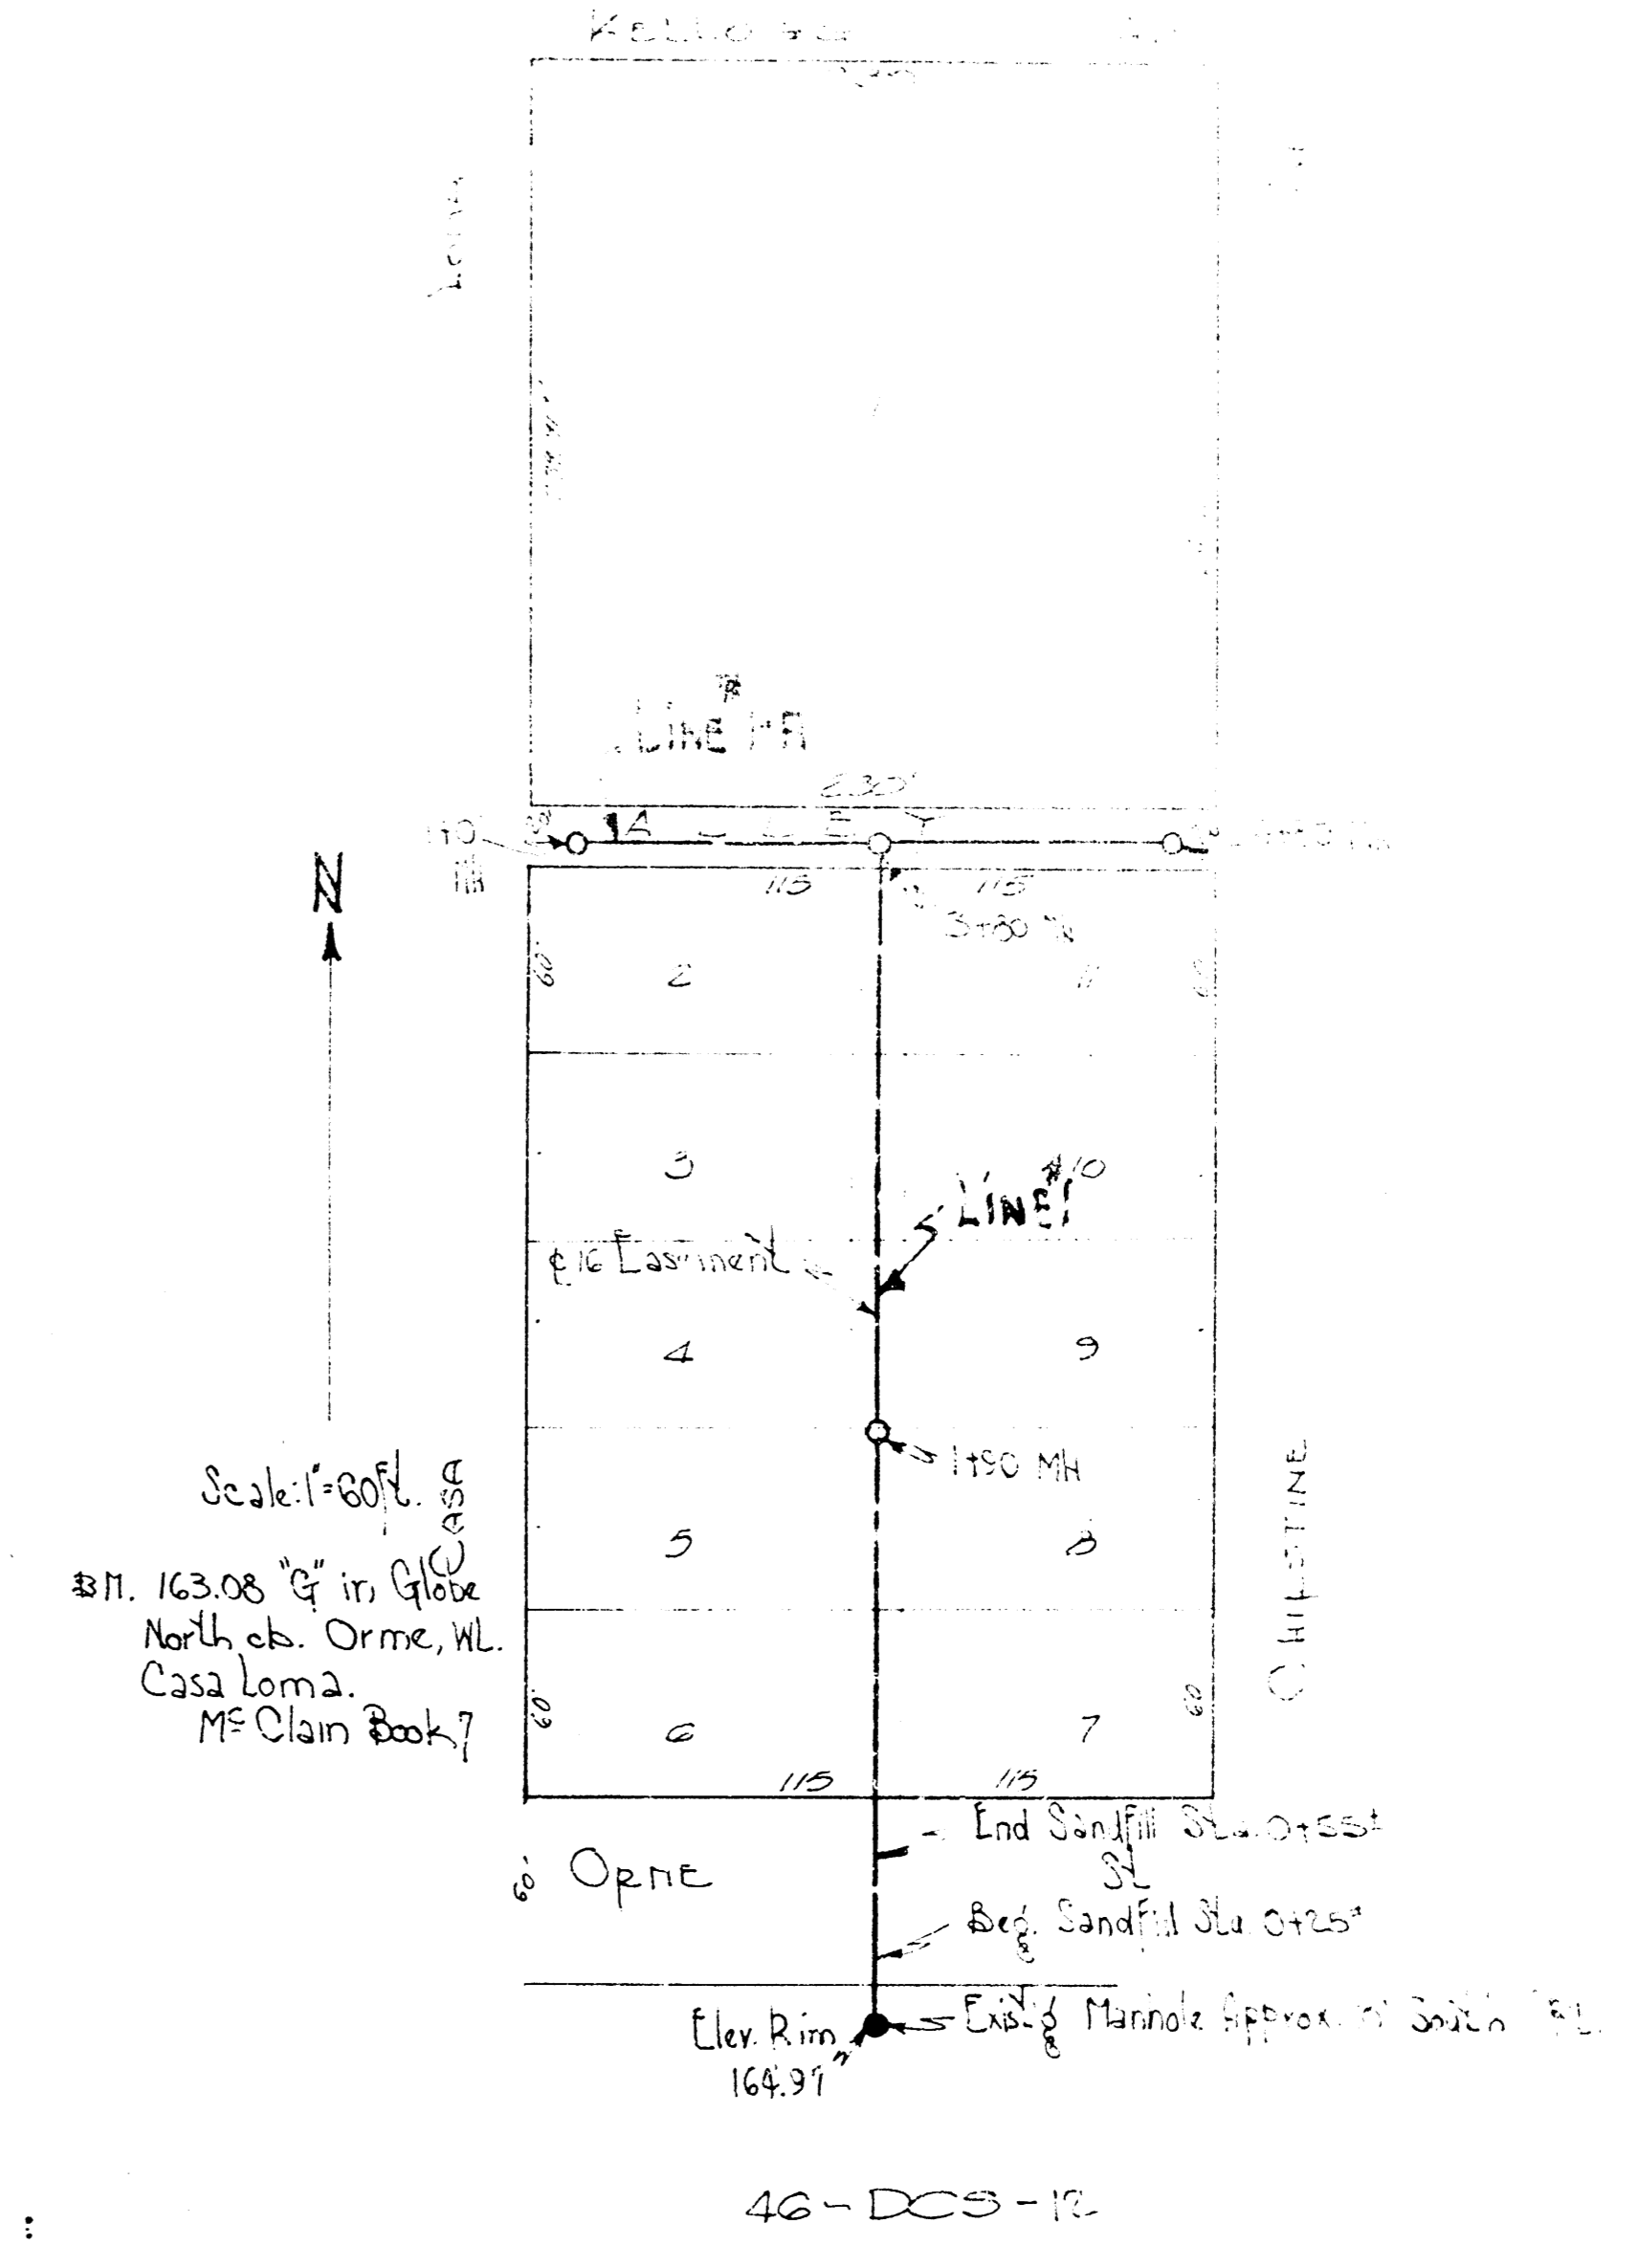
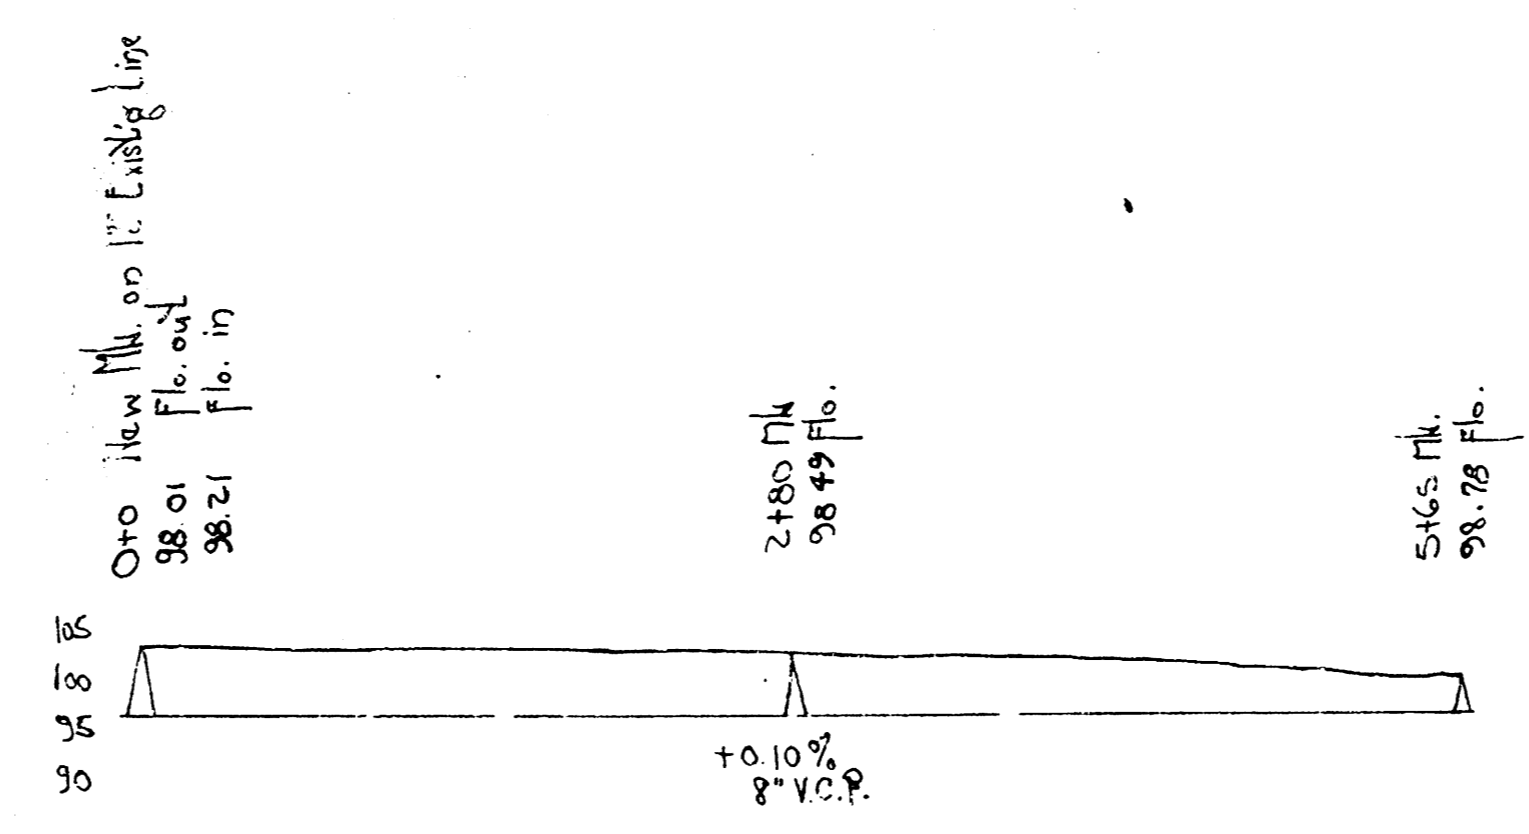
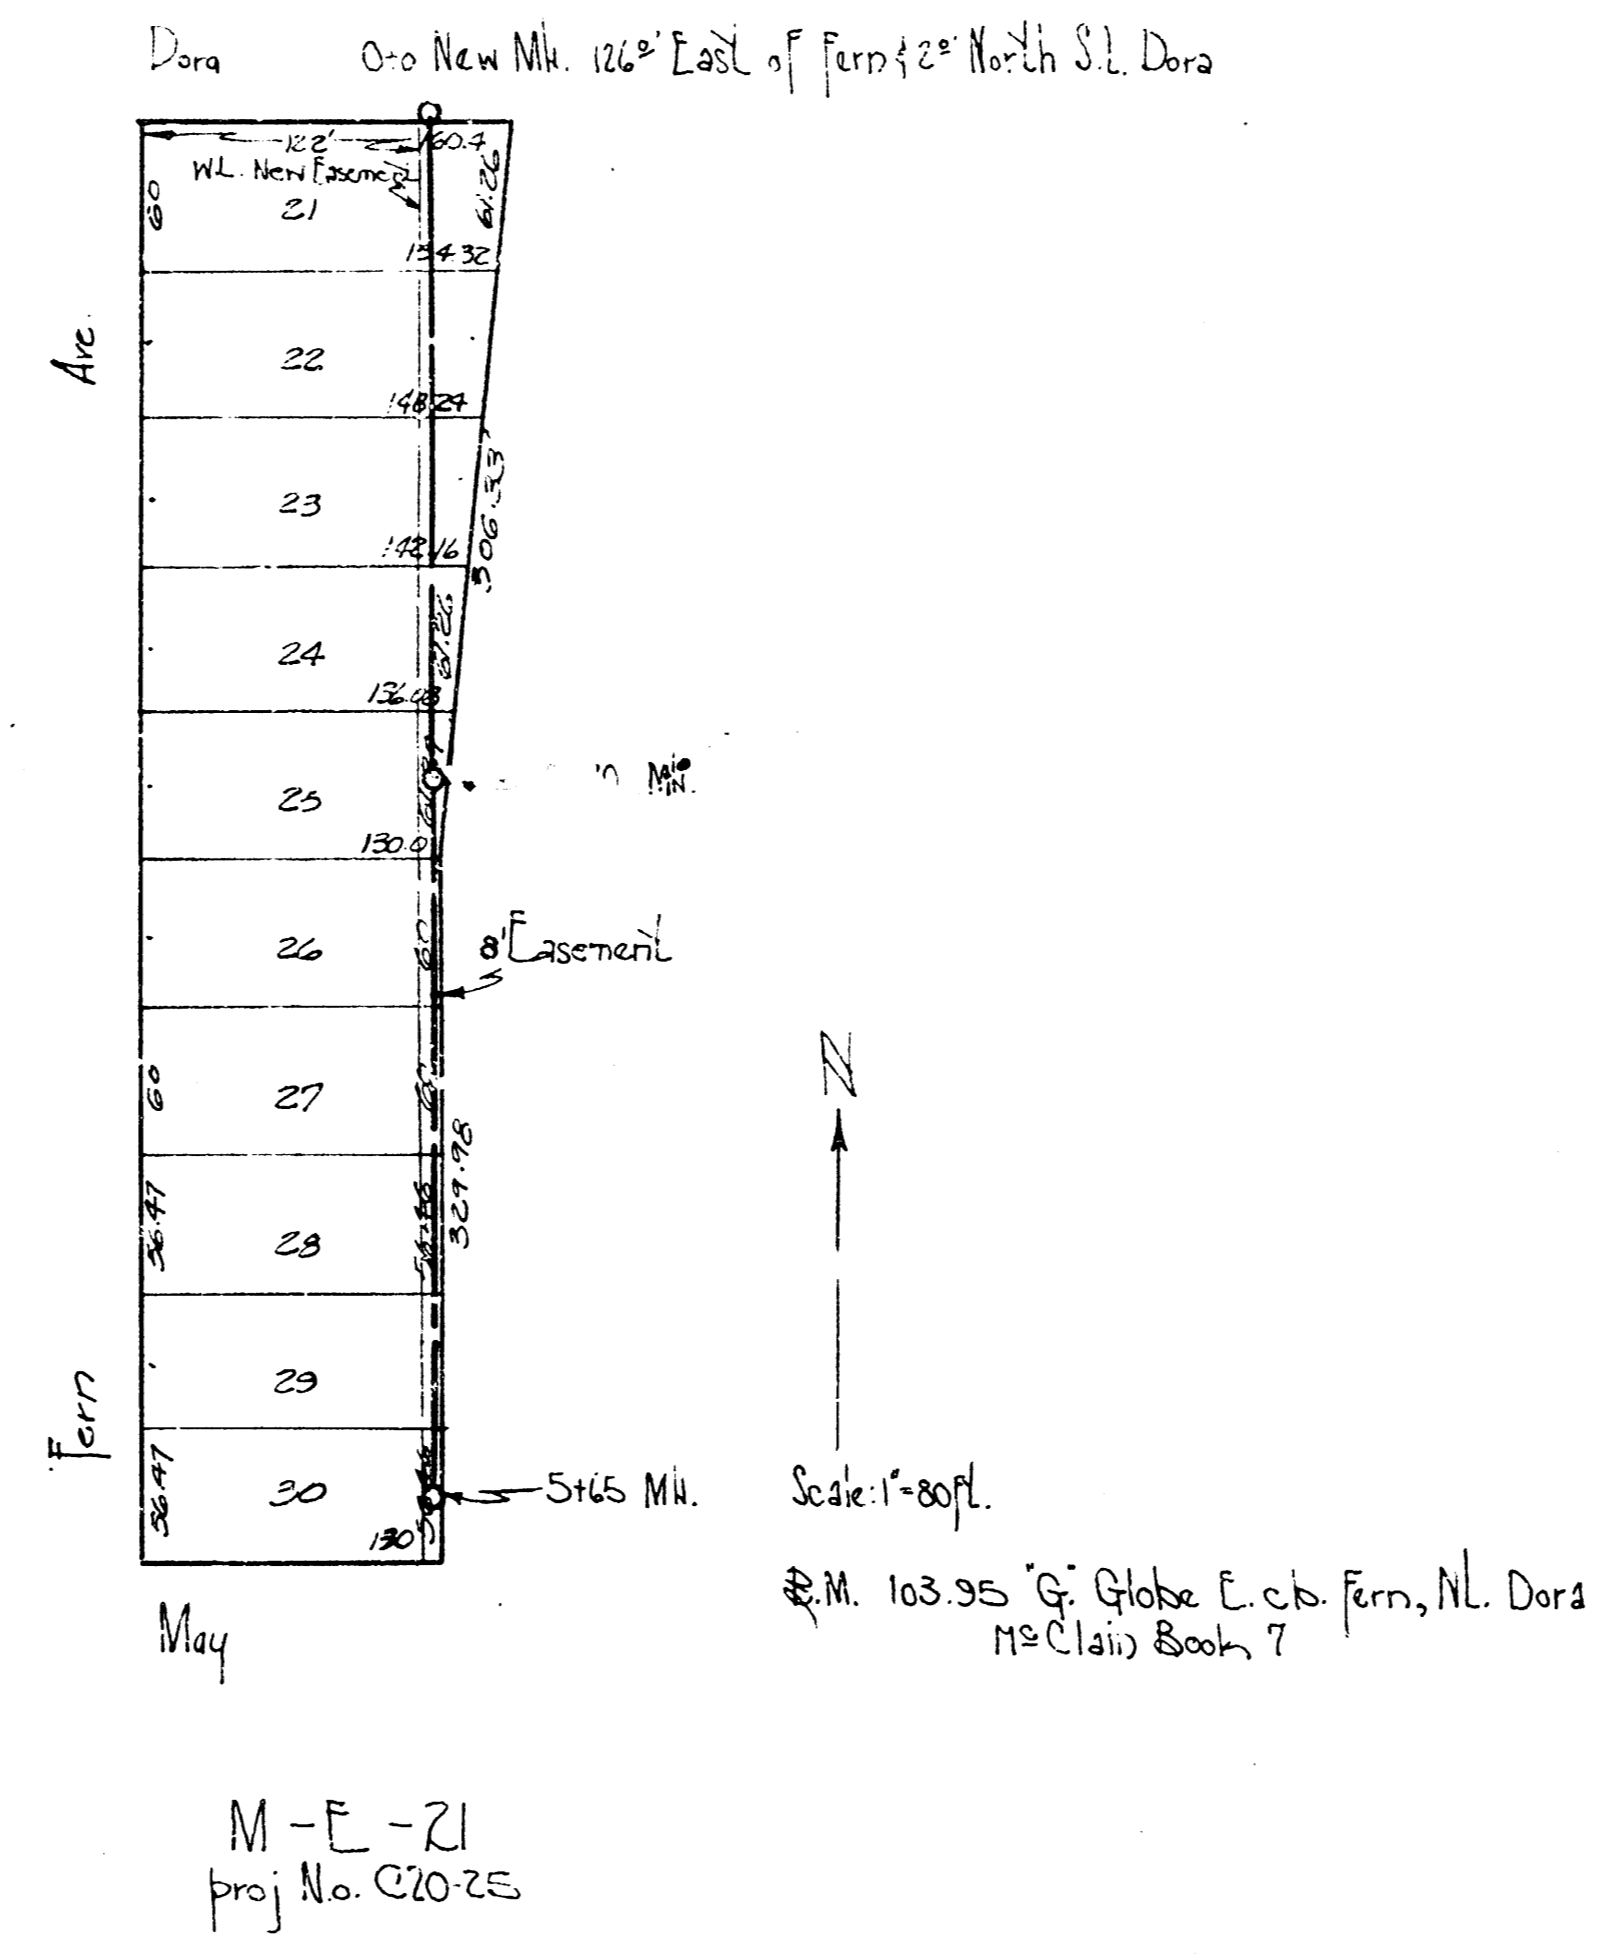
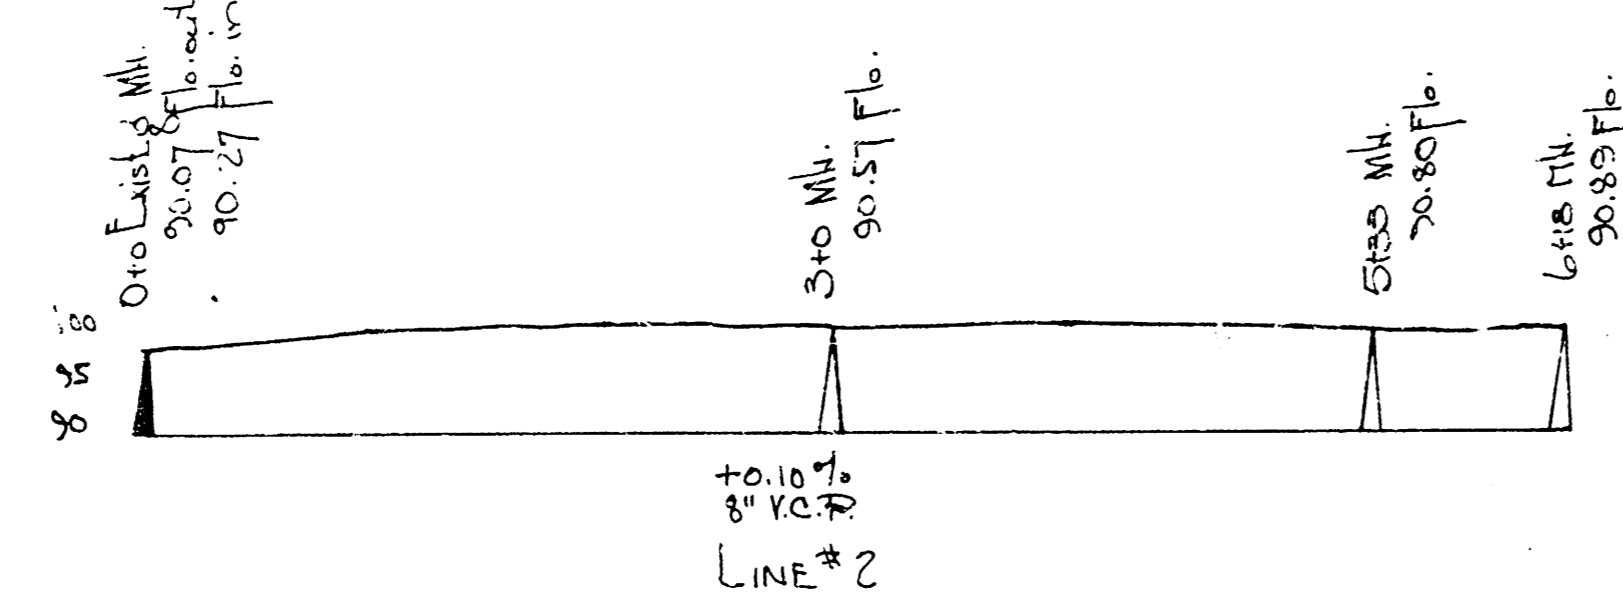


15-18-20
C20-34

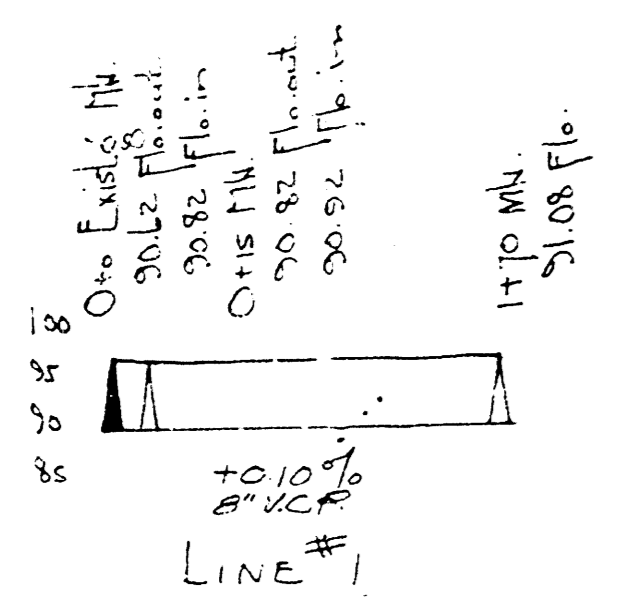

LAT. 15, DIST. 2, SS# 20
" M, " E, " 21
" 42, D.C.S., " 12
City of Wichita, Kansas
L.K. White - City Engineer
Date - 5-25-50