

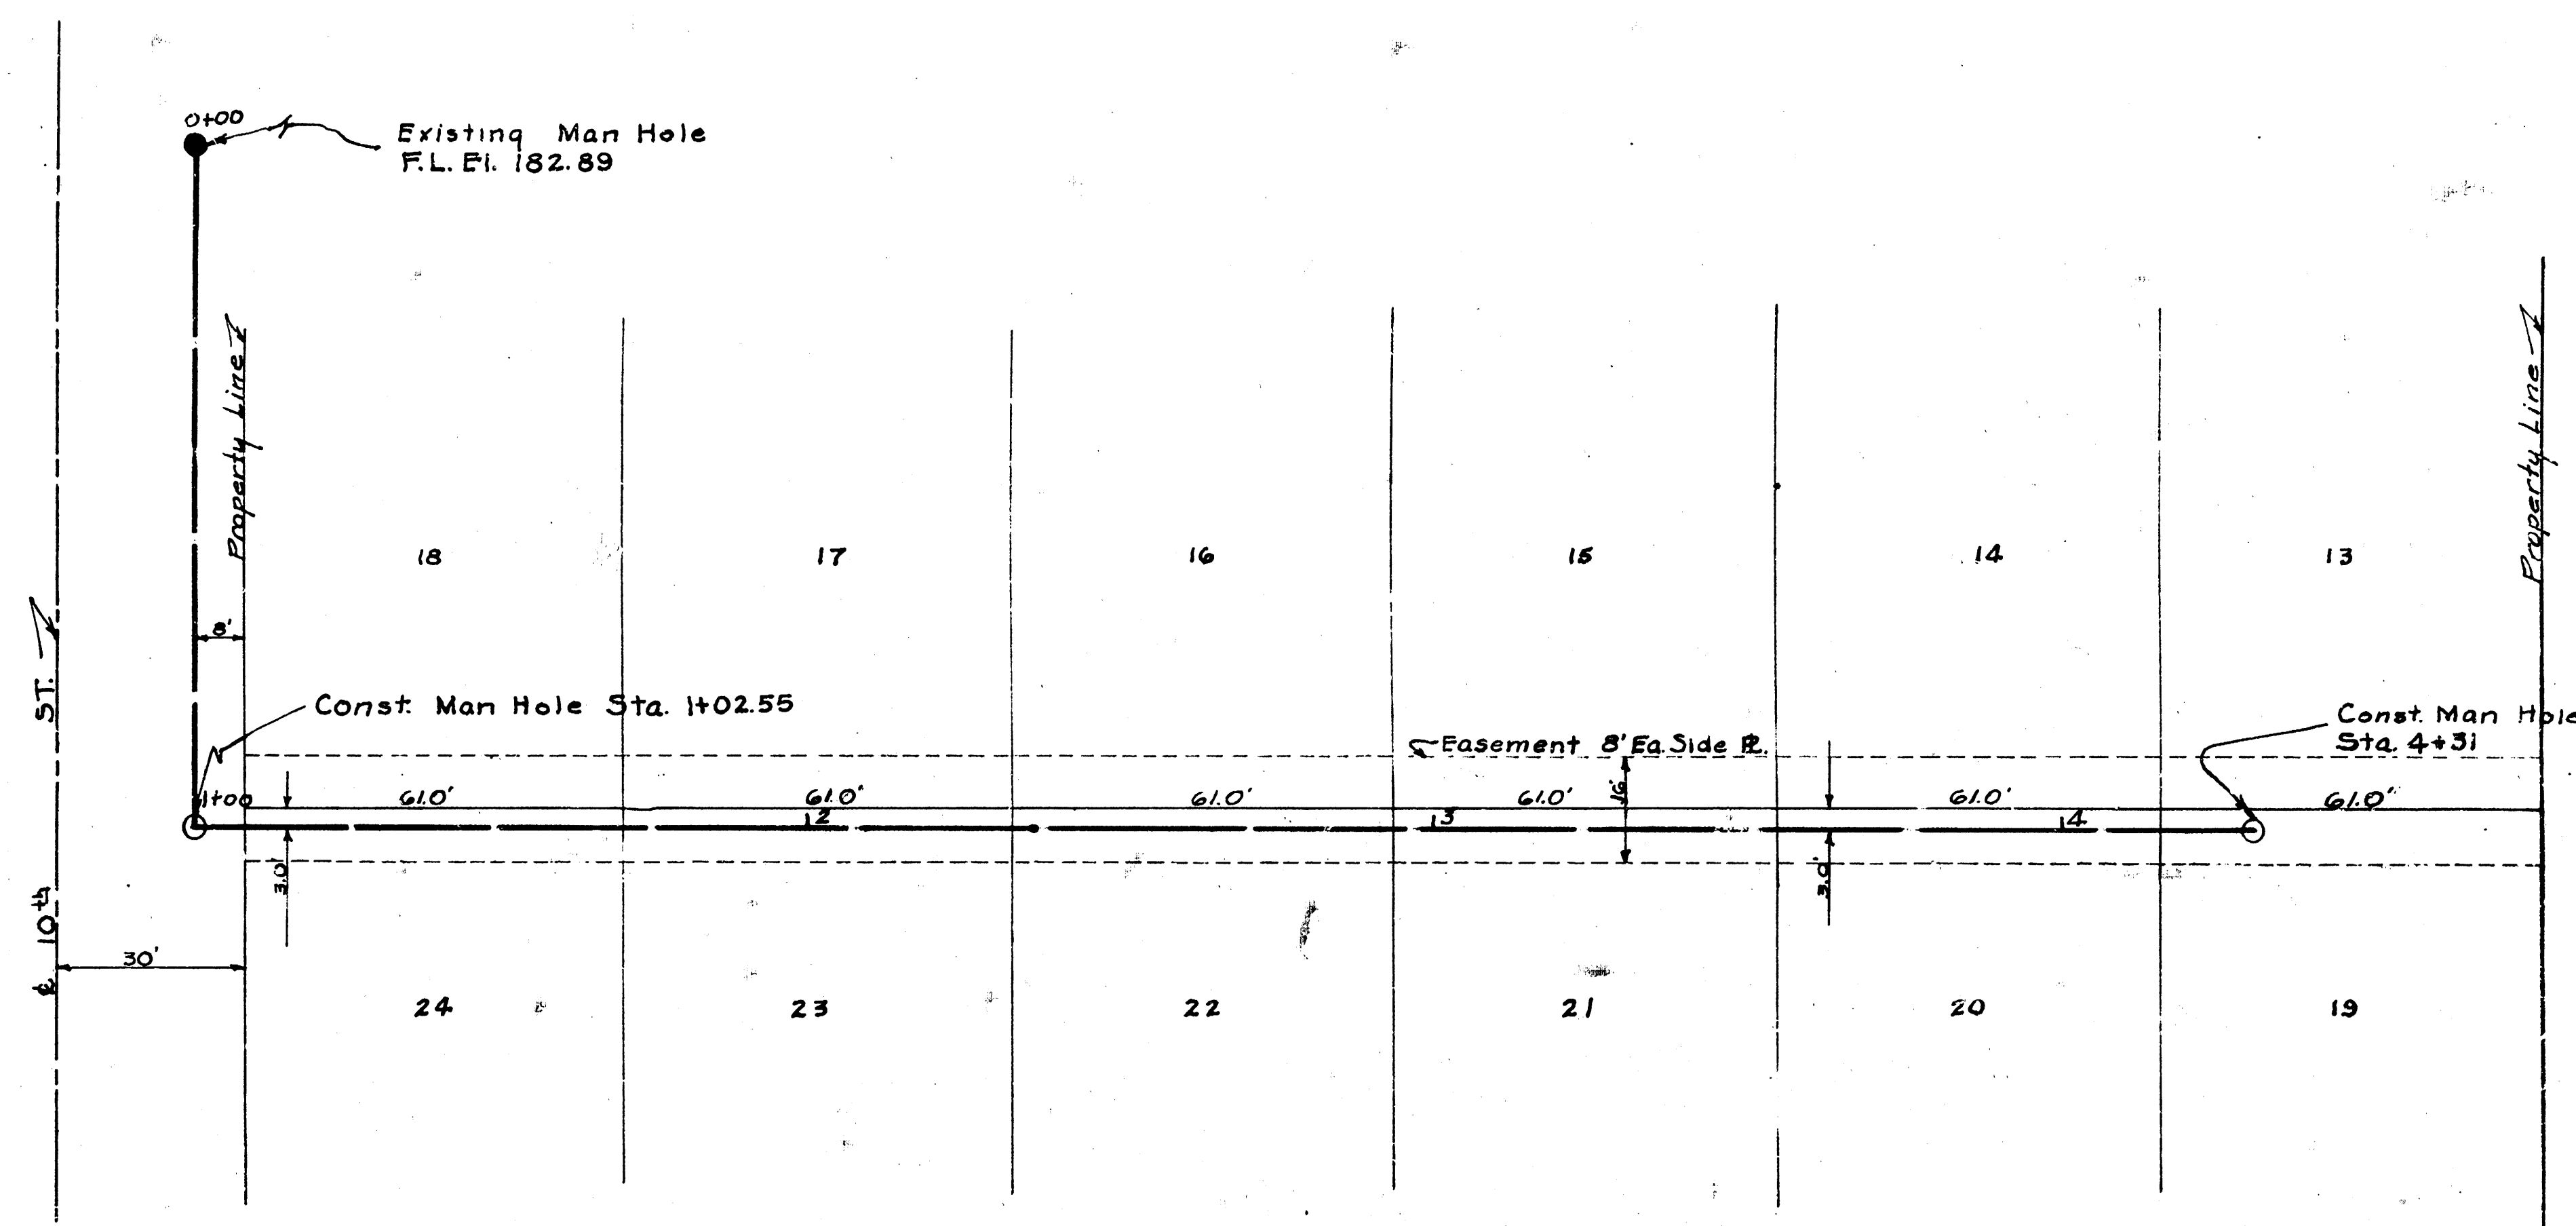
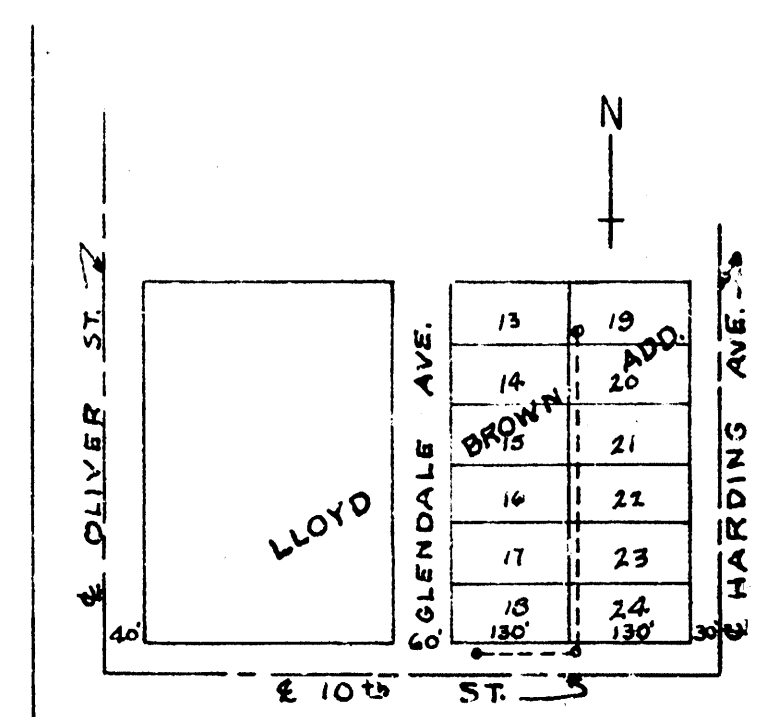


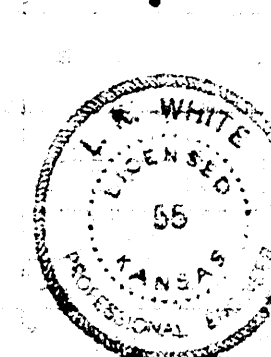

B.M. 5a. Rim Man Hole
Sta. 0+00 El. 192.53

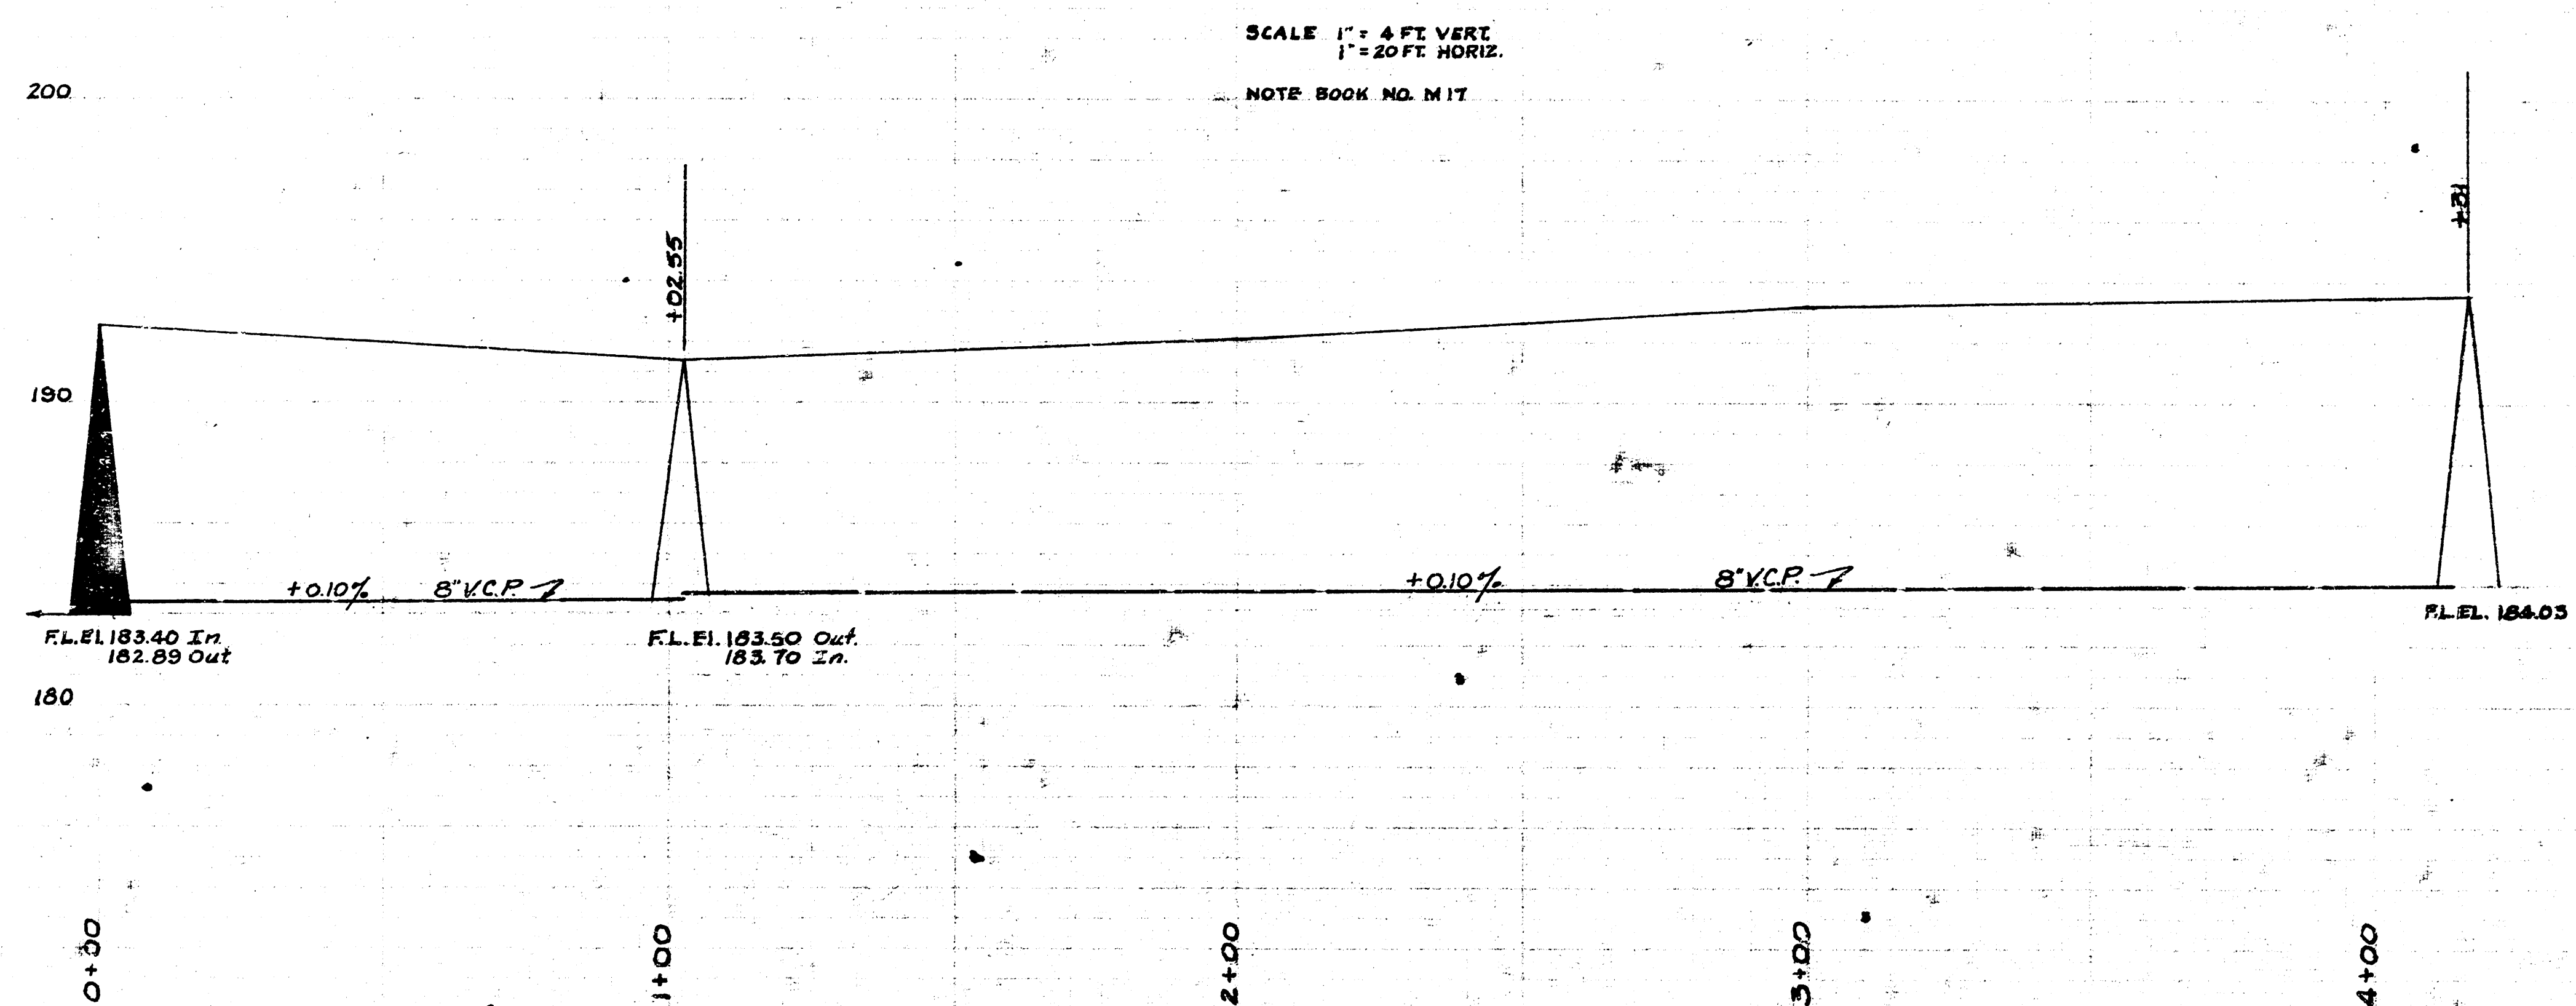

LAT 53-DCS. MAIN 12
CITY OF WICHITA, KANSAS
L. K. WHITE, CITY ENGINEER
28 January 1951
Proj. C-20-69