



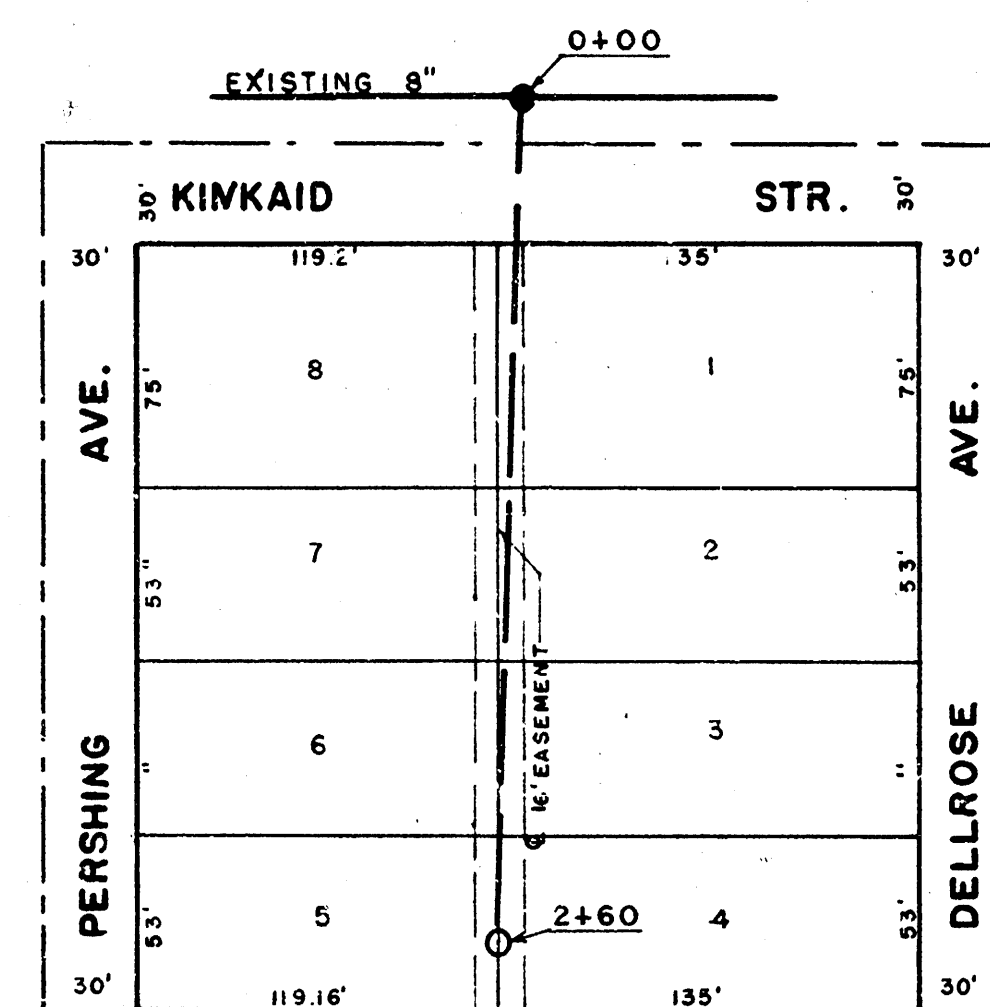


SCALE 1"=60'



CEDERDALE ADDITION

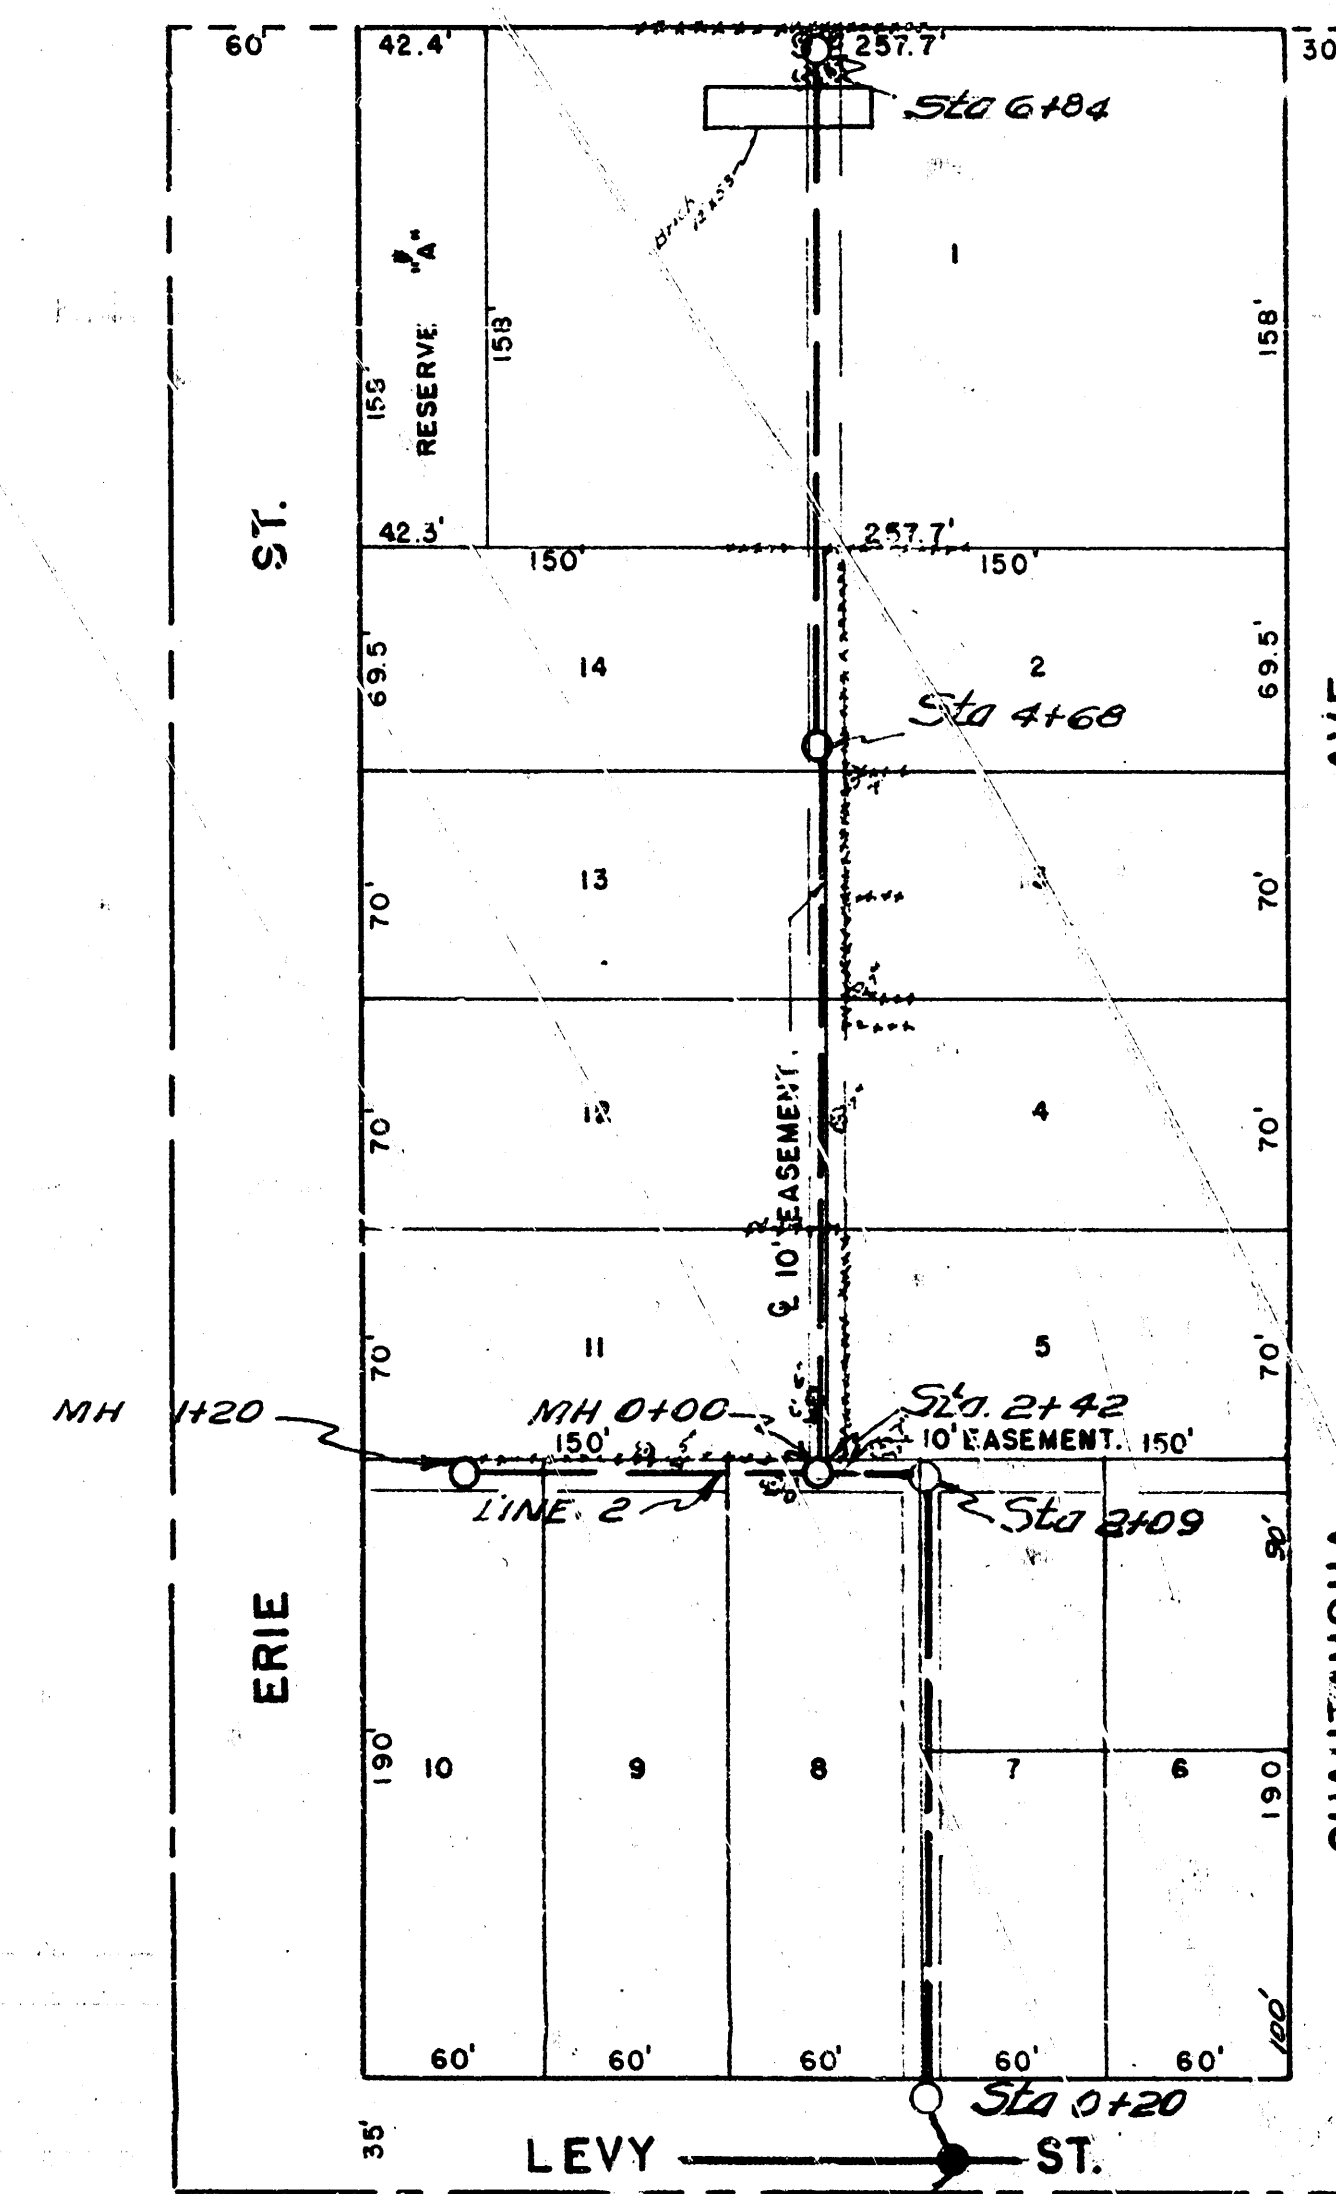

SCALE 1"=60'

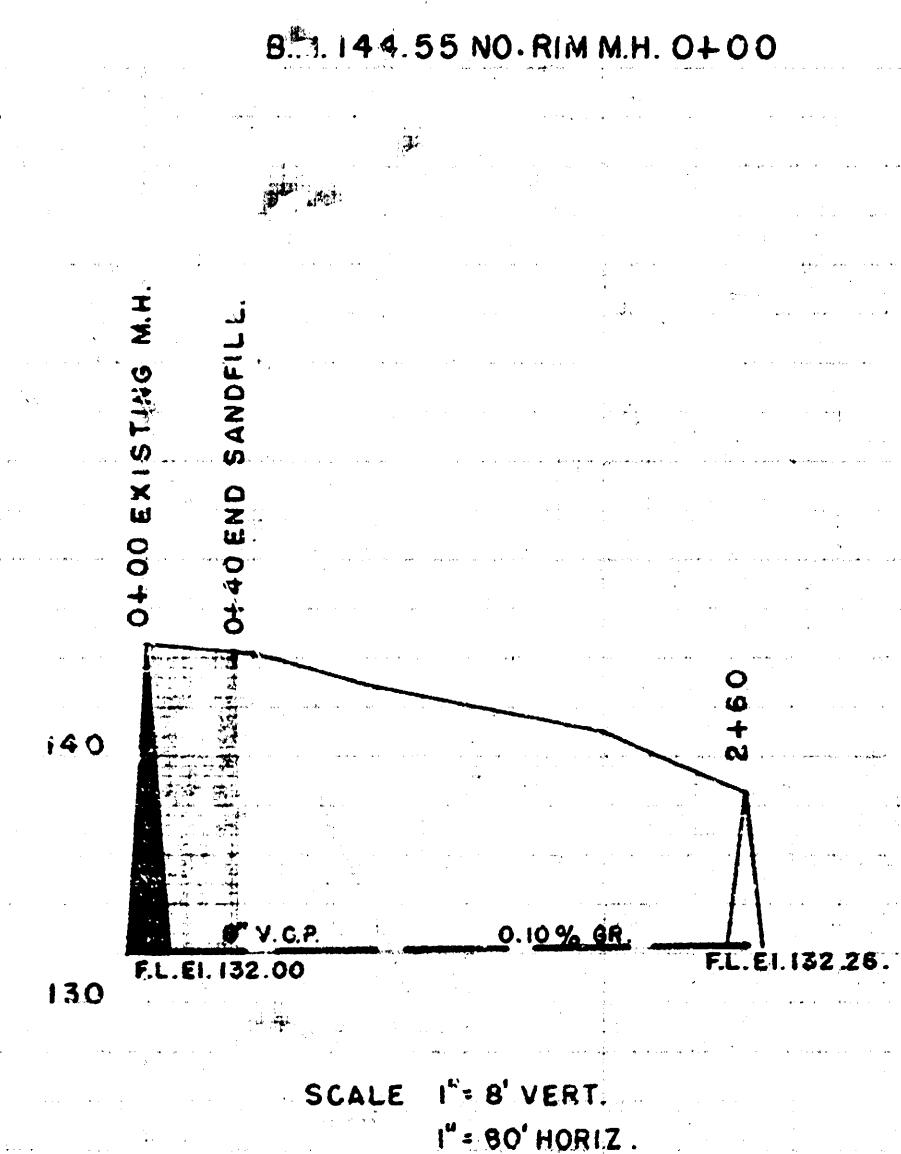

Date 6-26-52
Drawn by L. McClain
Checked by B. McClain
Book 16, 621-17-24

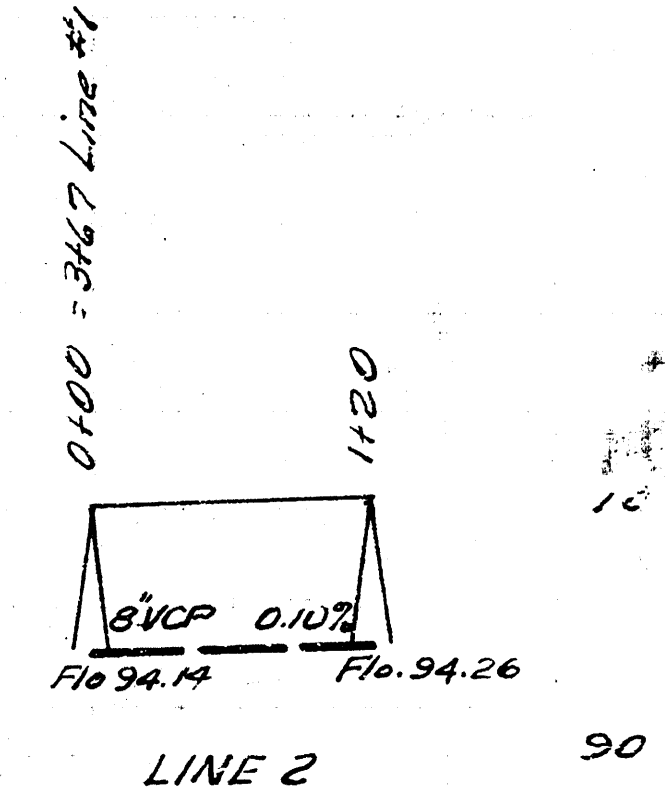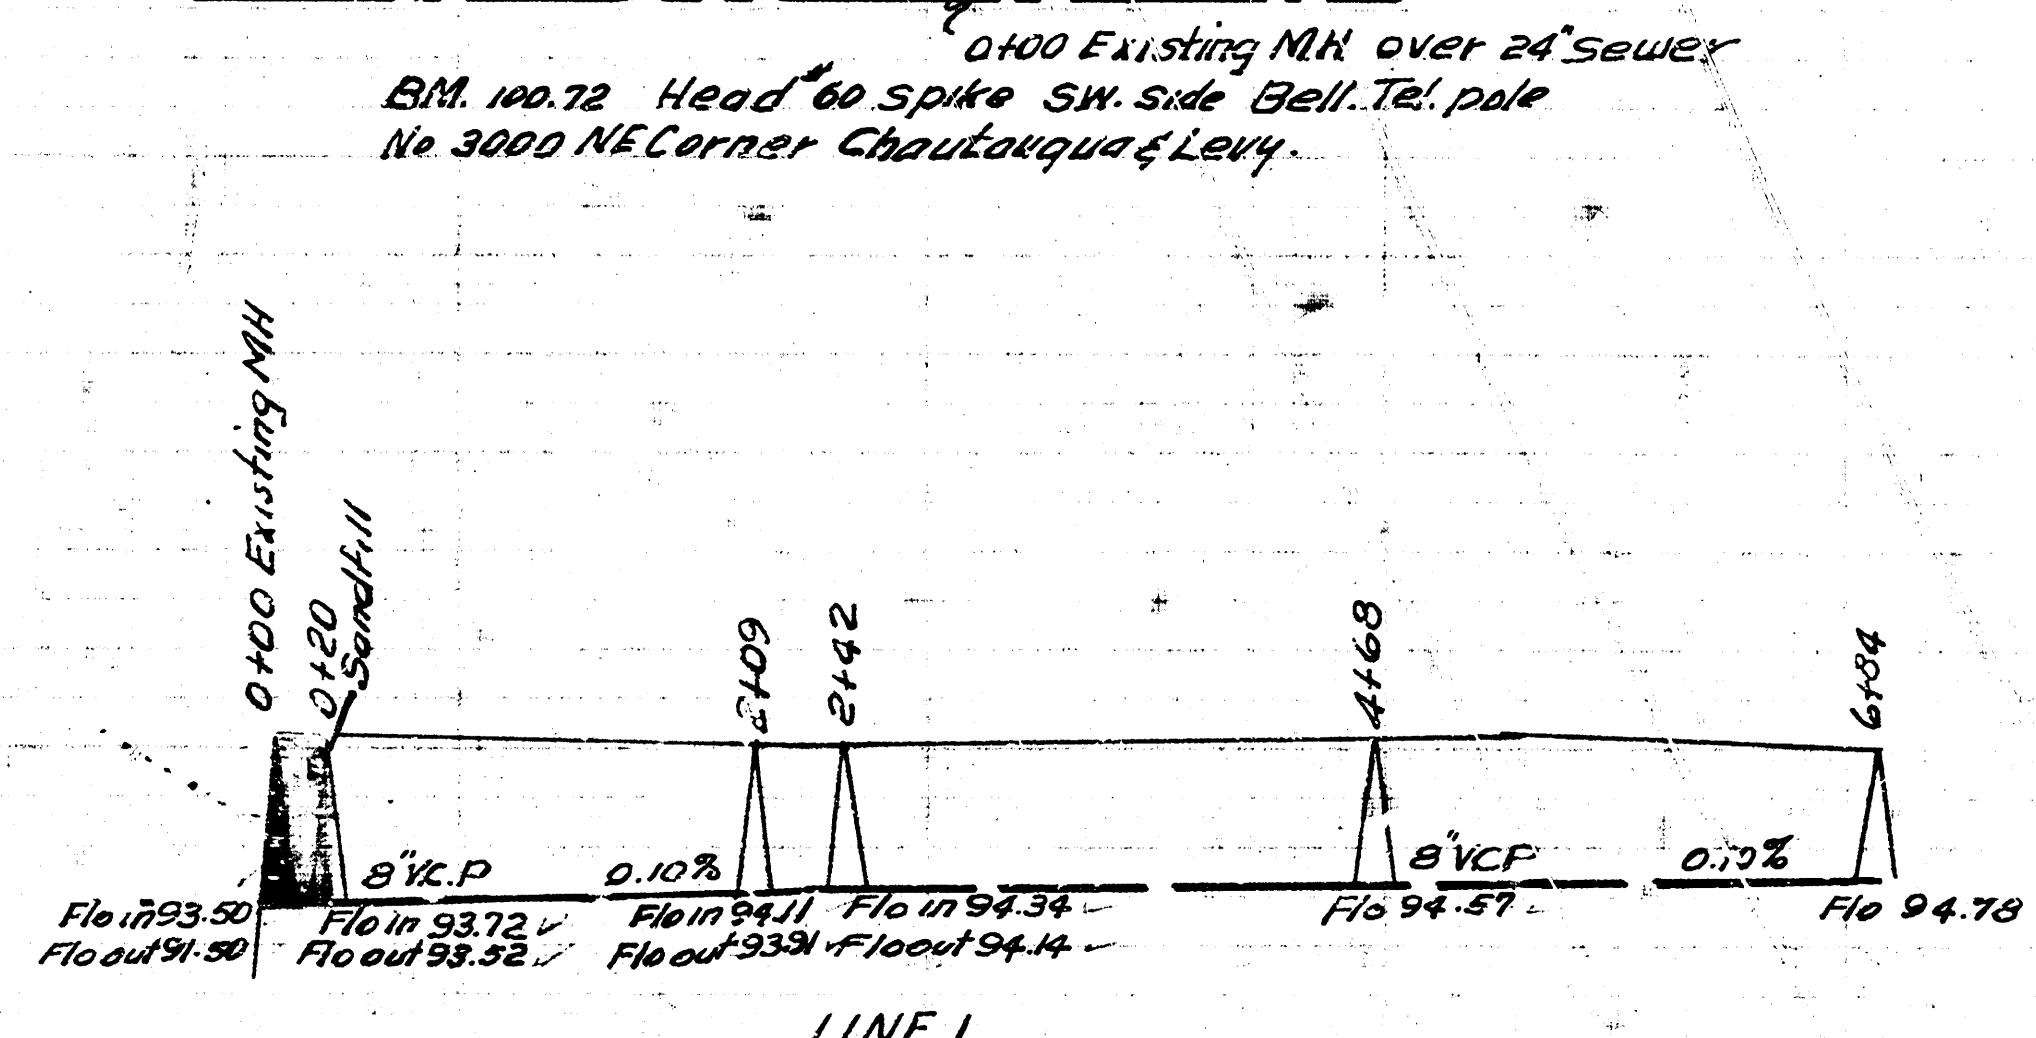

LAT. 62, D.C. MAIN 12,
CITY OF WICHITA KANSAS
L.K. WHITE CITY ENGINEER
PROJ. NO. C-22-5.

LAT. 12, D.C.2 MAIN 12,
CITY OF WICHITA KANSAS
L.K. WHITE CITY ENGINEER
PROJ. NO. C-22-27

DATE 4-9-52
DRAWN BY L.M.C.
CHECKED BY
BOOK NO.

