

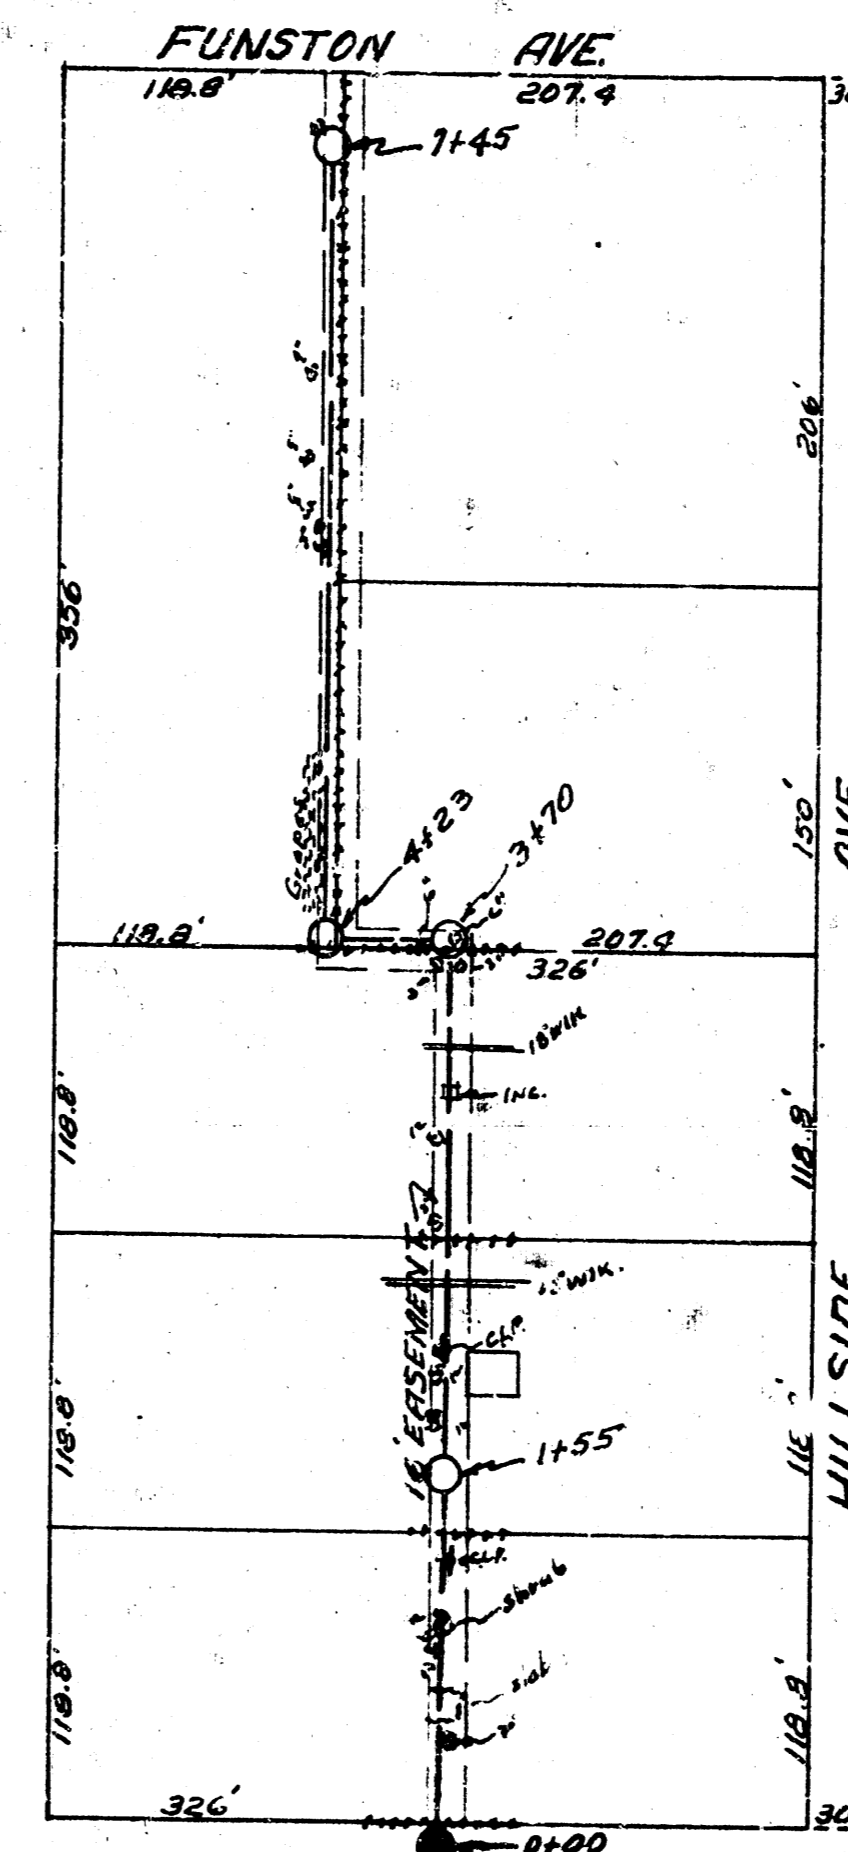
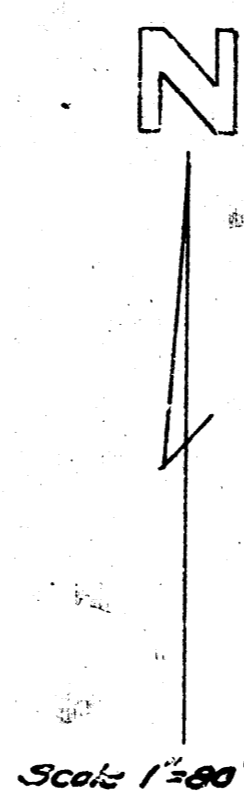



**BLOCK 5 KANSAS ADD.**

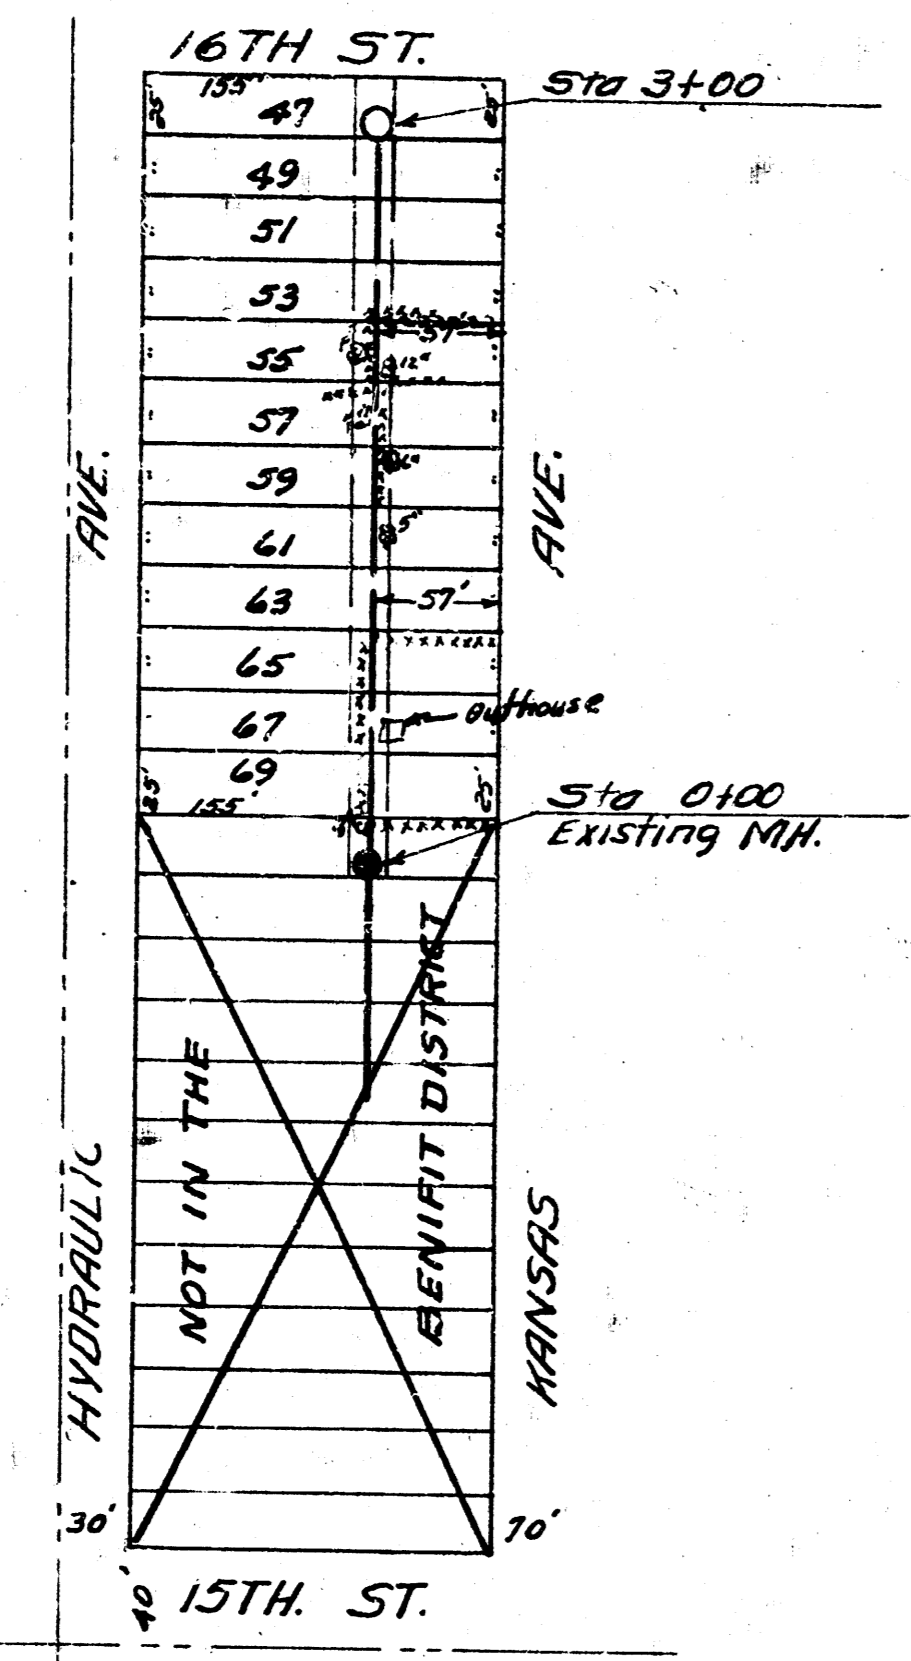

Date 9-1-53  
 Drawn by McLean  
 Checked by [Signature]  
 Sheet No. 701

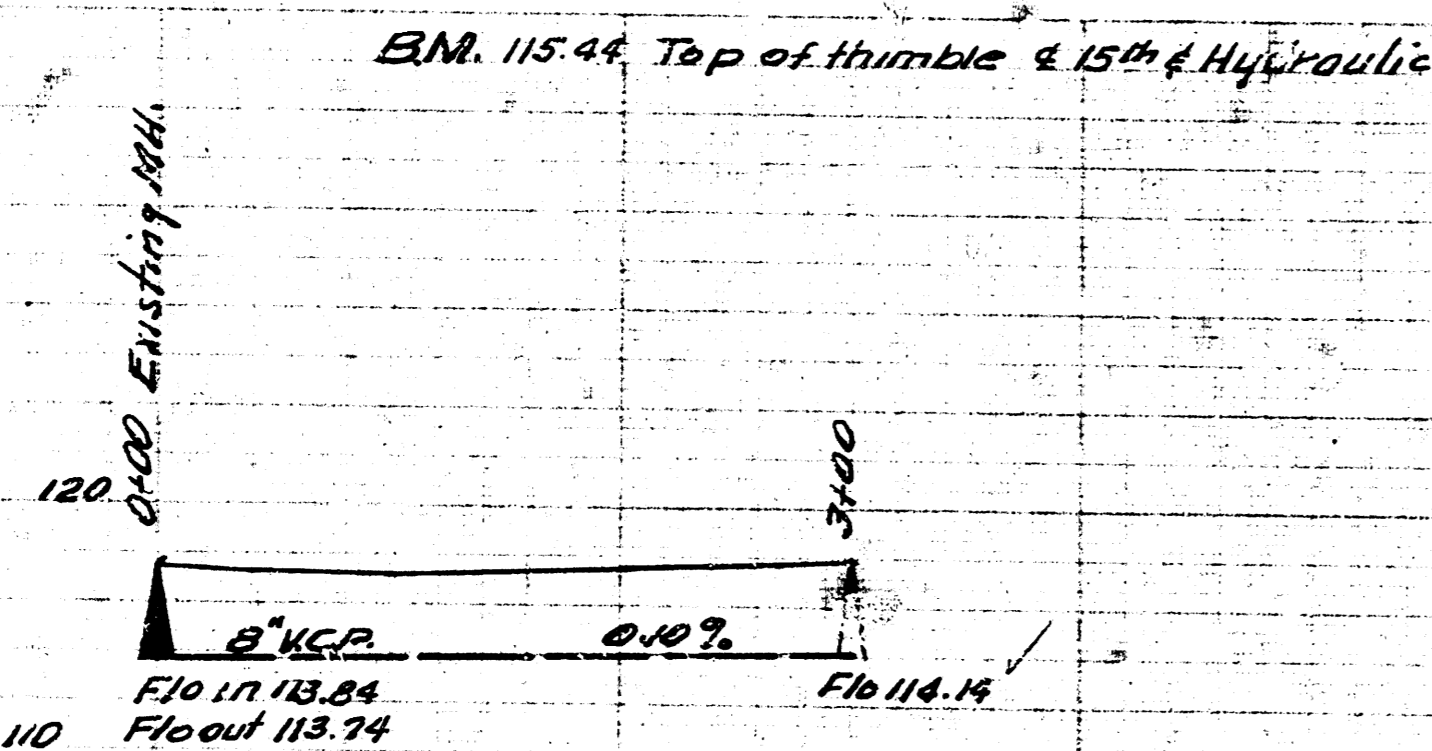

Date  
 Drawn by McLean  
 Checked by [Signature]  
 Sheet No. 701

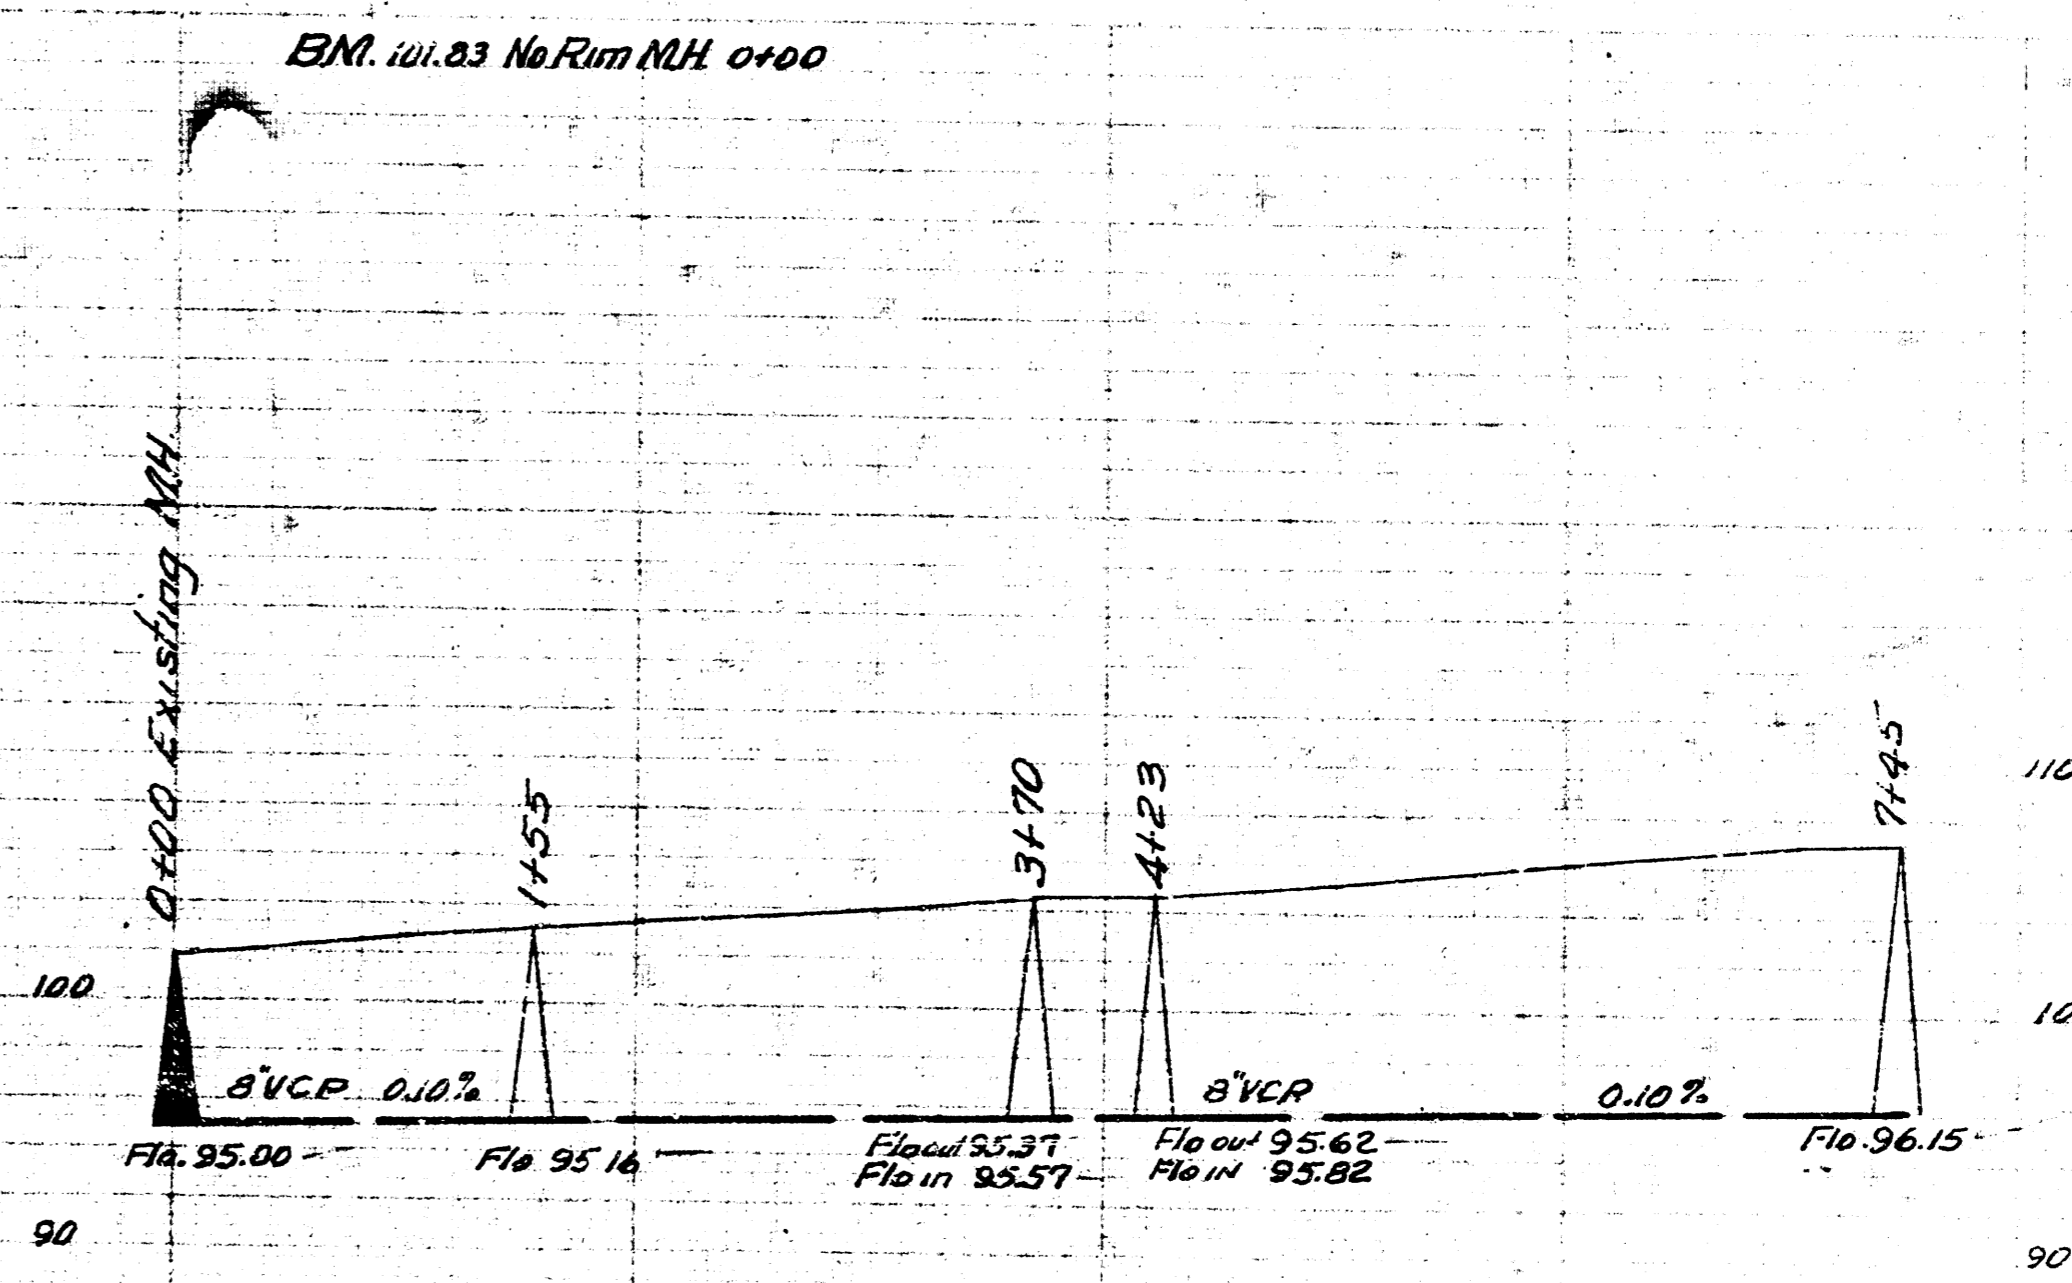

LAT. 6 DIST. R. 5S. 12  
 CITY OF WICHITA, KANSAS  
 BESMITH CITY ENGINEER  
 Proj. No. C-22-95

LAT. 26 DCS. 2 5S. 12  
 CITY OF WICHITA, KANSAS  
 BE-SMITH CITY ENGINEER  
 Proj. No. C-22-81

