
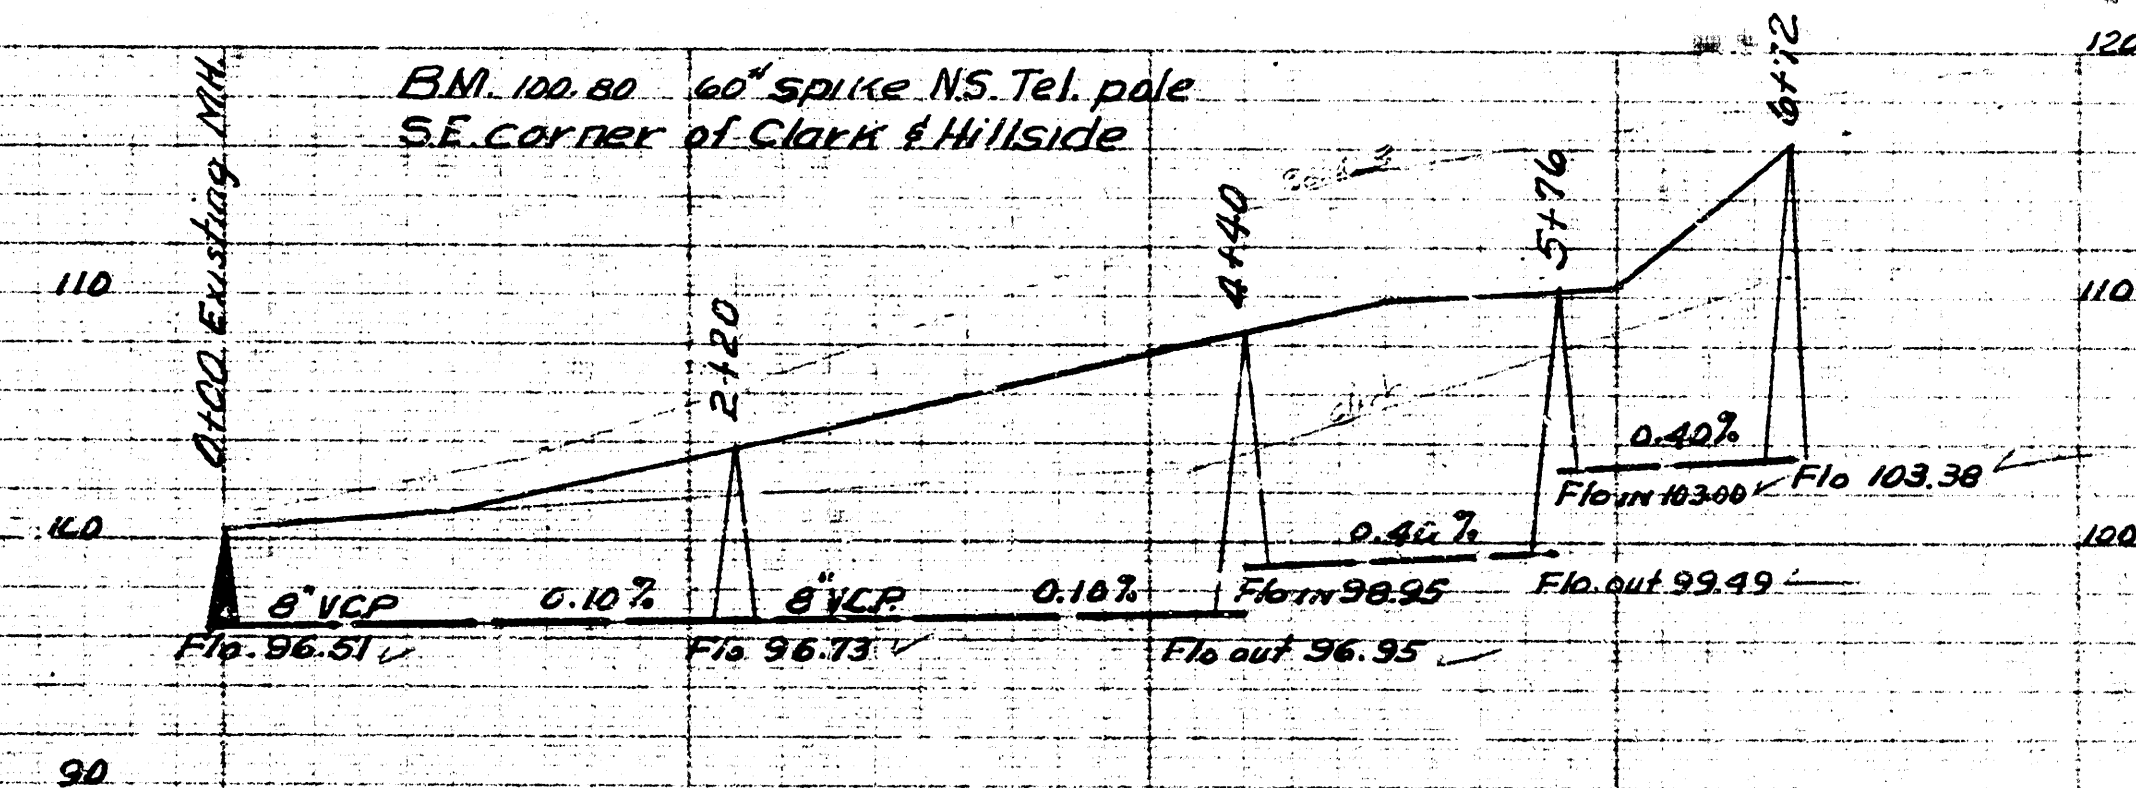
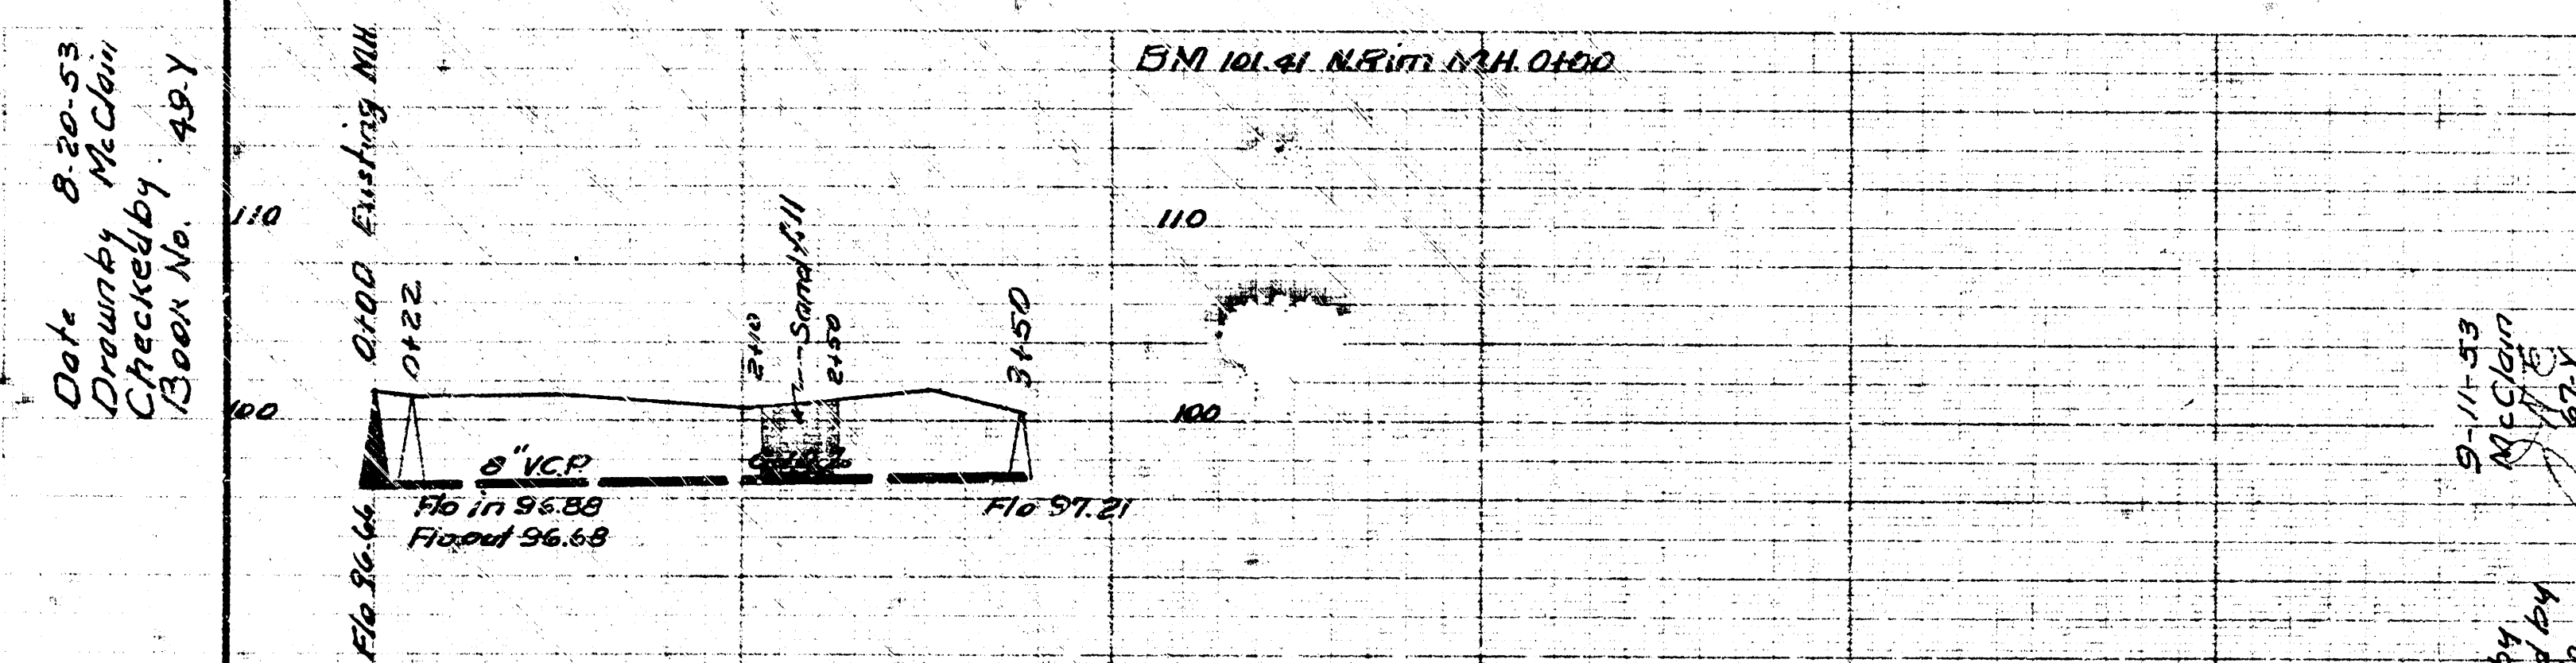


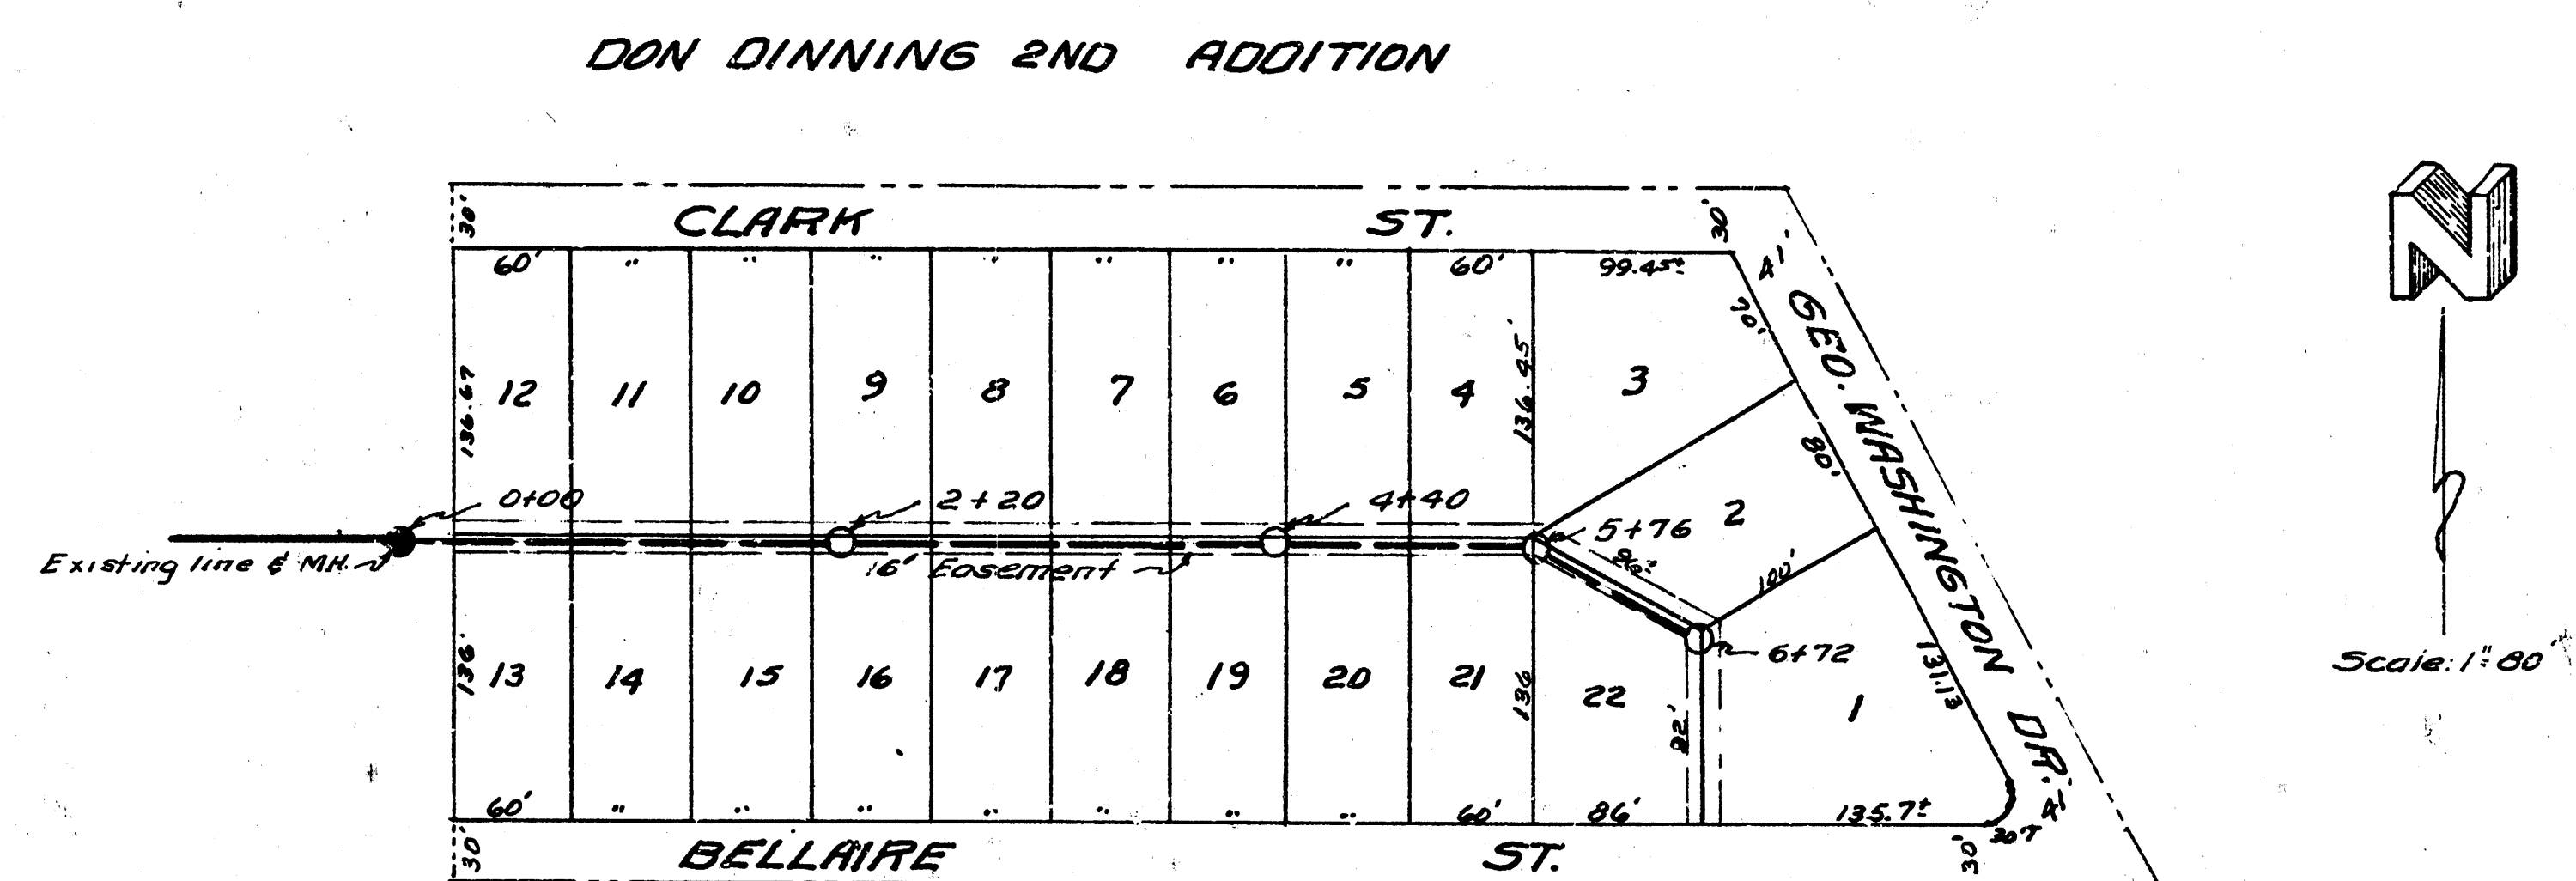

LAT. 4. DIST. 55. 21
CITY OF WICHITA KANSAS.
BE SMITH CITY ENGINEER
Proj No. C-23-40

LAT. 34 DCS 2 S.S. 12
CITY OF WICHITA KANSAS
B.E. SMITH CITY ENGINEER
Proj No. C-23-41