


J. W. ...  
D. ...


**NOTE:**  
Trench will be adjacent to new cb & qtr.  
Contractor shall use planking or otherwise  
protect cb & qtr. from any damage, by  
trencher, or from settlement due to weight  
of trencher.

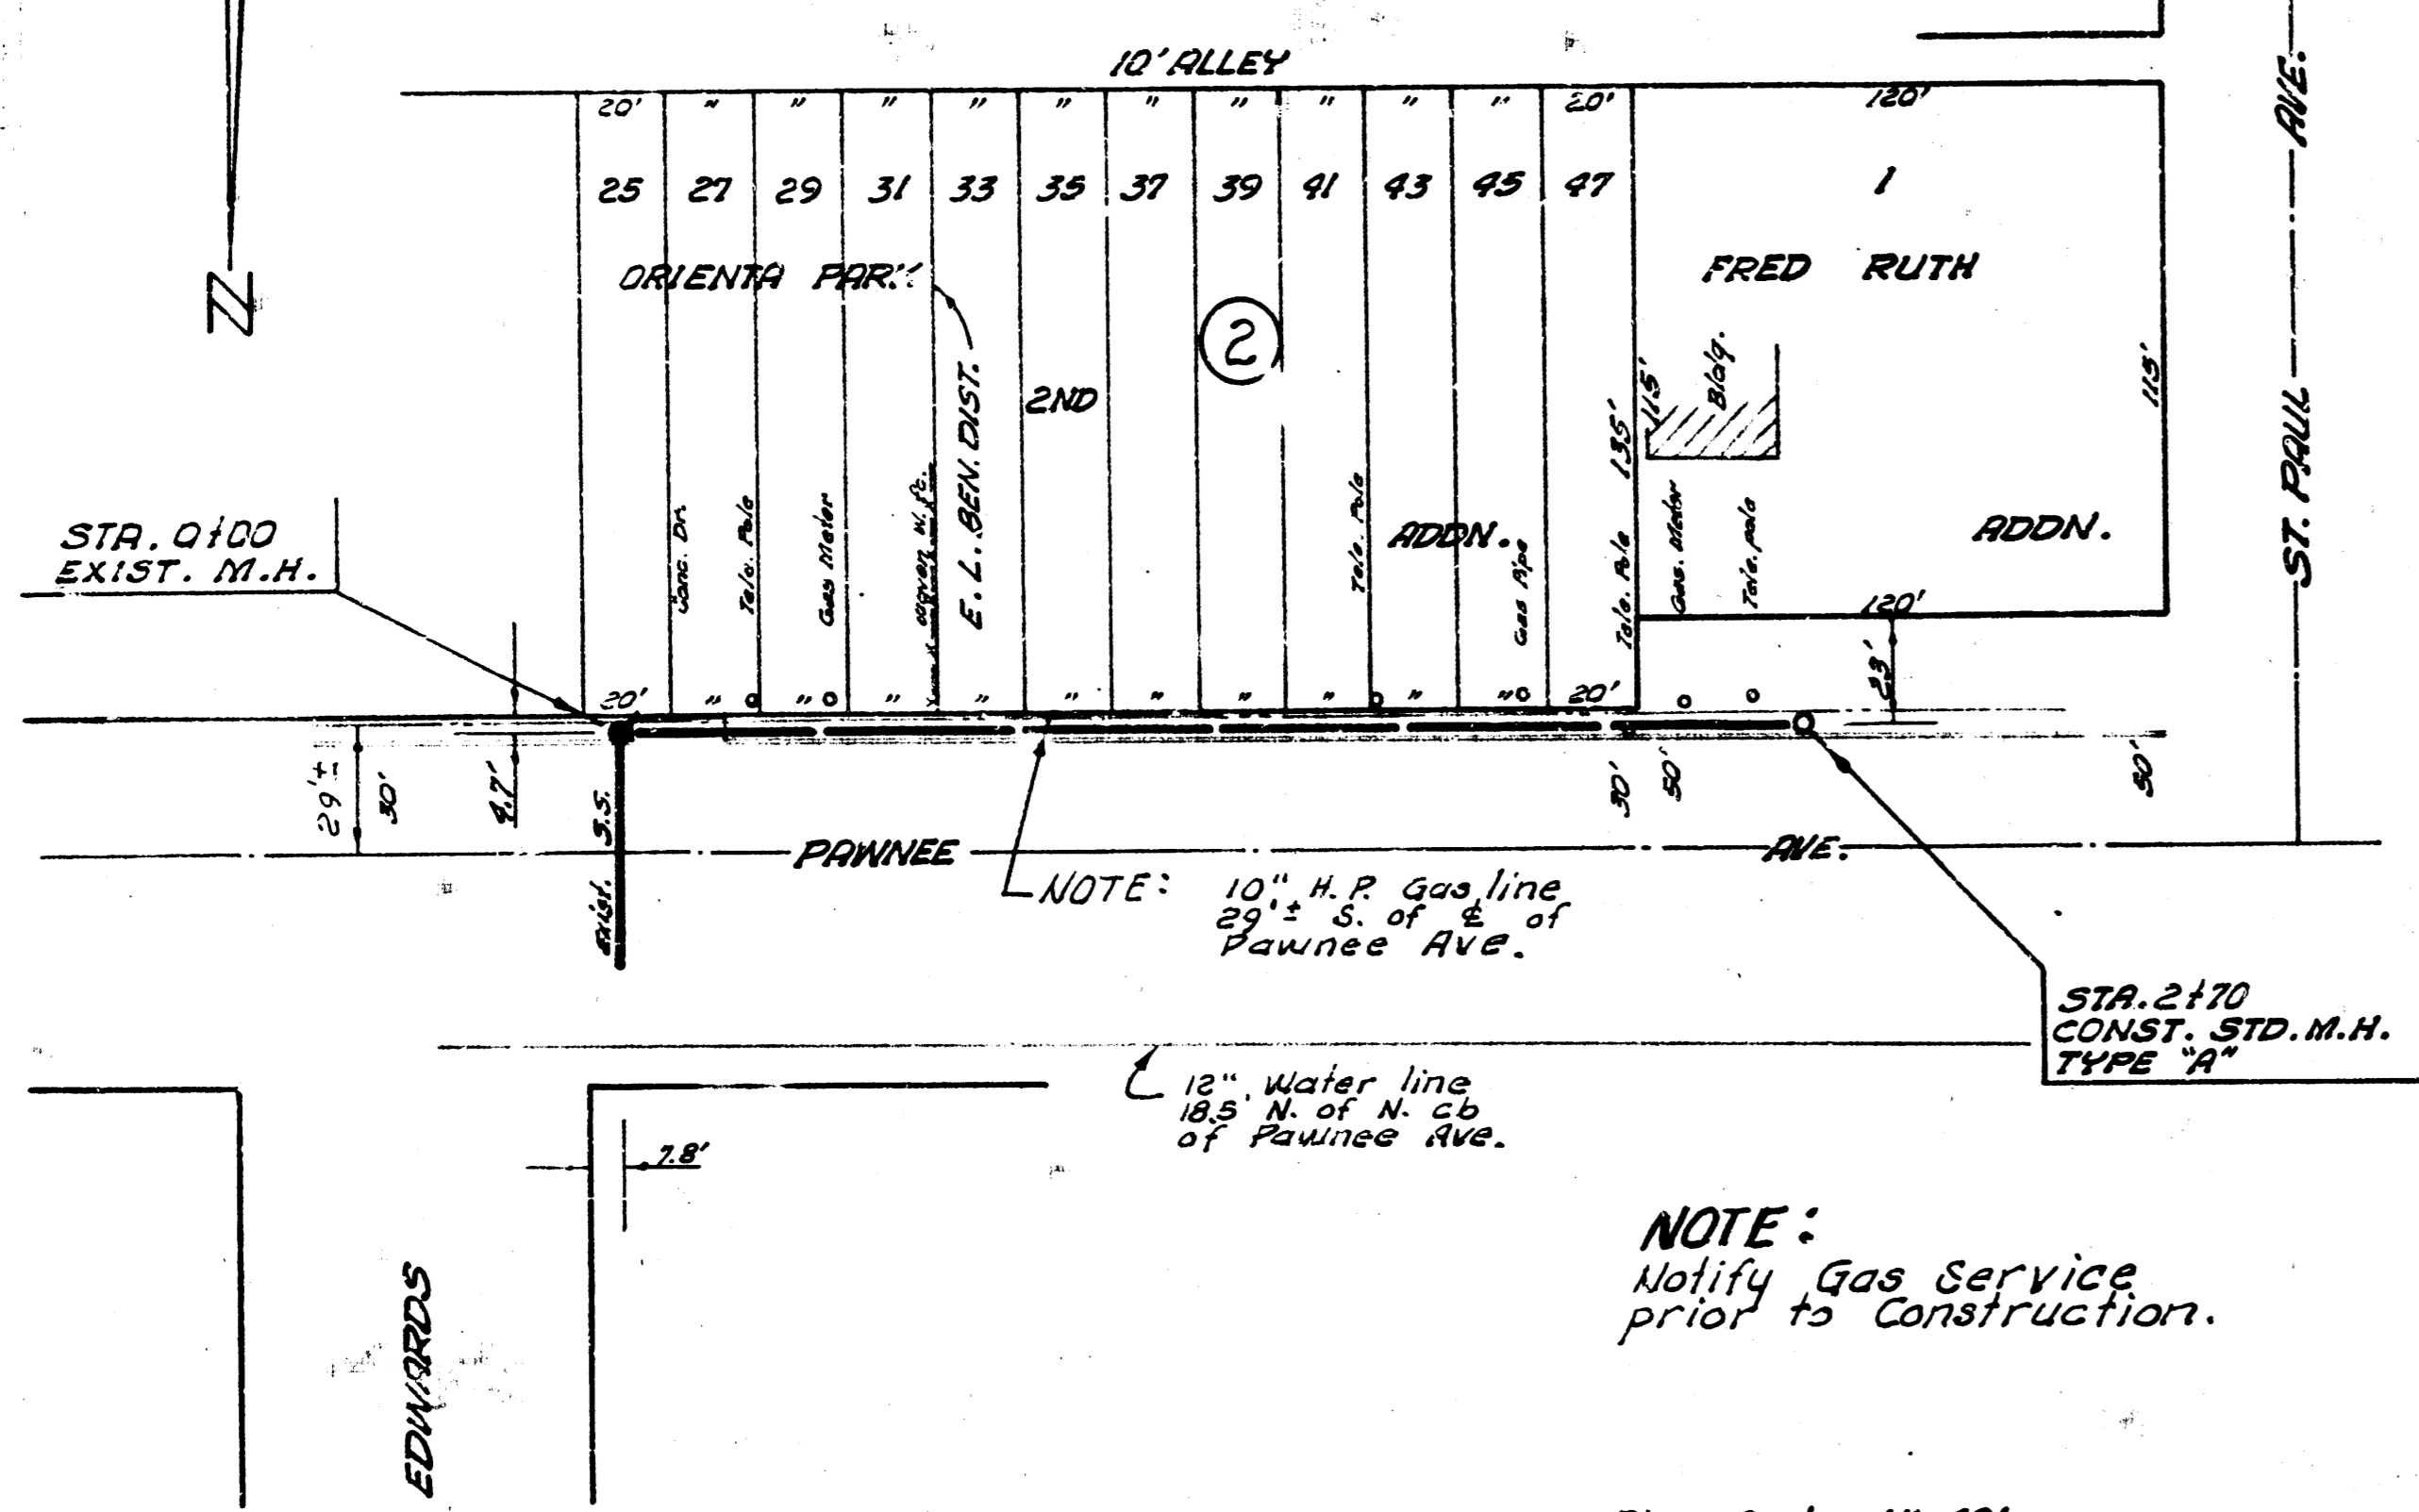

**NOTE:**  
Notify Gas Service  
prior to construction.


Plan Scale 1"=40'  
Profile Scale 1"=40' Hor.  
1"=4' Vert.

B.M. 102.07 City Standard S.E. Cor. Pawnee & Meridian

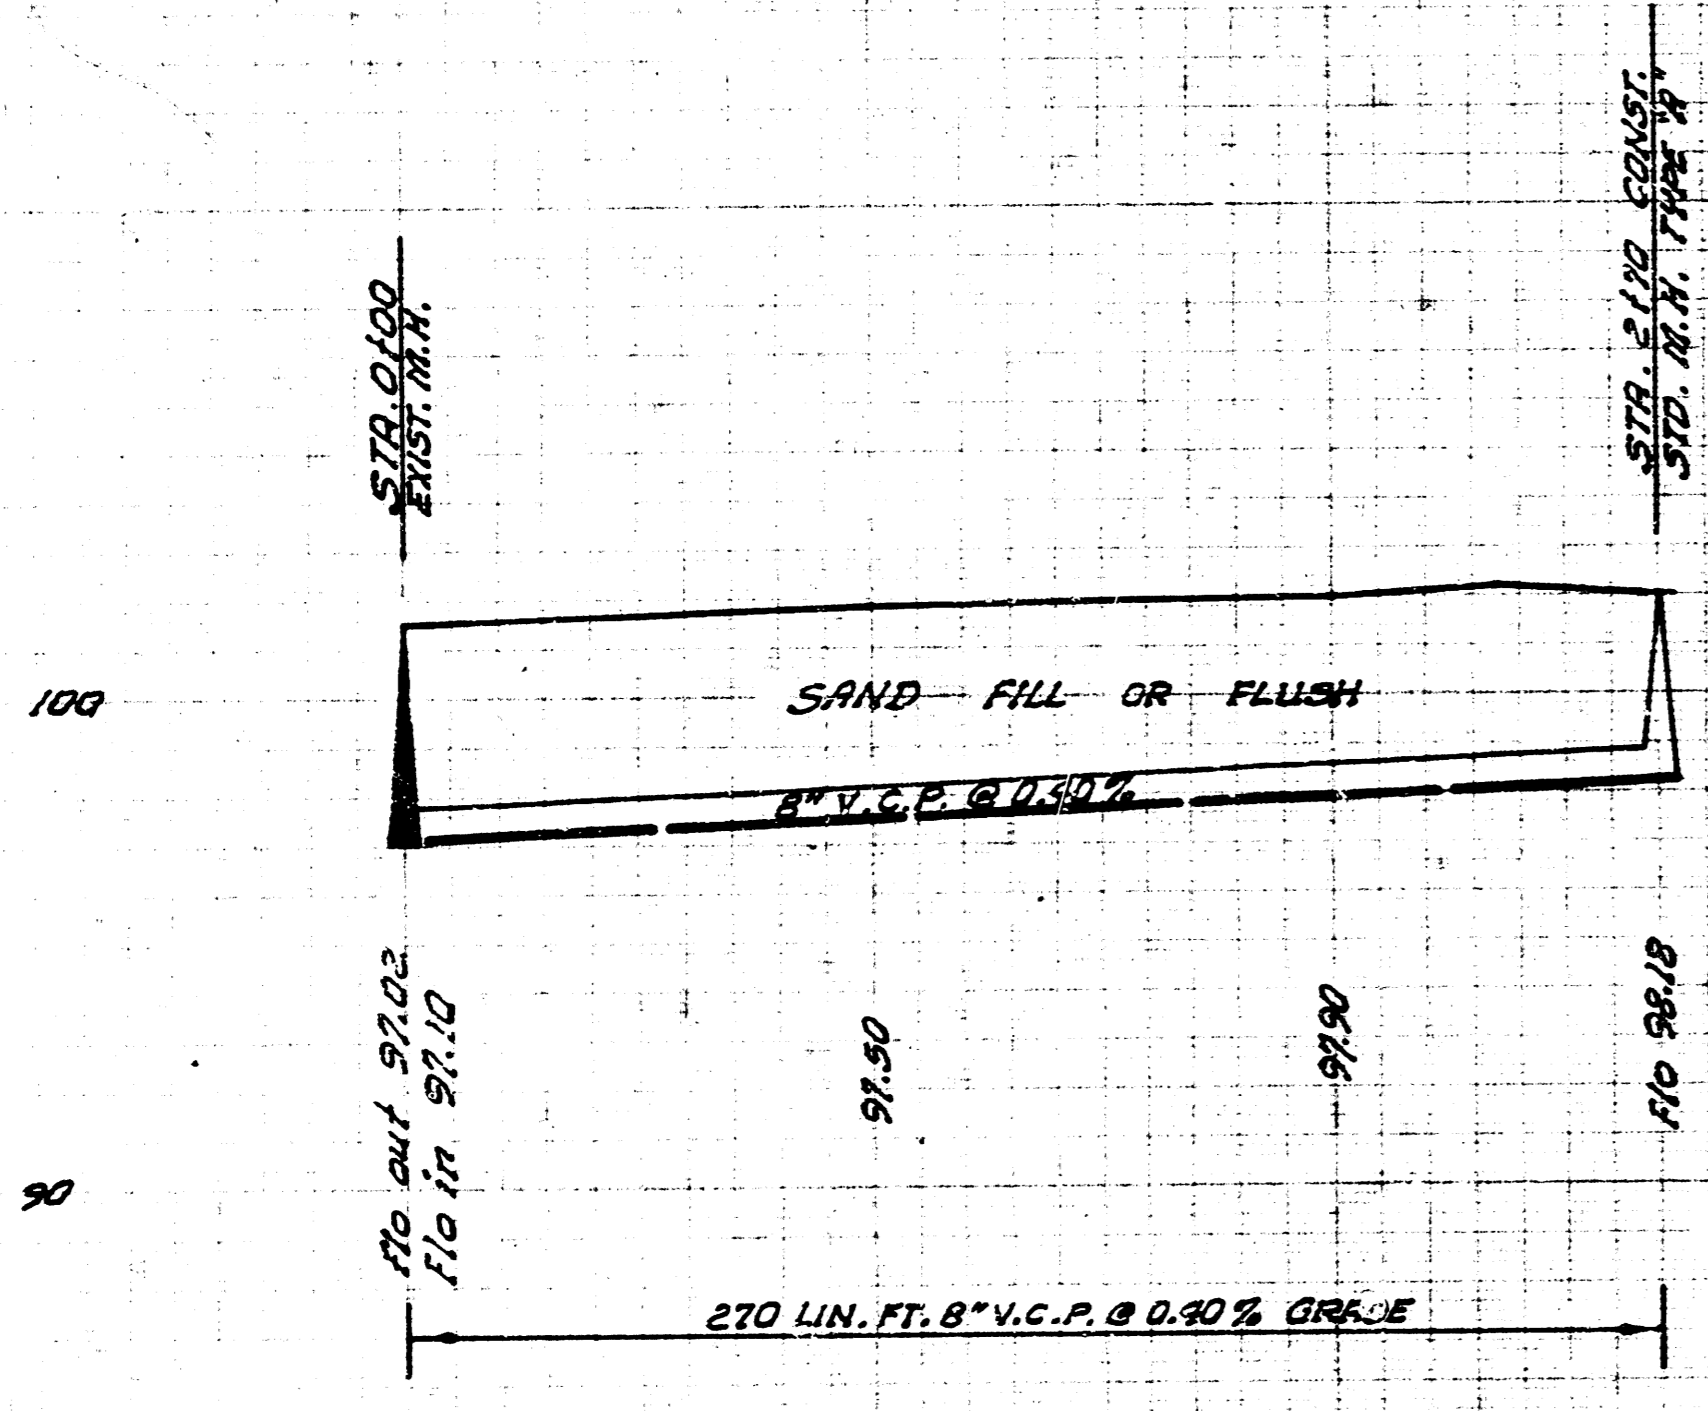


LAT. 4, SUB. 16, S.S. NO. 22  
CITY OF WICHITA, KANSAS  
B. E. SMITH, CITY ENGINEER  
PROJ. NO. C25-37  
DATE: MAR. 1966

Survey G. ...  
Plan: D. ...  
Checked

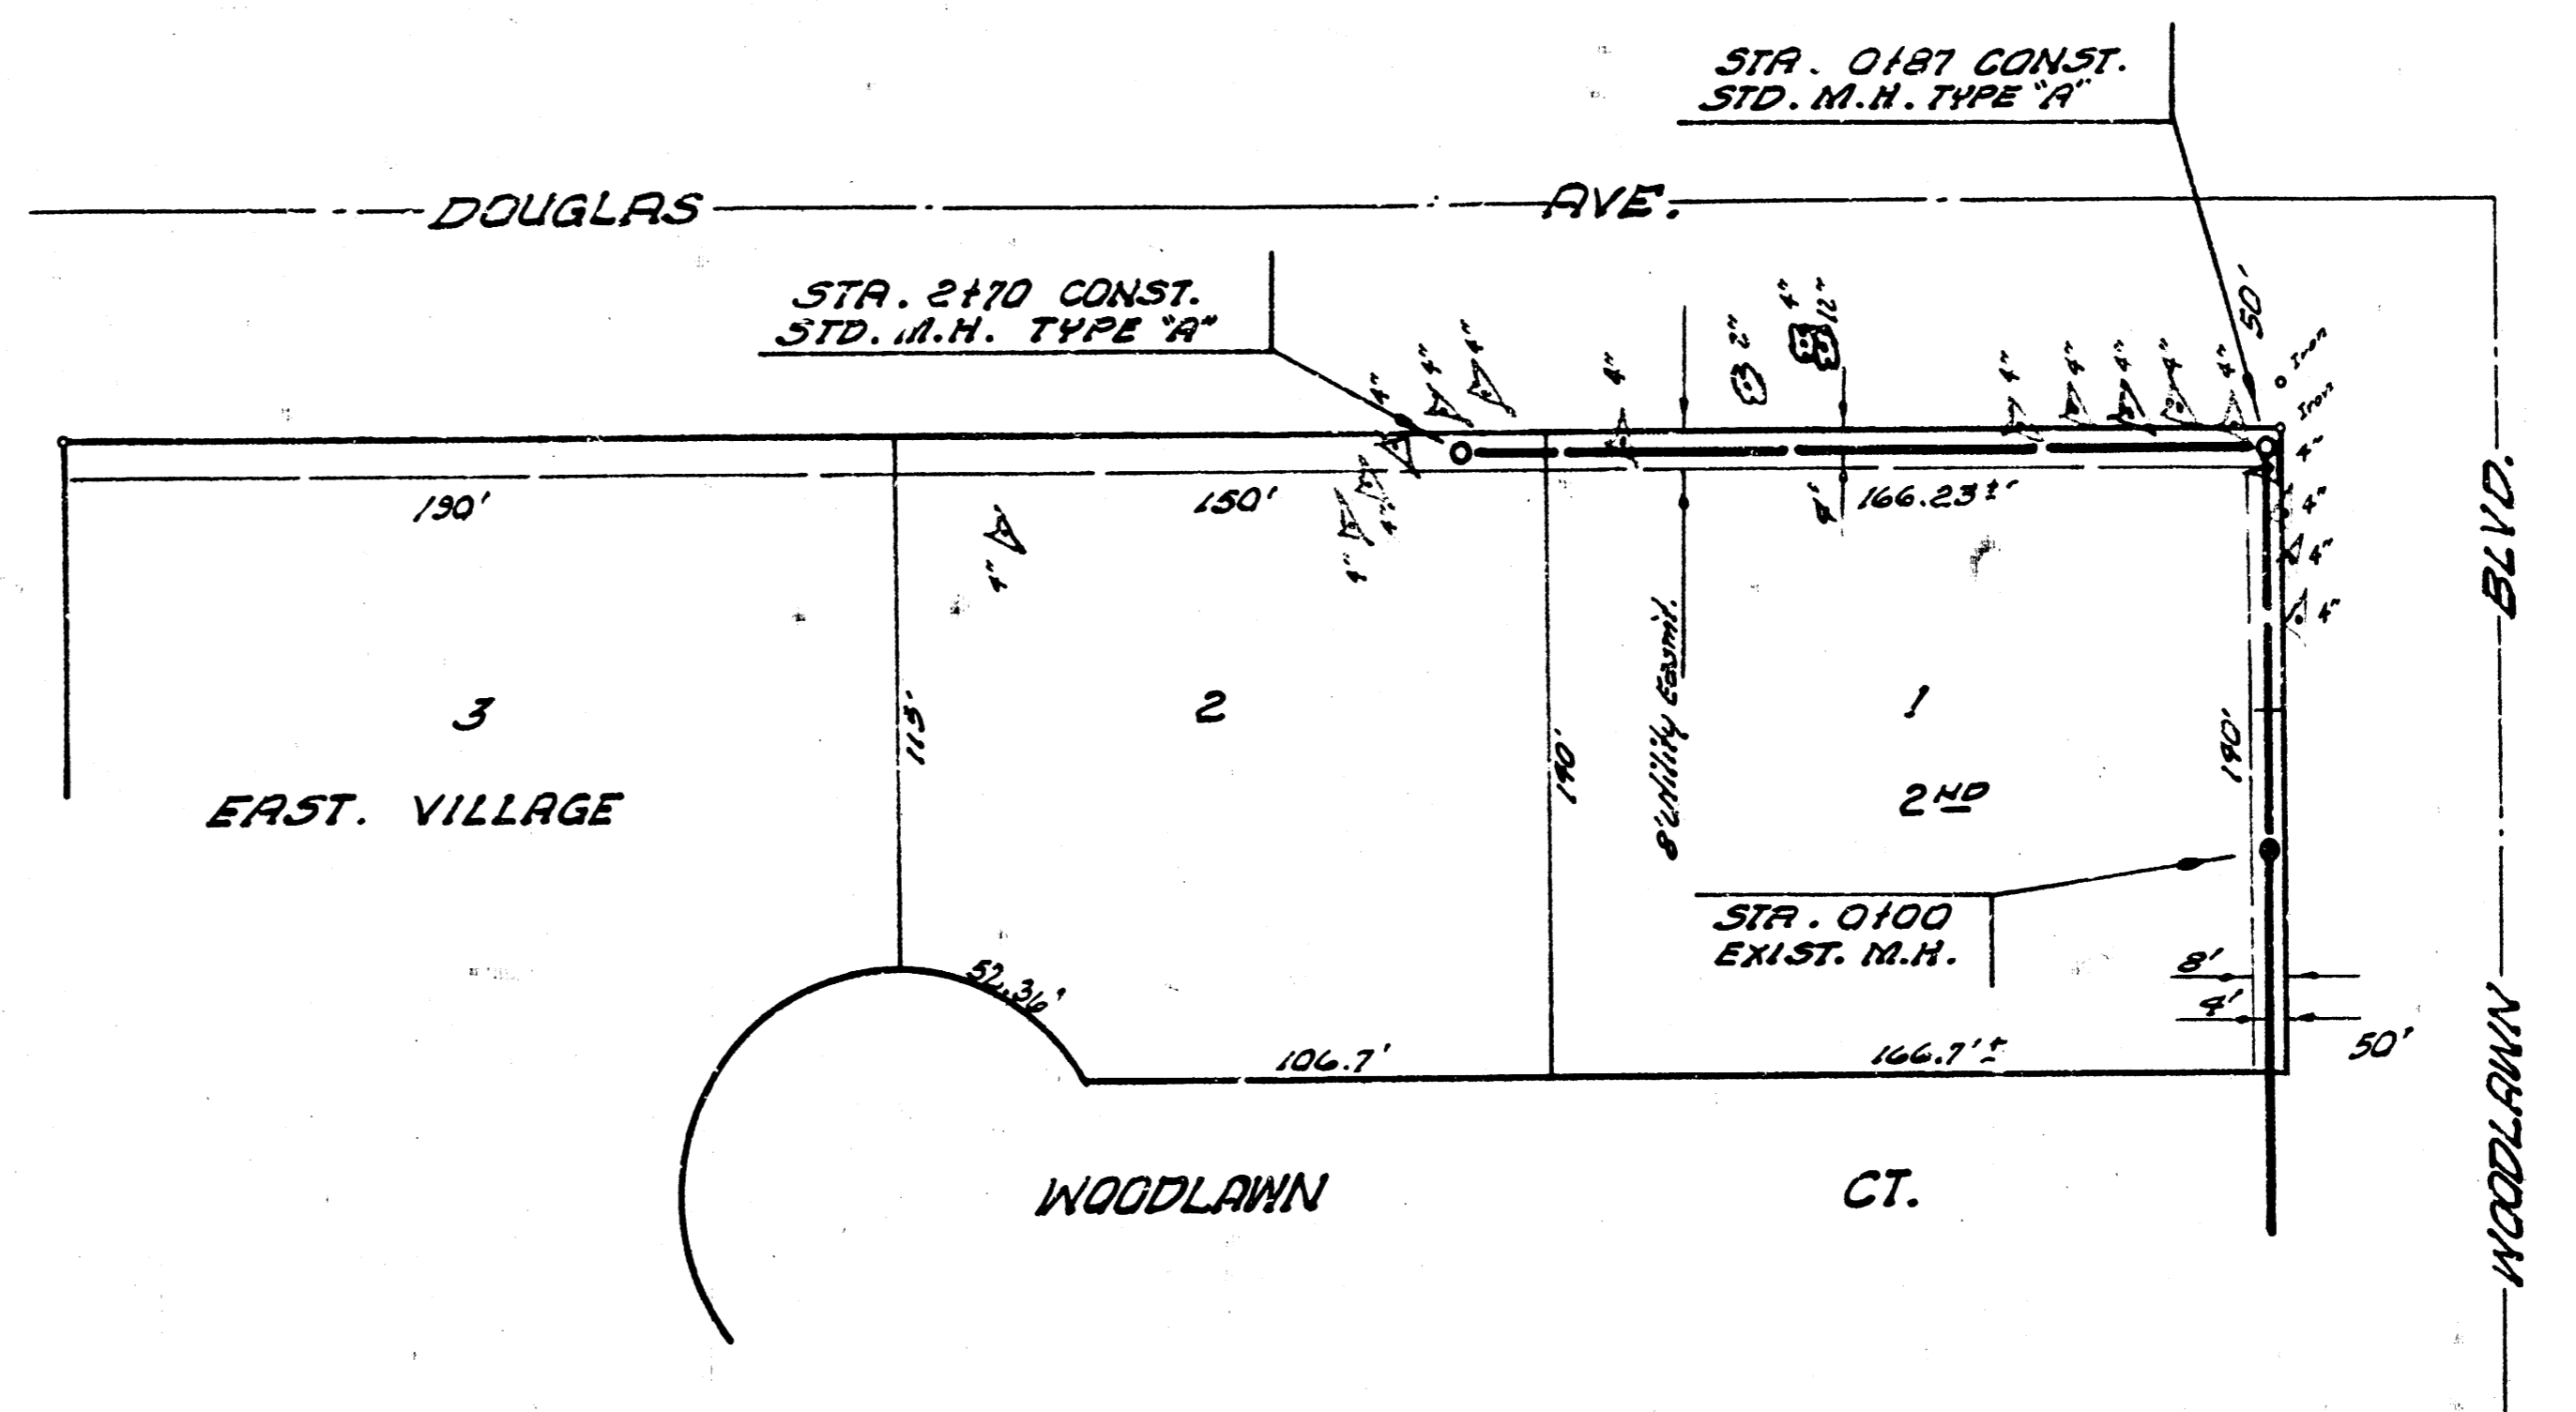

Plan Scale 1"=40'  
Profile Scale 1"=40' Hor.  
1"=4' Vert.

B.M. 179.46 "X" on S.W. Cor. City Concrete M.H. on S.E. Cor. Woodlawn & Douglas

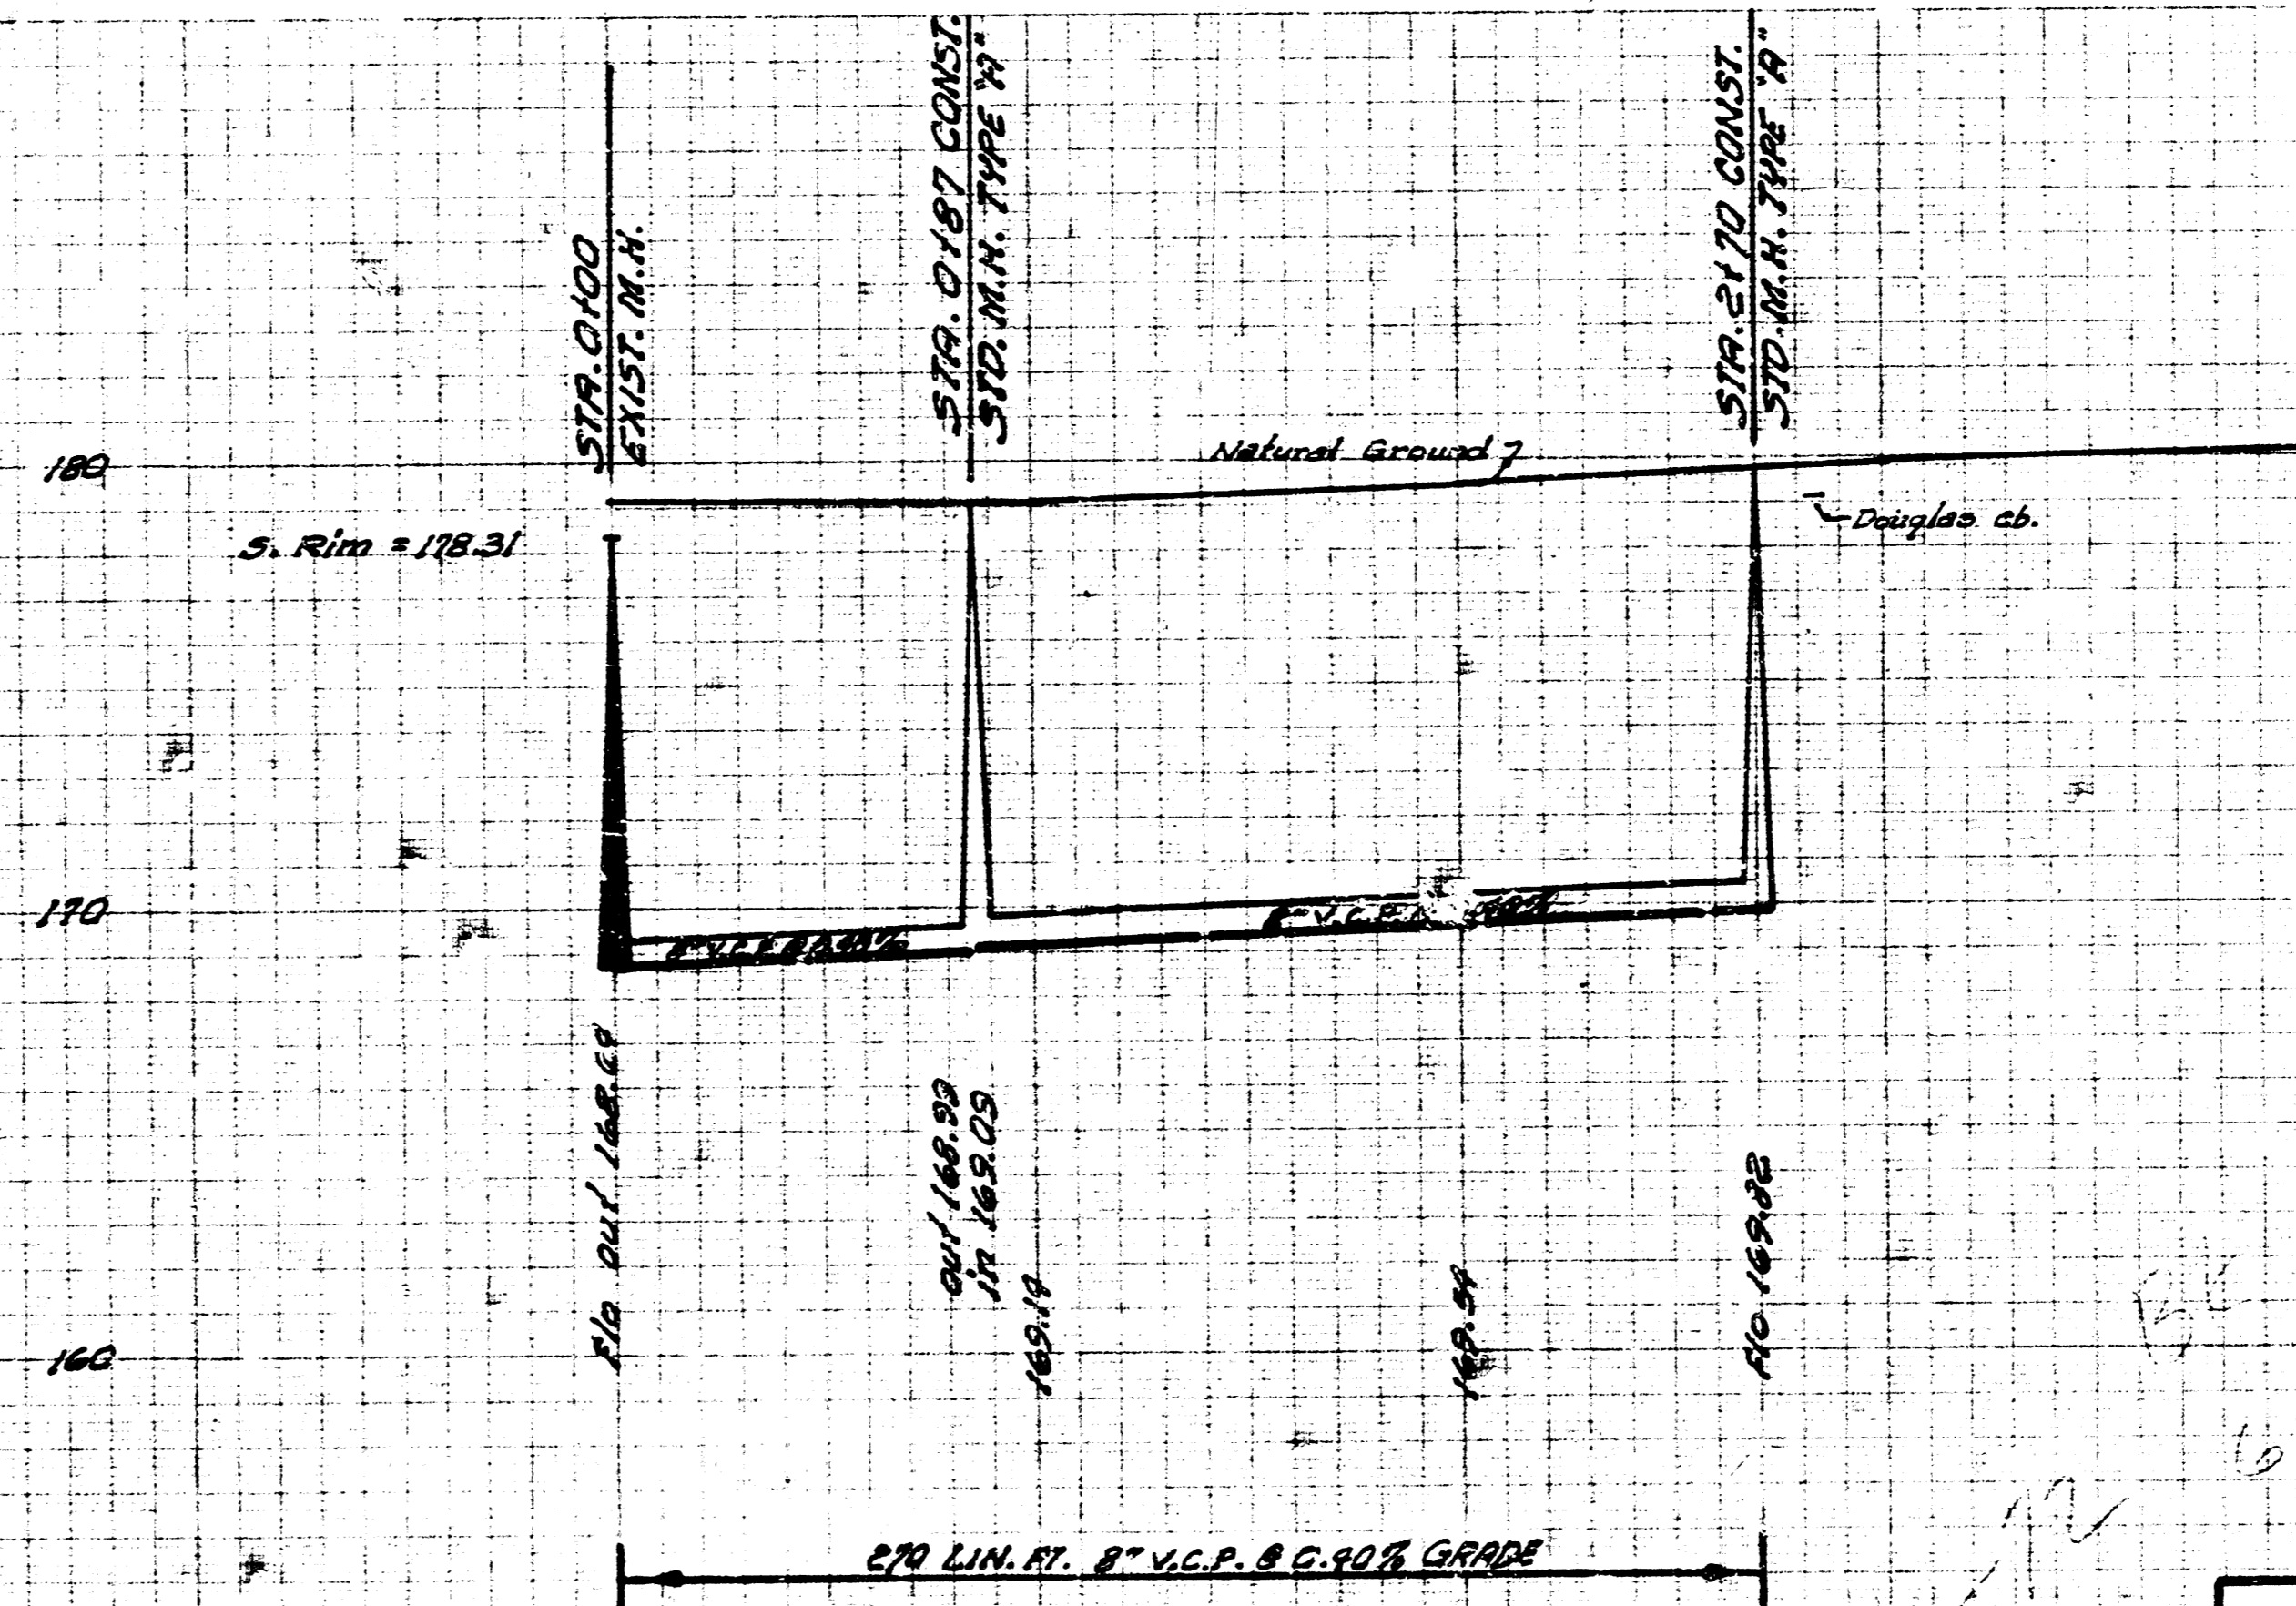

EXTENSION OF LAT. 52, D.C. SUB. #2, S.S. 12  
CITY OF WICHITA, KANSAS  
B. E. SMITH, CITY ENGINEER  
PRIVATE PROJ. DATE: