

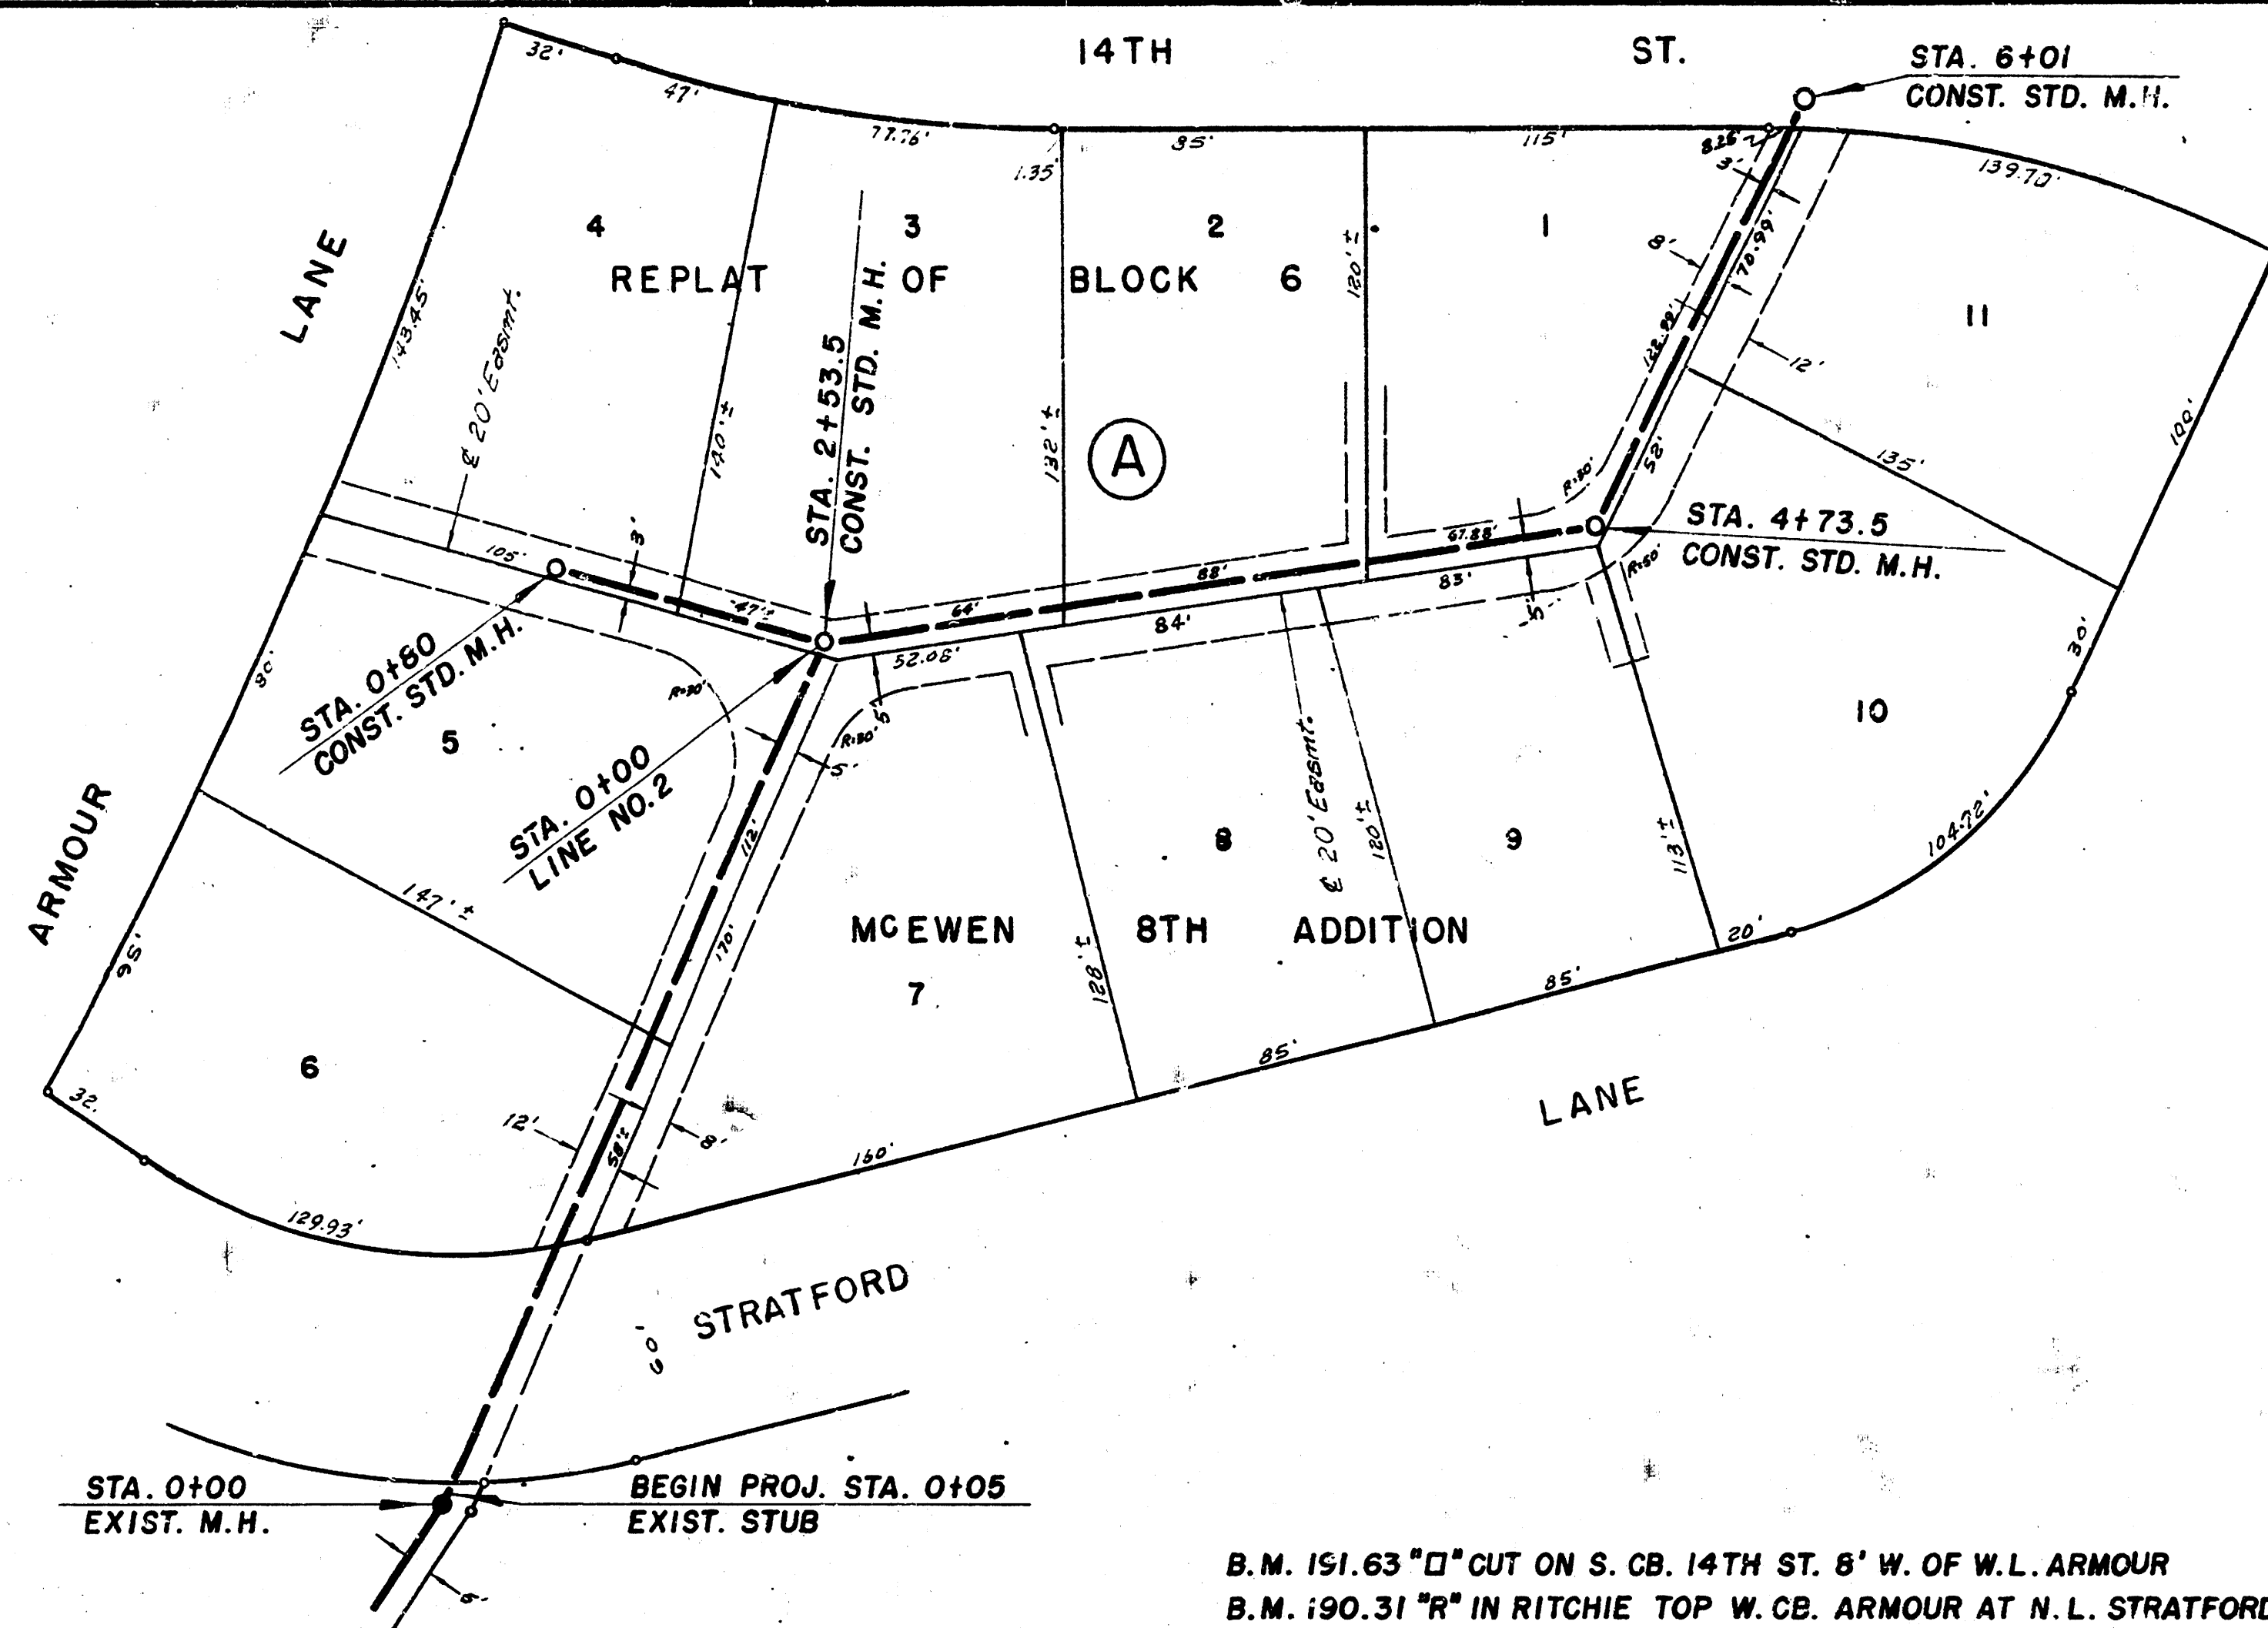
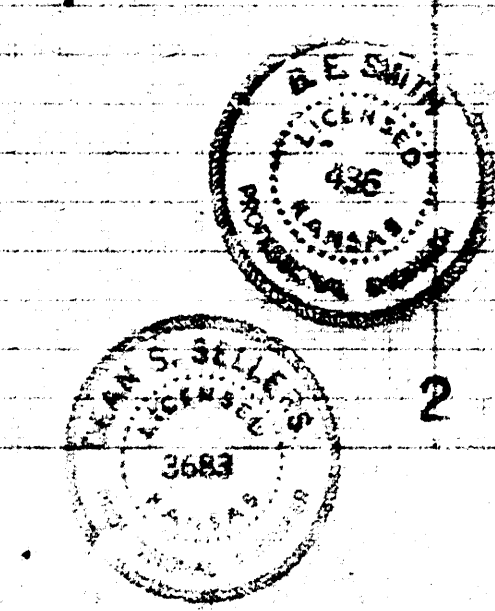


Survey by J.F.G. Bk No. J.F.G. 37
 Plan by J.M. Checked by J.M. Date:

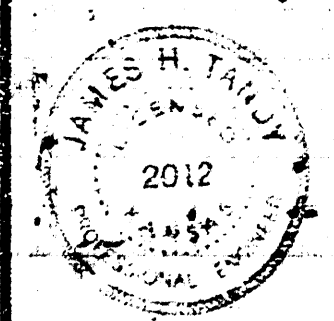

PLAN SCALE 1"=40'
 PROFILE SCALE 1"=40' HOR.
 1"=4' VERT.

B.M. 151.63 "D" CUT ON S. CB. 14TH ST. 6' W. OF W.L. ARMOUR
 B.M. 190.31 "R" IN RITCHIE TOP W. CB. ARMOUR AT N. L. STRATFORD

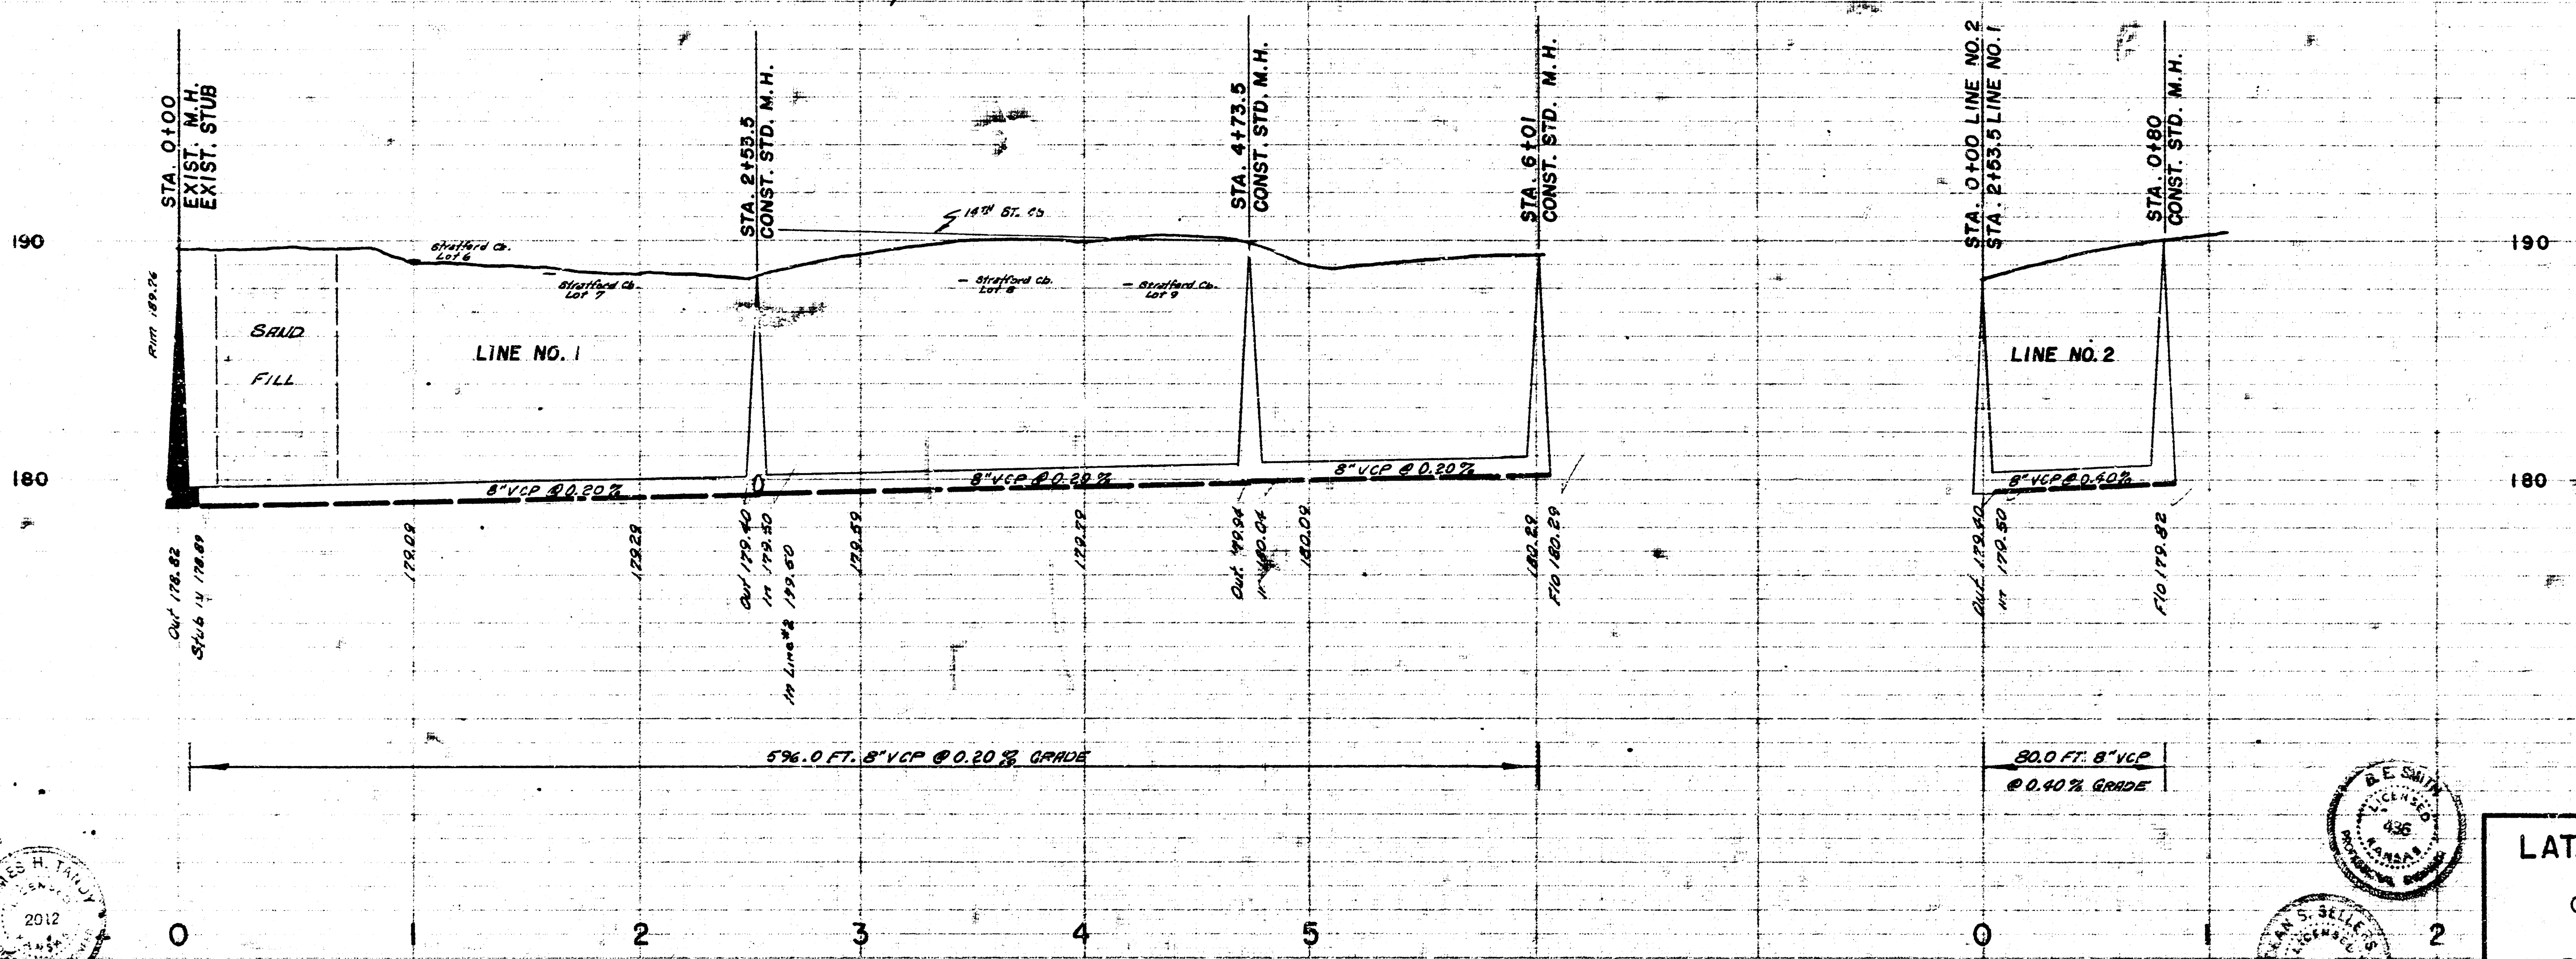

LAT. 86, D.C.S. 2, S. S. NO. 12
 CITY OF WICHITA, KANSAS
 B. E. SMITH CITY ENGINEER
 MAY 1963 PROJECT NO. C22-20