

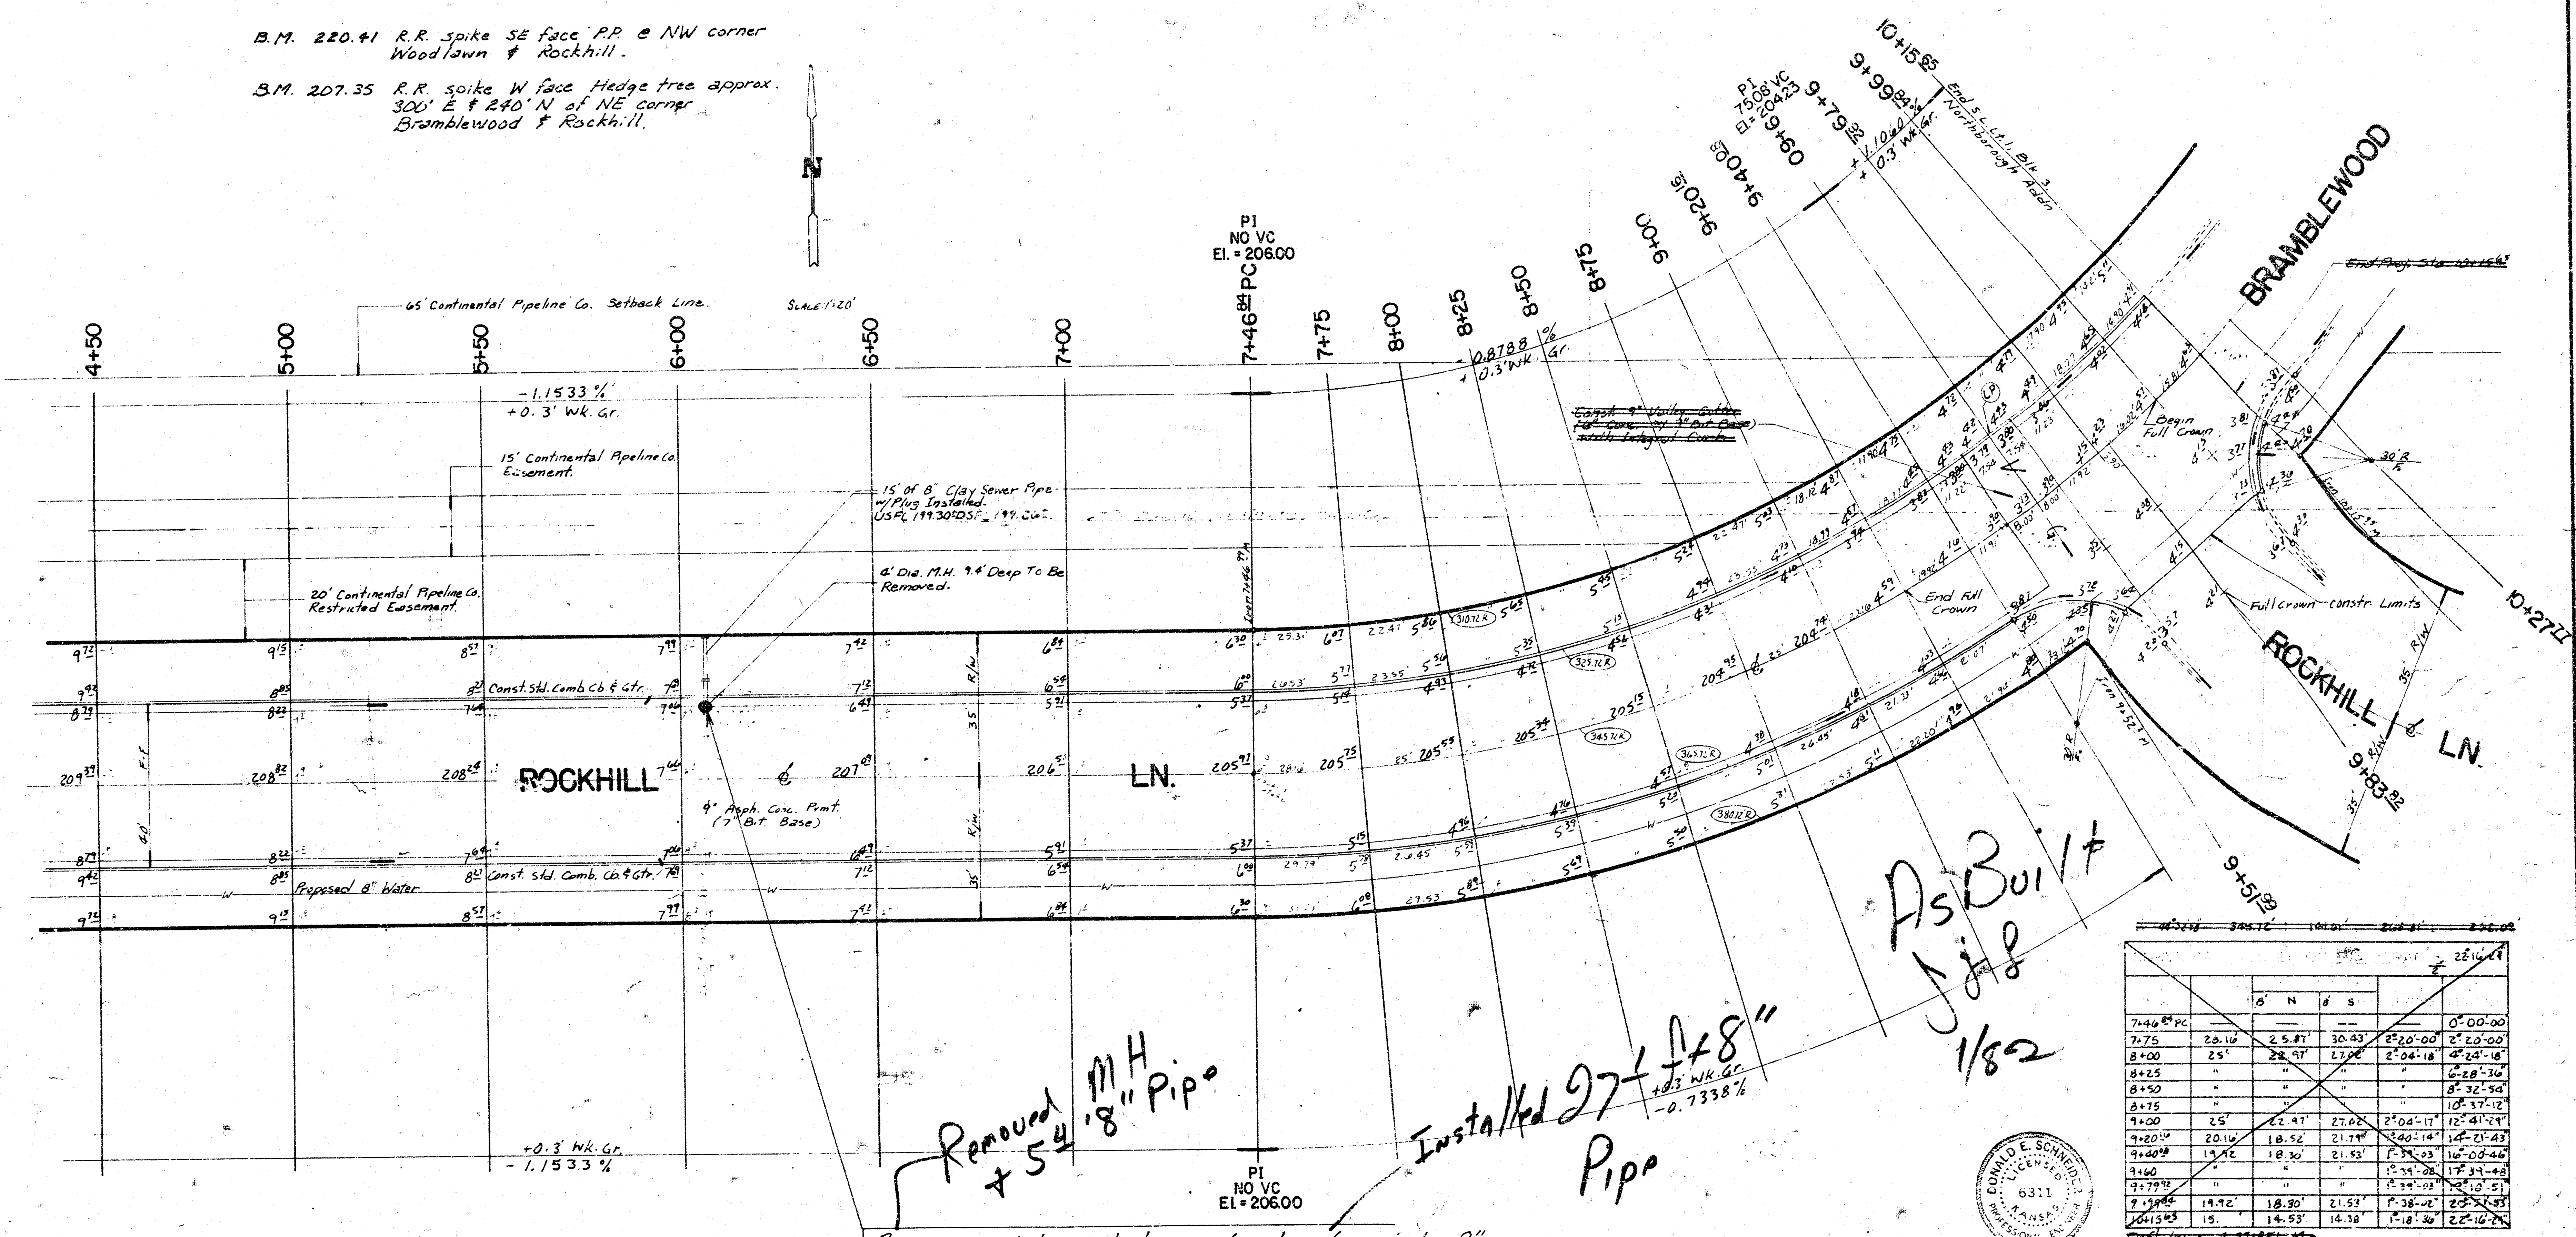


B.M. 220.41 R.R. spike SE face P.P. @ NW corner
Woodlawn & Rockhill.

B.M. 207.35 R.R. spike W face Hedge tree approx.
300' E & 240' N of NE corner
Bramblewood & Rockhill.

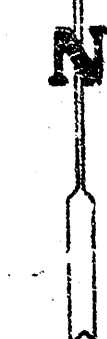

Station	6" N	8" S	6" S	8" S
7+46.85 PC				0+00.00
7+75	20.10	25.87	30.43	25.20-00
8+00	25'	28.97	27.00	25.04-18
8+25	"	"	"	25.28-30
8+50	"	"	"	25.32-50
8+75	"	"	"	25.37-12
9+00	25'	27.47	27.02	25.04-17
9+25	20.10	18.52	21.77	25.40-14
9+50	19.12	18.30	21.53	25.35-03
9+75	"	"	"	25.34-08
10+00	19.72	18.30	21.52	25.38-02
10+25	15'	14.53	14.38	25.18-30
10+50				25.16-27

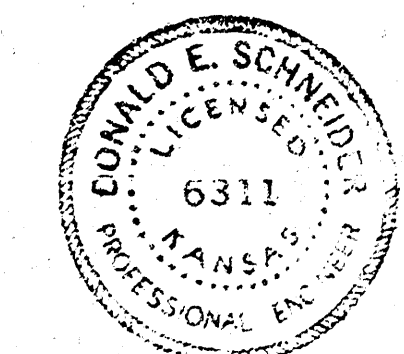

Lot 102, Dry Creek Main No. 2, S.S. #12 - Phase I
468-76-245-80409-000-000-001
City of Wichita, Kansas